




FED. ROAD DIST. NO.	STATE	FED. AID PROJ. NO.	FISCAL YEAR	SHEET NO.	TOTAL SHEETS
HAWAII	HAW.	I-H3-1(75), UNIT III	1994	327	353

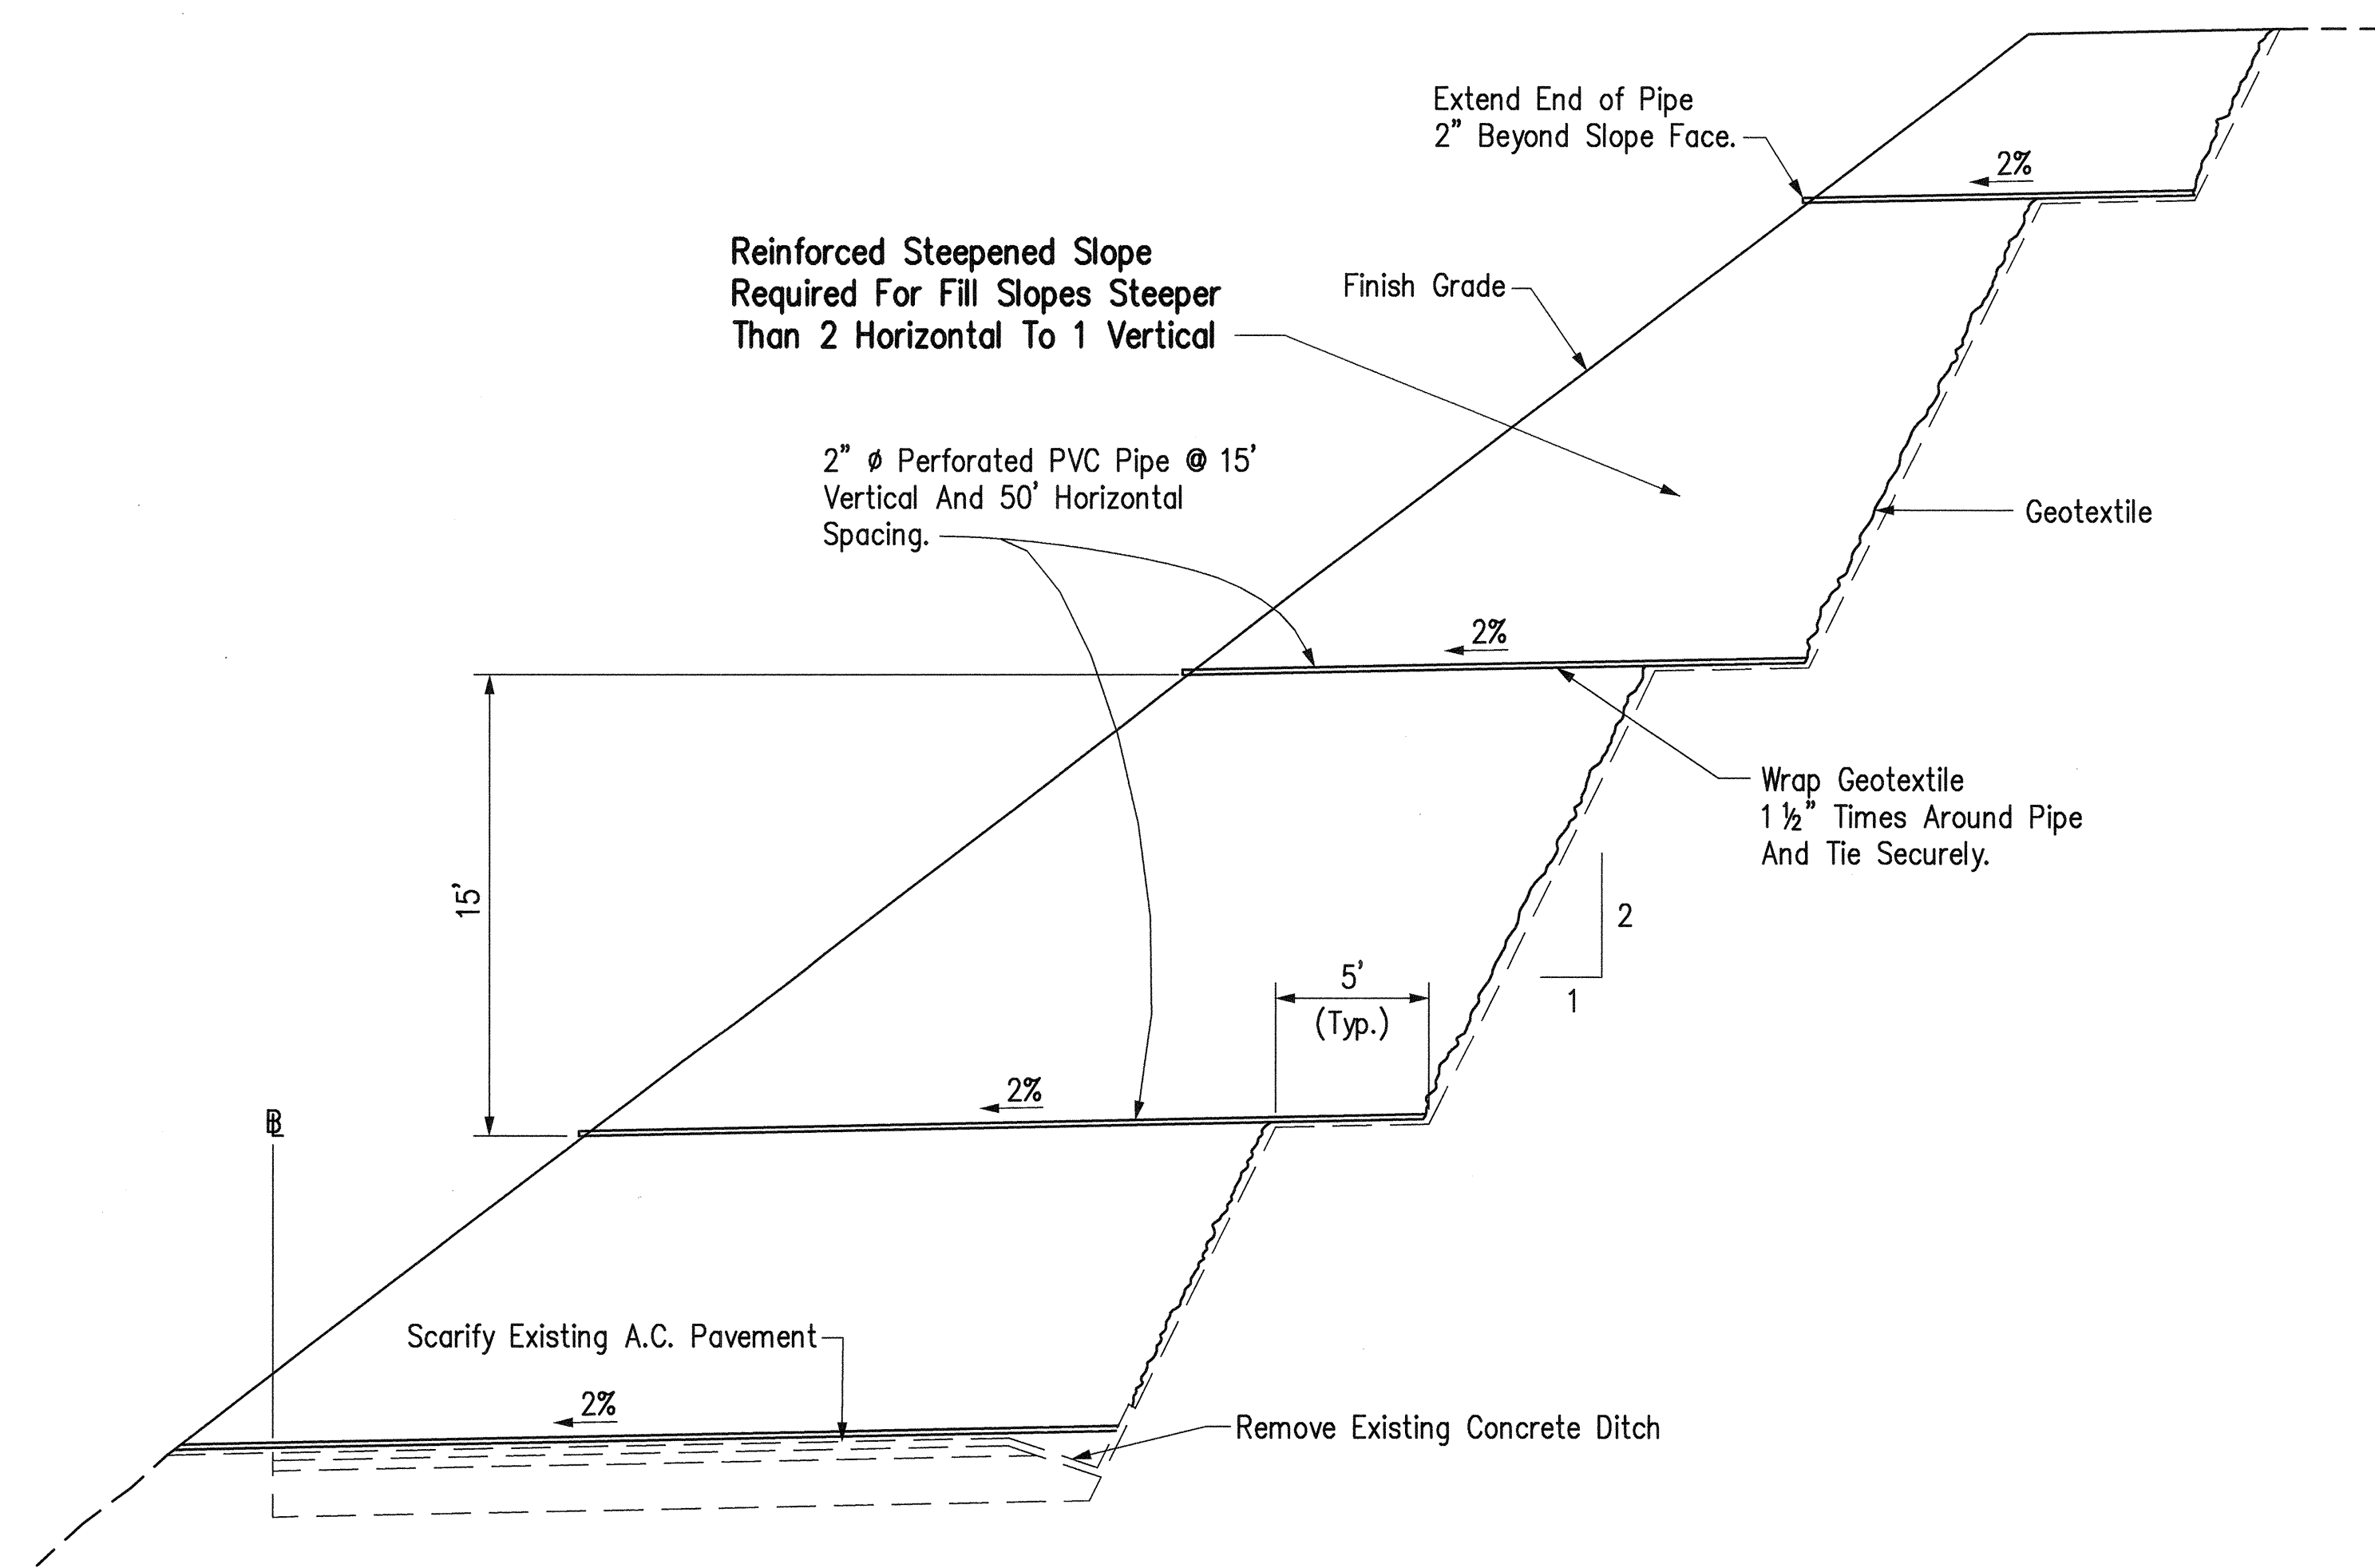


TYPICAL SLOPE RESTORATION SECTION

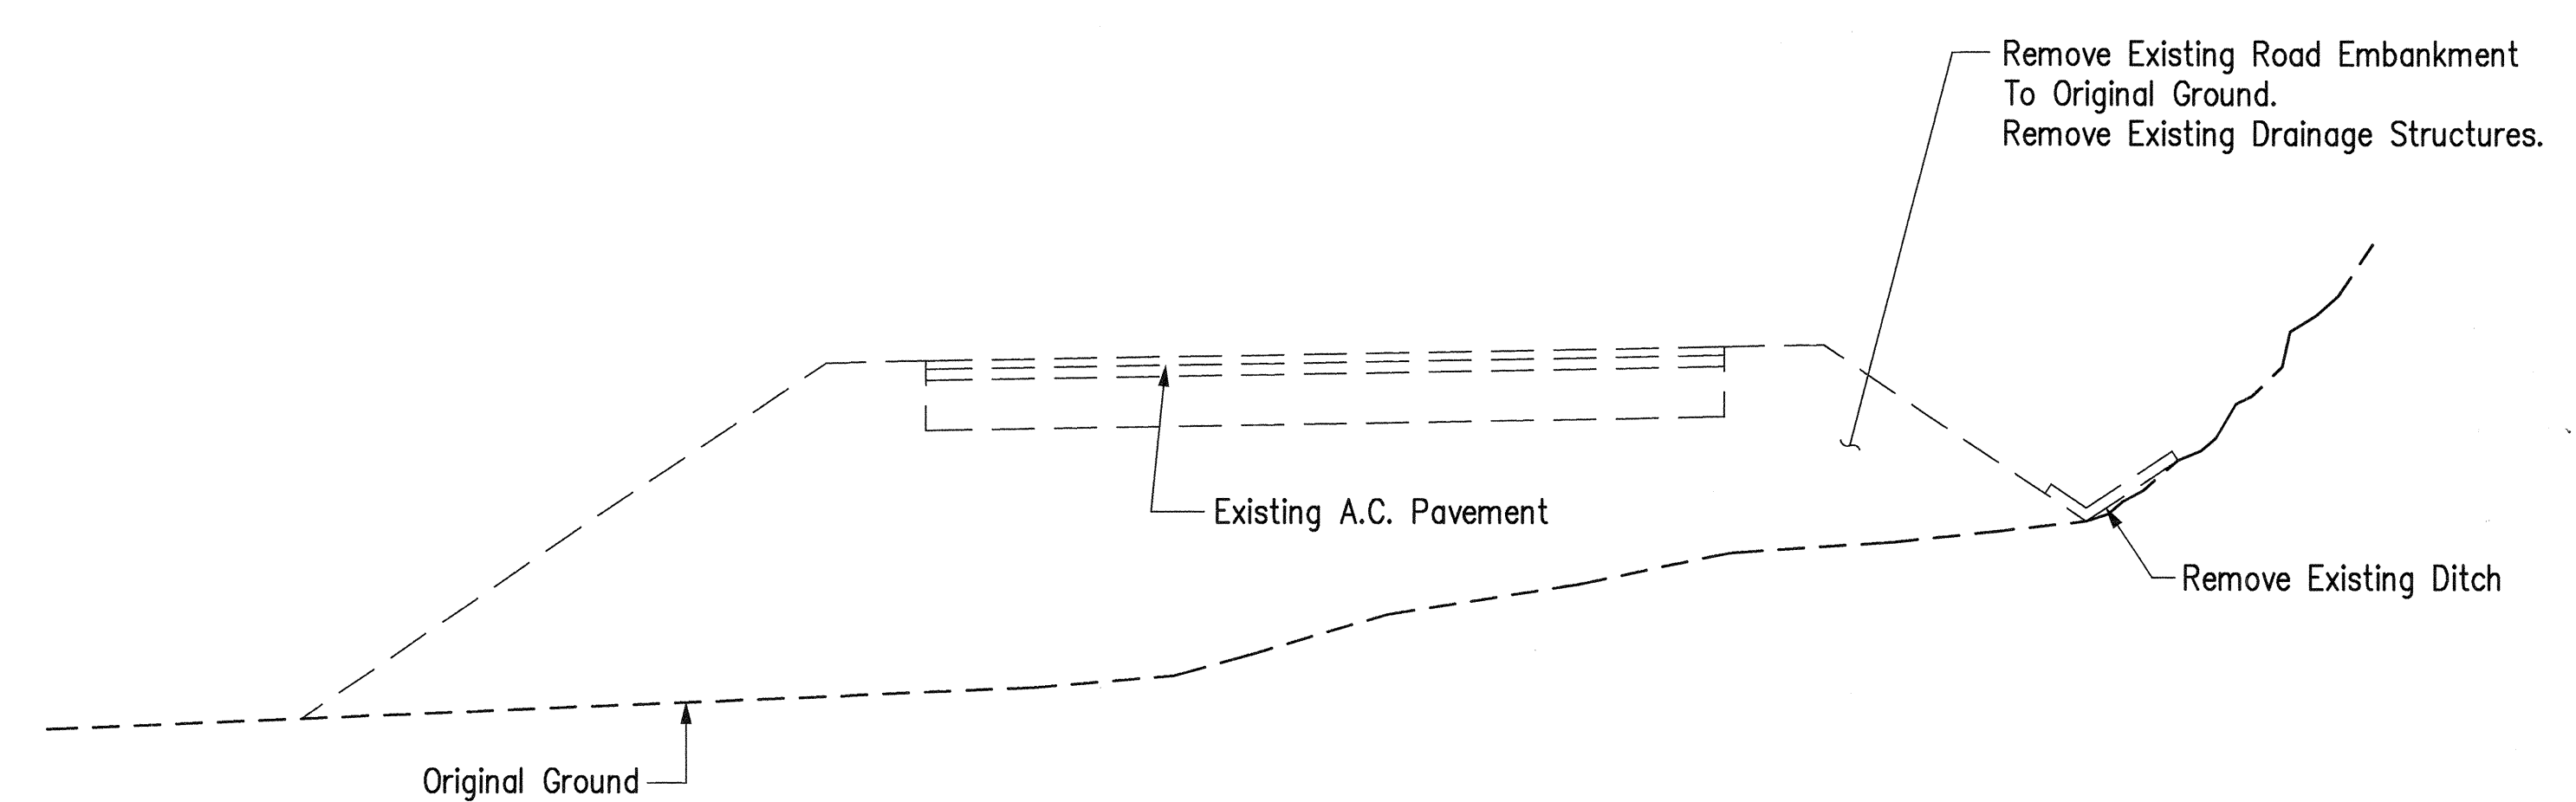

TYPICAL SECTION II
FILL SECTION

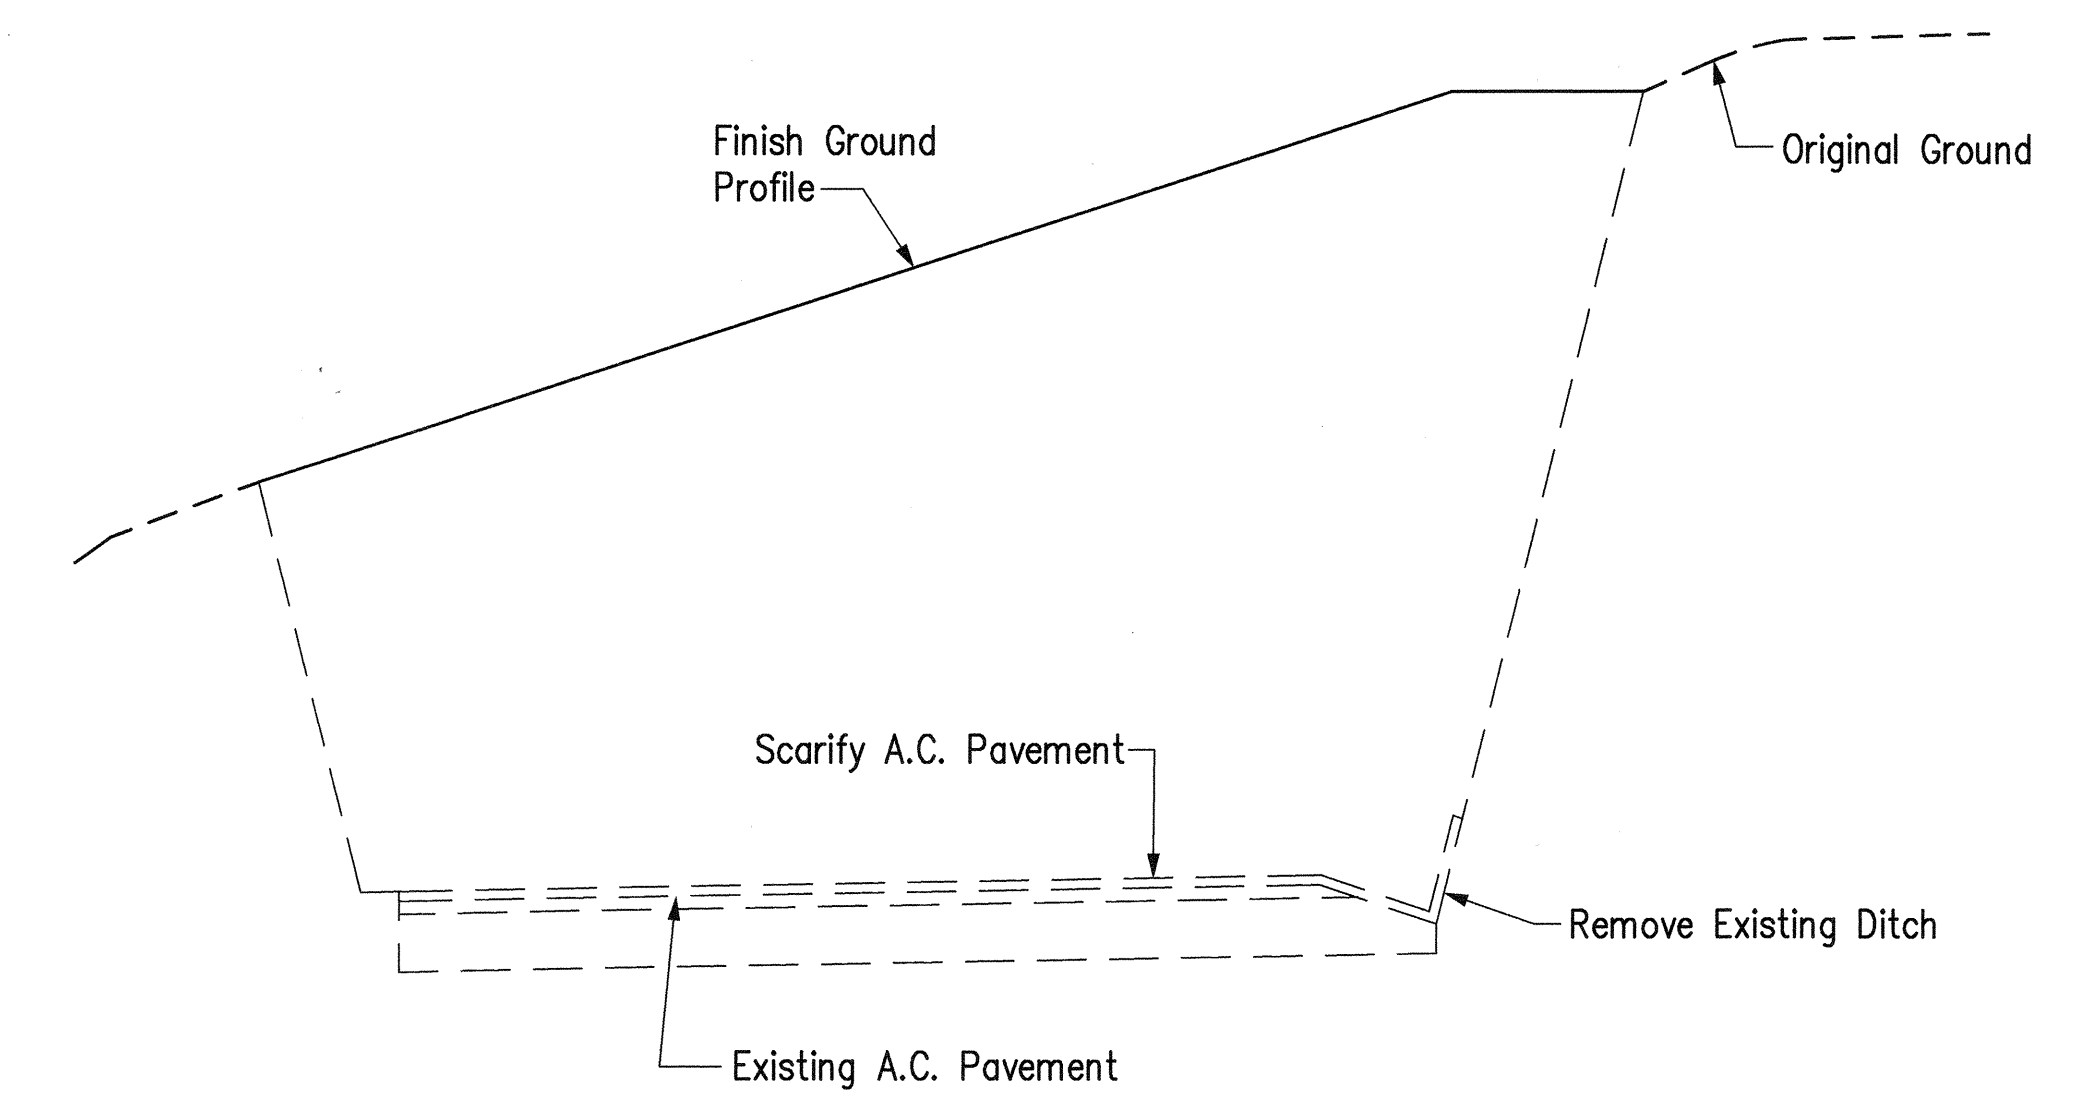


TYPICAL SECTION III
CUT SECTION

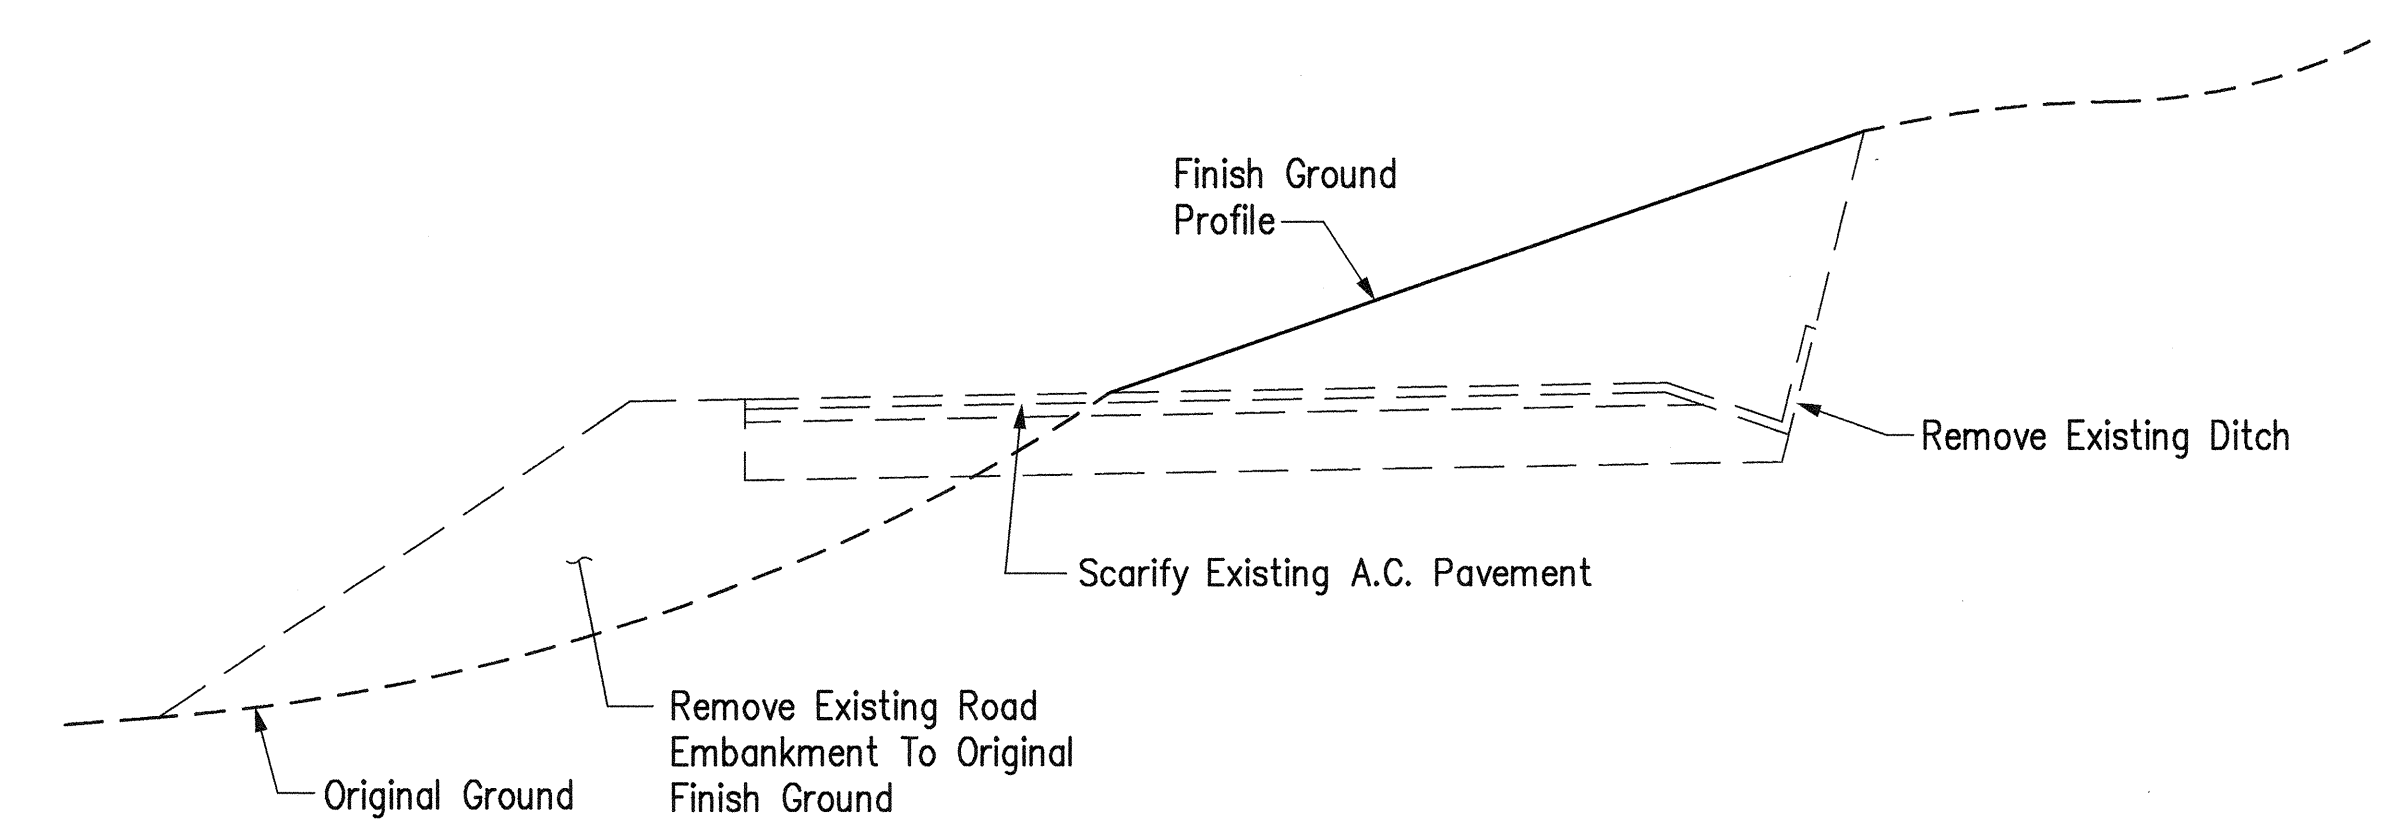

TYPICAL SECTION I
CUT & FILL SECTION

ORIGINAL PLAN	DATE
DESIGNED BY	DATE
NOTED BY	DATE
CHECKED BY	DATE
NO.	

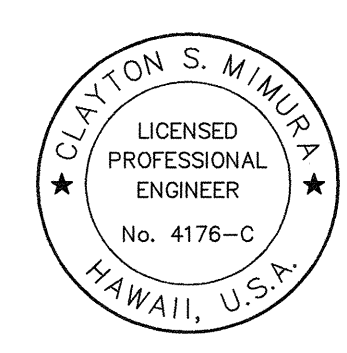


THIS WORK WAS PREPARED BY ME
OR UNDER MY SUPERVISION.

Clayton S. Mimura



STATE OF HAWAII
DEPARTMENT OF TRANSPORTATION
HIGHWAYS DIVISION
TYPICAL RESTORATION SECTIONS
HAIKU ACCESS ROAD
RESTORATION
H-3 FINISH (UNIT III)
FAIP NO. I-H3-1(75), UNIT III
I.K. TUNNEL/ACCESS ROADS
SCALE: 1" = 5'
DATE: JUNE 1995
SHEET NO. 9C1 OF 18 SHEETS

327

FED. ROAD DIST. NO.	STATE	FED. AID PROJ. NO.	FISCAL YEAR	SHEET NO.	TOTAL SHEETS
HAWAII	HAW.	I-H3-I(75), UNIT III	1994	328	353

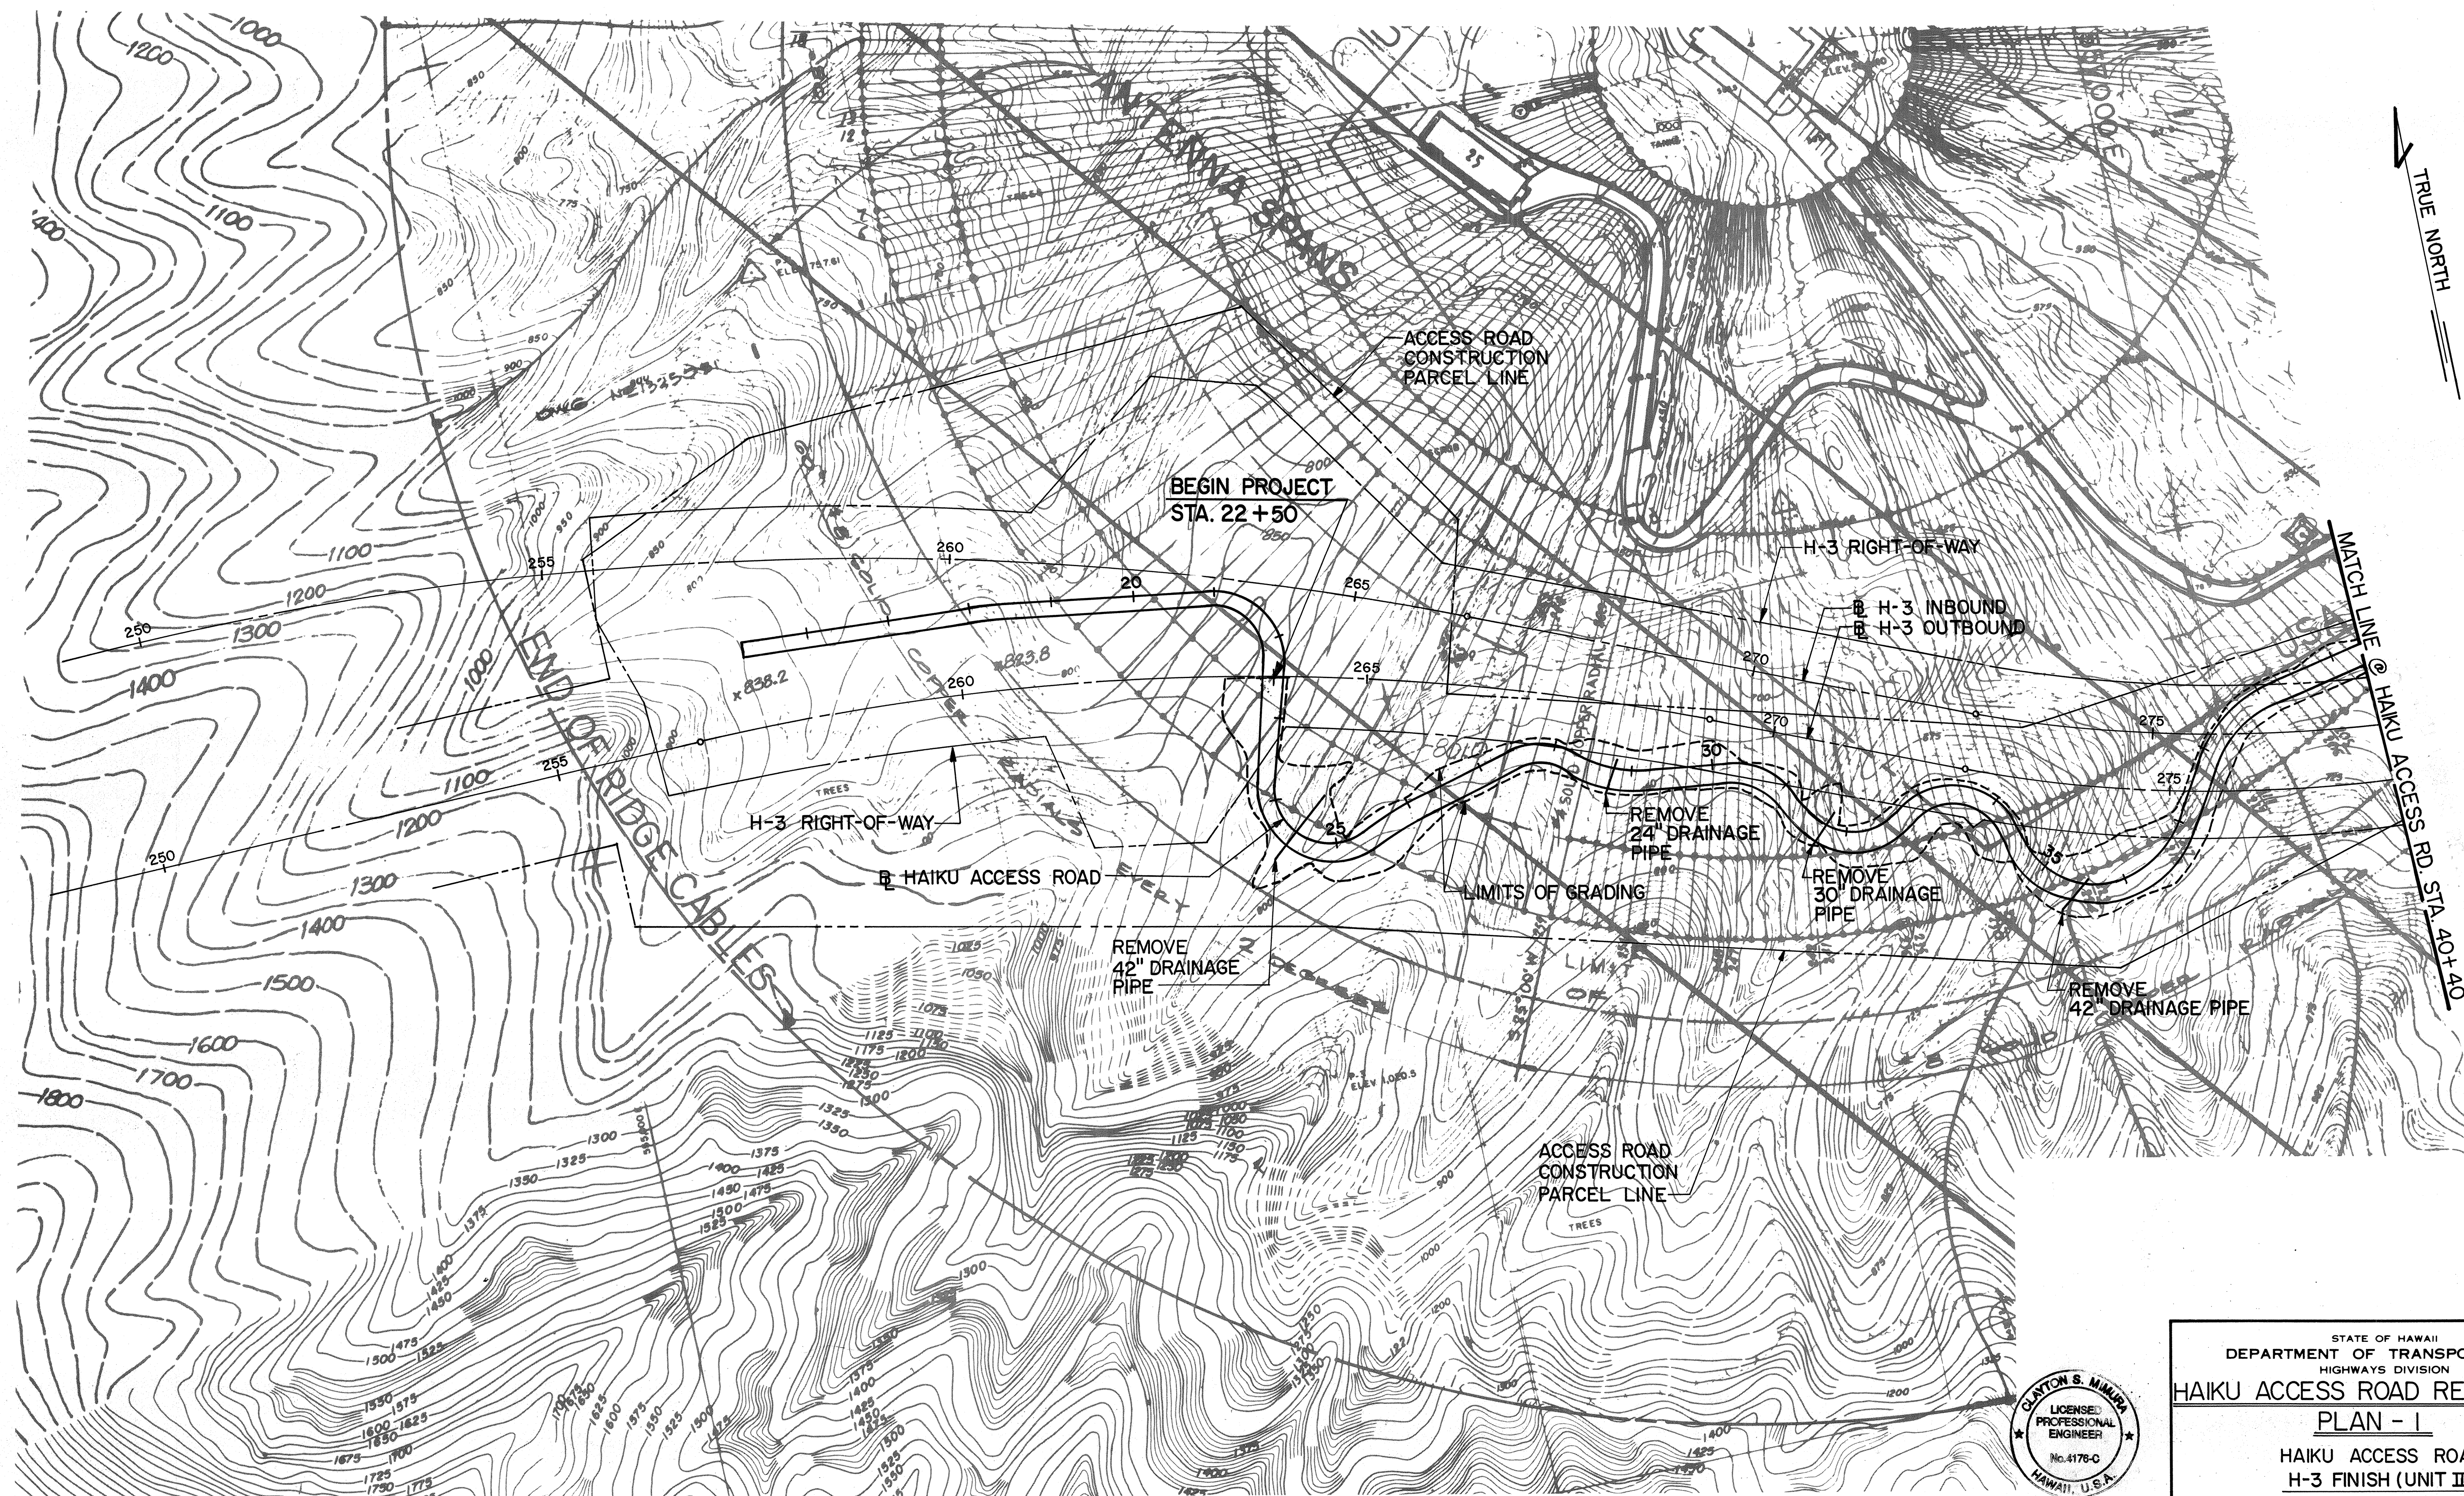


ORIGINAL PLAN	SURVEY PLOTTED BY	DATE
NOTE BOOK	DRAWN BY	
	DESIGNED BY	
	CHECKED BY	

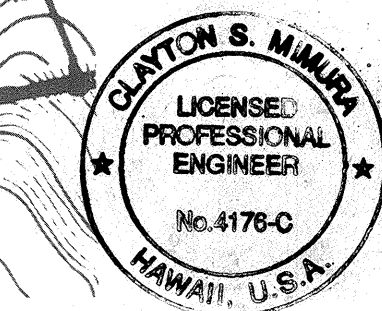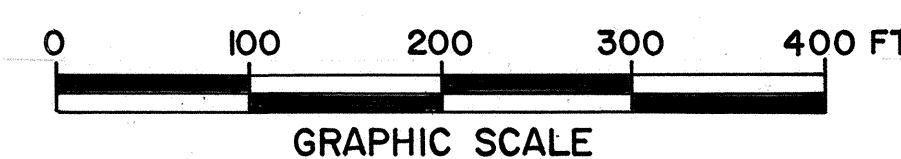

THIS WORK WAS PREPARED BY ME OR UNDER MY SUPERVISION.
Clayton S. Murre



STATE OF HAWAII
 DEPARTMENT OF TRANSPORTATION
 HIGHWAYS DIVISION
HAIKU ACCESS ROAD RESTORATION
PLAN - I
 HAIKU ACCESS ROAD
 H-3 FINISH (UNIT III)
 FAIP NO. I-H3-I(75), UNIT III
 T.K. TUNNEL / ACCESS ROADS
 SCALE: 1" = 100' DATE: JUNE 1995
 SHEET No. 9C2 OF 18 SHEETS

FED. ROAD DIST. NO.	STATE	FED. AID PROJ. NO.	FISCAL YEAR	SHEET NO.	TOTAL SHEETS
HAWAII	HAW.	H-3-I(75),UNIT III	1994	ADD.329	353

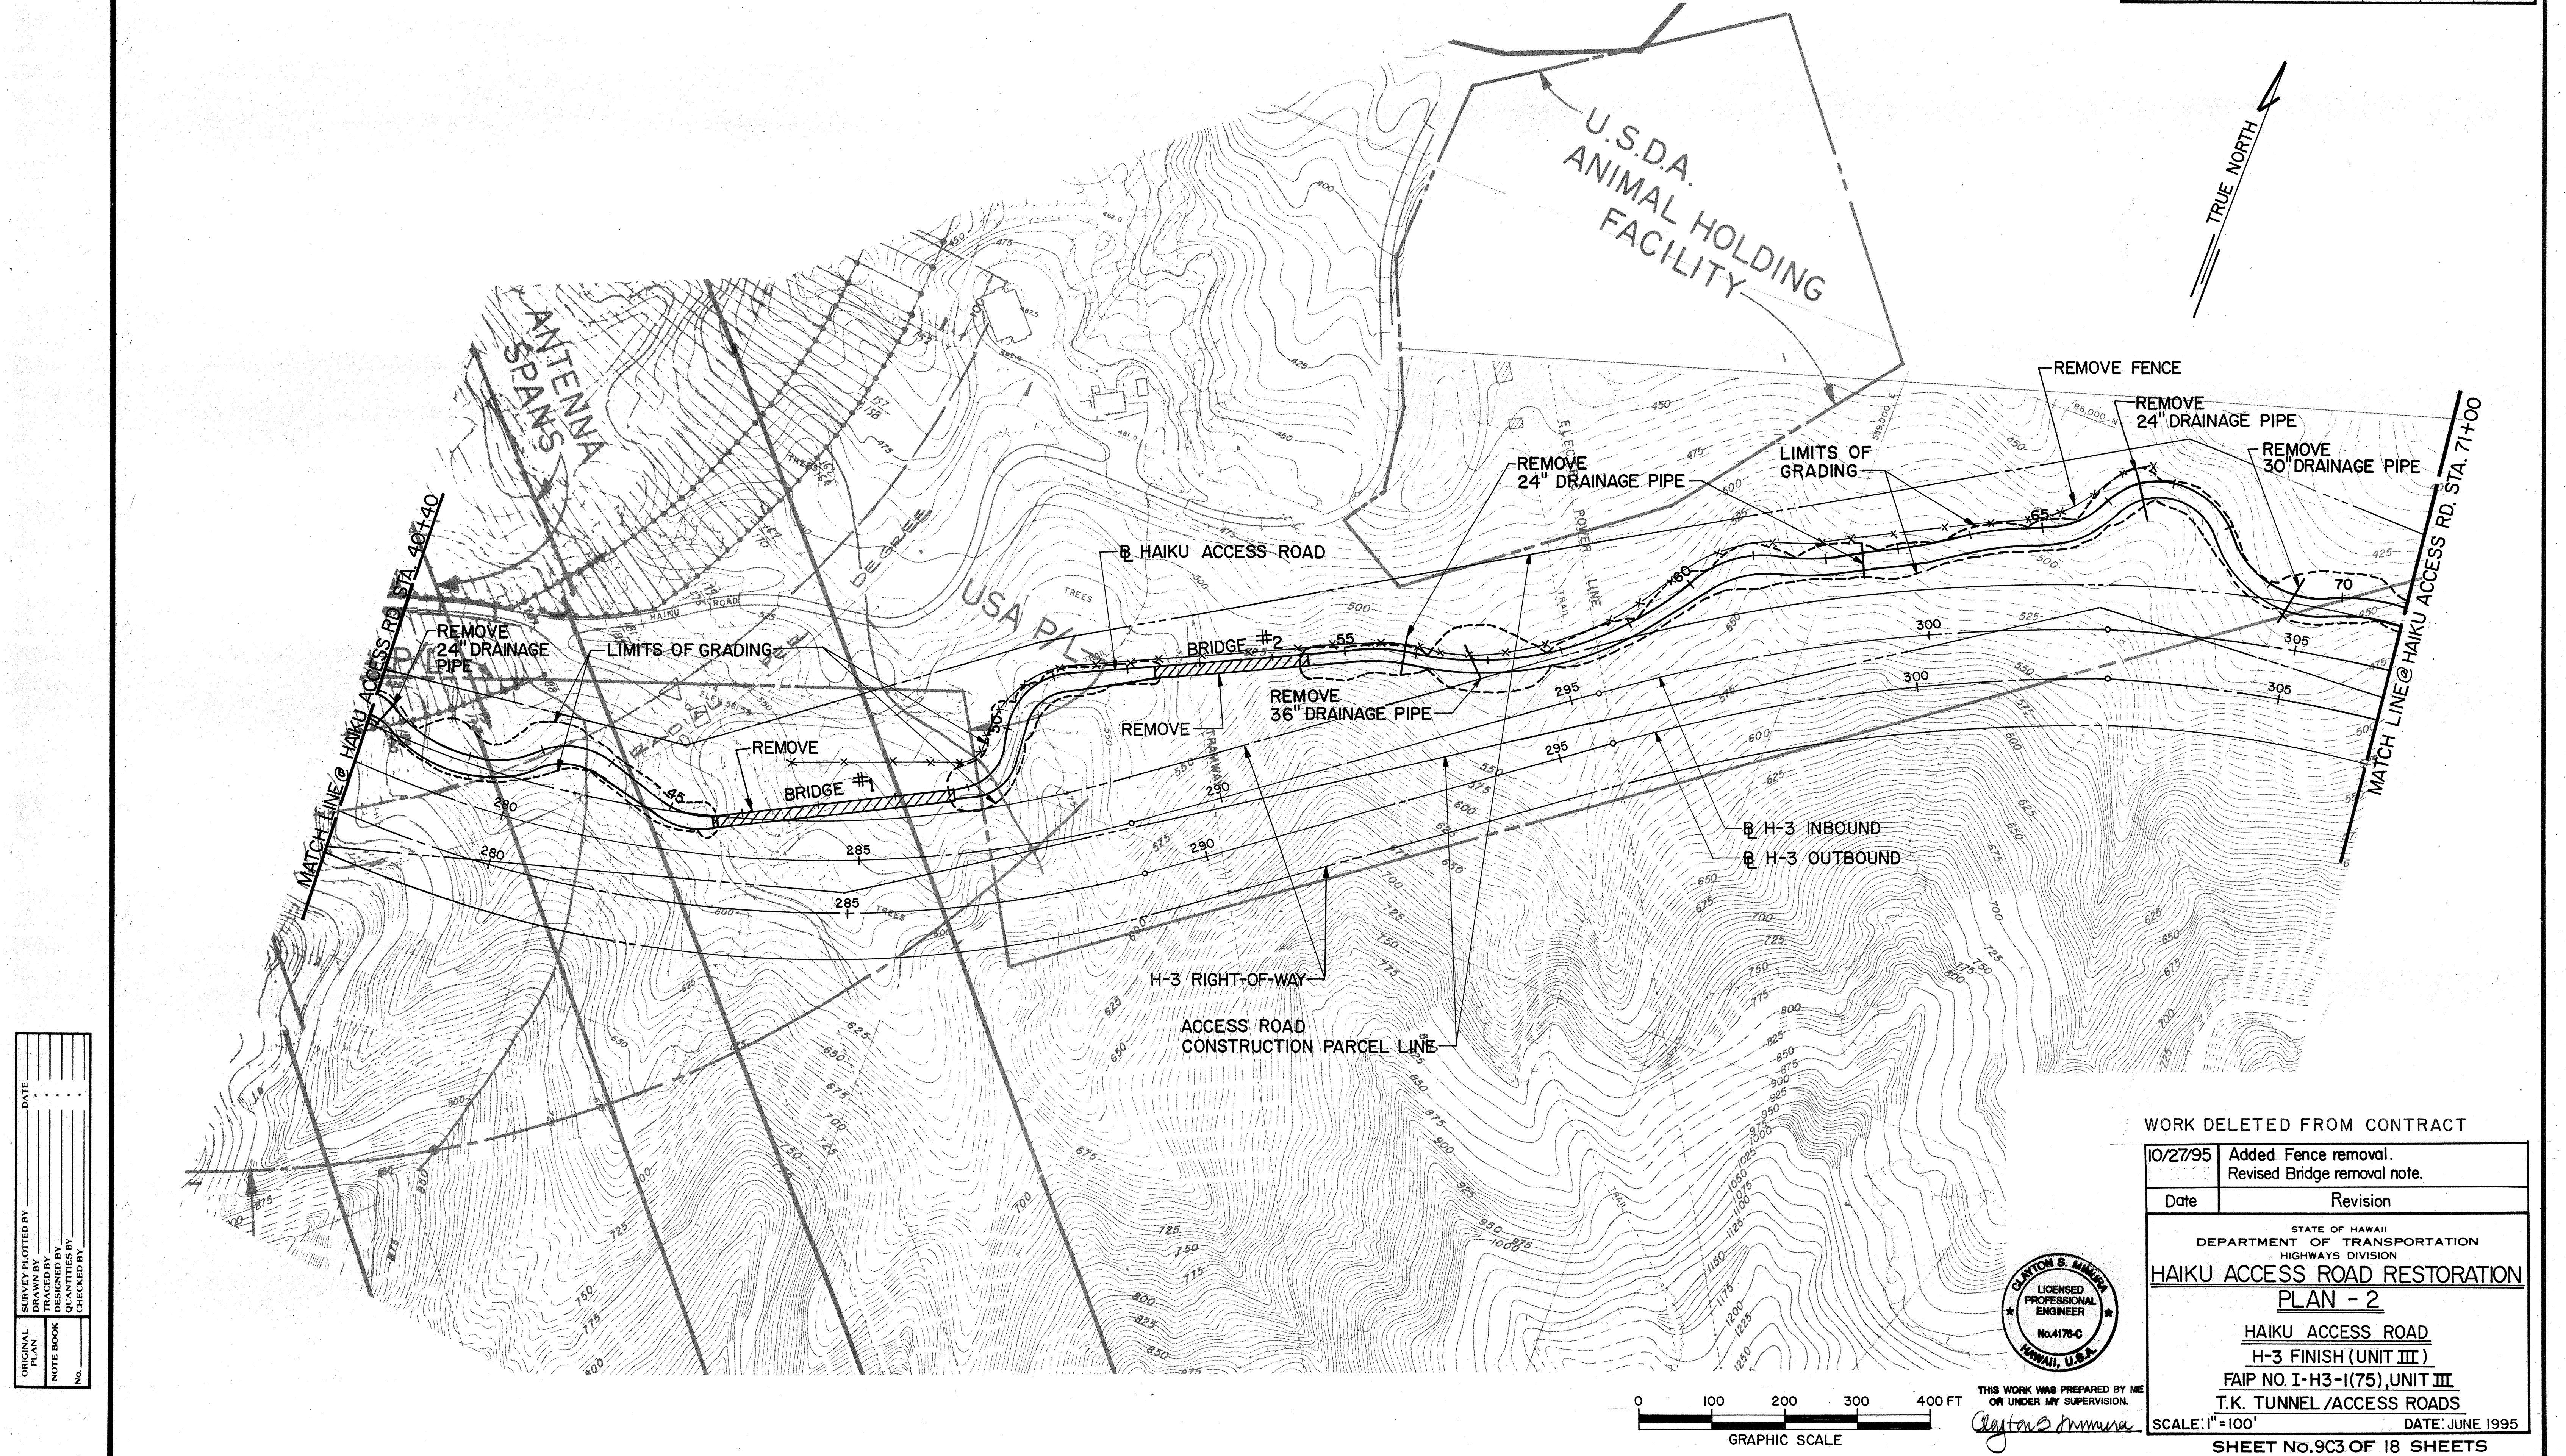


ORIGINAL PLAN	DATE
DRAWN BY	
DESIGNED BY	
CHECKED BY	
NO.	

WORK DELETED FROM CONTRACT	
10/27/95	Added Fence removal. Revised Bridge removal note.
Date	Revision
STATE OF HAWAII DEPARTMENT OF TRANSPORTATION HIGHWAYS DIVISION HAIKU ACCESS ROAD RESTORATION PLAN - 2 <u>HAIKU ACCESS ROAD</u> <u>H-3 FINISH (UNIT III)</u> <u>FAIP NO. I-H3-I(75),UNIT III</u> <u>T.K. TUNNEL /ACCESS ROADS</u> SCALE: 1"=100' DATE: JUNE 1995 SHEET No.9C3 OF 18 SHEETS	

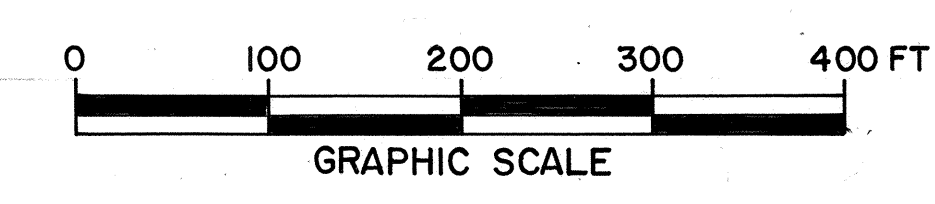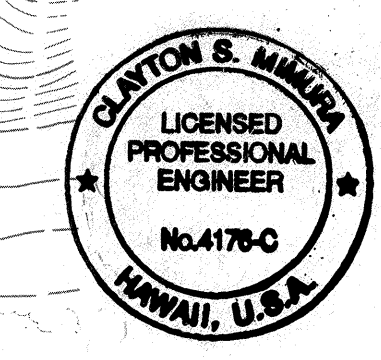


THIS WORK WAS PREPARED BY ME
OR UNDER MY SUPERVISION.
Clayton S. Immura


FED. ROAD DIST. NO.	STATE	FED. AID PROJ. NO.	FISCAL YEAR	SHEET NO.	TOTAL SHEETS
HAWAII	HAW.	H-3-(75), UNIT III	1994	ADD.331	353

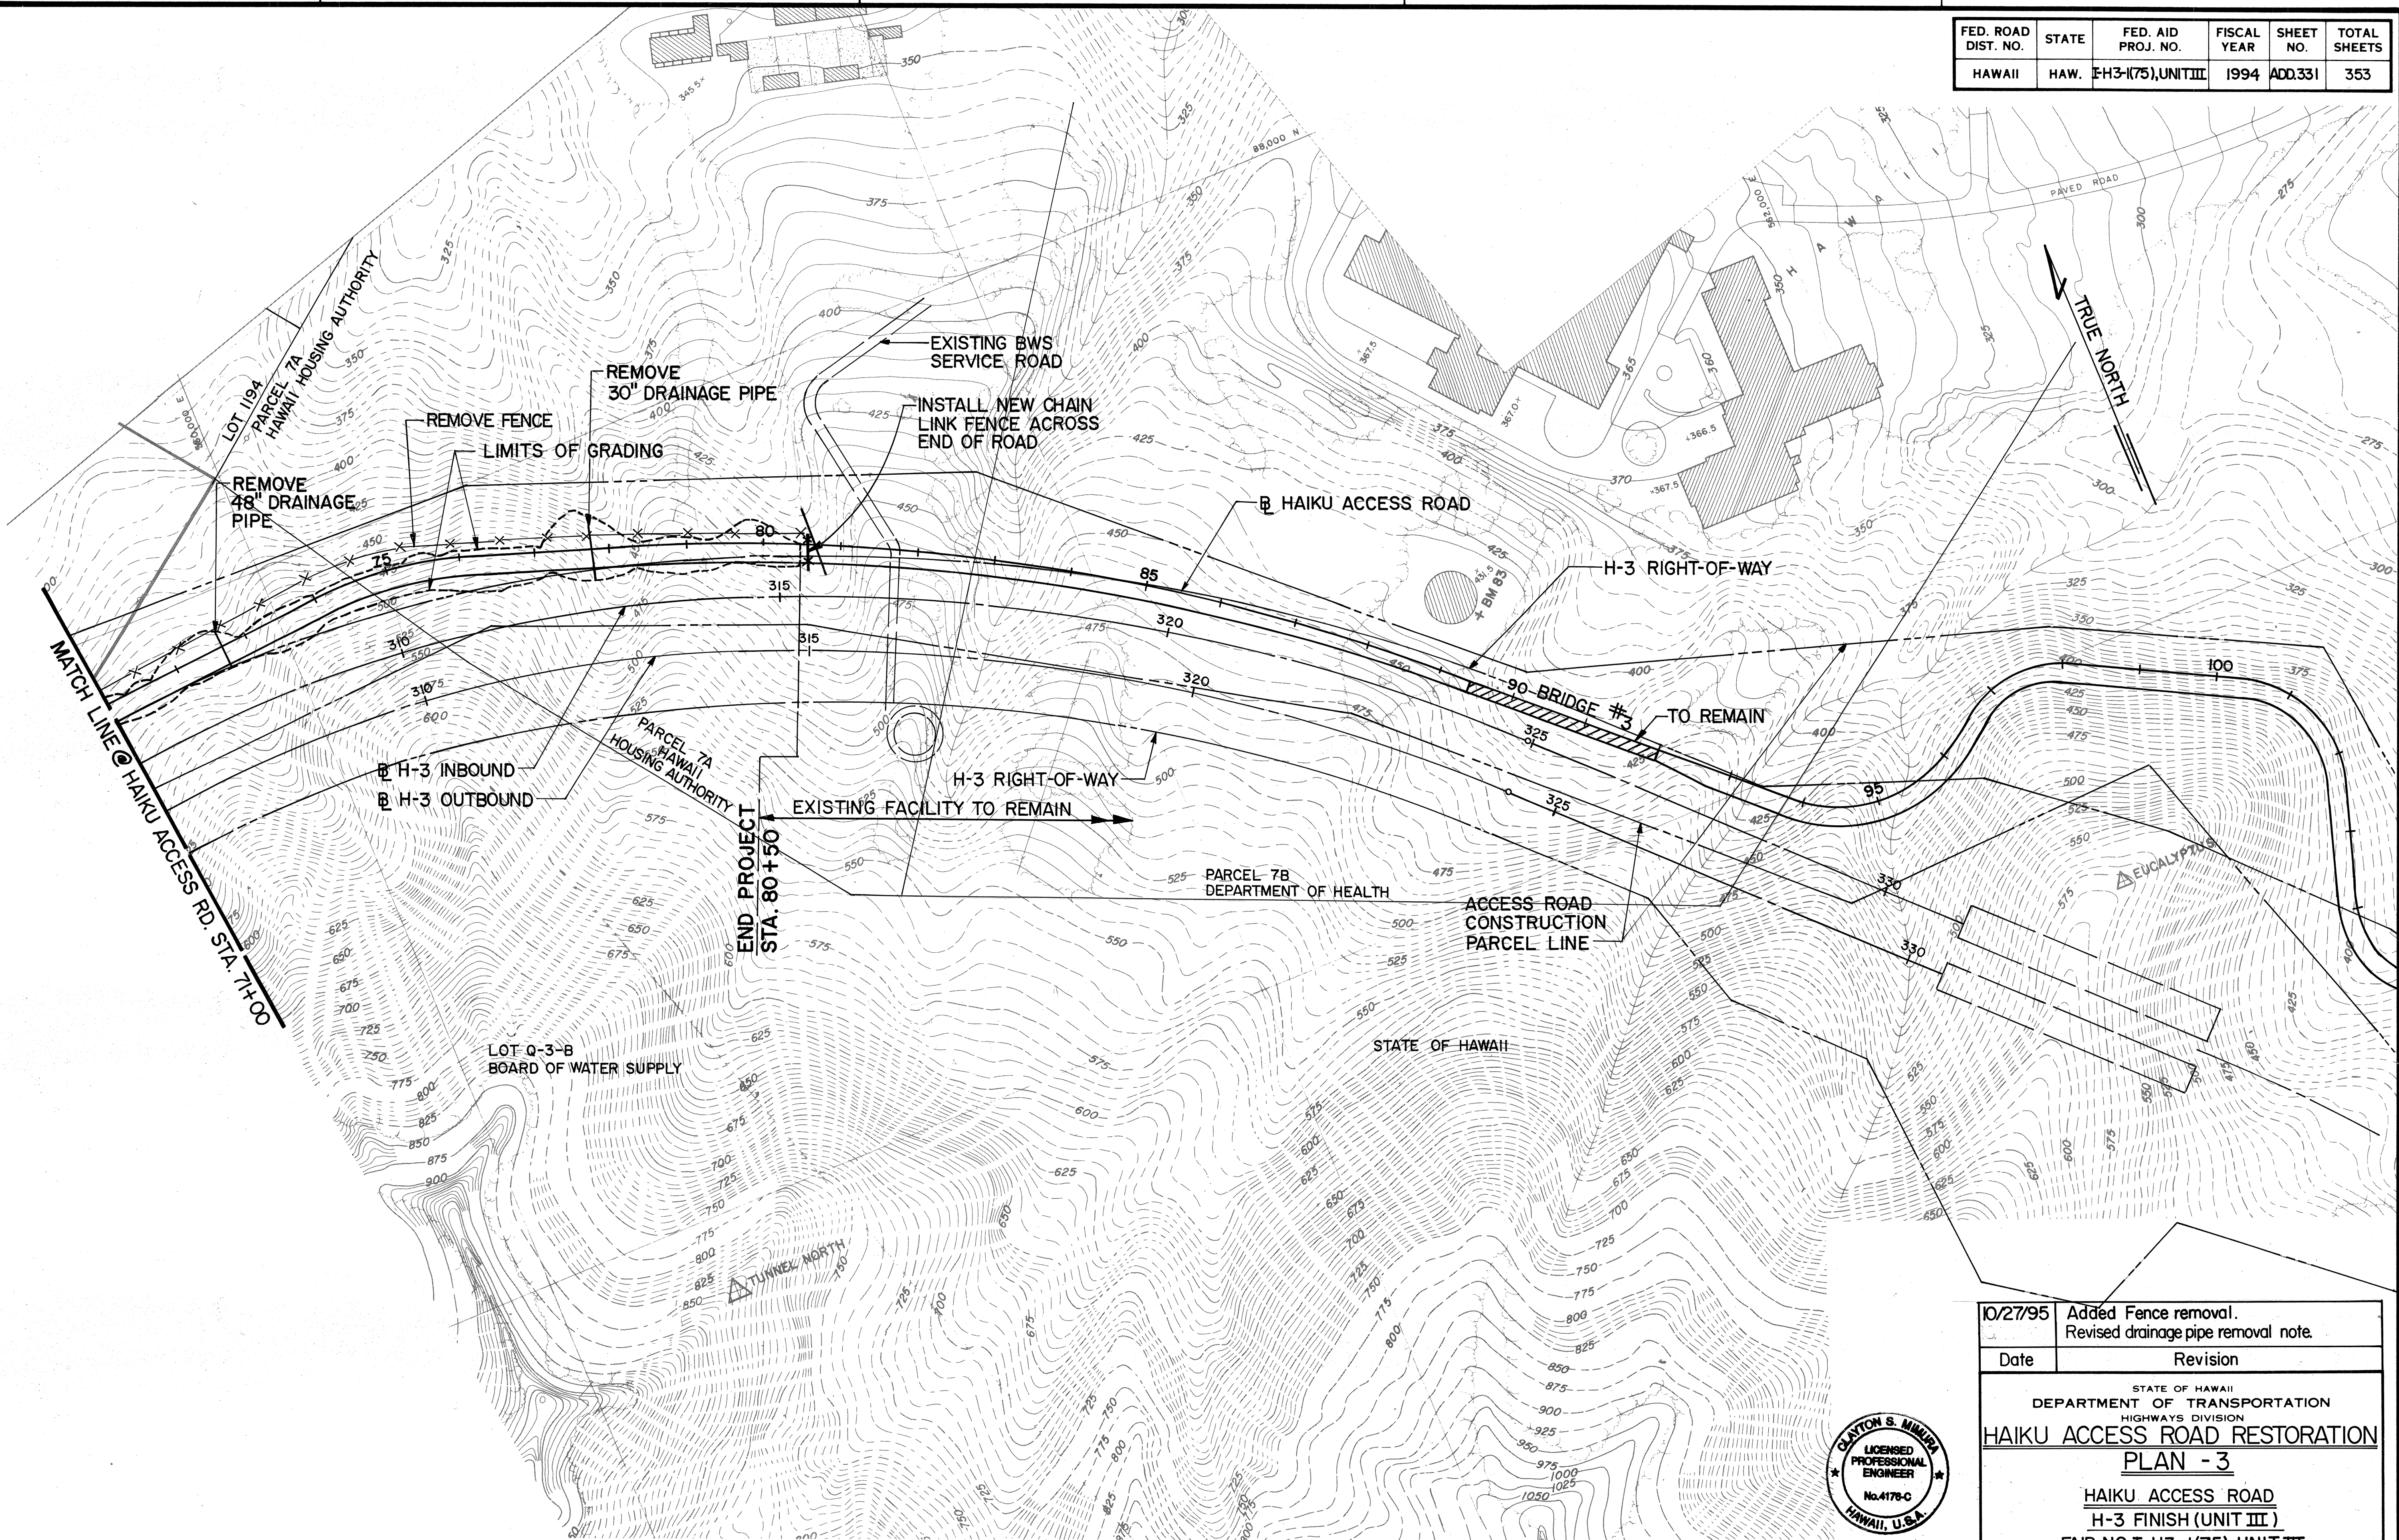

10/27/95	Added Fence removal. Revised drainage pipe removal note.
Date	Revision
STATE OF HAWAII DEPARTMENT OF TRANSPORTATION HIGHWAYS DIVISION HAIKU ACCESS ROAD RESTORATION PLAN - 3 HAIKU ACCESS ROAD H-3 FINISH (UNIT III) FAIP NO. I-H3-(75), UNIT III T.K. TUNNEL / ACCESS ROADS SCALE: 1" = 100' DATE: JUNE 1995 SHEET No.9C4 OF 18 SHEETS	

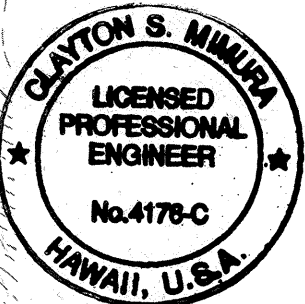


THIS WORK WAS PREPARED BY ME
OR UNDER MY SUPERVISION.
Clayton S. Minner

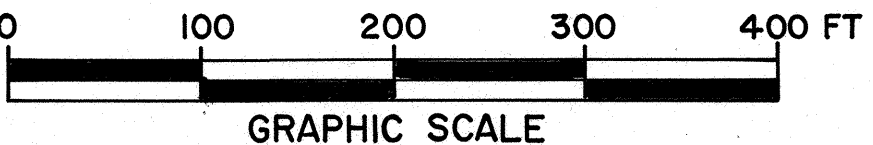

WORK DELETED FROM CONTRACT

ORIGINAL PLAN	DATE
DRAWN BY	
DESIGNED BY	
QUANTITIES BY	
CHECKED BY	
NO.	

FED. ROAD DIST. NO.	STATE	FED. AID PROJ. NO.	FISCAL YEAR	SHEET NO.	TOTAL SHEETS
HAWAII	HAW.	I-H3-(75),UNIT III	1994	ADD.331	353

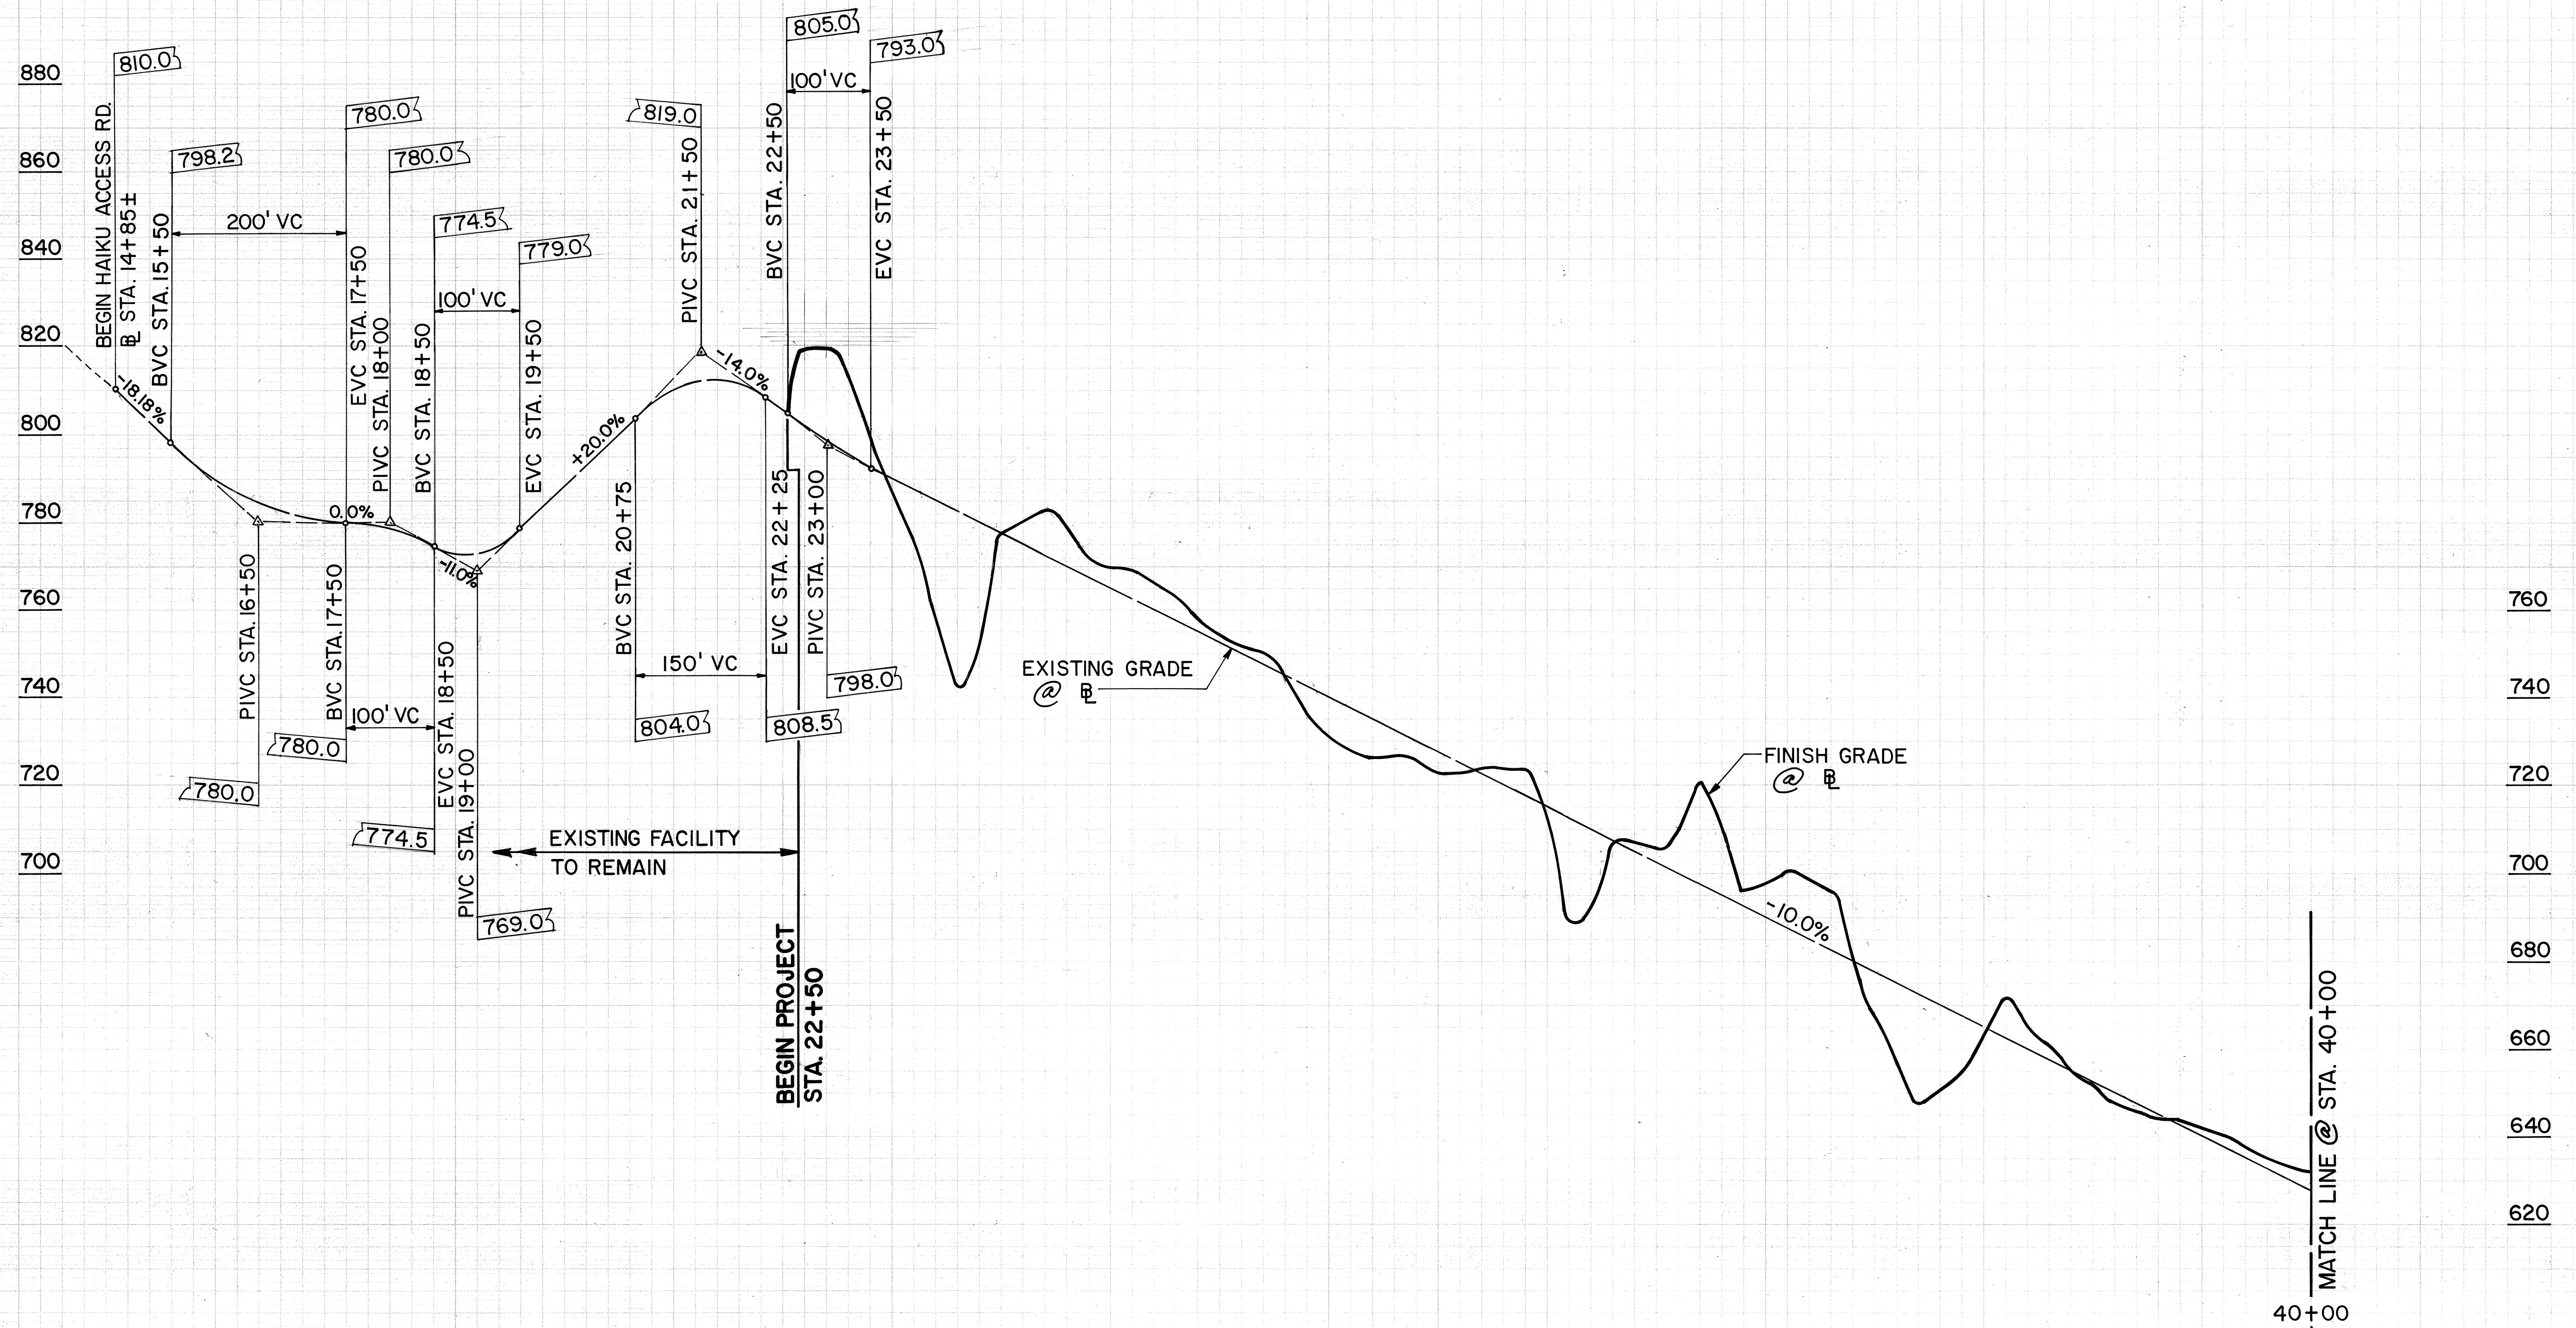

B PROFILE - HAIKU ACCESS RD.
SCALE: HORIZ. 1"=100'
VERT. 1"=20'

ORIGINAL PLAN	SURVEY PLOTTED BY _____	DATE _____
NOTE BOOK	DRAWN BY _____	_____
	TRACED BY _____	_____
	DESIGNED BY _____	_____
	QUANTITIES BY _____	_____
	CHECKED BY _____	_____
No. _____		



THIS WORK WAS PREPARED BY ME
OR UNDER MY SUPERVISION.
Clayton S. Immuna

WORK DELETED FROM CONTRACT

10/27/95	Revised original ground line.
Date	Revision

STATE OF HAWAII
DEPARTMENT OF TRANSPORTATION
HIGHWAYS DIVISION

HAIKU ACCESS ROAD RESTORATION

PROFILE - I

HAIKU ACCESS ROAD

H-3 FINISH (UNIT III)

FAIP NO. I-H3-I(75), UNIT III


T.K. TUNNEL /ACCESS ROADS

SCALE: AS SHOWN DATE: JUNE 1995

SHEET No. 9C5 OF 18 SHEETS


ADD. 331

FED. ROAD DIST. NO.	STATE	FED. AID PROJ. NO.	FISCAL YEAR	SHEET NO.	TOTAL SHEETS
HAWAII	HAW.	I-H3-I(75),UNIT III	1994	ADD.332	353

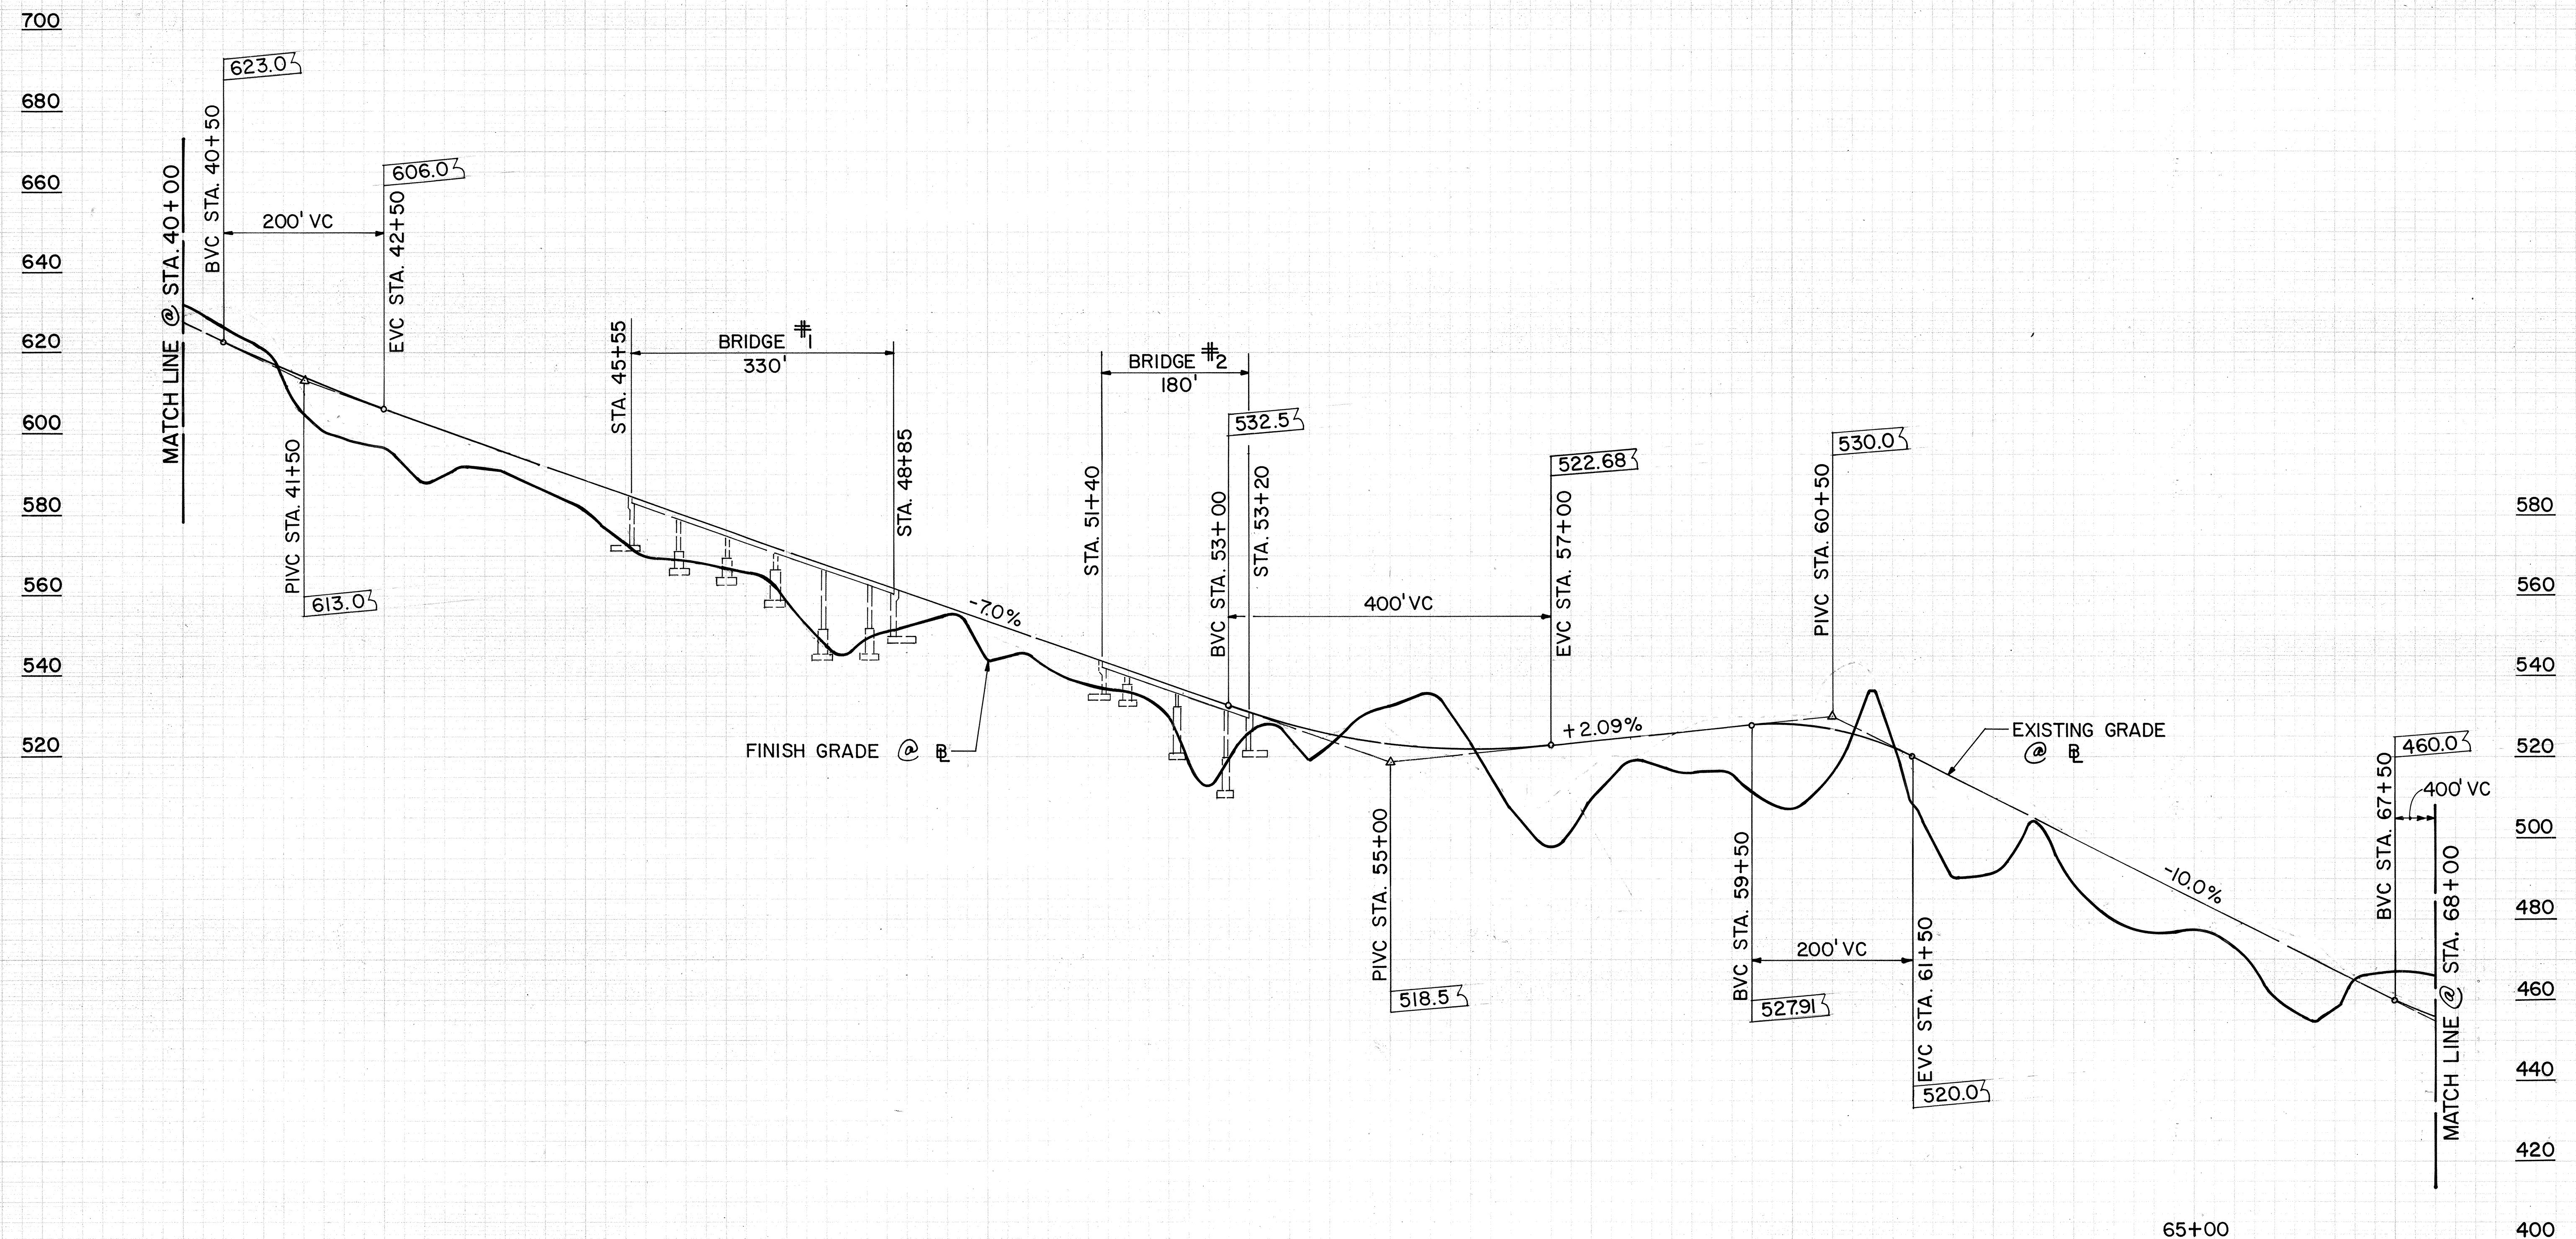

B PROFILE - HAIKU ACCESS RD.
 SCALE: HORIZ. 1"=100'
 VERT. 1"=20'

SURVEY PLOTTED BY	DATE
DRAWN BY	
DESIGNED BY	
NOTED BY	
CHECKED BY	
NO.	

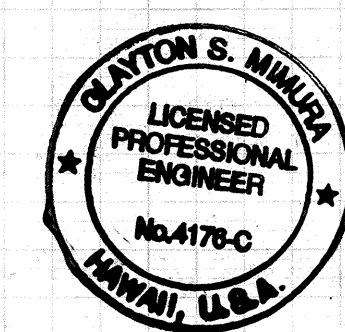


THIS WORK WAS PREPARED BY ME
 OR UNDER MY SUPERVISION.
Clayton S. Minner


10/27/95	Removed original ground line.
Date	Revision
STATE OF HAWAII DEPARTMENT OF TRANSPORTATION HIGHWAYS DIVISION HAIKU ACCESS ROAD RESTORATION PROFILE - 2 HAIKU ACCESS ROAD H-3 FINISH (UNIT III) FAIP NO. I-H3-I(75),UNIT III T.K. TUNNEL /ACCESS ROADS SCALE: AS SHOWN DATE: JUNE 1995	
SHEET NO.9C6 OF 18 SHEETS	

WORK DELETED FROM CONTRACT

FED. ROAD DIST. NO.	STATE	FED. AID PROJ. NO.	FISCAL YEAR	SHEET NO.	TOTAL SHEETS
HAWAII	HAW.	I-H3-(75), UNIT III	1994	ADD.333	353

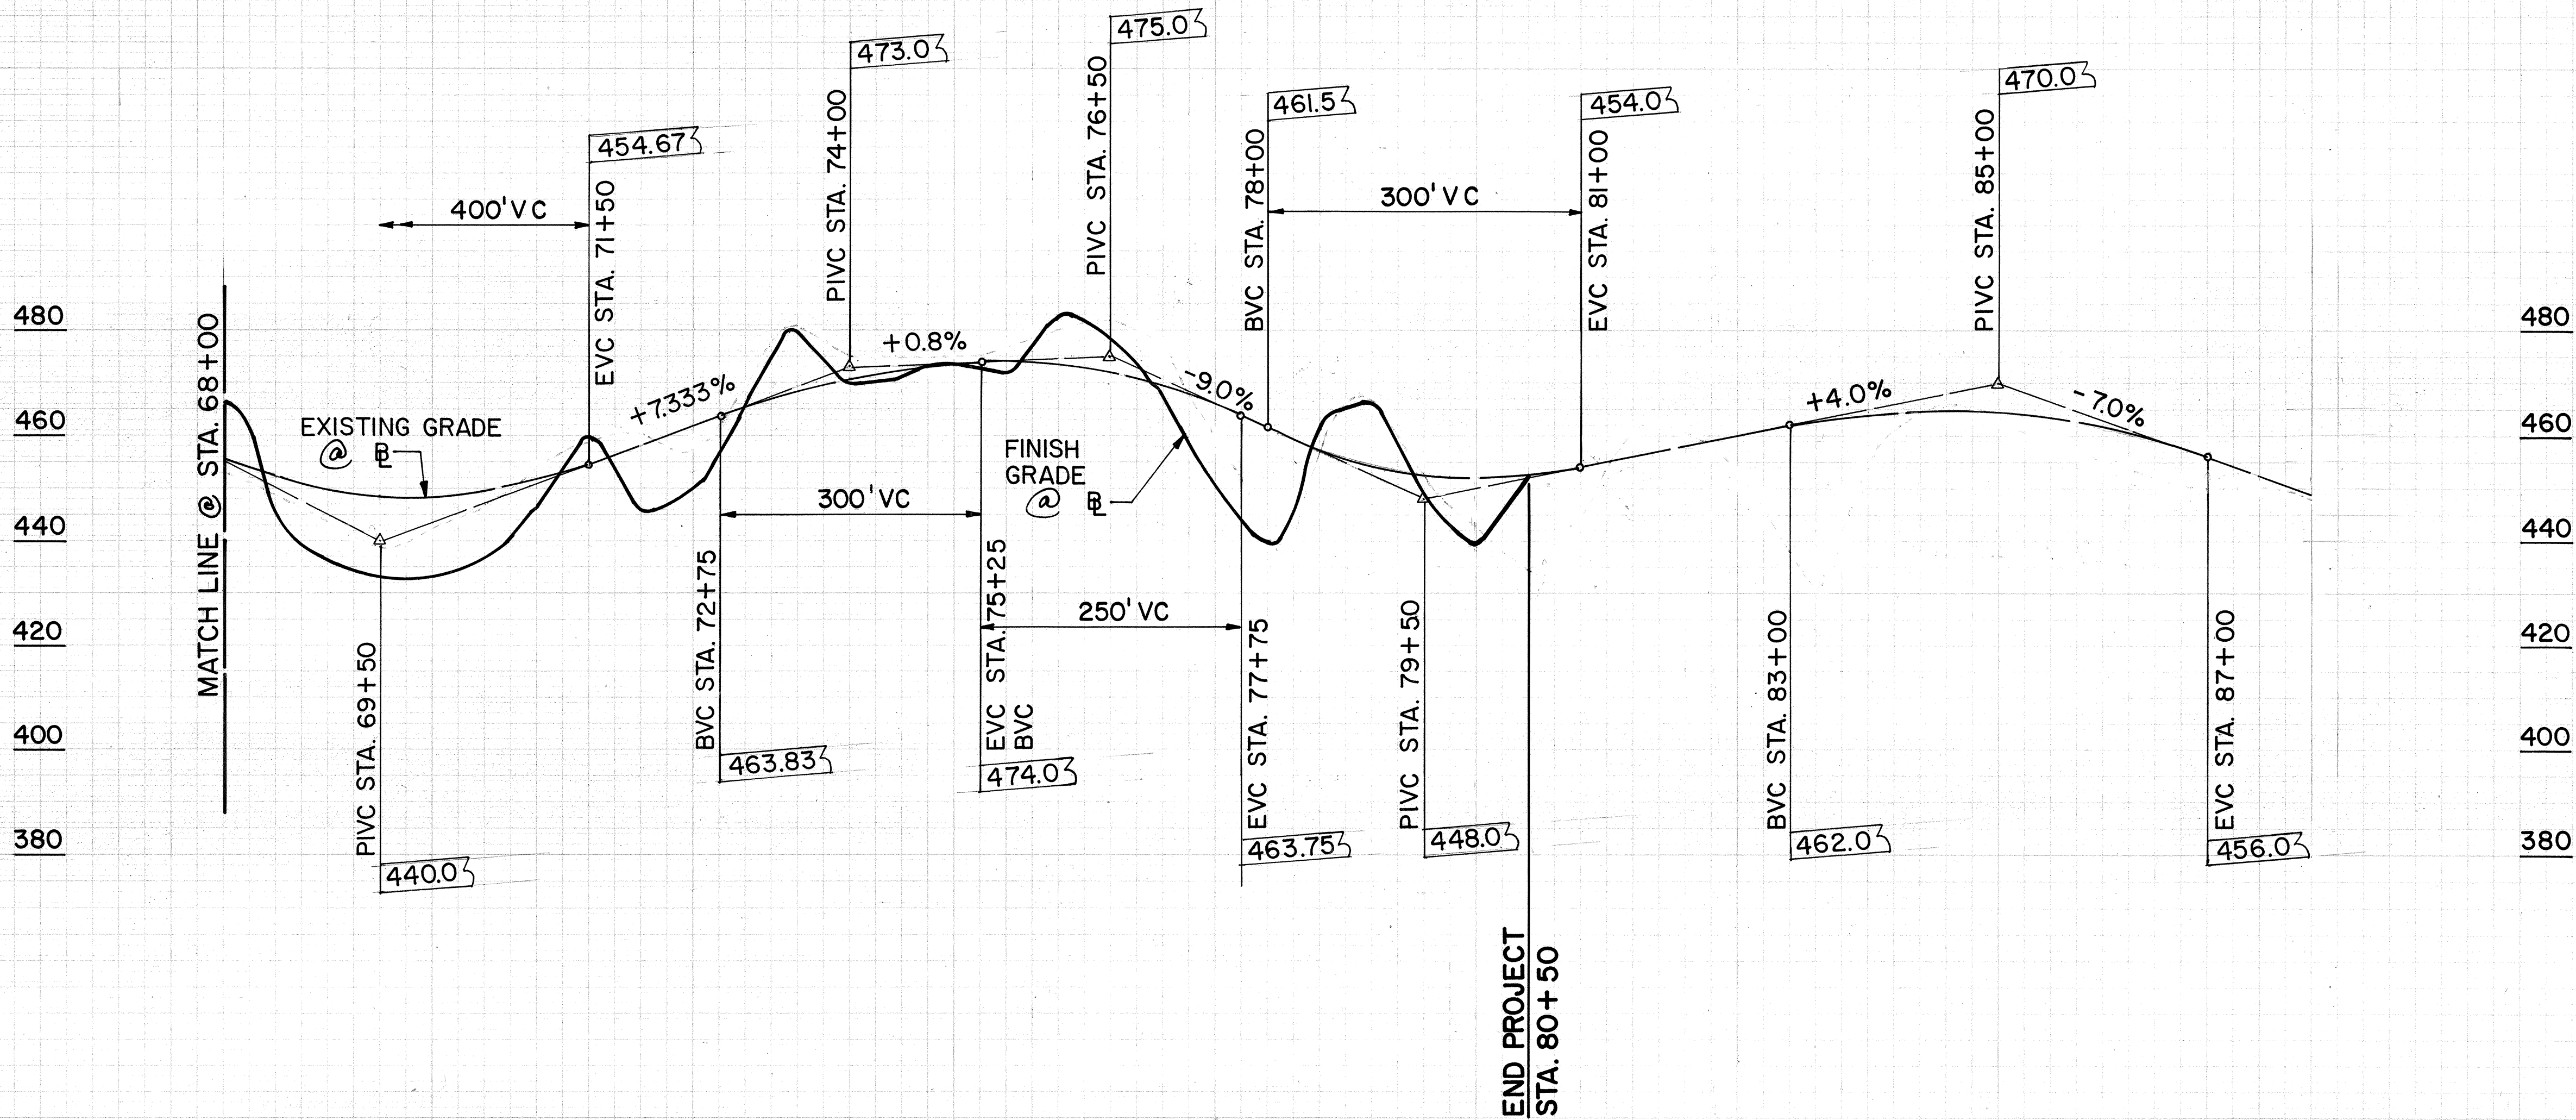

PROFILE - HAIKU ACCESS RD.
 SCALE: HORIZ. 1" = 100'
 VERT. 1" = 20'

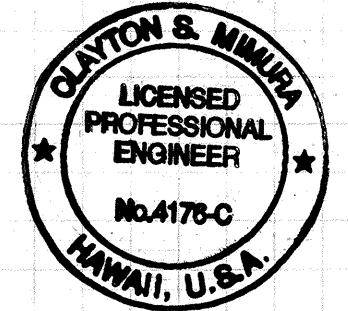

THIS WORK WAS PREPARED BY ME
 OR UNDER MY SUPERVISION.
Clayton S. Minner


10/27/95	Removed original ground line.
Date	Revision
STATE OF HAWAII DEPARTMENT OF TRANSPORTATION HIGHWAYS DIVISION HAIKU ACCESS ROAD RESTORATION PROFILE - 3 HAIKU ACCESS ROAD H-3 FINISH (UNIT III) FAIP NO. I-H3-I(75), UNIT III T.K. TUNNEL/ACCESS ROADS SCALE: AS SHOWN DATE: JUNE 1995	
SHEET No.9C7 OF 18 SHEETS	

SURVEY PLOTTED BY	DATE
DRAWN BY	
DESIGNED BY	
QUANTITIES BY	
CHECKED BY	
ORIGINAL PLAN	
NOTE BOOK	
No.	

WORK DELETED FROM CONTRACT

FED. ROAD DIST. NO.	STATE	FED. AID PROJ. NO.	FISCAL YEAR	SHEET NO.	TOTAL SHEETS
HAWAII	HAW.	I-H3-1(75), UNIT III	1994	ADD. 334	353

LEGEND:
[Hatched Box] RESTORE
[Hatched Box] REMOVE

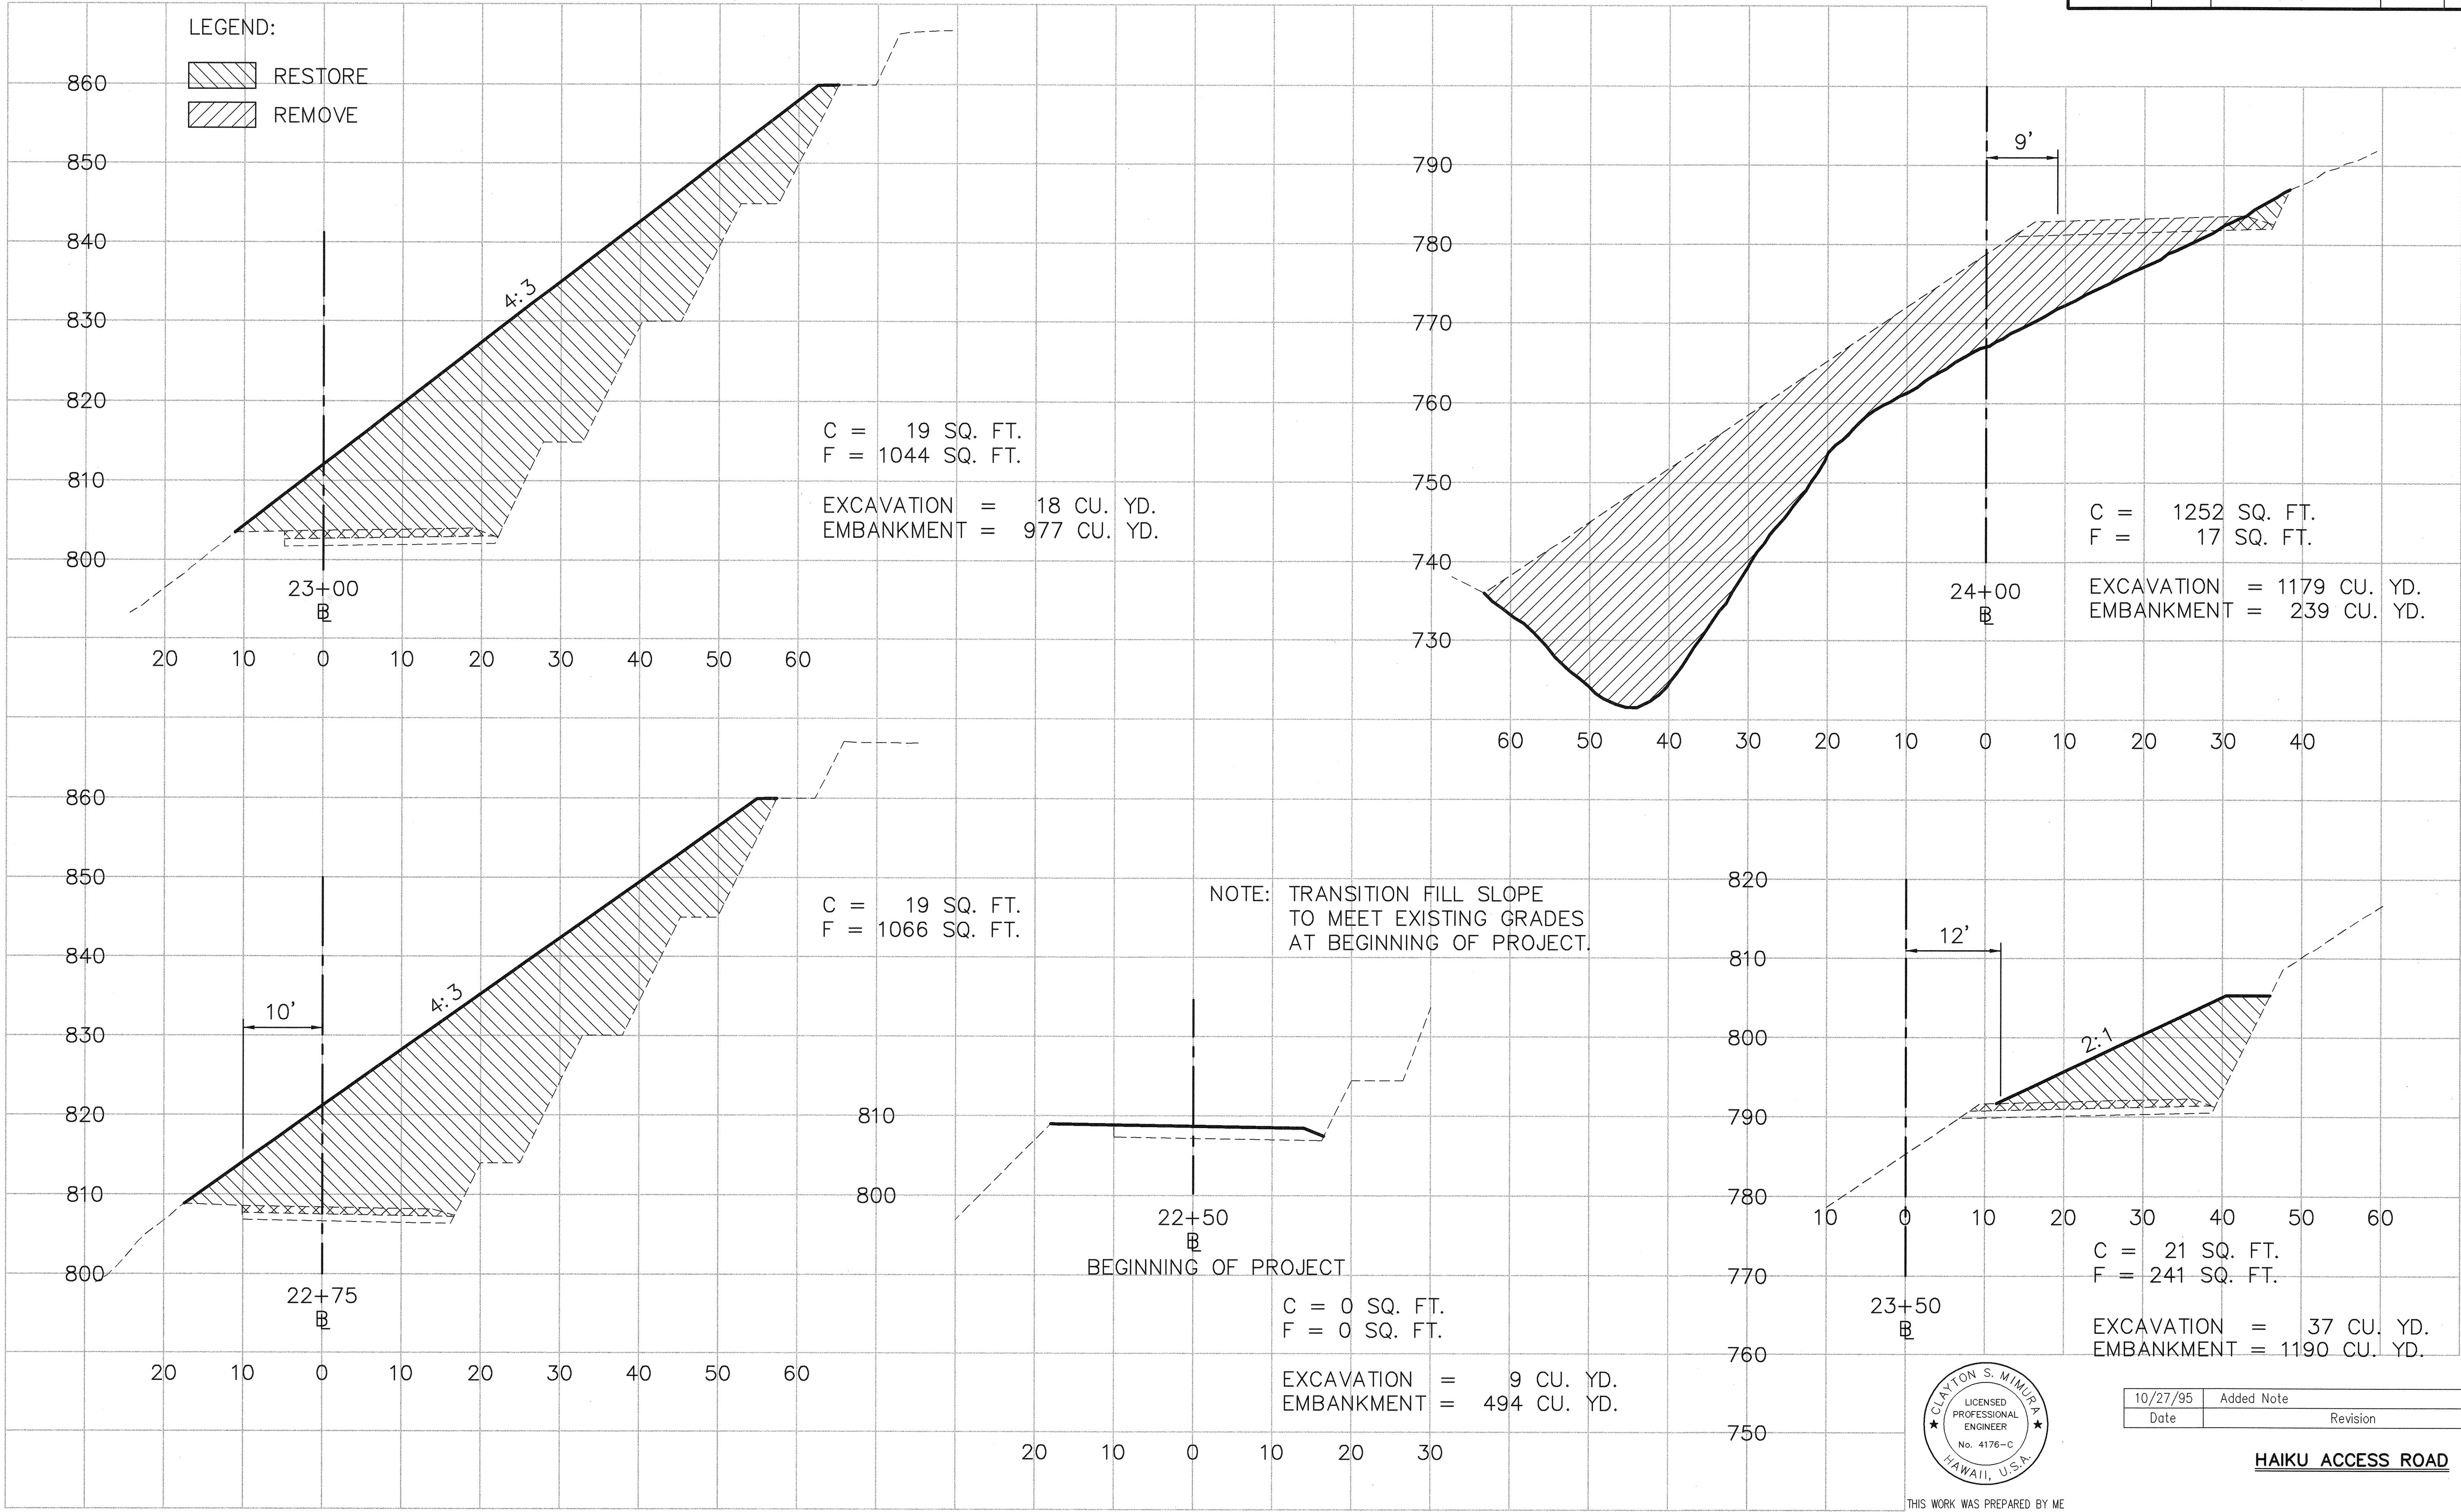

NOTE: TRANSITION FILL SLOPE TO MEET EXISTING GRADES AT BEGINNING OF PROJECT.

BEGINNING OF PROJECT



THIS WORK WAS PREPARED BY ME OR UNDER MY SUPERVISION.

Clayton S. Mimura

10/27/95	Added Note
Date	Revision

HAIKU ACCESS ROAD

Scale: Horiz. 1" = 10', Vert. 1" = 10'

SHEET NO. 908 OF 18 SHEETS


ADD.334

WORK DELETED FROM CONTRACT

ORIGINAL PLAN
DESIGNED BY
CHECKED BY
DATE
NO.

CAD by J. Minura, 5/9-92

FED. ROAD DIST. NO.	STATE	FED. AID PROJ. NO.	FISCAL YEAR	SHEET NO.	TOTAL SHEETS
HAWAII	HAW.	I-H3-1(75), UNIT III	1994	335	353

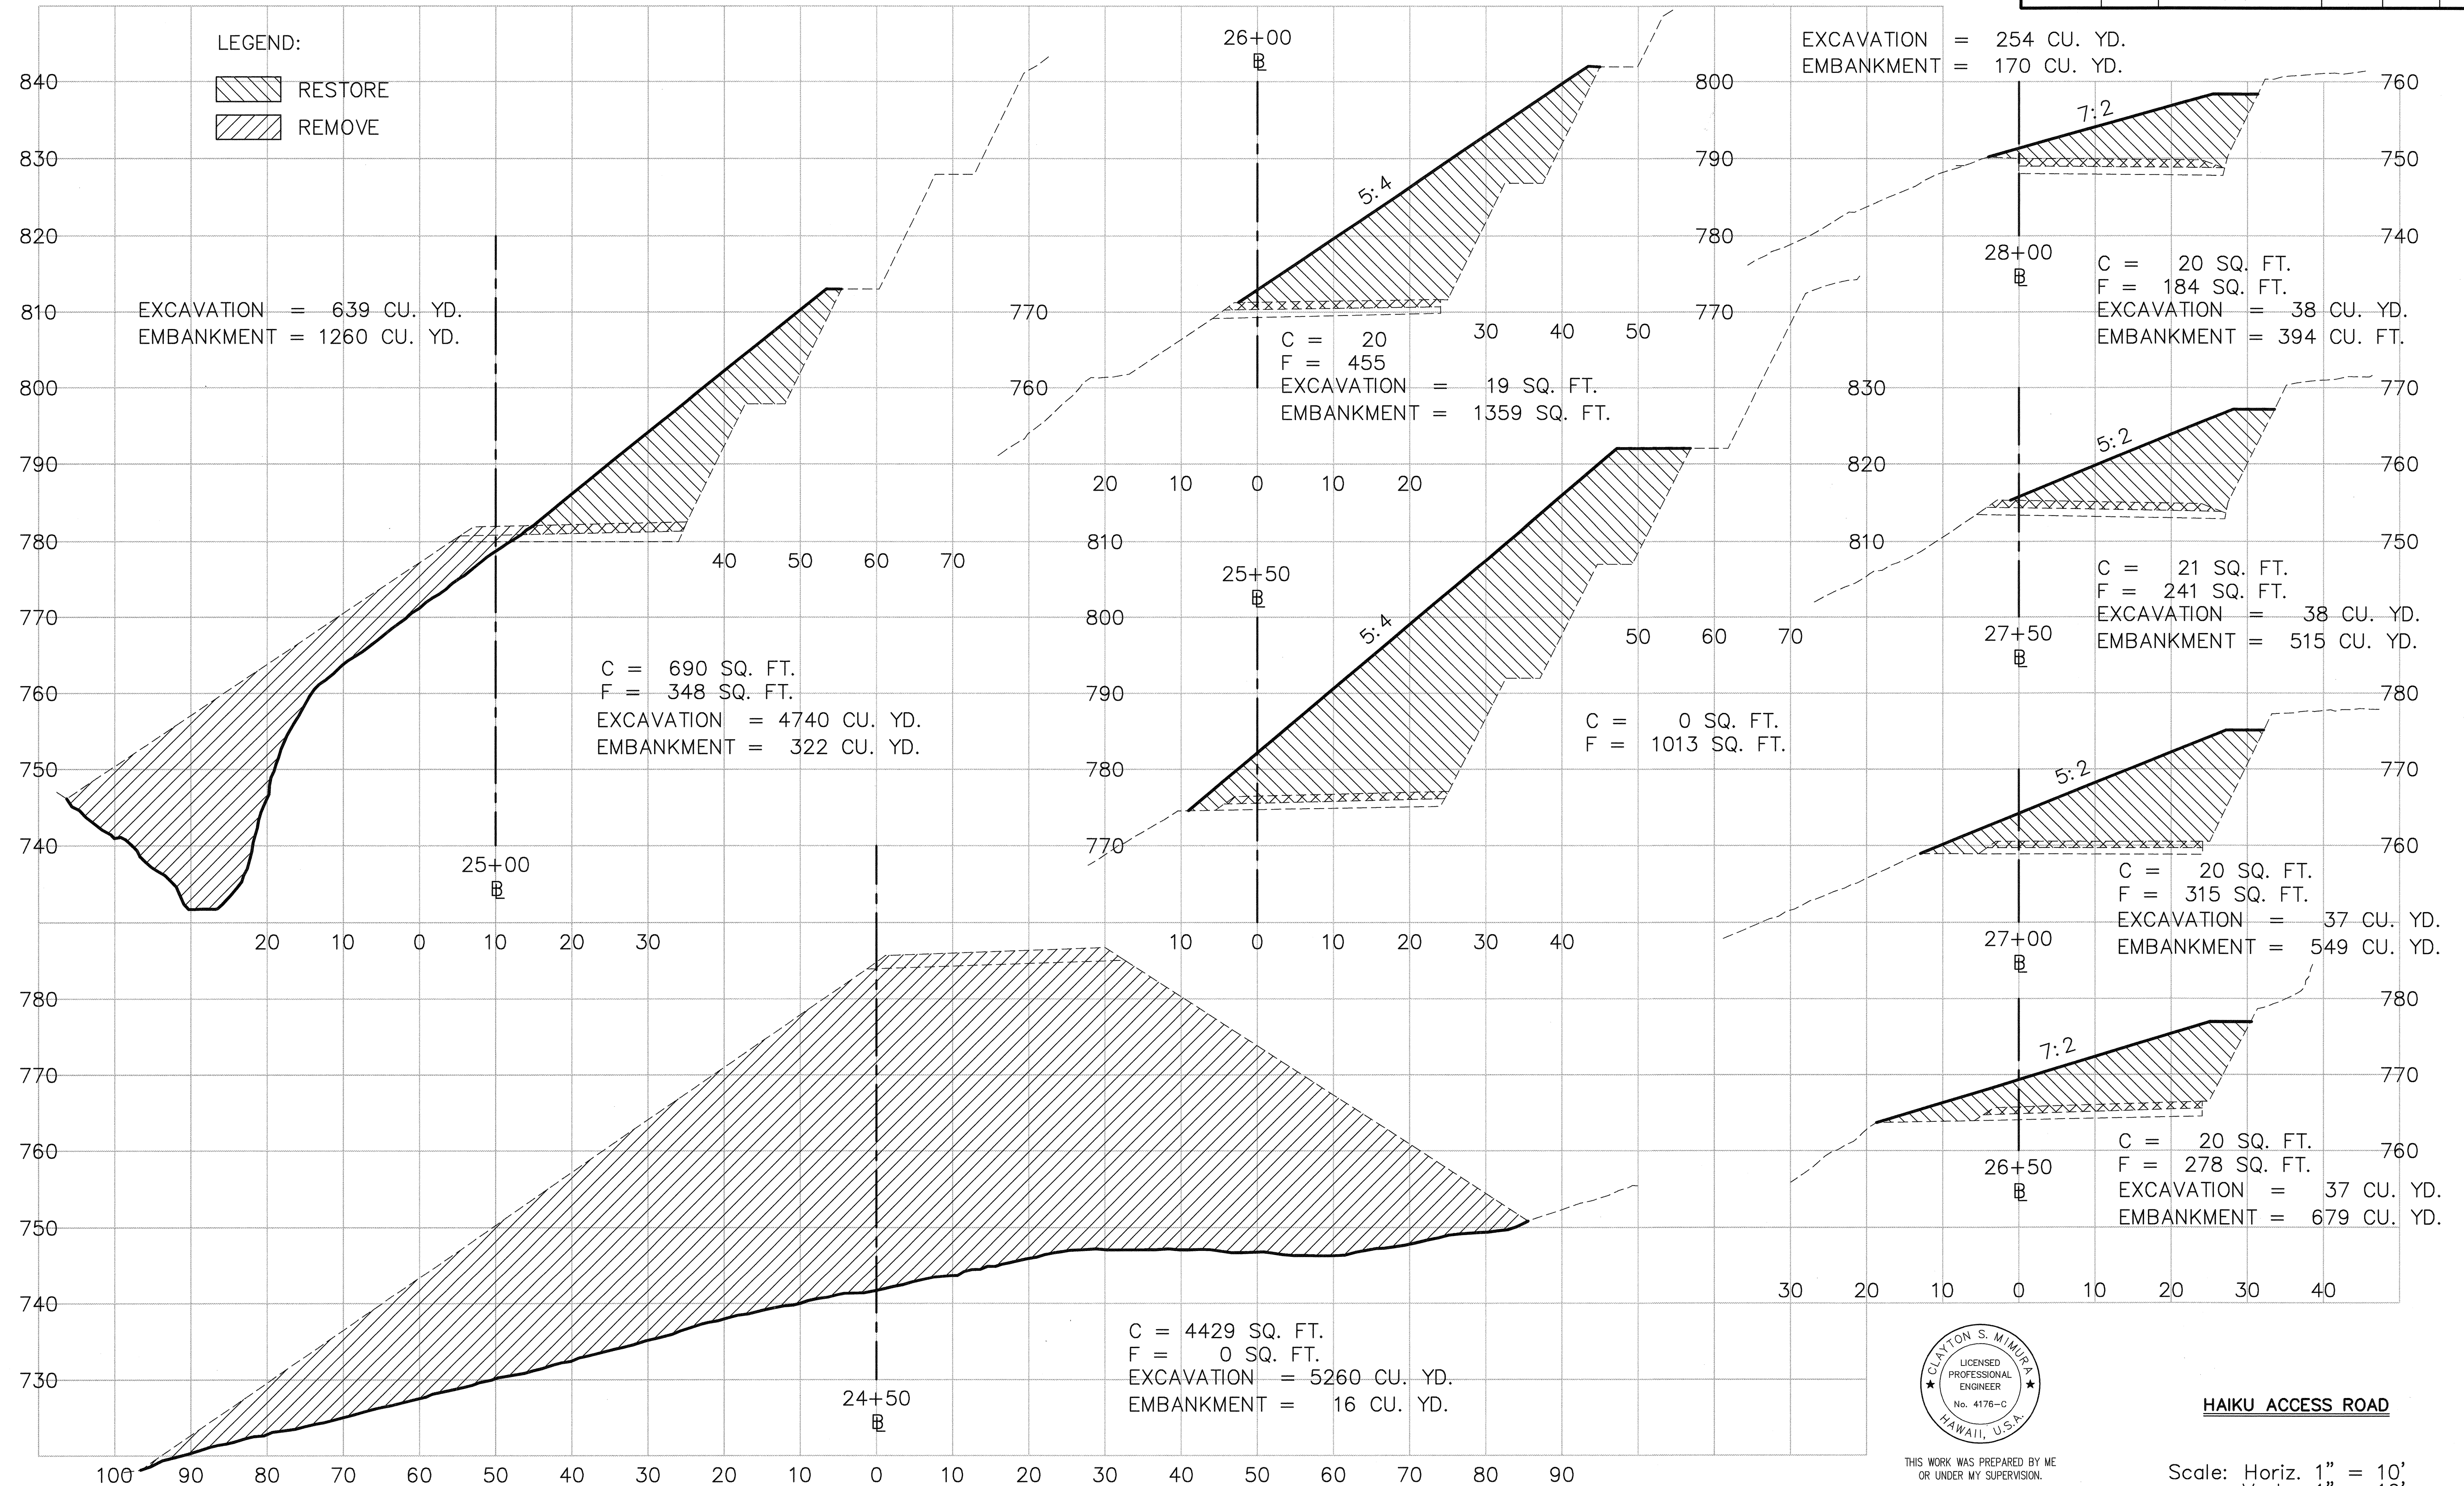

ORIGINAL PLAN	SURVEY PLOTTED BY _____ DATE _____
NOTE BOOK	DRAWN BY _____
	TRACED BY _____
	DESIGNED BY _____
	QUANTITIES BY _____
No. _____	CHECKED BY _____

CAD by J. Mimura. 55-52

Last Saved: J:\H3RF\U3\HQVM\XSEC02A.dwg 06/15/95 at 16:4



THIS WORK WAS PREPARED BY ME
OR UNDER MY SUPERVISION.

Clayton S. Hummer

HAIKU ACCESS ROAD



Scale: Horiz. 1" = 10'
Vert. 1" = 10'

SHEET NO. 9C9 OF 18 SHEETS

335

FED. ROAD DIST. NO.	STATE	FED. AID PROJ. NO.	FISCAL YEAR	SHEET NO.	TOTAL SHEETS
HAWAII	HAW.	I-H3-1(75), UNIT III	1994	336	353

ORIGINAL PLAN	DATE
DESIGNED BY	
TRACED BY	
NOTED BY	
CHECKED BY	
NO.	

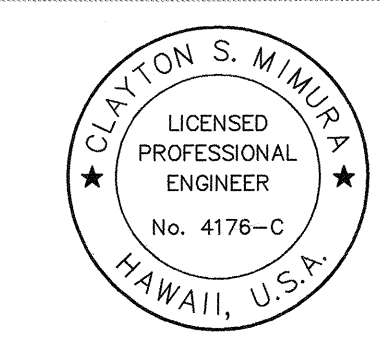
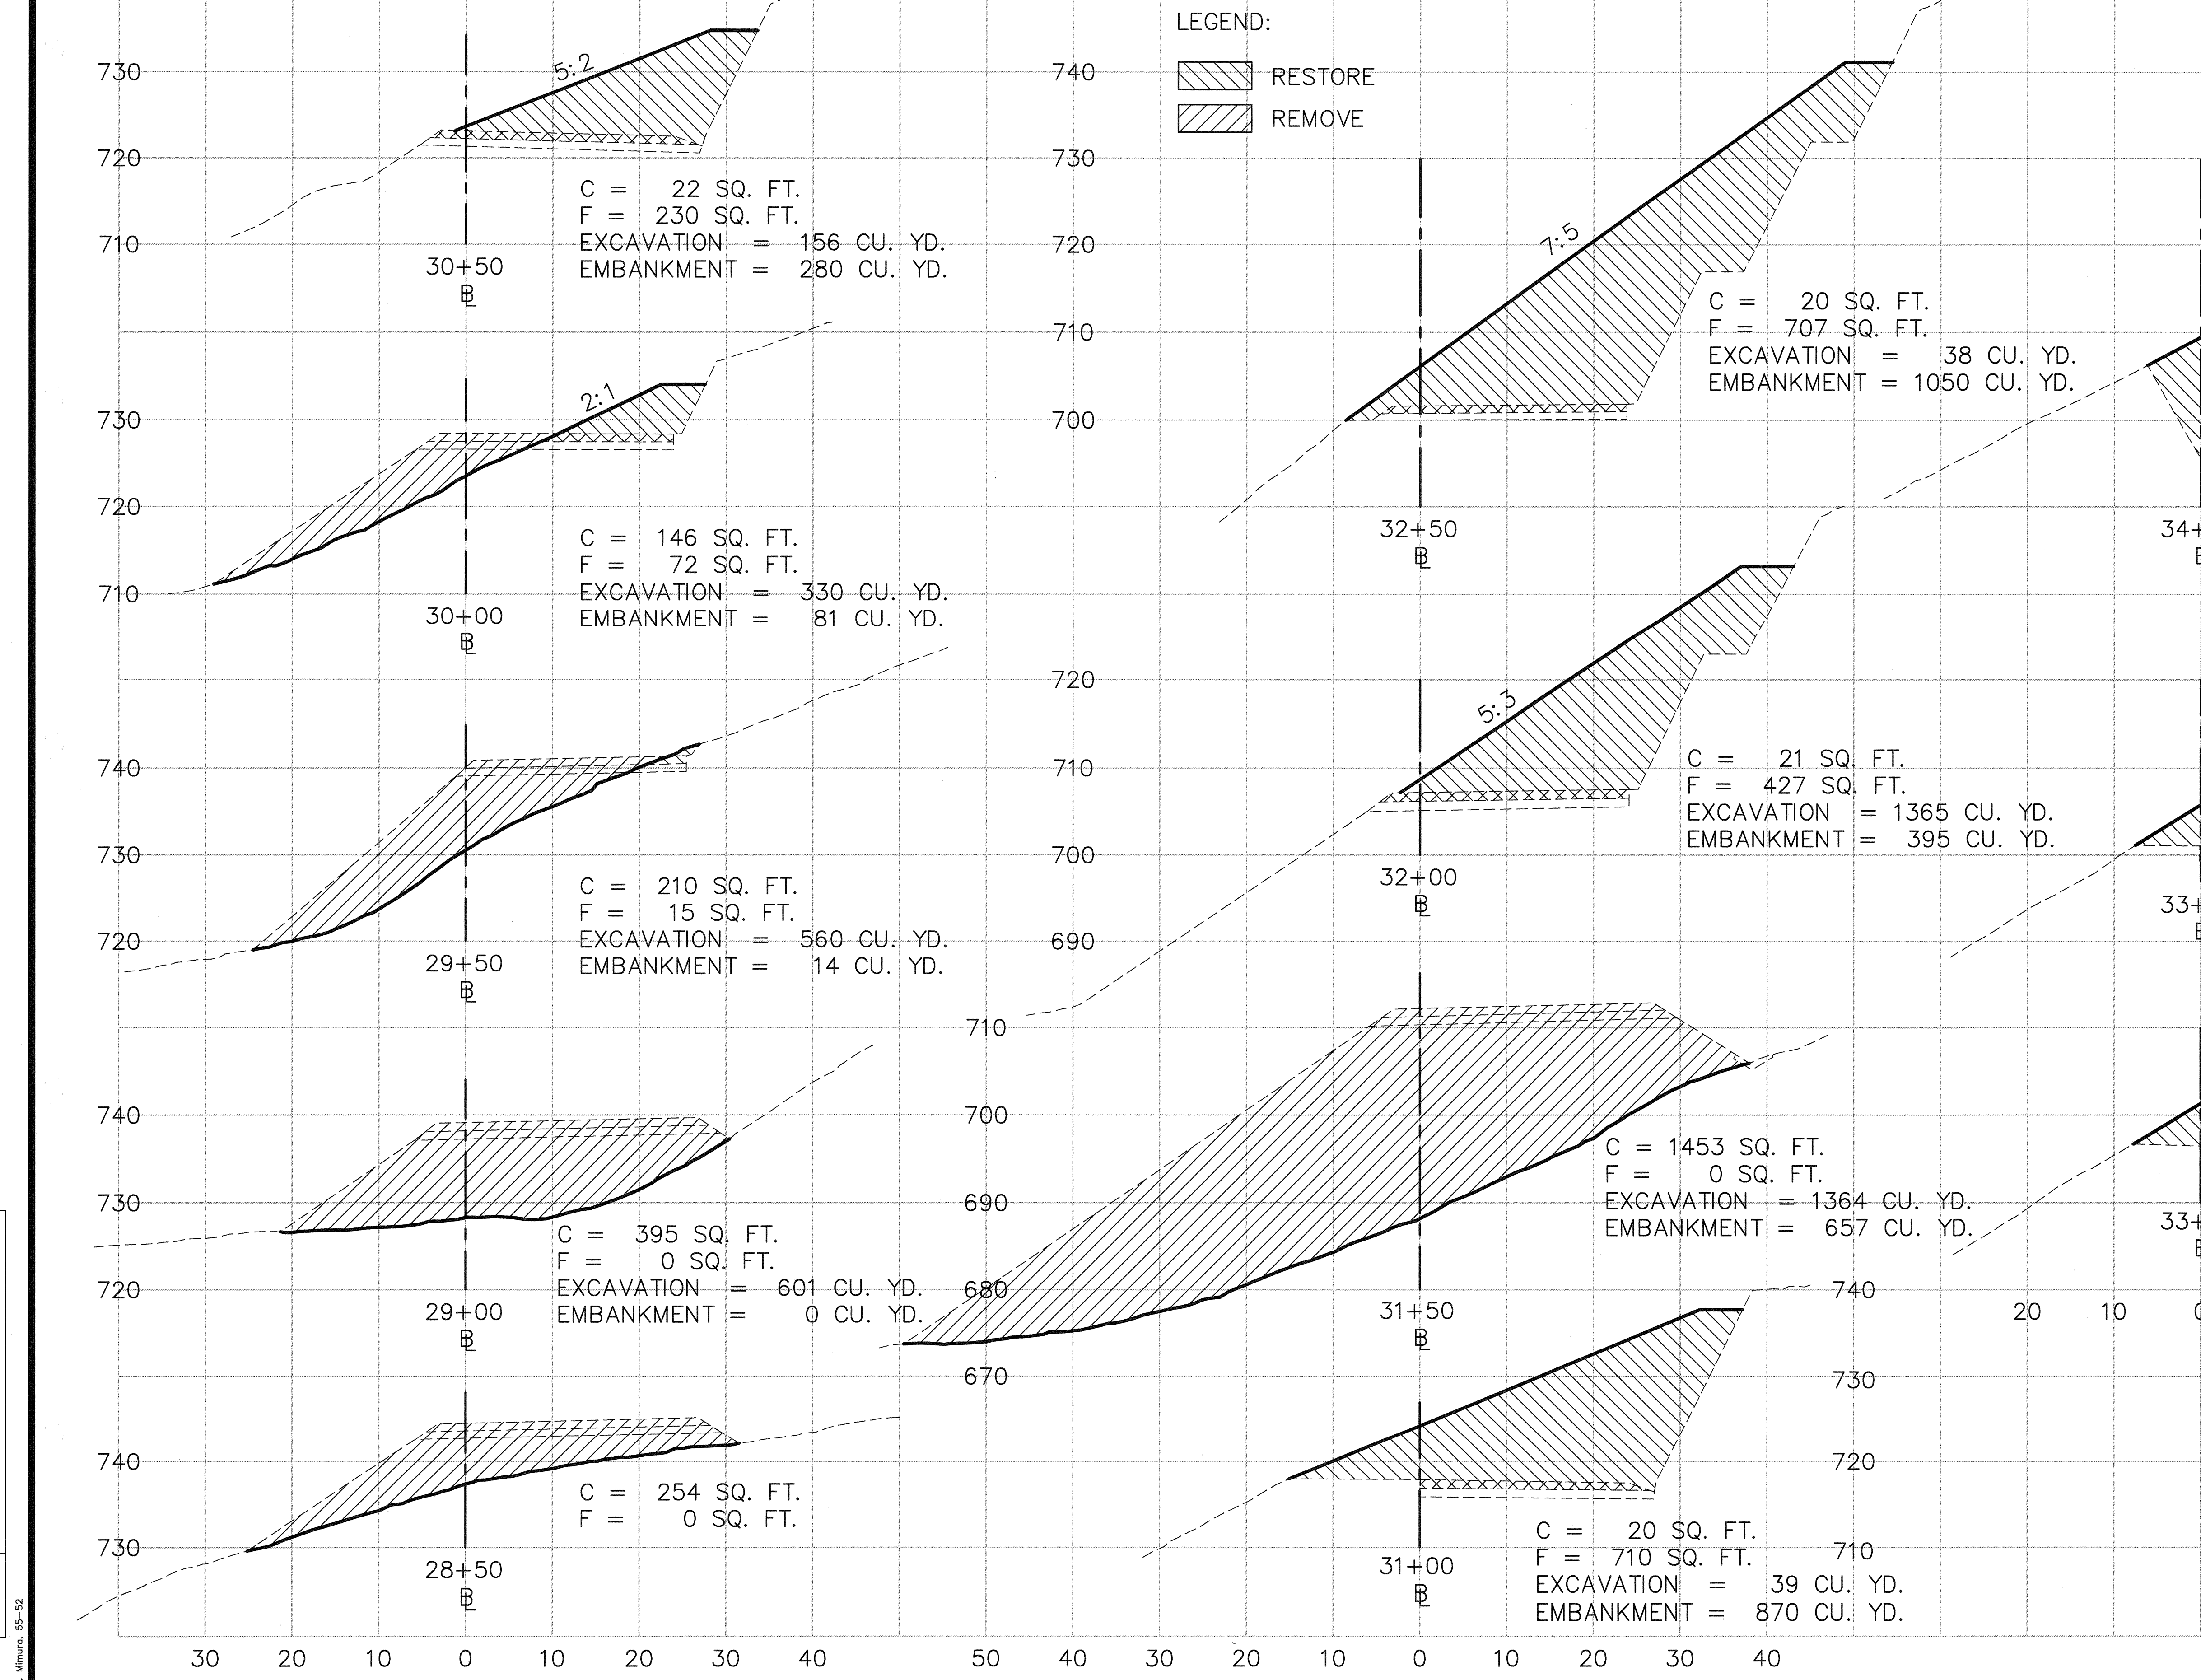


THIS WORK WAS PREPARED BY ME OR UNDER MY SUPERVISION.
Clayton S. Minura

HAIKU ACCESS ROAD
Scale: Horiz. 1" = 10'
Vert. 1" = 10'
SHEET NO. 9C10 OF 18 SHEETS

WORK DELETED FROM CONTRACT

FED. ROAD DIST. NO.	STATE	FED. AID PROJ. NO.	FISCAL YEAR	SHEET NO.	TOTAL SHEETS
HAWAII	HAW.	I-H3-1(75), UNIT III	1994	ADD. 337	353

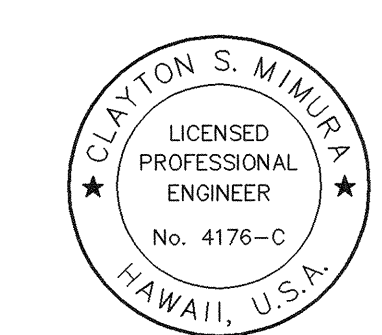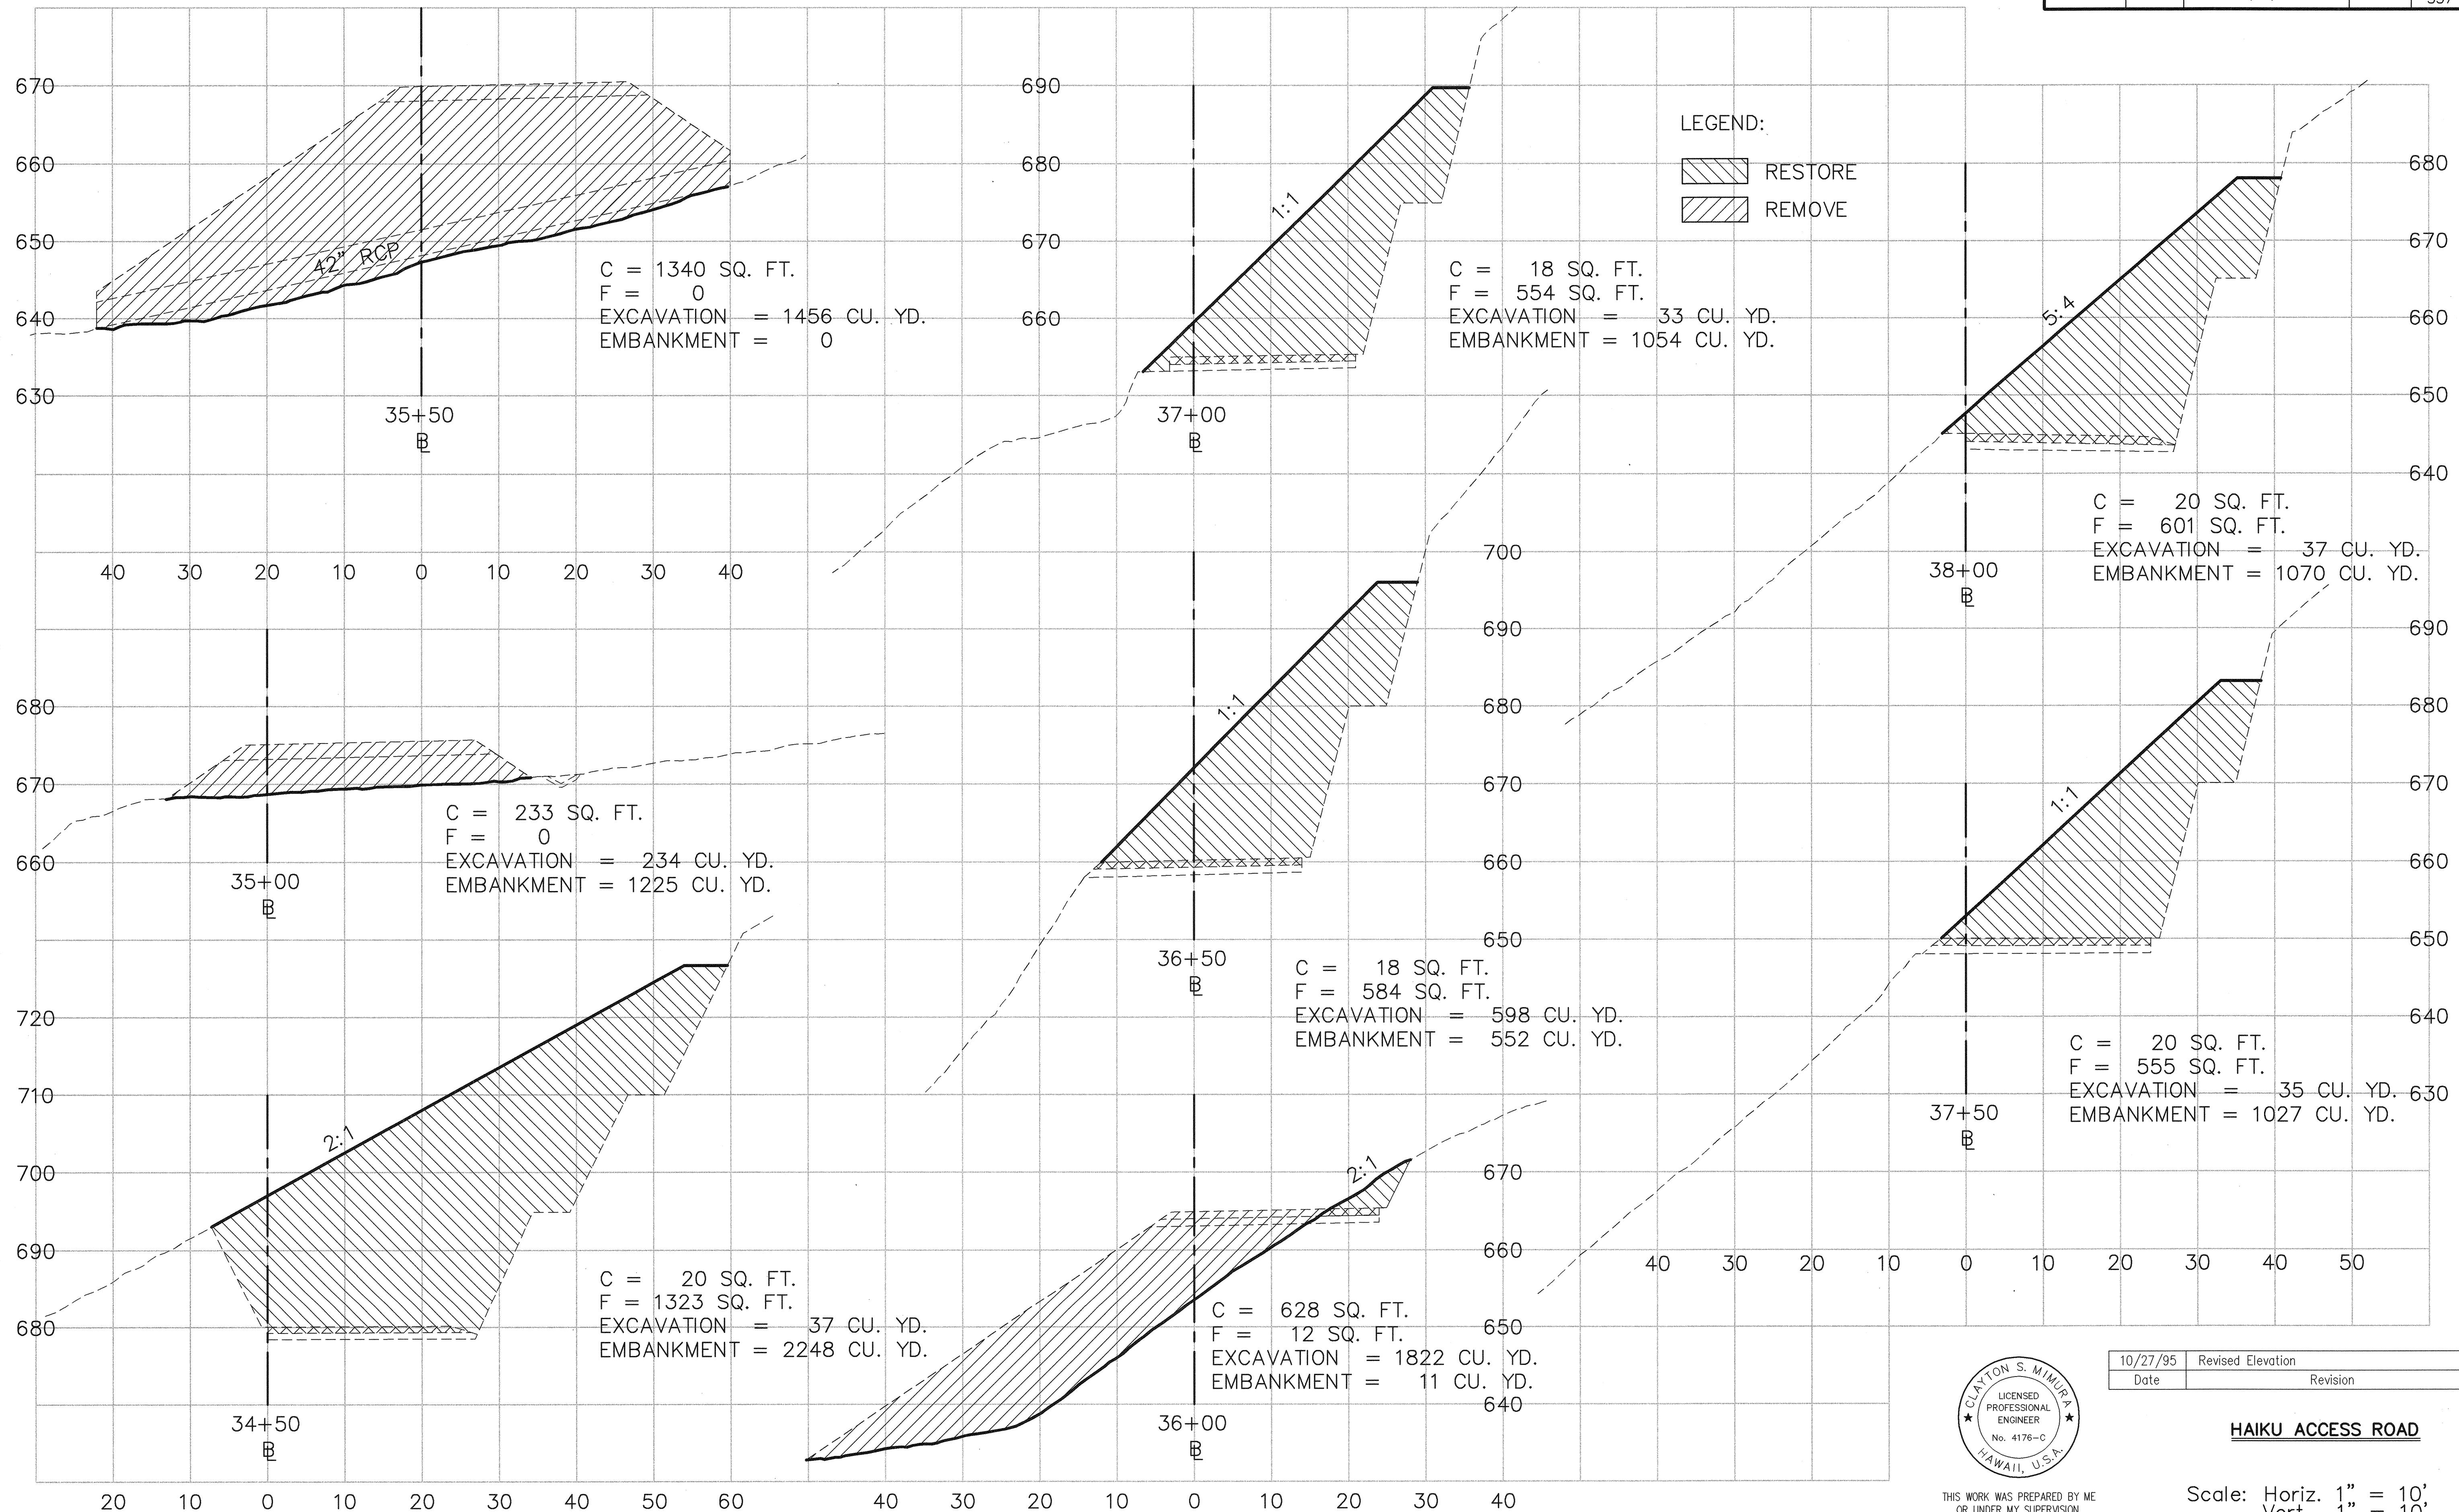

10/27/95	Revised Elevation
Date	Revision

HAIKU ACCESS ROAD

THIS WORK WAS PREPARED BY ME OR UNDER MY SUPERVISION.

Scale: Horiz. 1" = 10'
Vert. 1" = 10'

Clayton S. Mimura

SHEET NO. 9C11 OF 18 SHEETS


WORK DELETED FROM CONTRACT

ADD.337

SURVEY PLOTTED BY	DATE
DESIGNED BY	
NOTED BY	
QUANTITIES BY	
CHECKED BY	

640 by J. Mimura, 55-52

FED. ROAD DIST. NO.	STATE	FED. AID PROJ. NO.	FISCAL YEAR	SHEET NO.	TOTAL SHEETS
HAWAII	HAW.	I-H3-1(75), UNIT III	1994	338	353

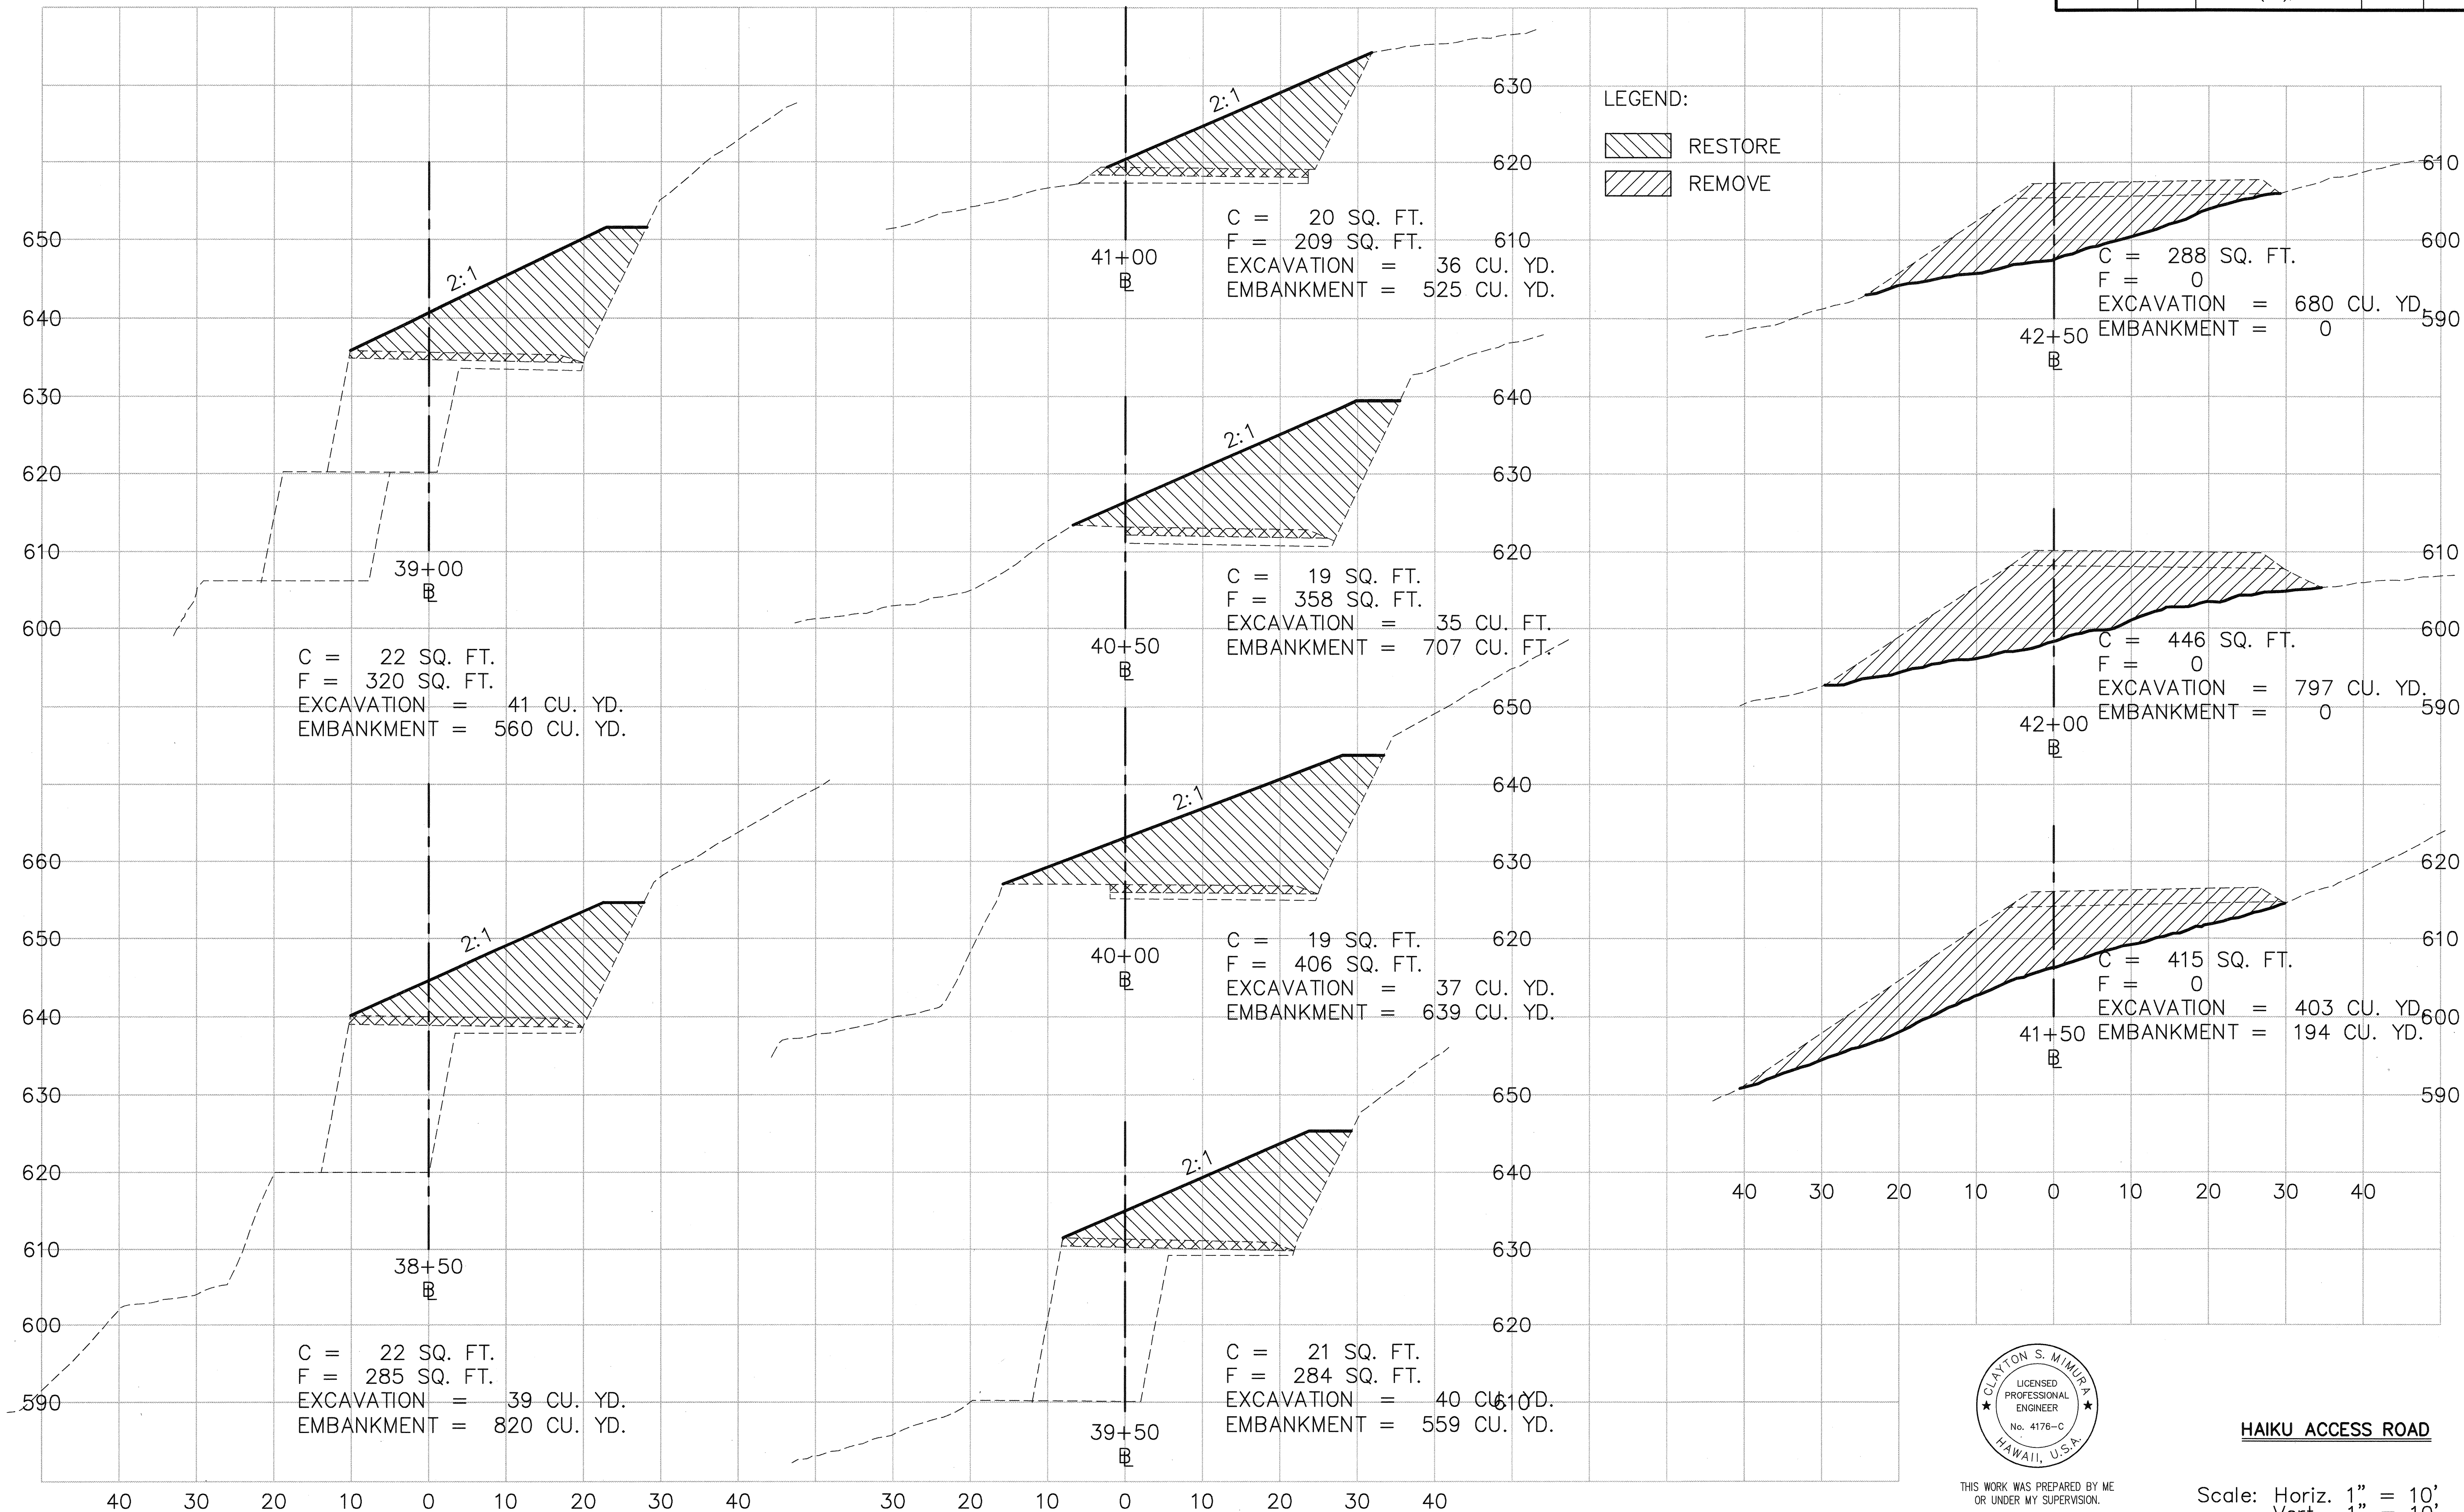


ORIGINAL PLAN
 DATE
 DESIGNED BY
 CHECKED BY
 NO.

CAD by J. MINURA, 55-52

Last Saved: J:\H3RF\U3\H3VM\XSEC05A.dwg 06/15/95 at 16:41

WORK DELETED FROM CONTRACT

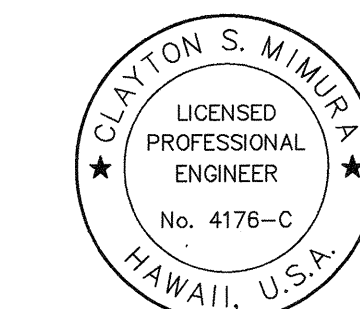

THIS WORK WAS PREPARED BY ME
 OR UNDER MY SUPERVISION.


Clayton S. Minura

HAIKU ACCESS ROAD

Scale: Horiz. 1" = 10'
 Vert. 1" = 10'

SHEET NO. 9C12 OF 18 SHEETS

FED. ROAD DIST. NO.	STATE	FED. AID PROJ. NO.	FISCAL YEAR	SHEET NO.	TOTAL SHEETS
HAWAII	HAW.	I-H3-1(75), UNIT III	1994	339	353

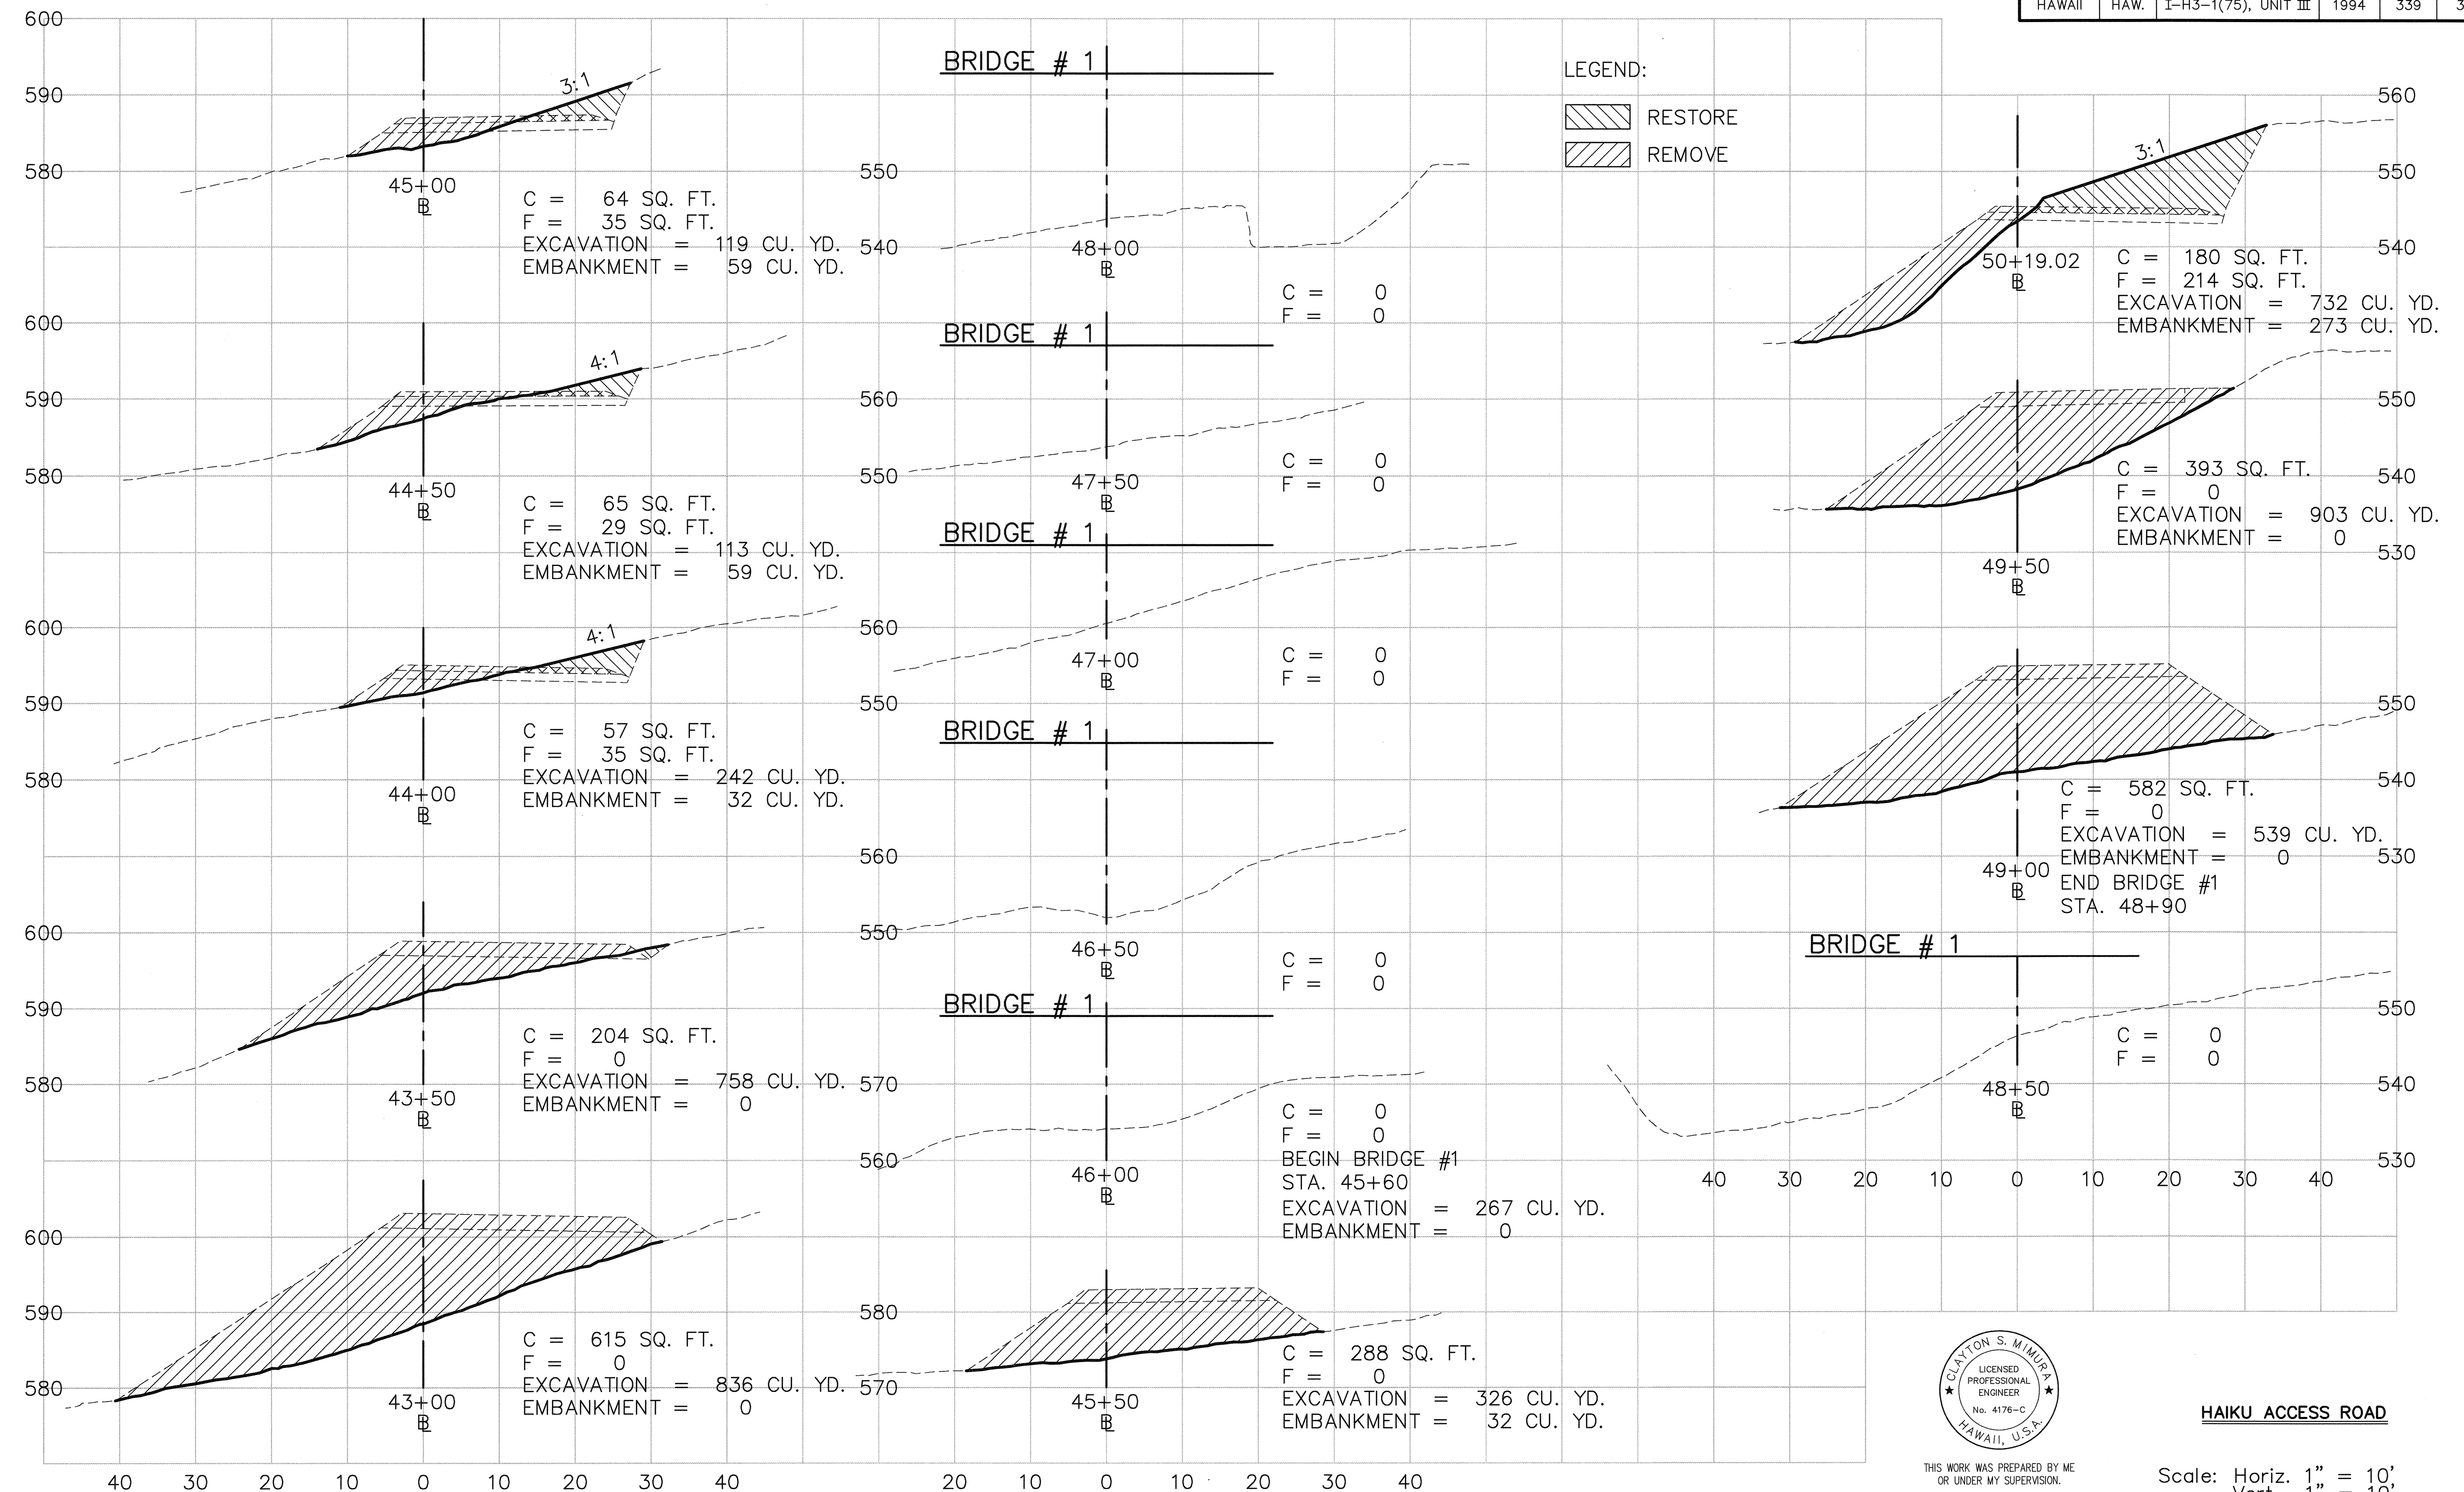

ORIGINAL PLAN	SURVEY PLOTTED BY _____ DATE _____
NOTE BOOK	DRAWN BY _____
	TRACED BY _____
	DESIGNED BY _____
	QUANTITIES BY _____
No. _____	CHECKED BY _____

CAD by C. Rivera, 55-52

Last Saved: J:\H3RF\U3\HQVM\XSEC06A.dwg 06/15/95 at 16:40



THIS WORK WAS PREPARED BY ME
OR UNDER MY SUPERVISION.

HAIKU ACCESS ROAD


Scale: Horiz. $1'' = 10'$
Vert. $1'' = 10'$

SHEET NO. 9C13 OF 18 SHEETS

339

WORK DELETED FROM CONTRACT

FED. ROAD DIST. NO.	STATE	FED. AID PROJ. NO.	FISCAL YEAR	SHEET NO.	TOTAL SHEETS
HAWAII	HAW.	I-H3-1(75), UNIT III	1994	340	353

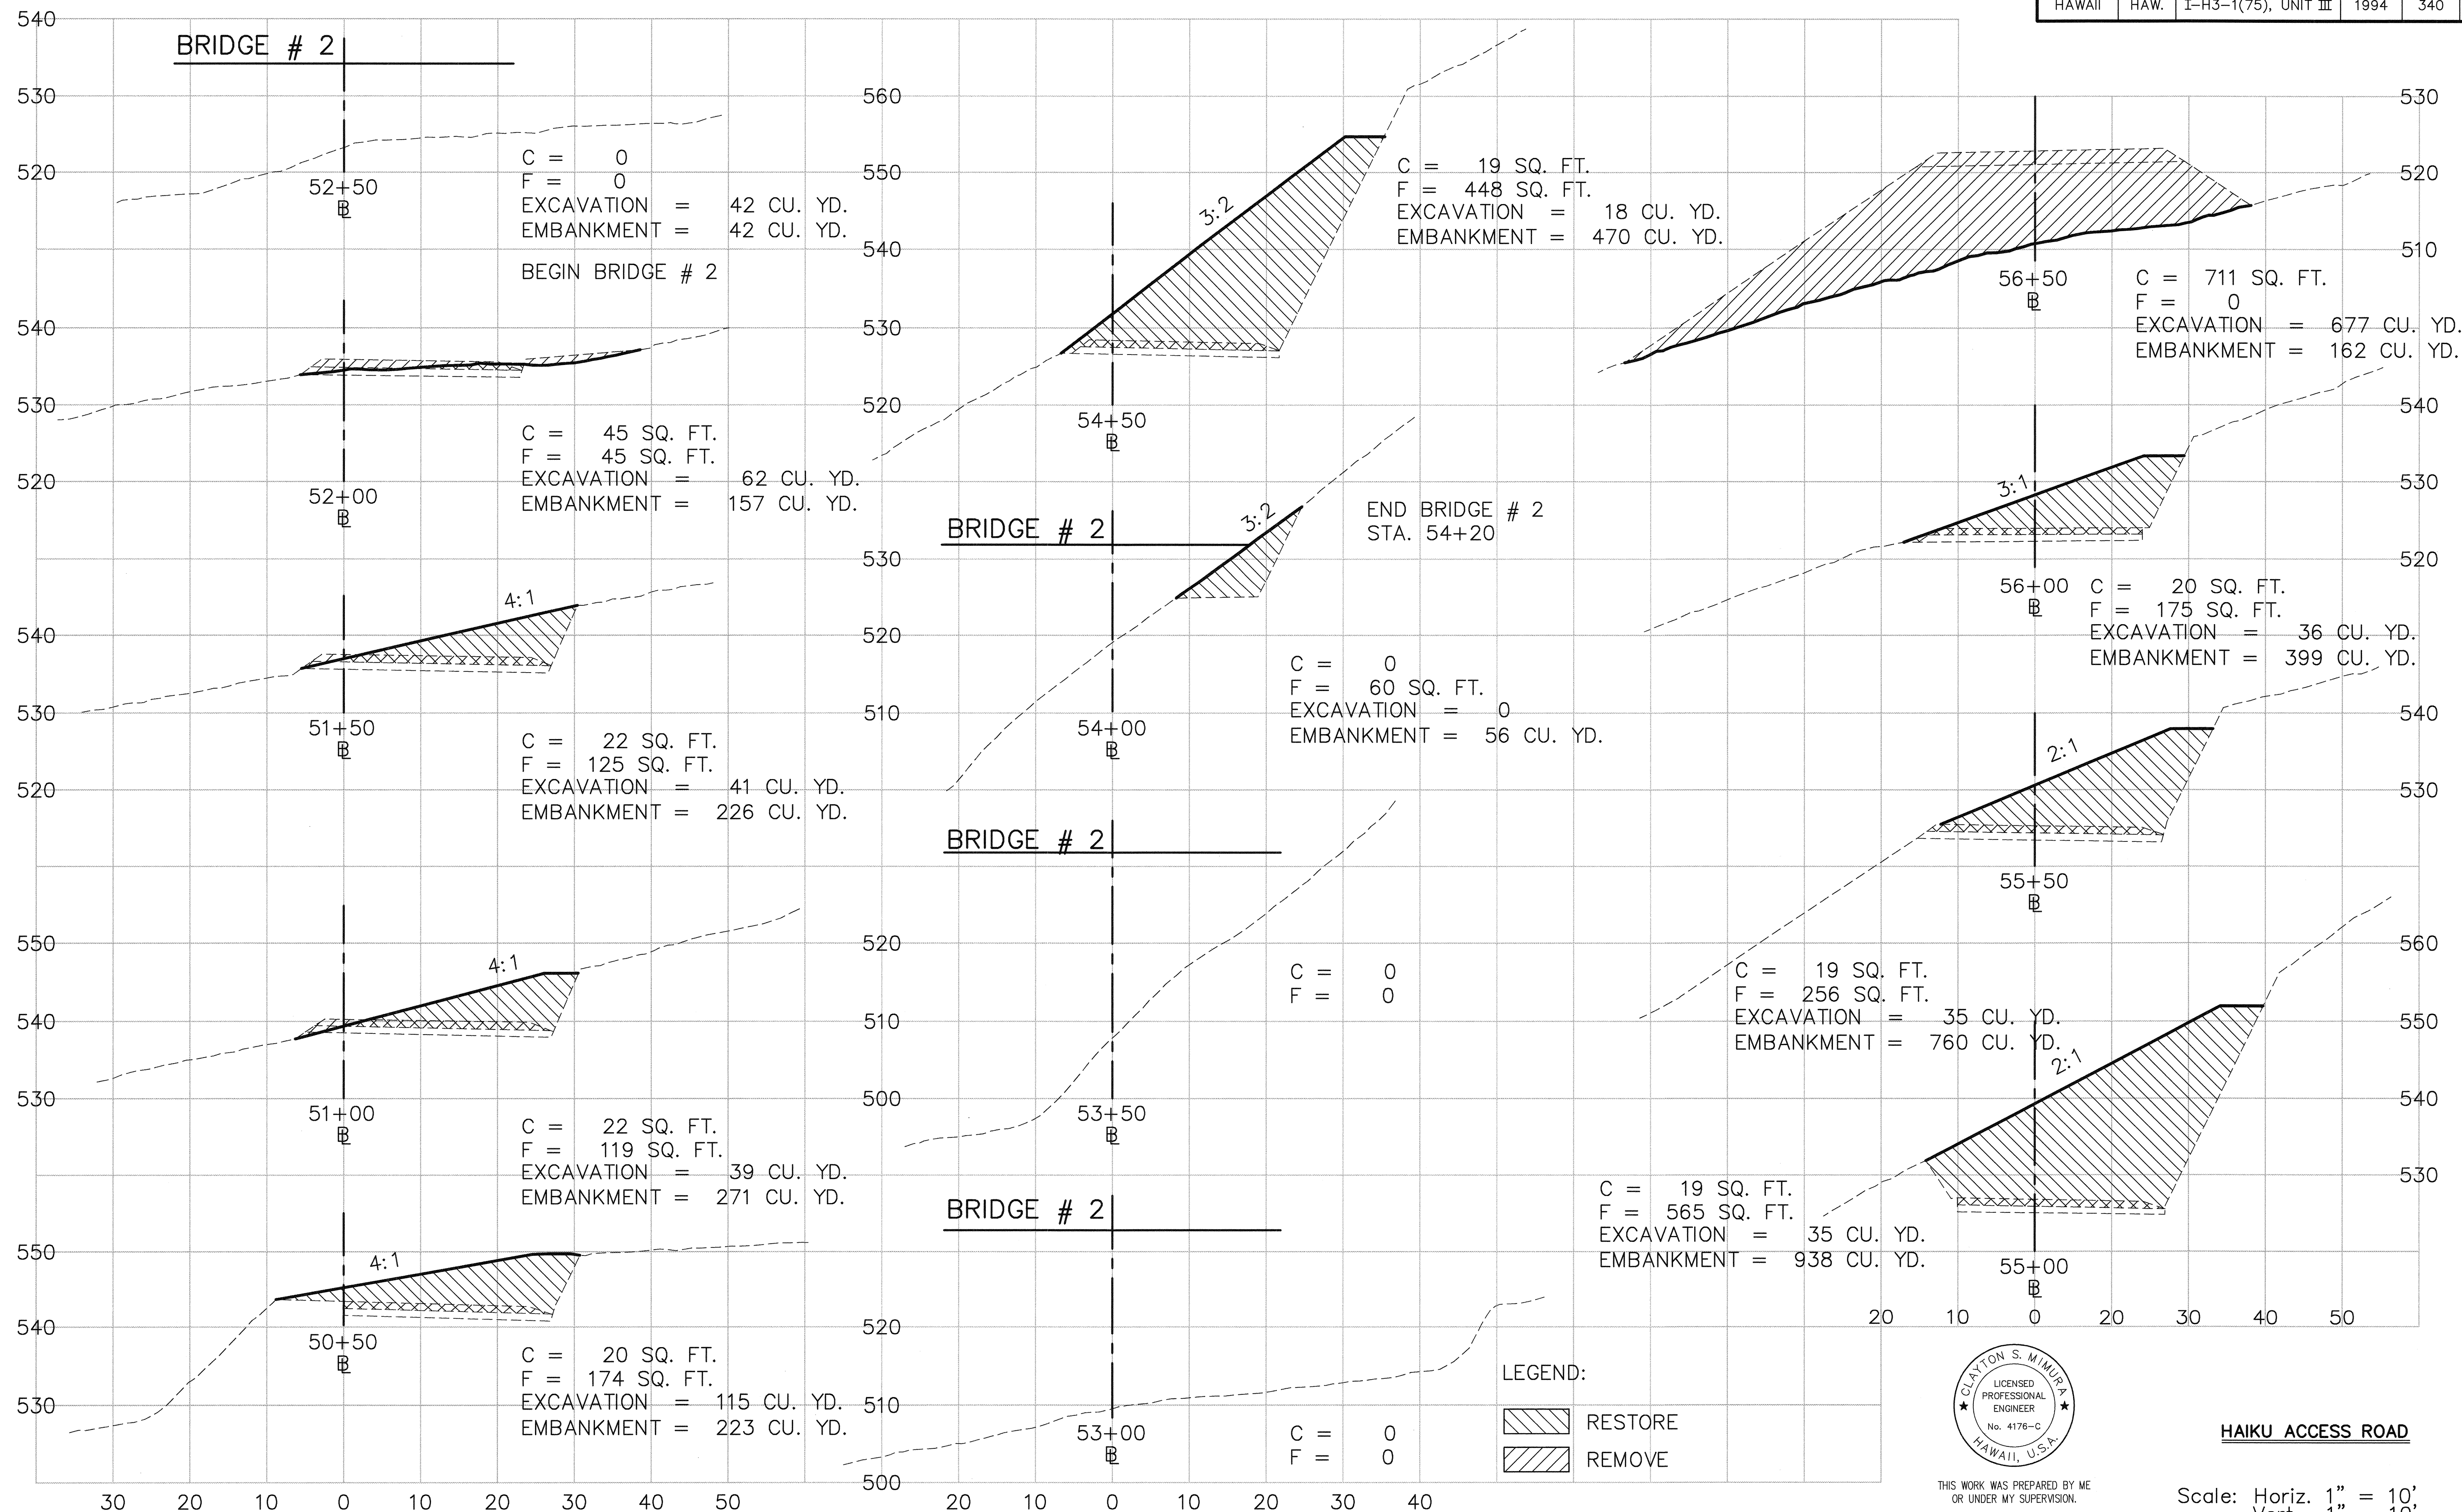

ORIGINAL PLAN
 DATE
 DESIGNED BY
 CHECKED BY
 NO.

Survey Plotted by
 Date
 Checked by
 No.

WORK DELETED FROM CONTRACT


THIS WORK WAS PREPARED BY ME
 OR UNDER MY SUPERVISION.

Clayton S. Minura

Scale: Horiz. 1" = 10',
 Vert. 1" = 10'

SHEET NO. 9C14 OF 18 SHEETS

ORIGINAL PLAN	SURVEY PLOTTED BY _____ DATE _____	
	DRAWN BY _____	
NOTE BOOK	TRACED BY _____	
	DESIGNED BY _____	
	QUANTITIES BY _____	
	CHECKED BY _____	
No. _____		

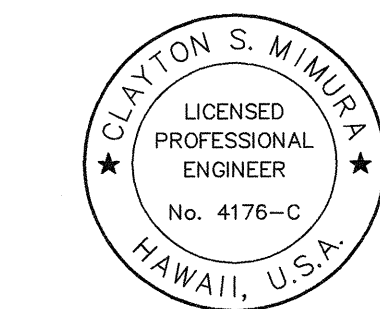



THIS WORK WAS PREPARED BY ME
OR UNDER MY SUPERVISION.

Scale: Horiz. 1" = 10'
Vert. 1" = 10'

SHEET NO. 9C15 OF 18 SHEETS

341

FED. ROAD DIST. NO.	STATE	FED. AID PROJ. NO.	FISCAL YEAR	SHEET NO.	TOTAL SHEETS
HAWAII	HAW.	I-H3-1(75), UNIT III	1994	ADD. 342	353

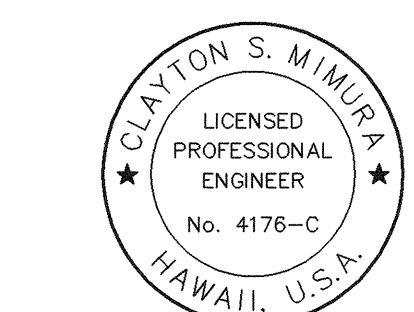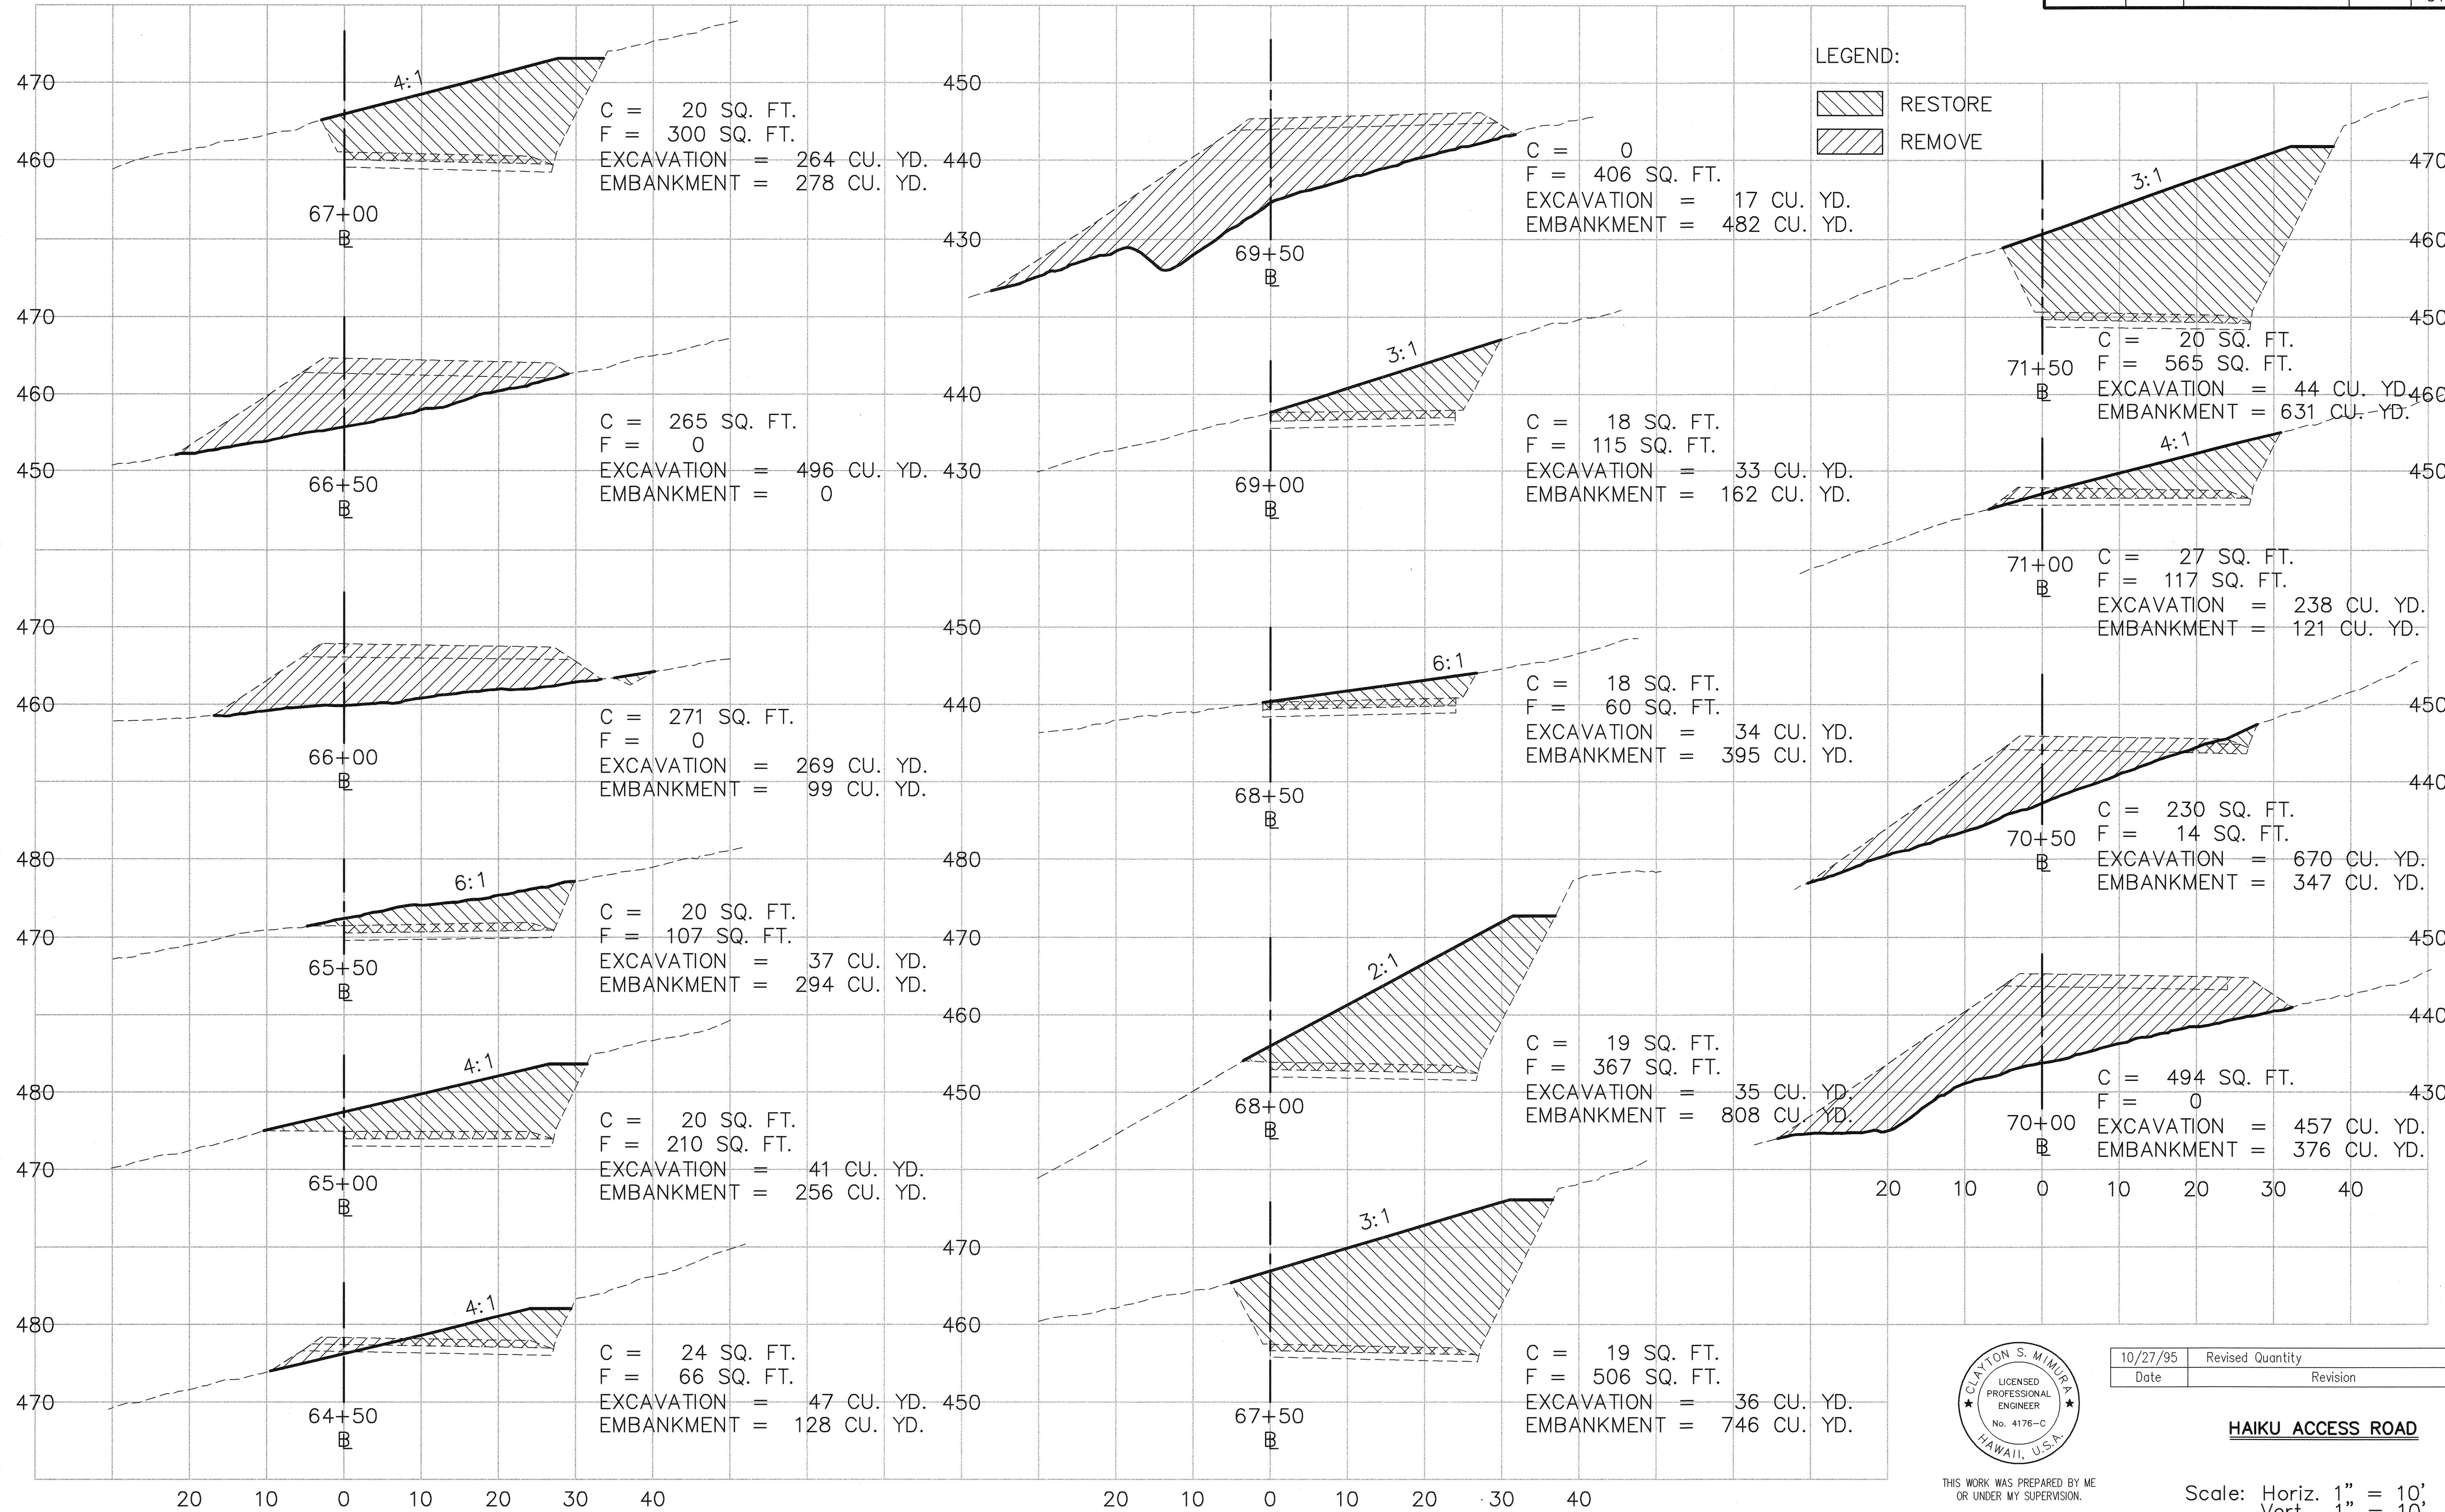

10/27/95	Revised Quantity
Date	Revision

HAIKU ACCESS ROAD

THIS WORK WAS PREPARED BY ME OR UNDER MY SUPERVISION.

Clayton S. Mimura

Scale: Horiz. 1" = 10'
Vert. 1" = 10'

SHEET NO. 9C16 OF 18 SHEETS


ADD.342

WORK DELETED FROM CONTRACT

ORIGINAL PLAN
 SURVEY PLOTTED BY
 DATE
 DESIGNED BY
 CHECKED BY
 NOTE BOOK
 QUANTITIES BY
 No.

CAD by J. Mimura, 55-52


FED. ROAD DIST. NO.	STATE	FED. AID PROJ. NO.	FISCAL YEAR	SHEET NO.	TOTAL SHEETS
HAWAII	HAW.	I-H3-1(75), UNIT III	1994	343	353

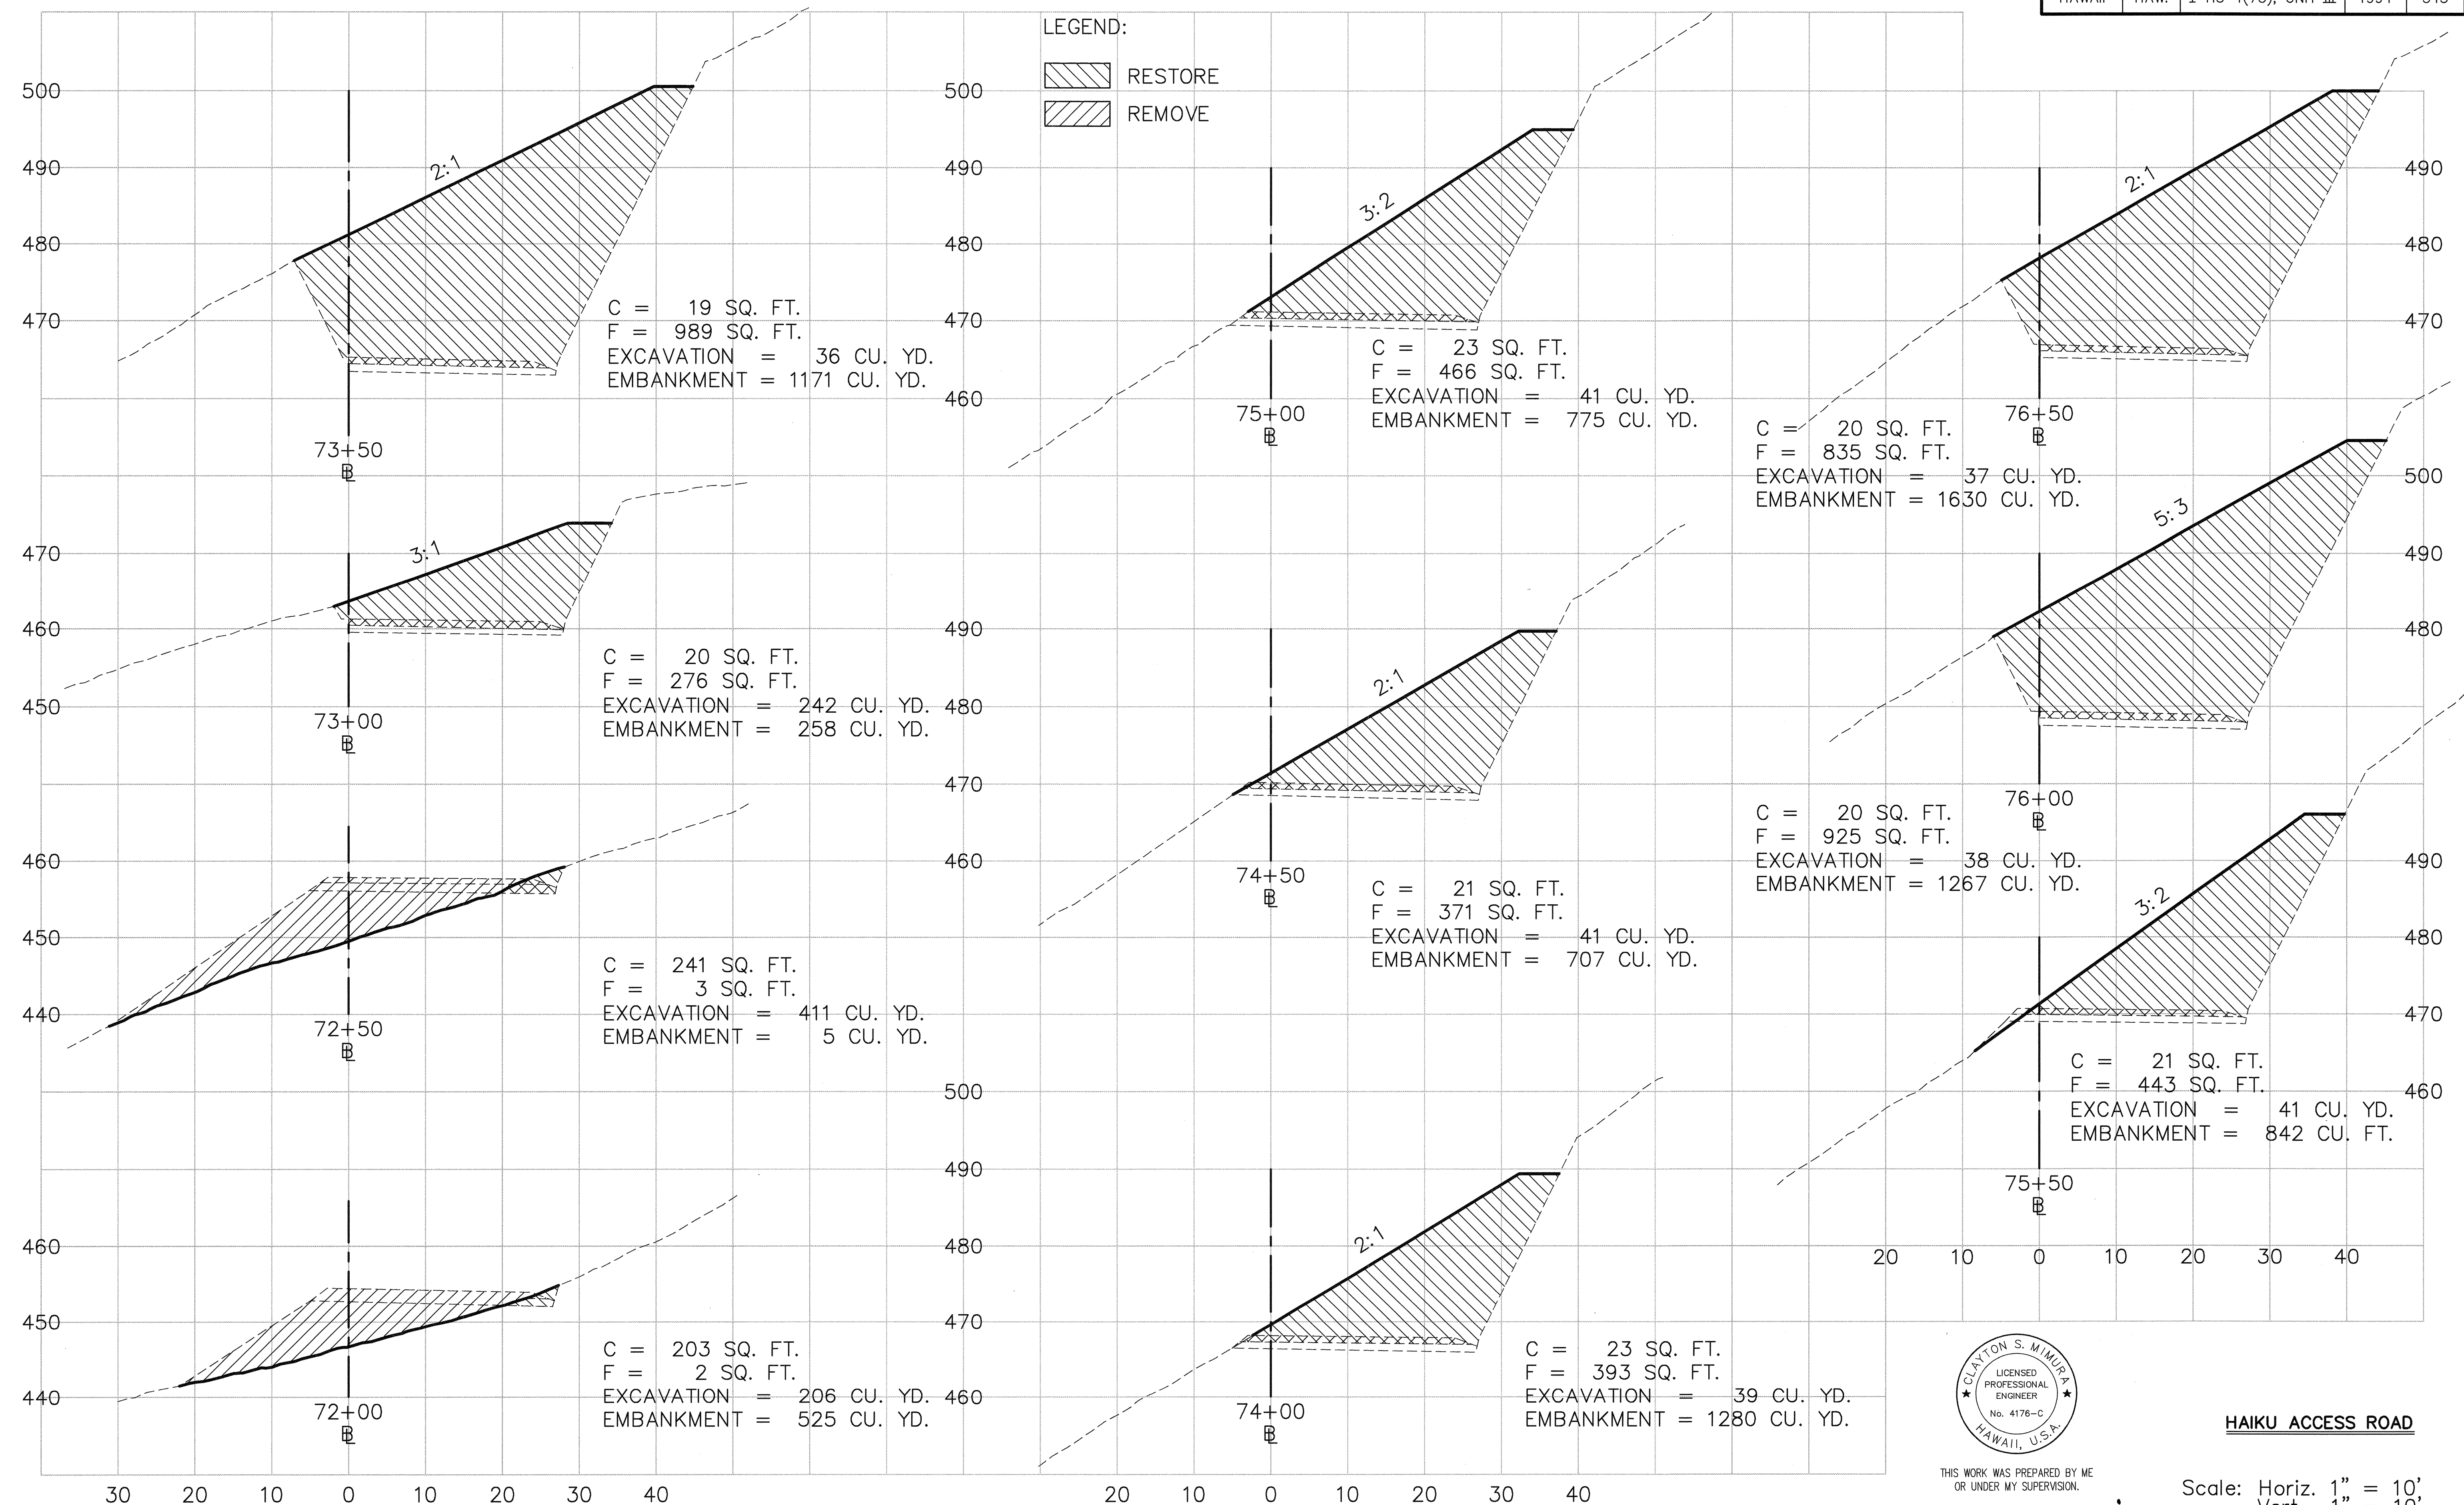

SURVEY PLOTTED BY: _____ DATE: _____
DESIGNED BY: _____
CHECKED BY: _____
NOTE BOOK: _____
No. _____

CAD by C. Rivera, 55-52

Last Saved: J:\H3RF\U3\HQM\XSEC10A.dwg 06/15/95 at 16:14

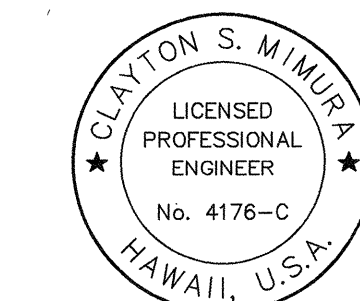


THIS WORK WAS PREPARED BY ME
OR UNDER MY SUPERVISION.

Clayton S. Mimura

HAIKU ACCESS ROAD

Scale: Horiz. 1" = 10'
Vert. 1" = 10'
SHEET NO. 9C17 OF 18 SHEETS

FED. ROAD DIST. NO.	STATE	FED. AID PROJ. NO.	FISCAL YEAR	SHEET NO.	TOTAL SHEETS
HAWAII	HAW.	I-H3-1(75), UNIT III	1994	ADD. 344	353

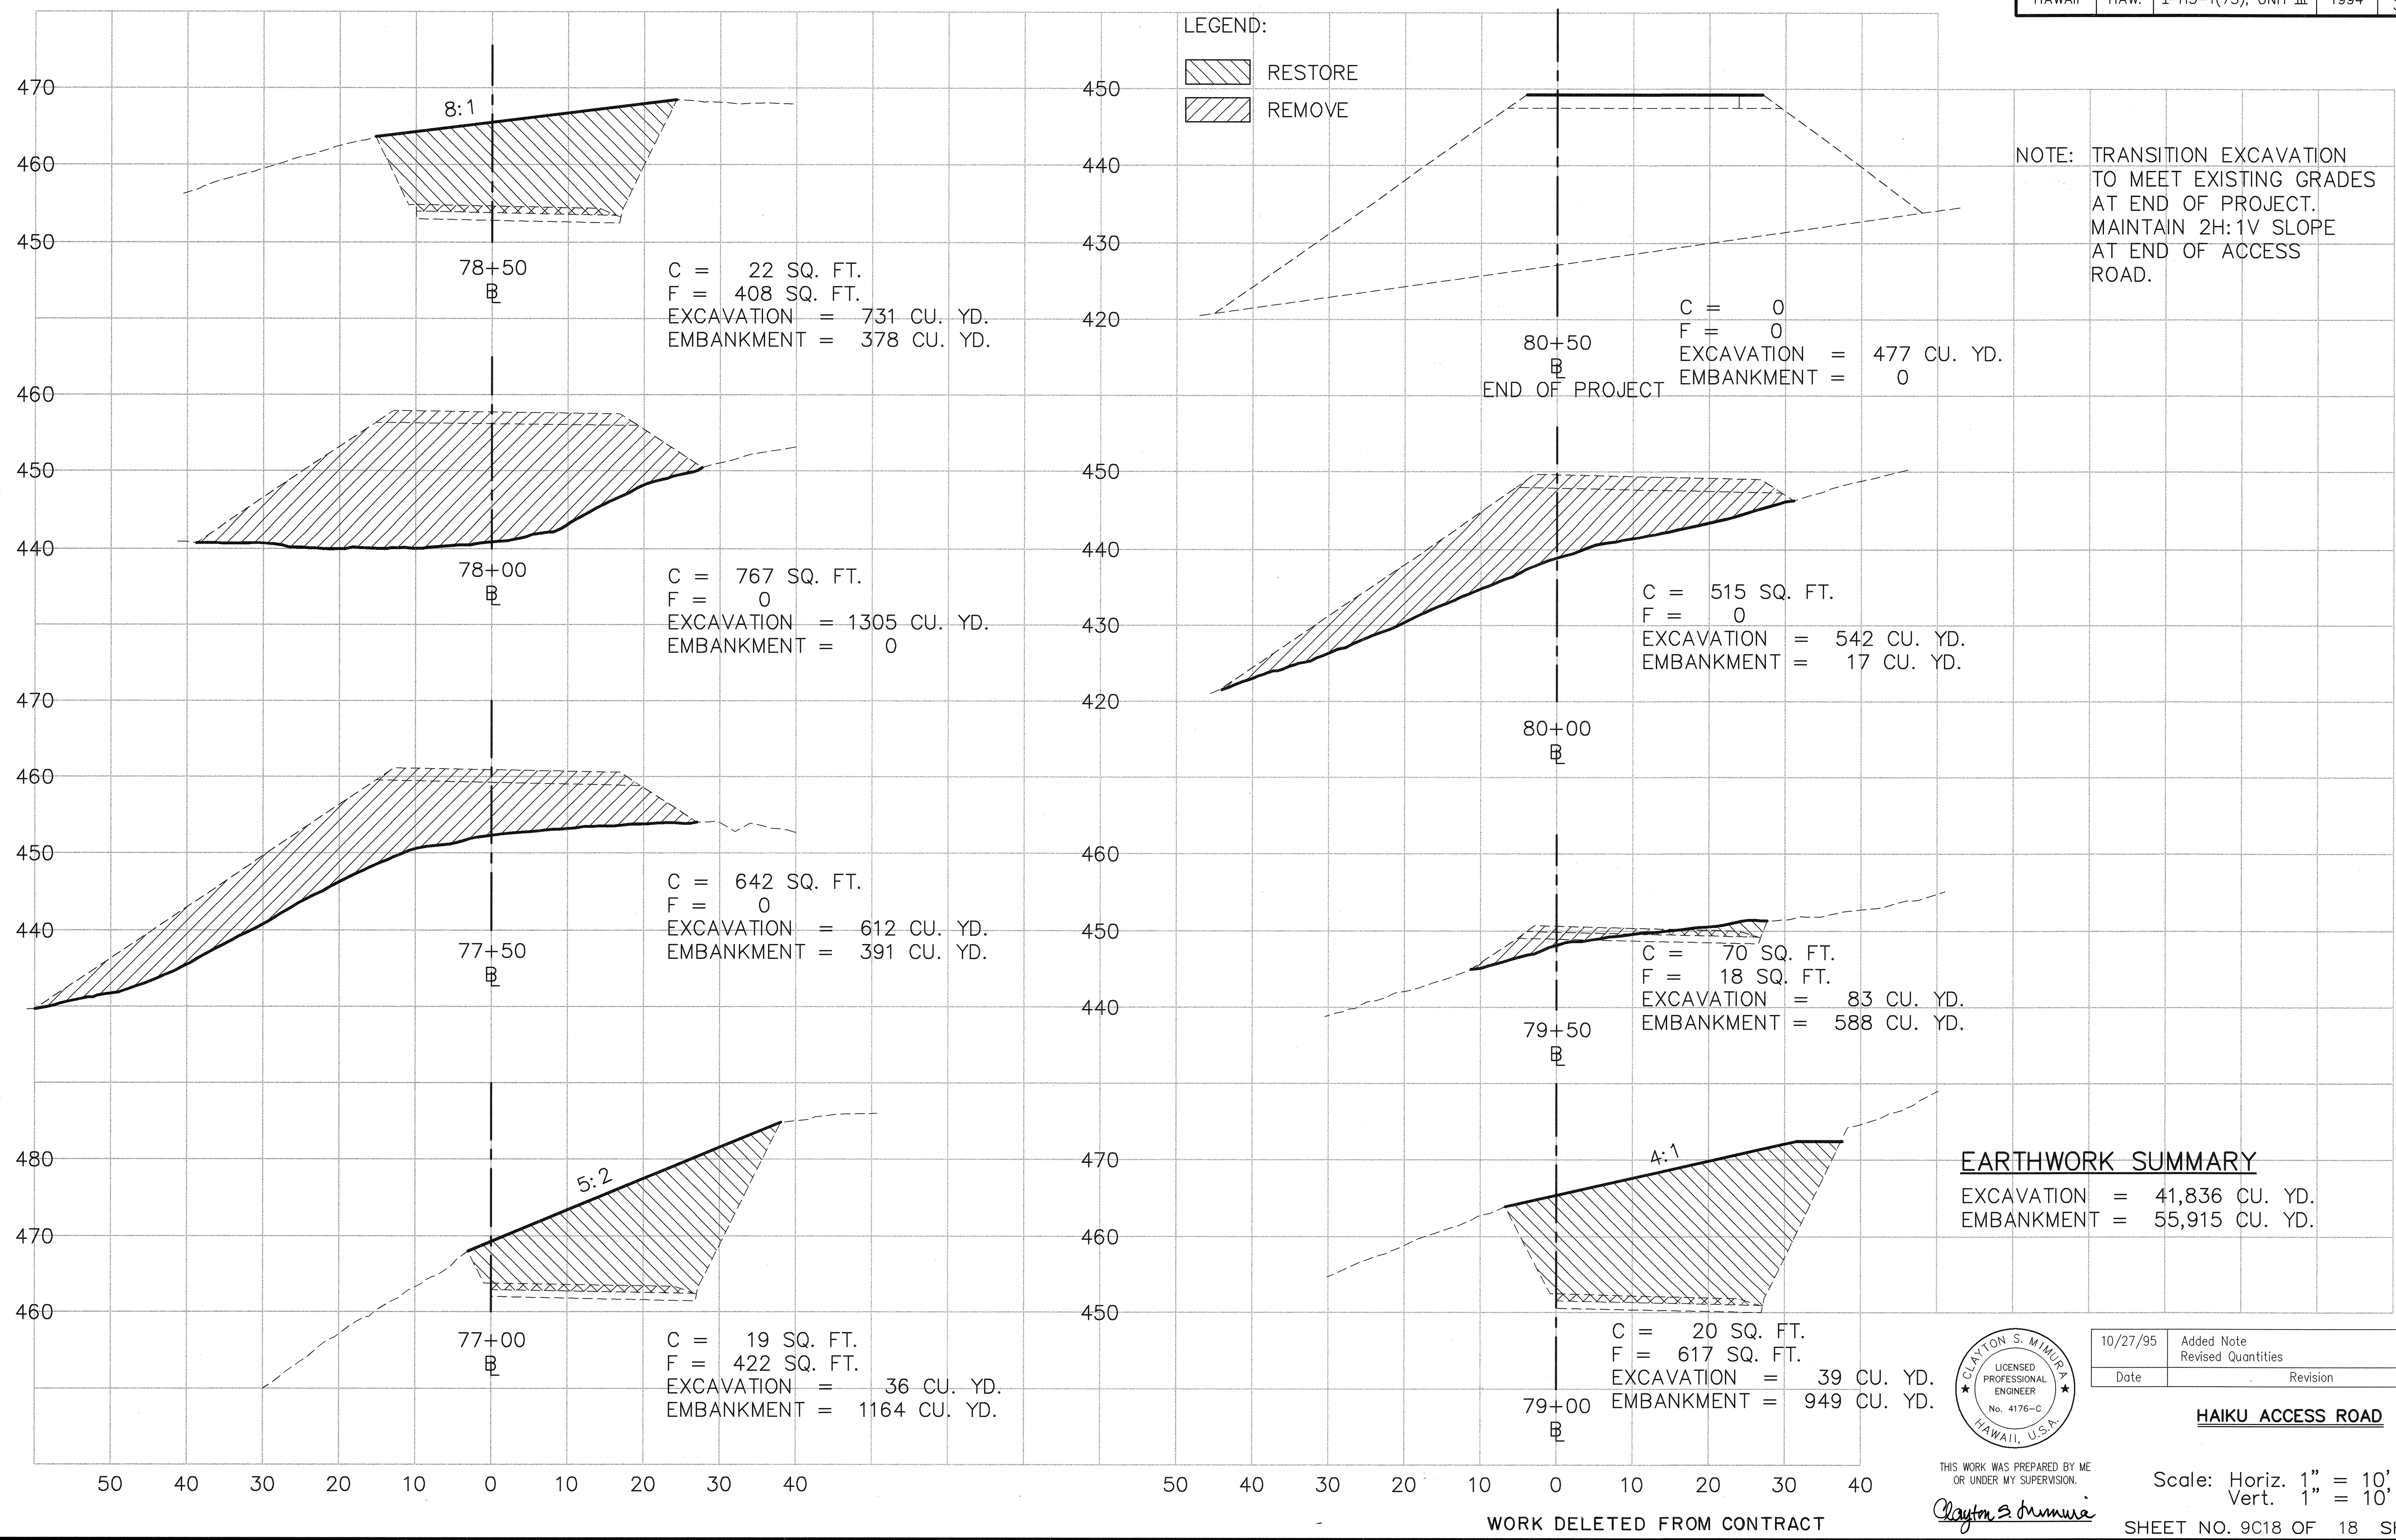

DATE	10/27/95
DESIGNED BY	CLAYTON S. MIMURA
CHECKED BY	CLAYTON S. MIMURA
NO.	4176-C

CAD by J. Minura, 55-52

FED. ROAD DIST. NO.	STATE	FED. AID PROJ. NO.	FISCAL YEAR	SHEET NO.	TOTAL SHEETS
HAWAII	HAW.	I-H3-1(75), UNIT III	1994	ADD. 345	353



GENERAL NOTES :

- (A) SPECIFICATIONS
- Standard Specifications for Highway Bridges (Fifteenth Edition 1992) American Association of State Highway and Transportation Officials and Interim Specifications.
 - Standard Specifications for Road and Bridge Construction State of Hawaii Department of Transportation with Special Provisions for this Project.
 - Tubular Guardrail meets Provisions of O.S.H.A. Requirements.
- (B) LIVE LOAD
- HS20-44 truck loading or 2 axles 4 feet apart with each axle weighing 24,000lbs.
 - Full impact.
 - Live load deflection with impact is limited 1/800 of the span.
- (C) MATERIALS
- ASTM A36(Fy=36ksi) Steel, Hot-dipped galvanized after fabrication.
 - ASTM A-325, Type 1 bolts and nuts for Deck system and ASTM- A-307 bolts for Metal Hand railings and other part. All bolts, nuts & washers shall be hot-dipped galvanized.
 - Steel floor deck plate shall be finished with raised checker board or equivalent skid resistant treatment.
 - Handrail post and railings shall be of steel tubing (ASTM A500, Grade A) hot-dipped galvanized after fabrication.
- (D) CONSTRUCTION
- The contractor shall verify the existing tie spacings prior to fabrication of deck system.
 - The Contractor shall remove and dispose of existing timber decking as shown on Section A Sheet No. 9S2 and replace with steel decking as shown on Section A Sheet No. 9S2. The removal and disposal of existing decking system as shown on Section A Sheet No. 9S2 shall be incidental to "Steel Deck System for Haiku Access Road Bridges" and will not be paid for separately.
 - The existing grade within 10' approaching to both ends of bridge shall be adjusted to a smooth approach.


STEEL DECK SYSTEM FOR HAIKU ACCESS ROAD

Bridge No. 3 = 252,000 lbs.

10/13/95	Deleted Bridge No. 2. Revised note (D)(2), (C)(1), (C)(4), & steel quantity. Added Note (D)(3)
Date	Revision
STATE OF HAWAII DEPARTMENT OF TRANSPORTATION HIGHWAYS DIVISION HAIKU ACCESS ROAD RESTORATION PLAN AND ELEVATION HAIKU ACCESS ROAD H-3 FINISH (UNIT III) FAIP NO. I-H3-1(75), UNIT III I.K. TUNNEL/ACCESS ROADS SCALE: AS SHOWN DATE: JUNE 1995 SHEET NO. 9S1 OF 3 SHEETS	

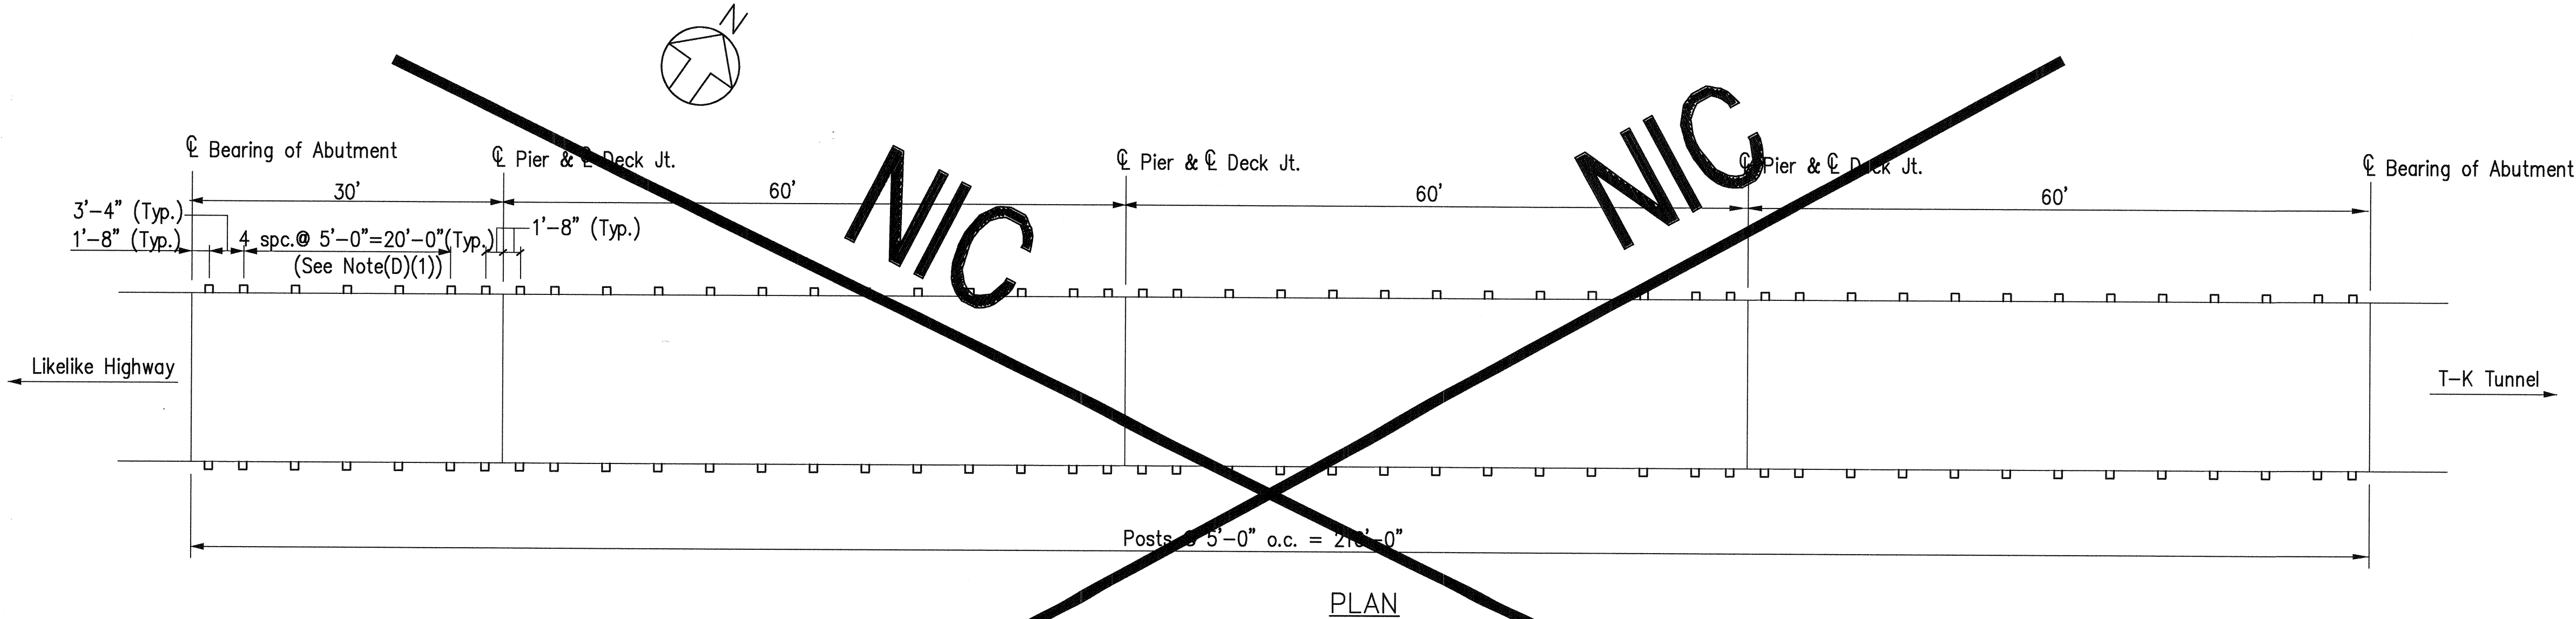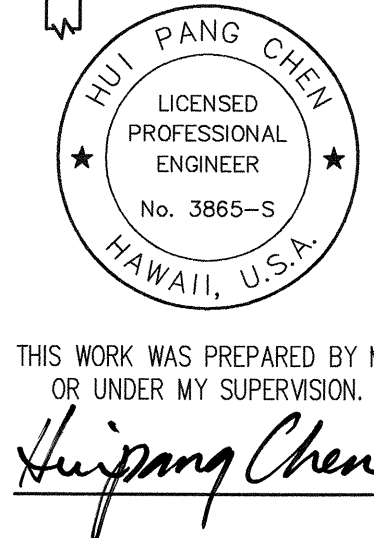


PLAN

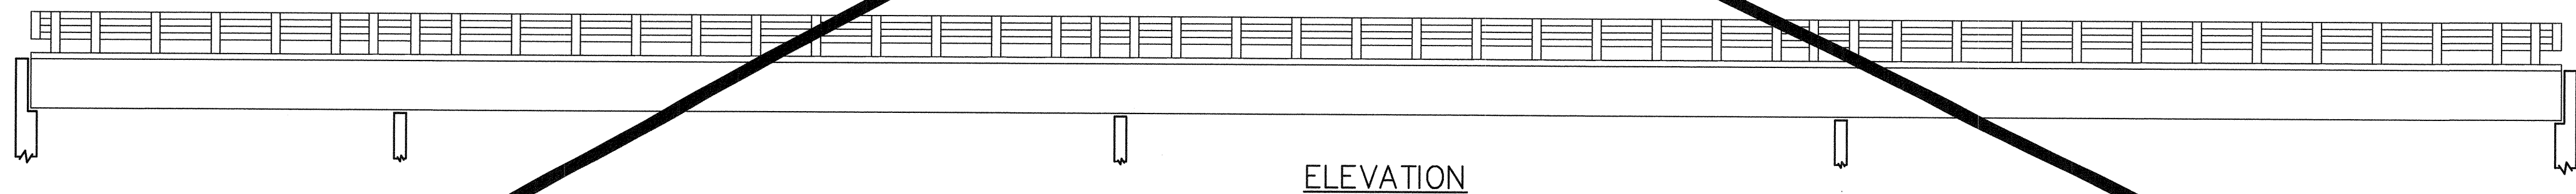

ELEVATION


BRIDGE No. 2

Scale: 1" = 10'-0"

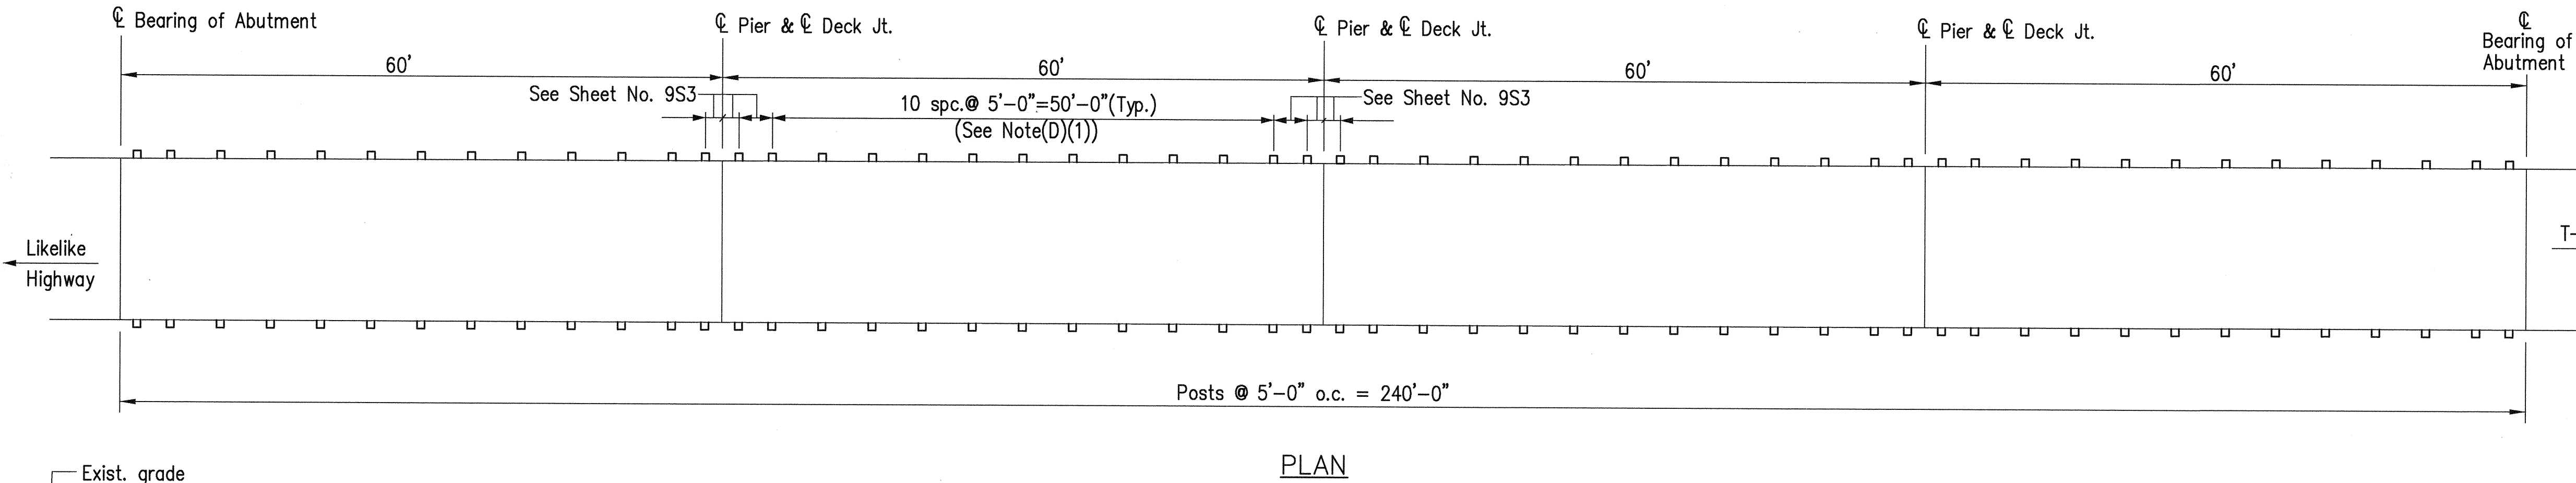

PLAN

Exist. grade
See Note (D)(3)

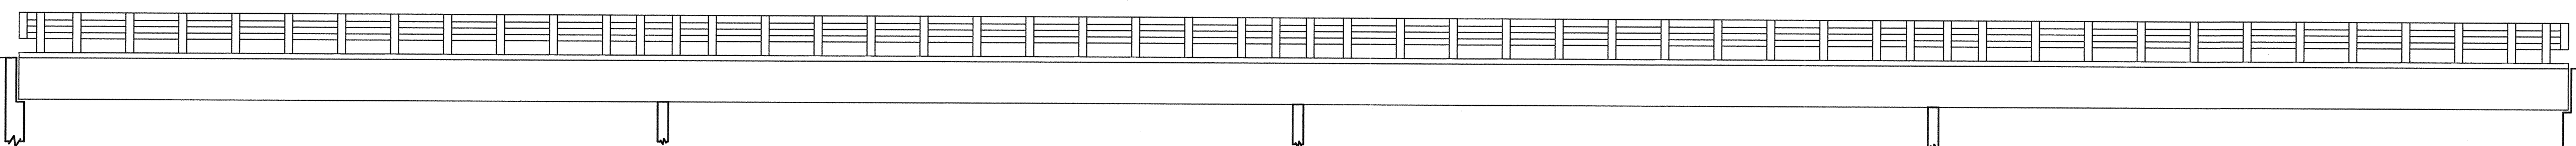

ELEVATION


BRIDGE No. 3

Scale: 1" = 10'-0"

SURVEY PLOTTED BY	DATE
ORIGINAL PLAN	
DESIGNED BY	
NOTE BOOK	
QUANTITIES BY	
CHECKED BY	
No.	


GD By J. Minura, 55-52

FED. ROAD DIST. NO.	STATE	FED. AID PROJ. NO.	FISCAL YEAR	SHEET NO.	TOTAL SHEETS
HAWAII	HAW.	I-H3-1(75), UNIT III	1994	ADD. 346	353

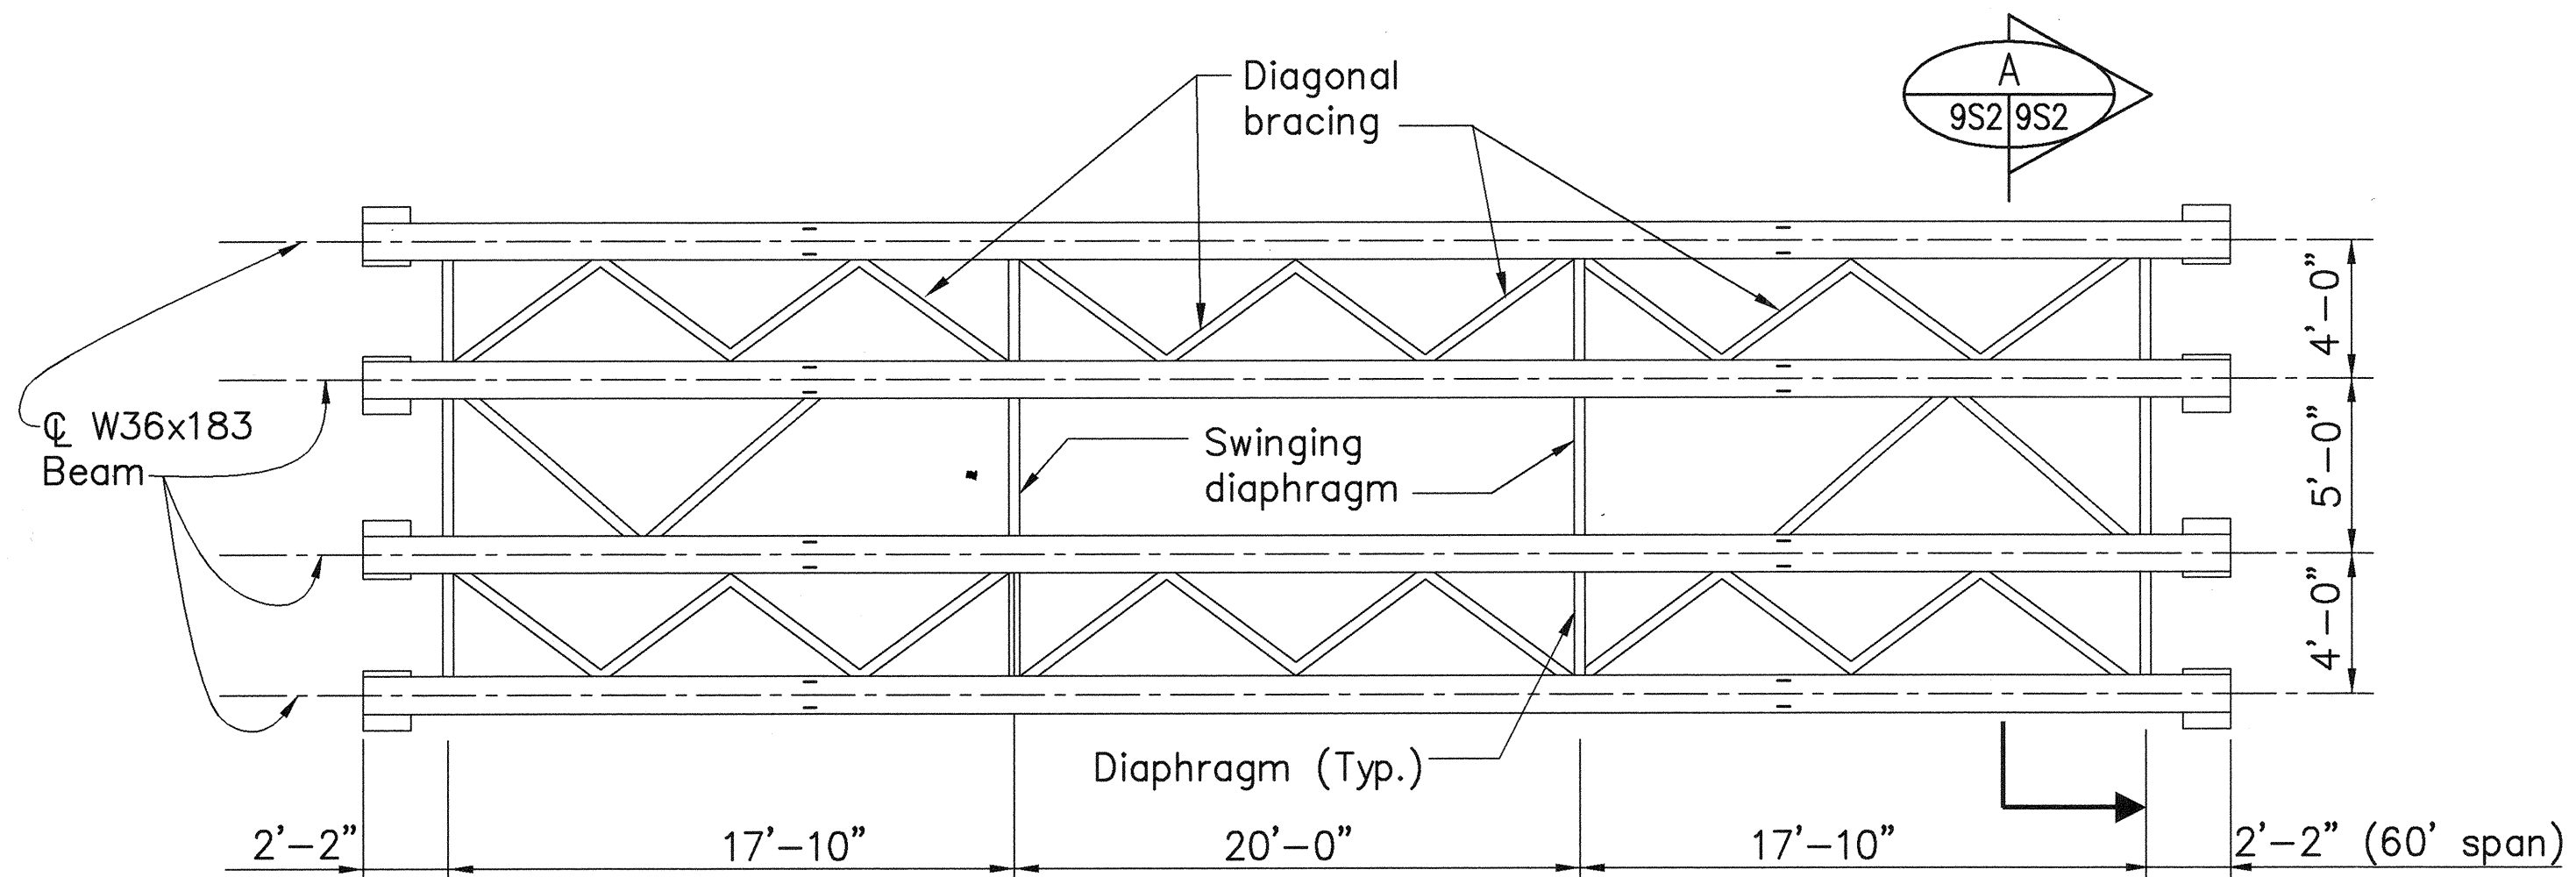


Note:
Deck not shown
for clarity

PARTIAL EXISTING FRAMING PLAN
N.T.S.

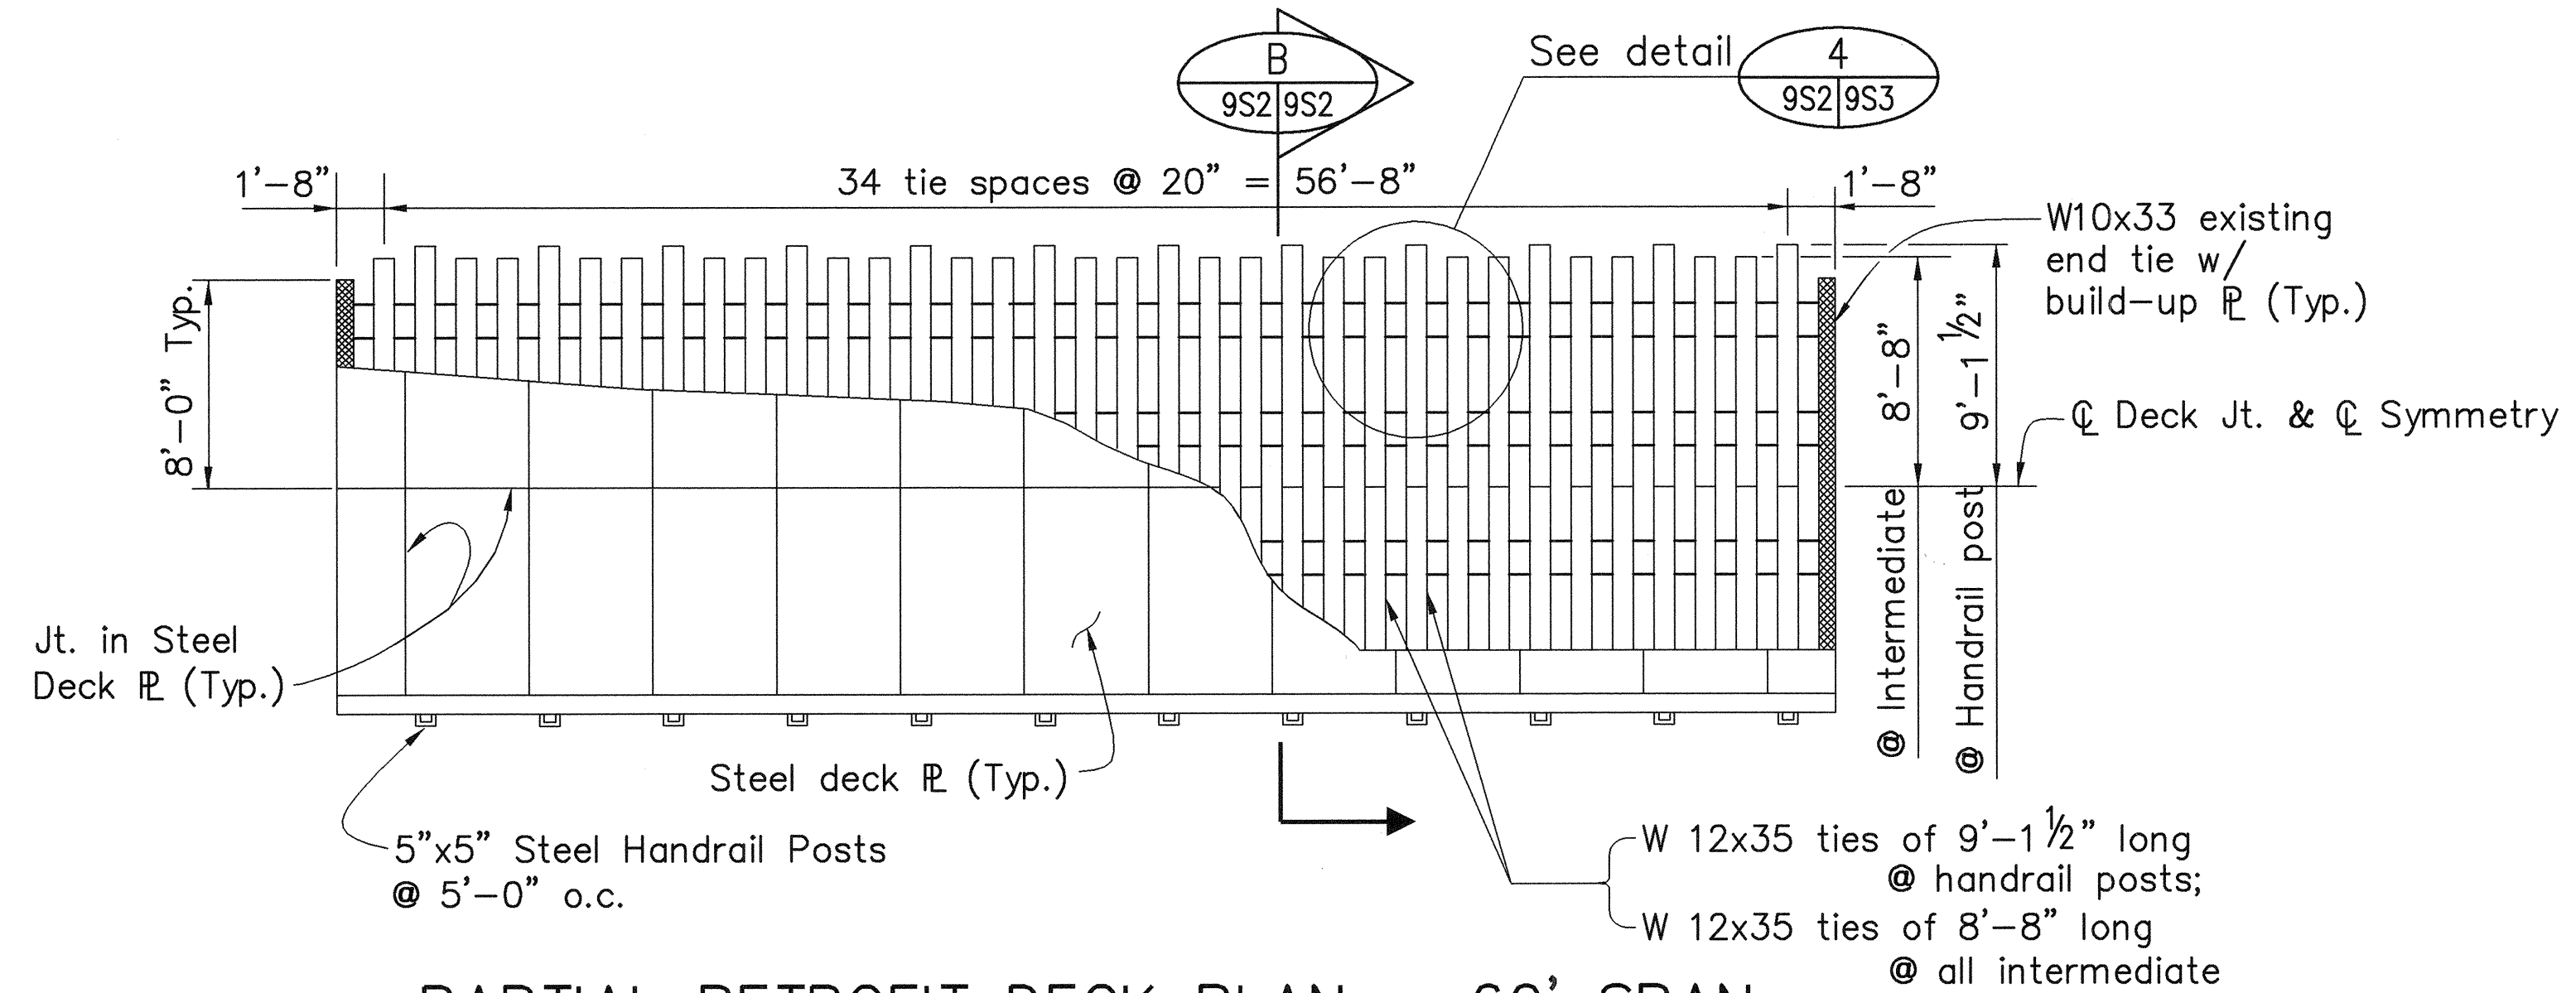


PARTIAL RETROFIT DECK PLAN - 60' SPAN
N.T.S.

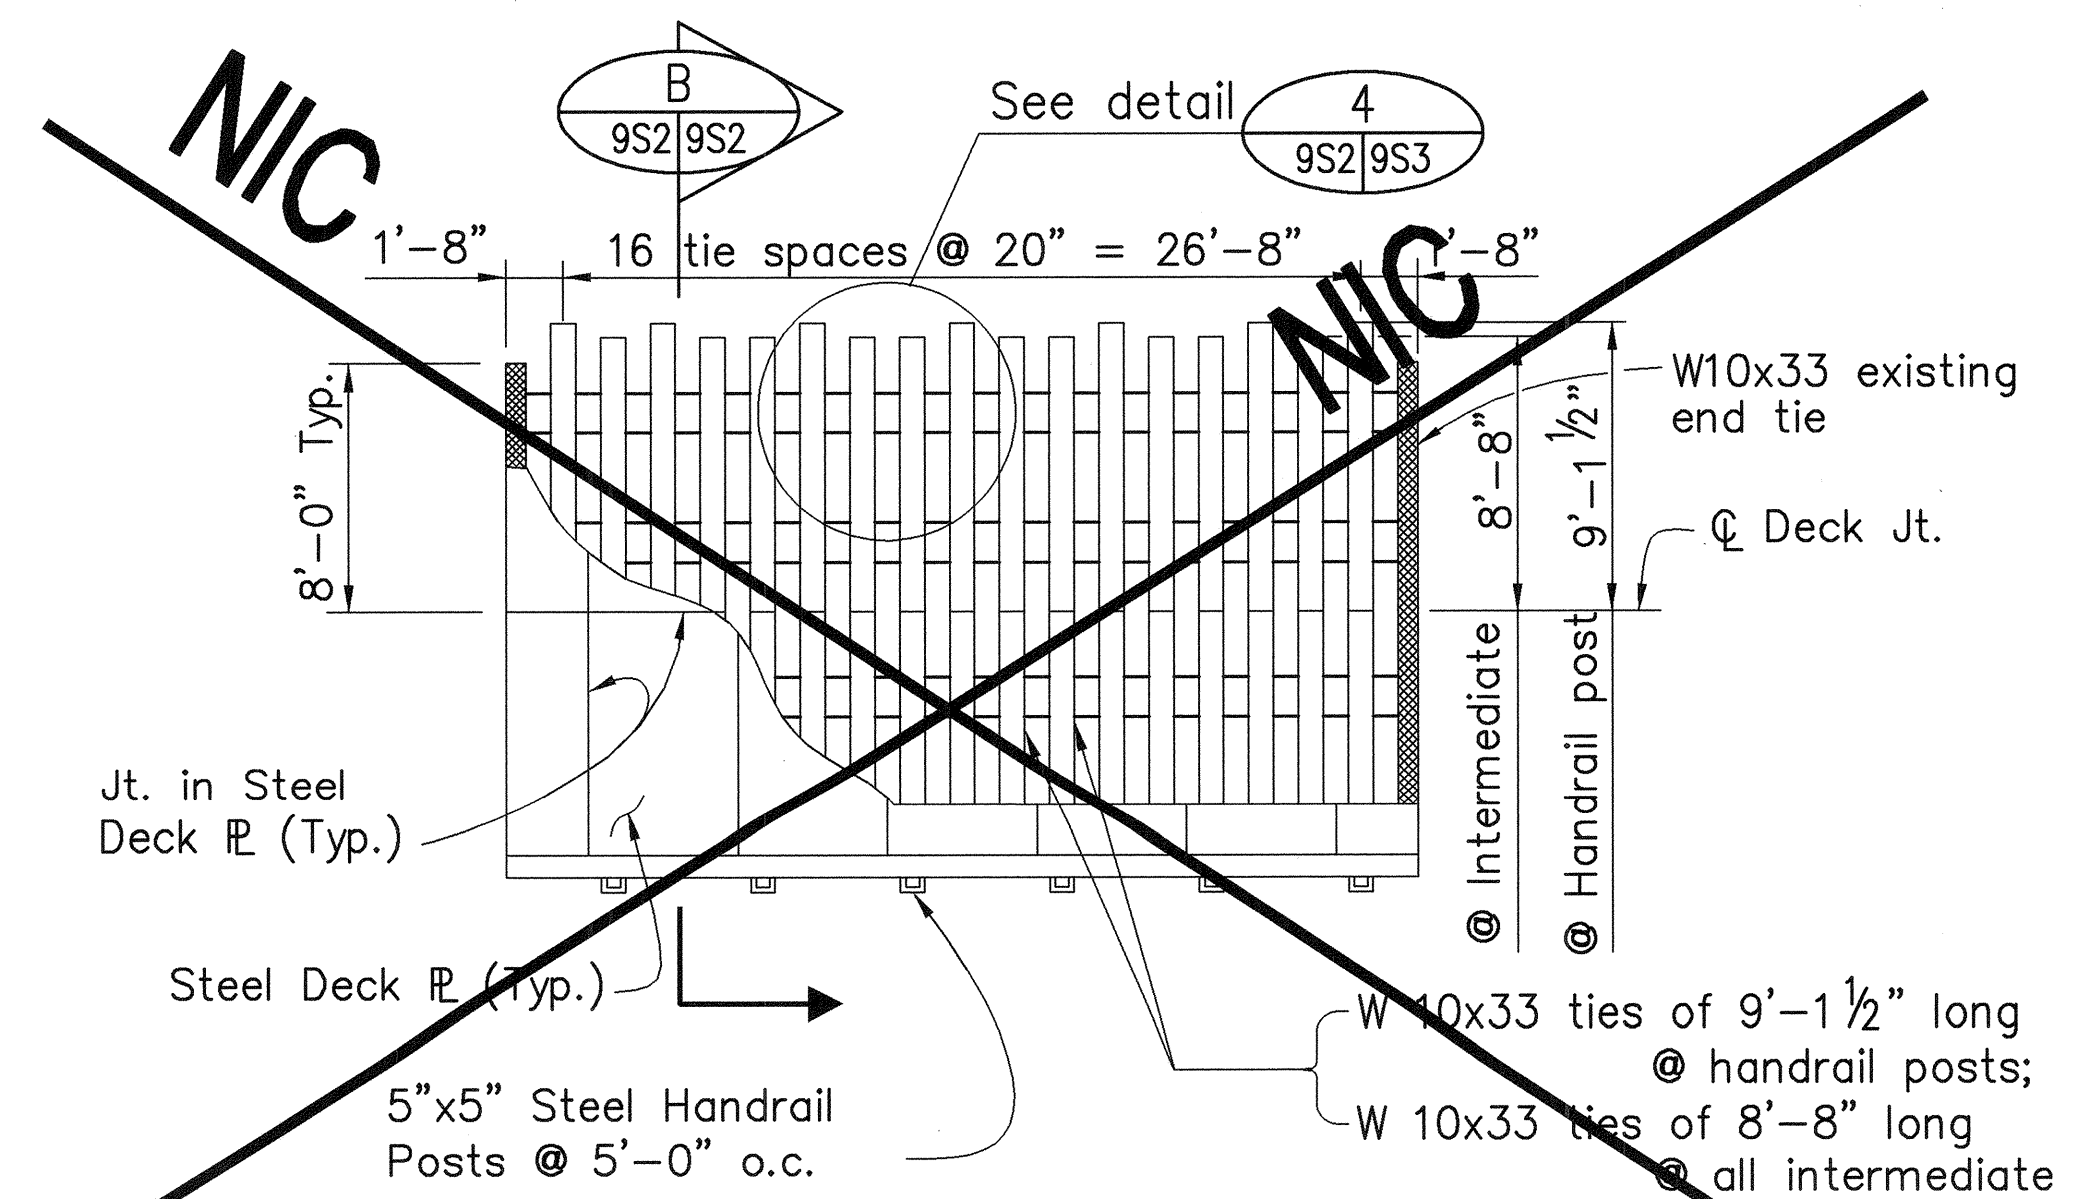


PARTIAL RETROFIT DECK PLAN - 30' SPAN
N.T.S.


LEGEND:
[Hatched Box] Denotes removal of existing structure.

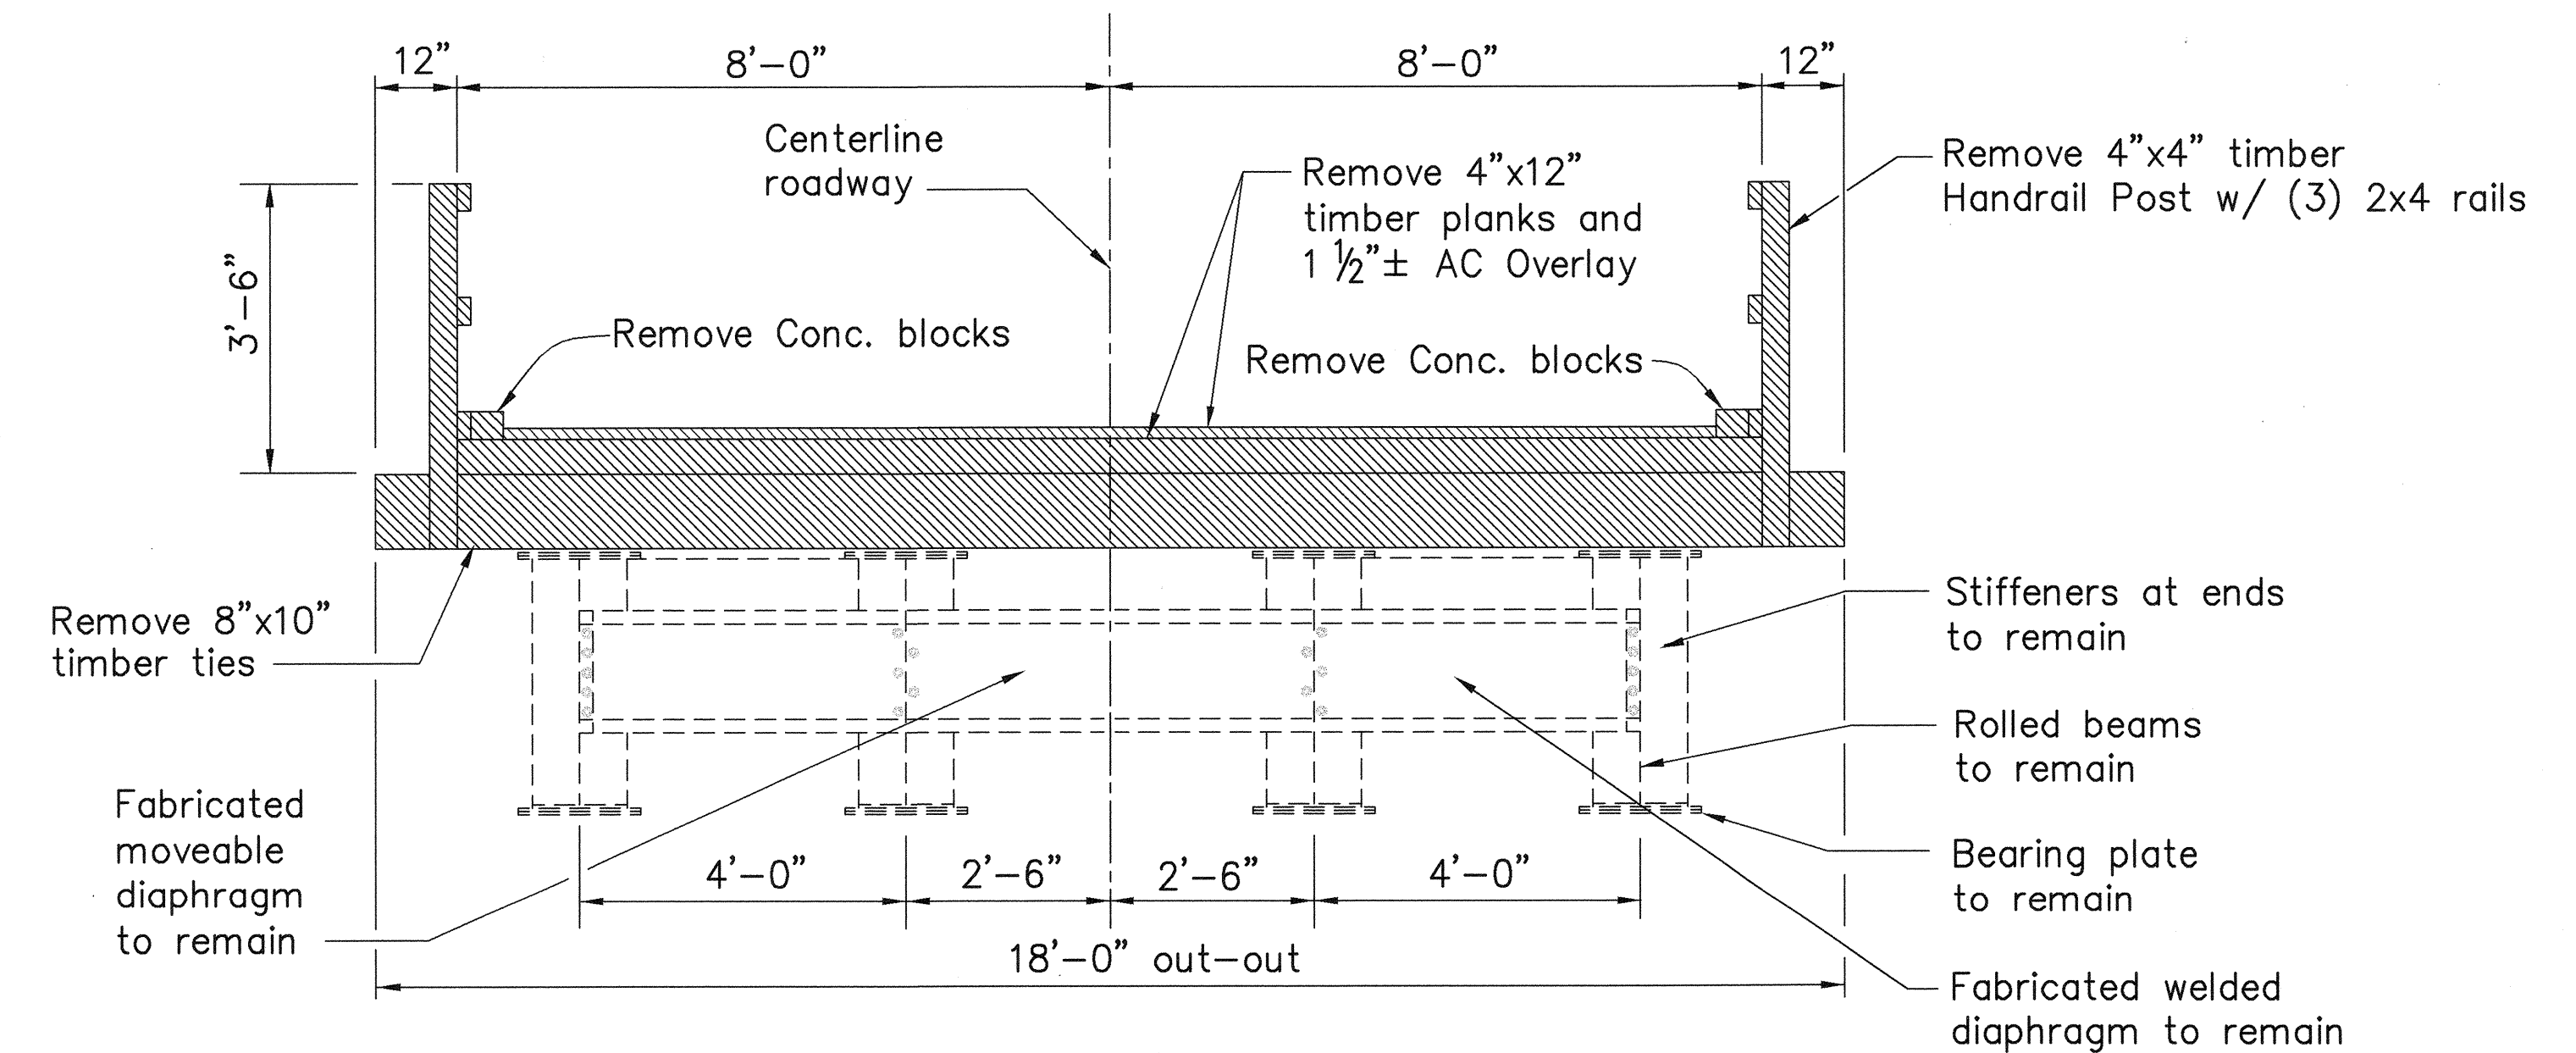


SECTION A
Scale: 1/2" = 1'-0"

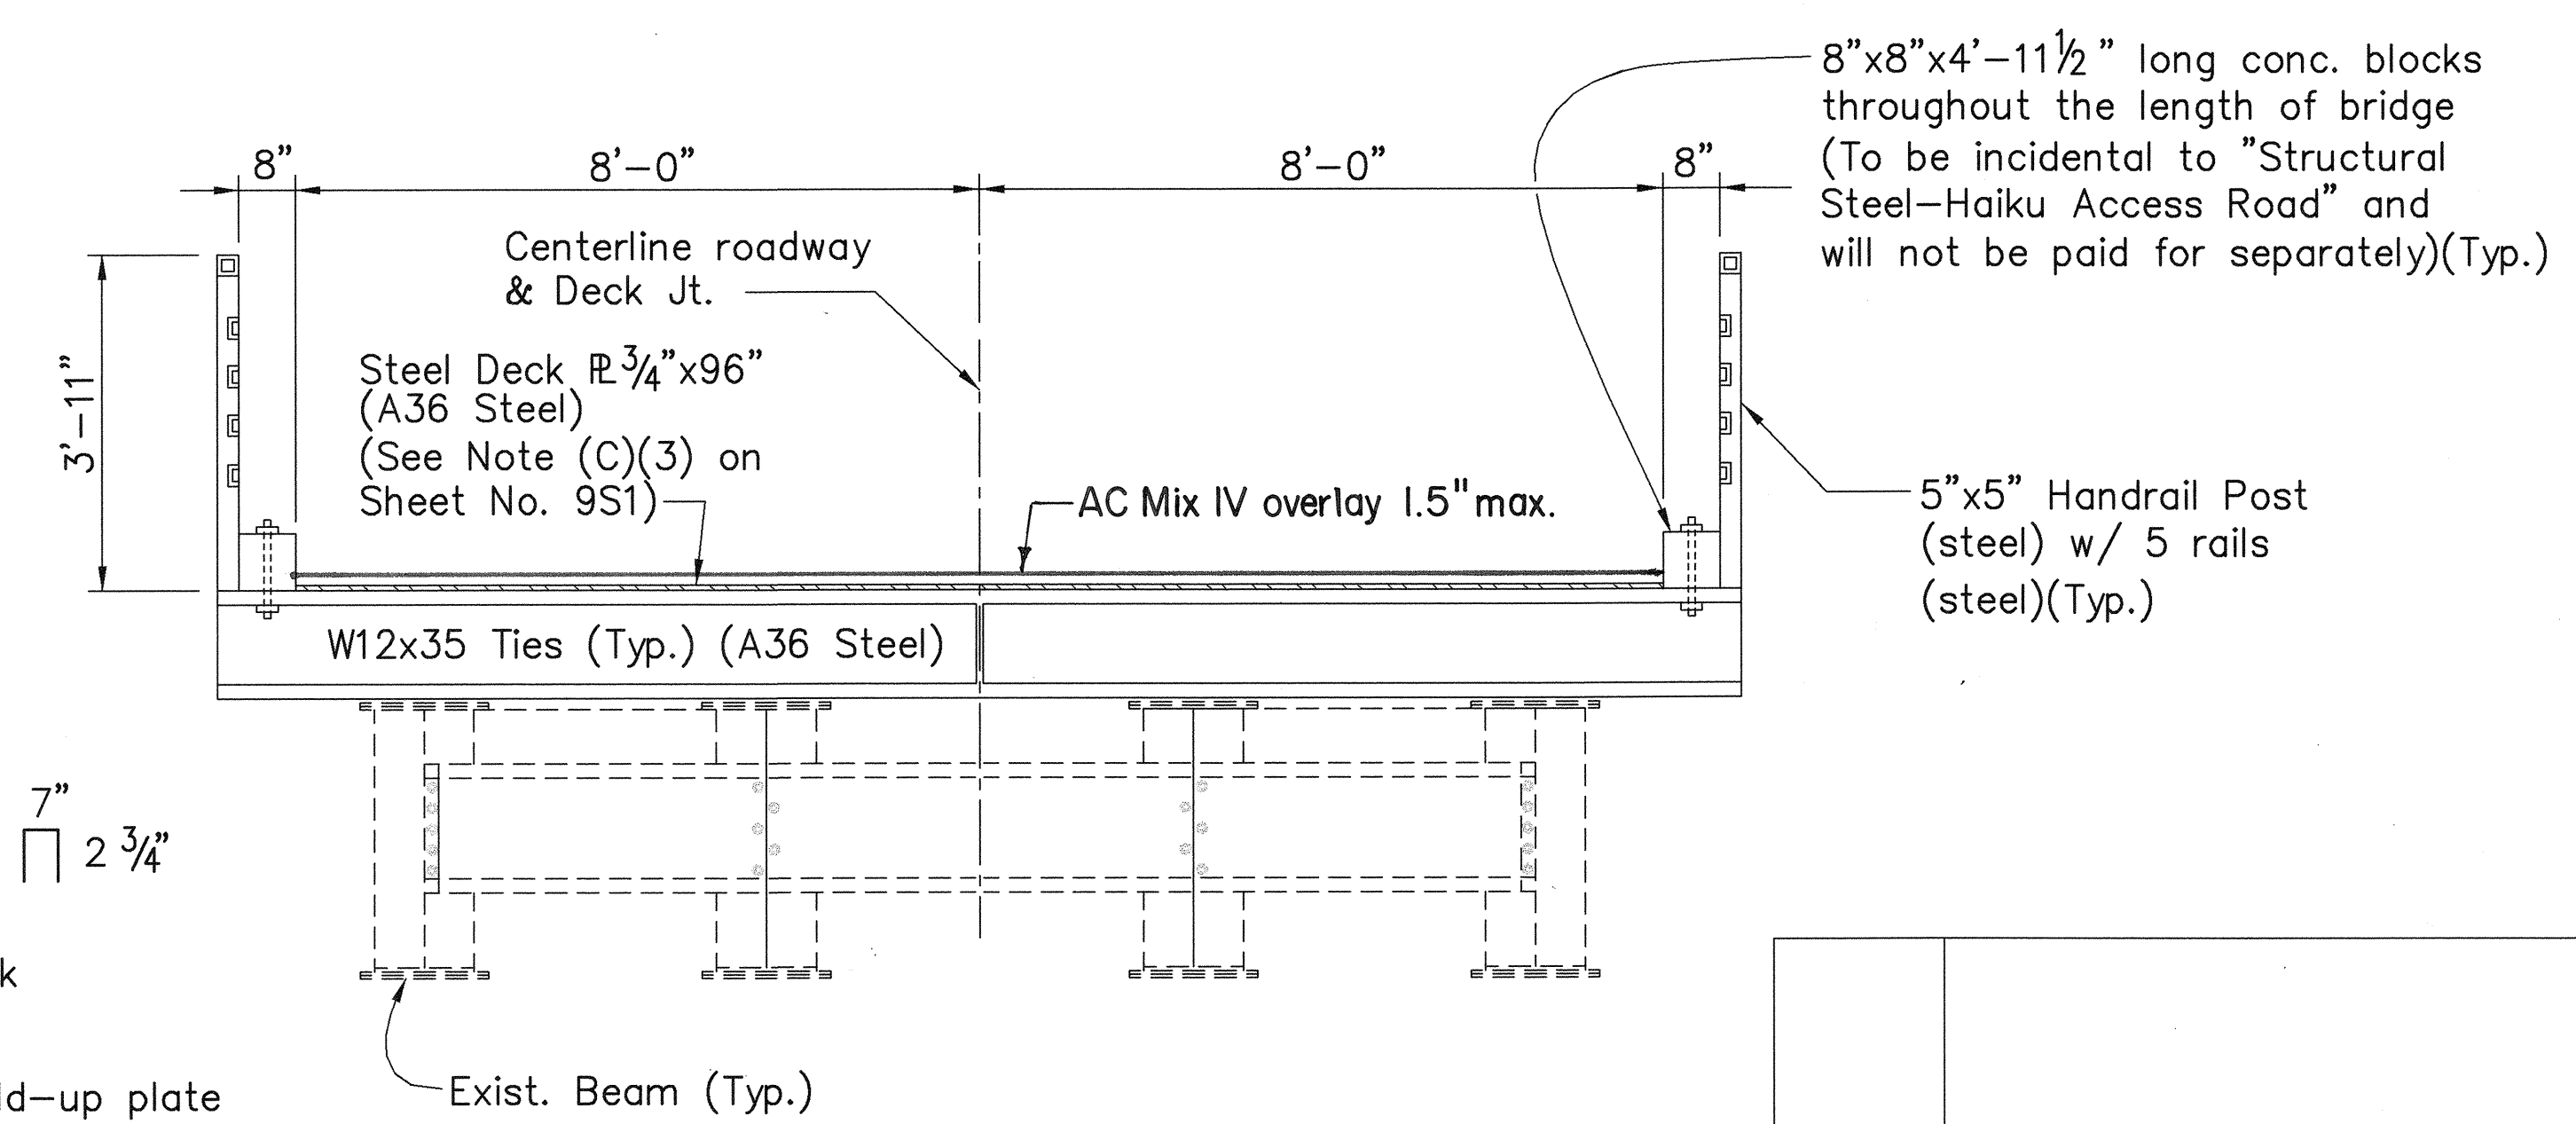

SECTION B
Scale: 1/2" = 1'-0"

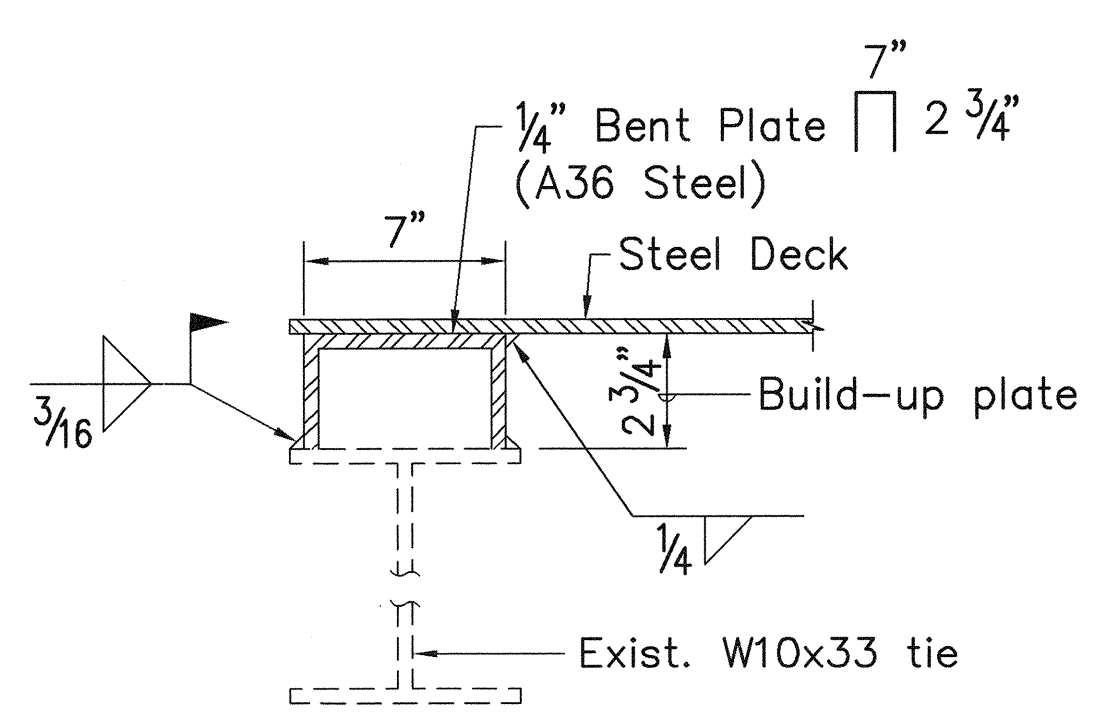

DETAIL 6
N.T.S.

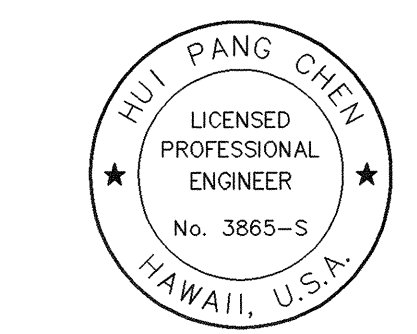

THIS WORK WAS PREPARED BY ME
OR UNDER MY SUPERVISION.
Hui Pang Chen











10/13/95	Deleted 30' Span Plan. Revised 60' Span Plan & Sections A/9S2 & B/9S2. Added Detail 6/9S2.
Date	Revision
STATE OF HAWAII DEPARTMENT OF TRANSPORTATION HIGHWAYS DIVISION	
HAIKU ACCESS ROAD RESTORATION	
BRIDGE DETAILS - 1	
HAIKU ACCESS ROAD	
H-3 FINISH (UNIT III)	
FAIP NO. I-H3-1(75), UNIT III	
T.K. TUNNEL/ACCESS ROADS	
SCALE: AS SHOWN	DATE: JUNE 1995
SHEET NO. 9S2 OF 3 SHEETS	

ADD.346

SURVEY PLOTTED BY	DATE
DESIGNED BY	
NOTED BY	
CHECKED BY	
ORIGINAL PLAN	
NO. 346	

CAD by J. Minami, 55-52

FED. ROAD DIST. NO.	STATE	FED. AID PROJ. NO.	FISCAL YEAR	SHEET NO.	TOTAL SHEETS
HAWAII	HAW.	I-H3-1(75), UNIT III	1994	ADD. 347	353

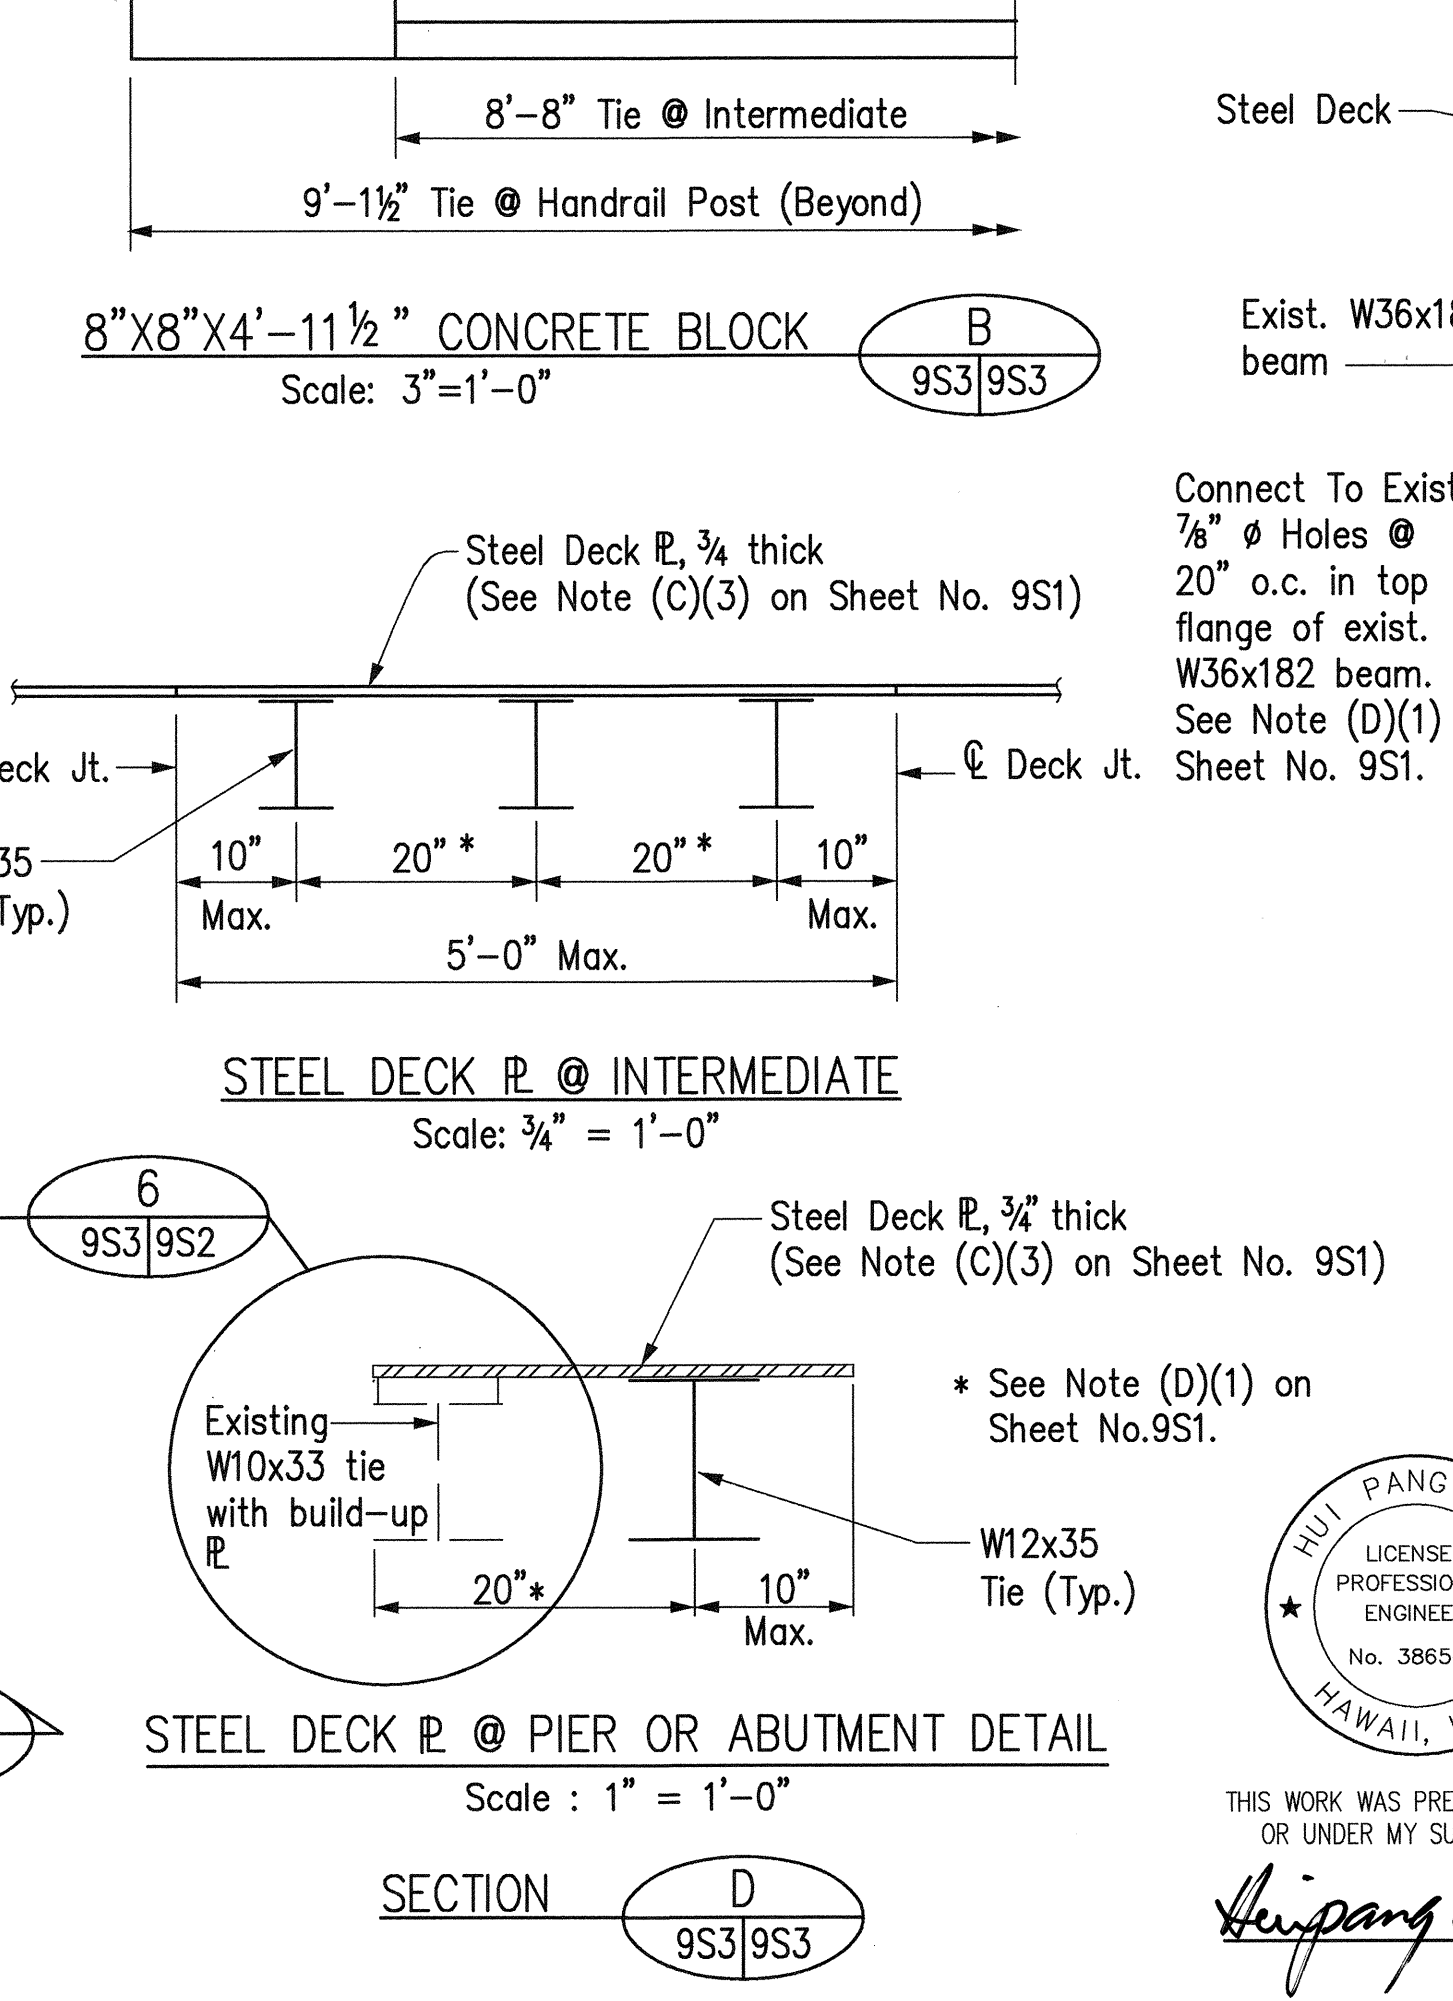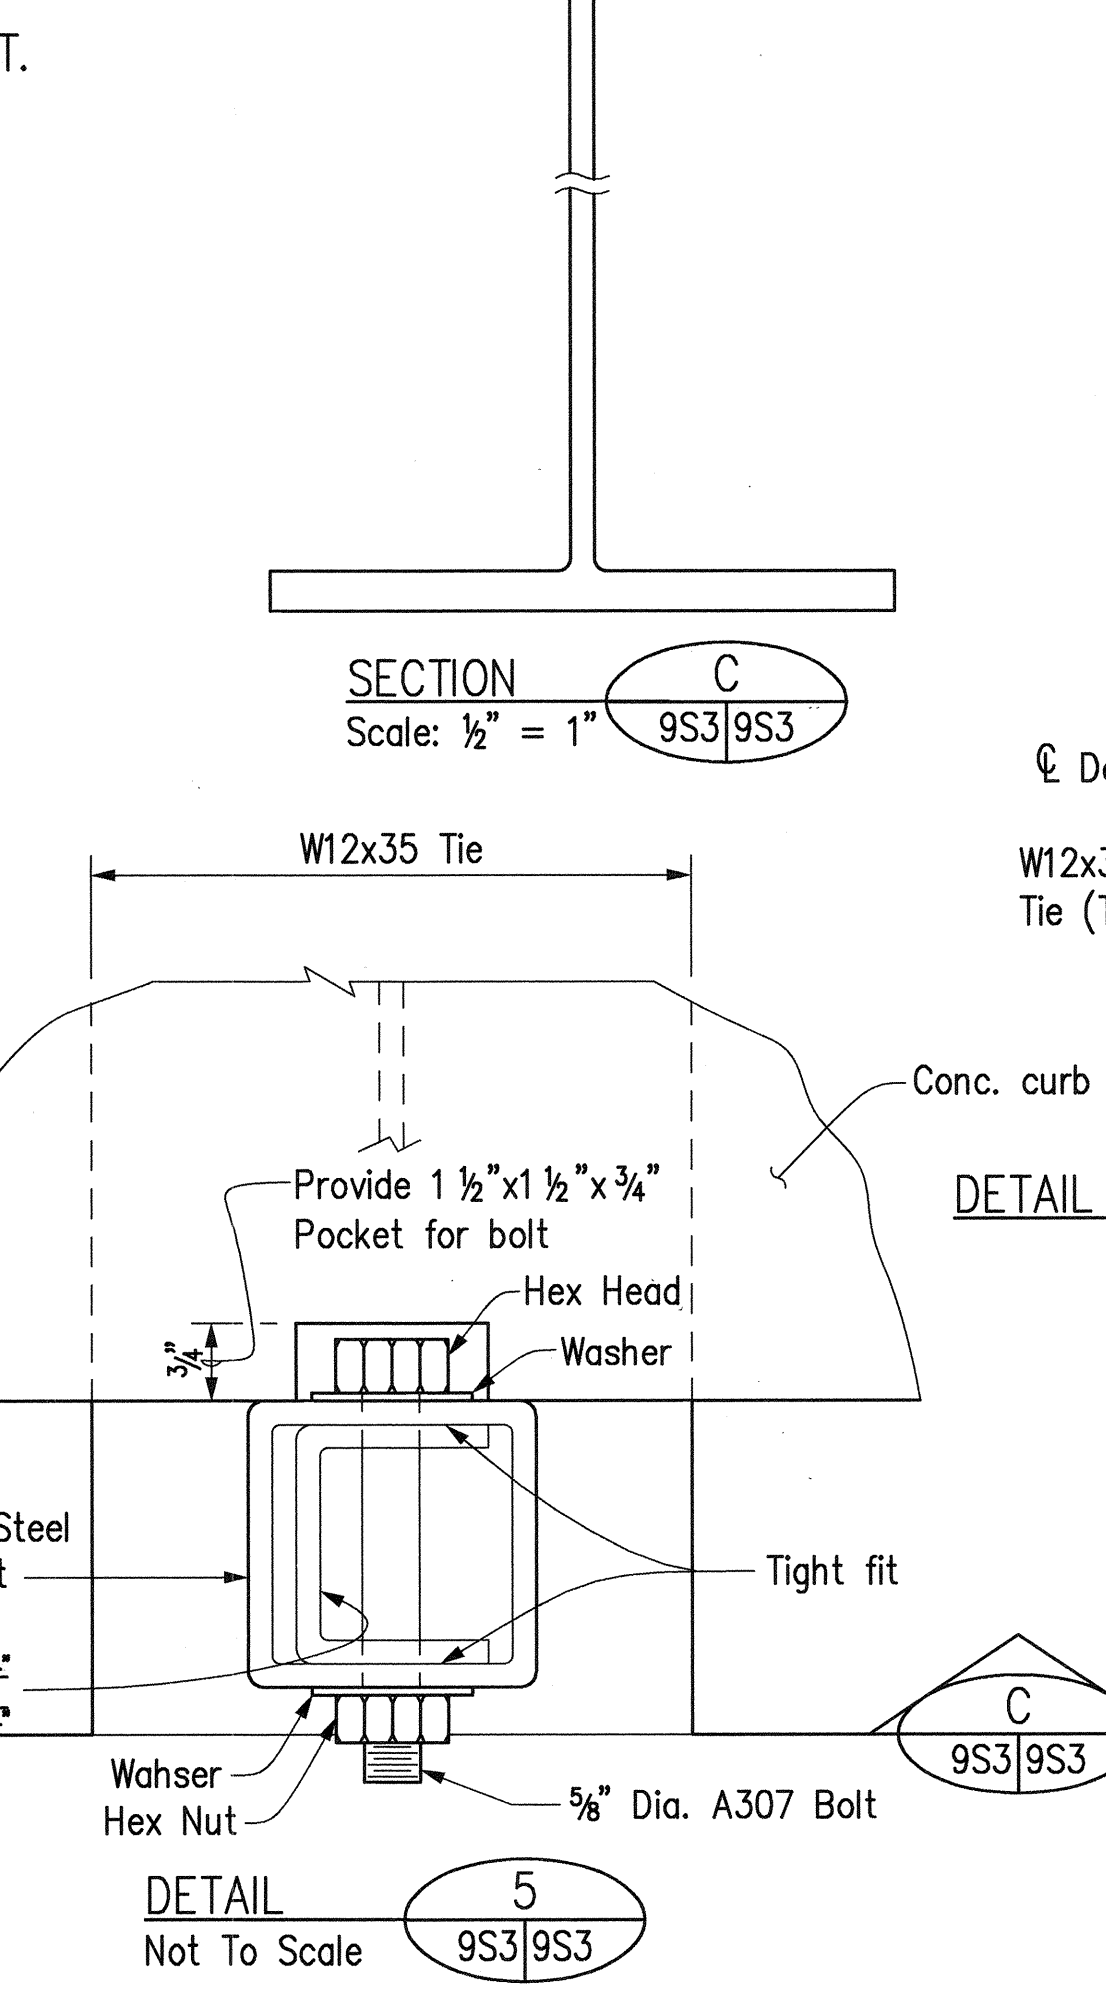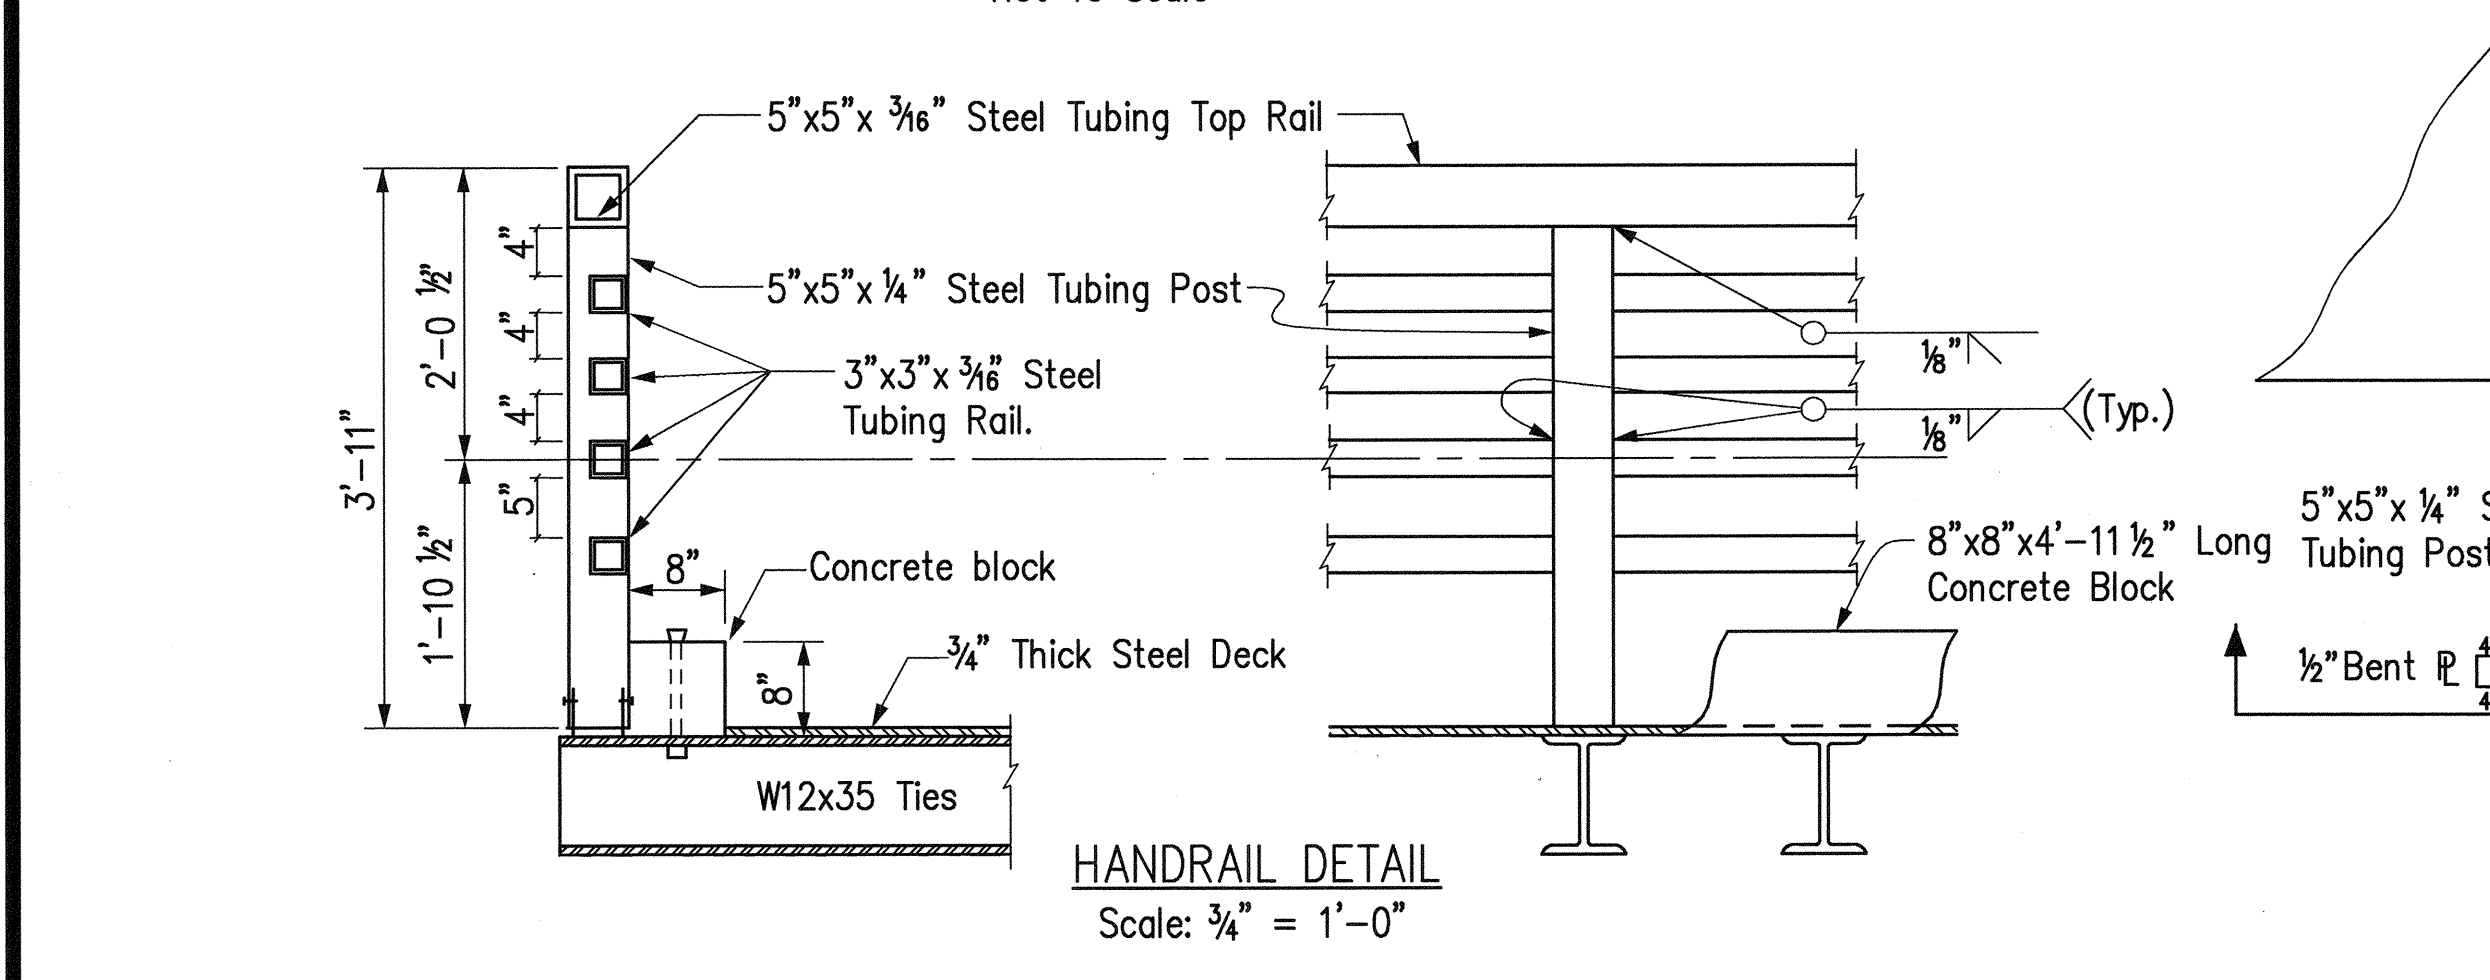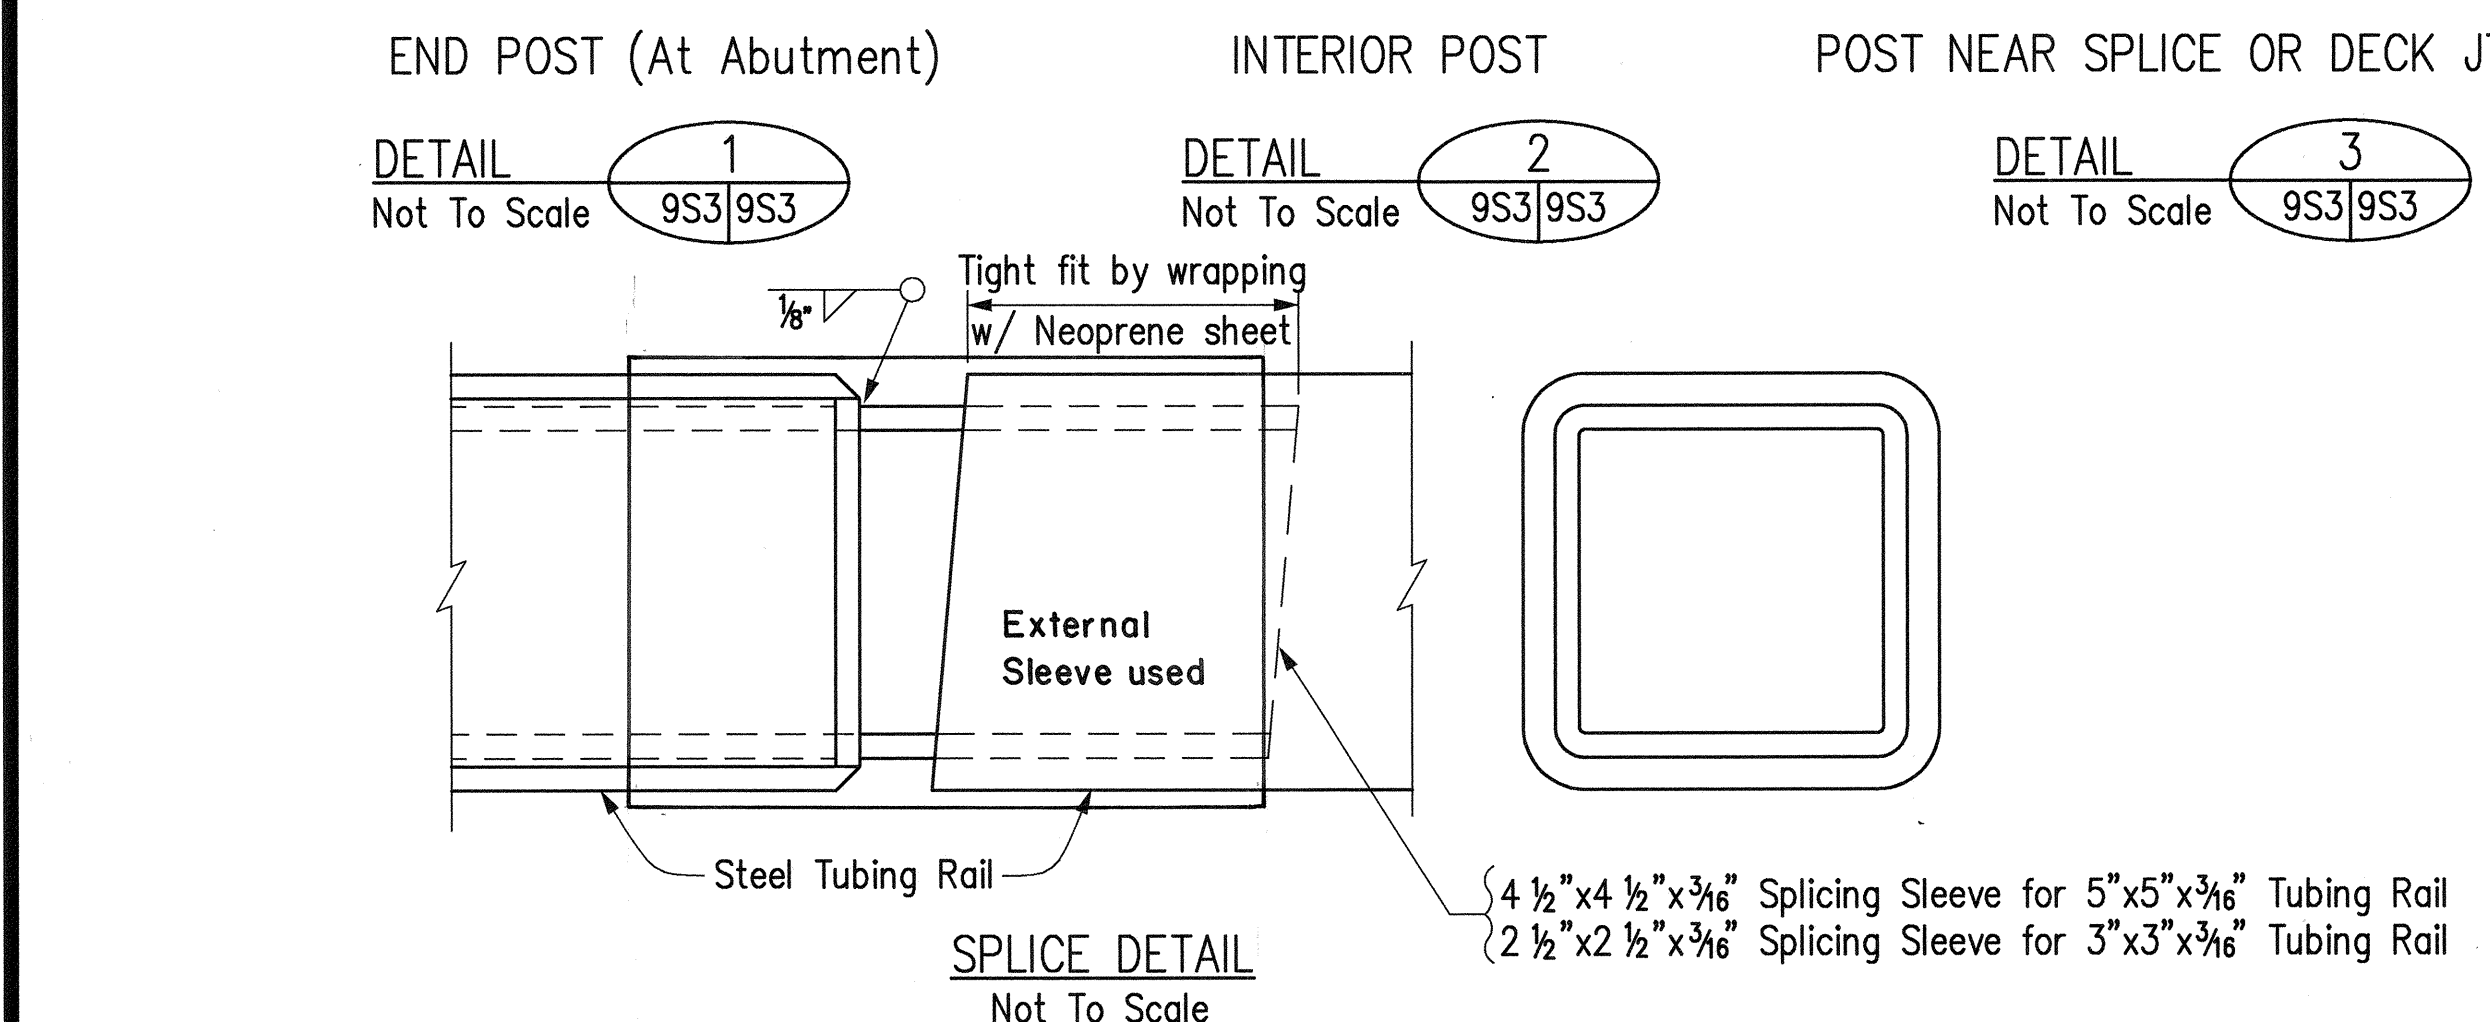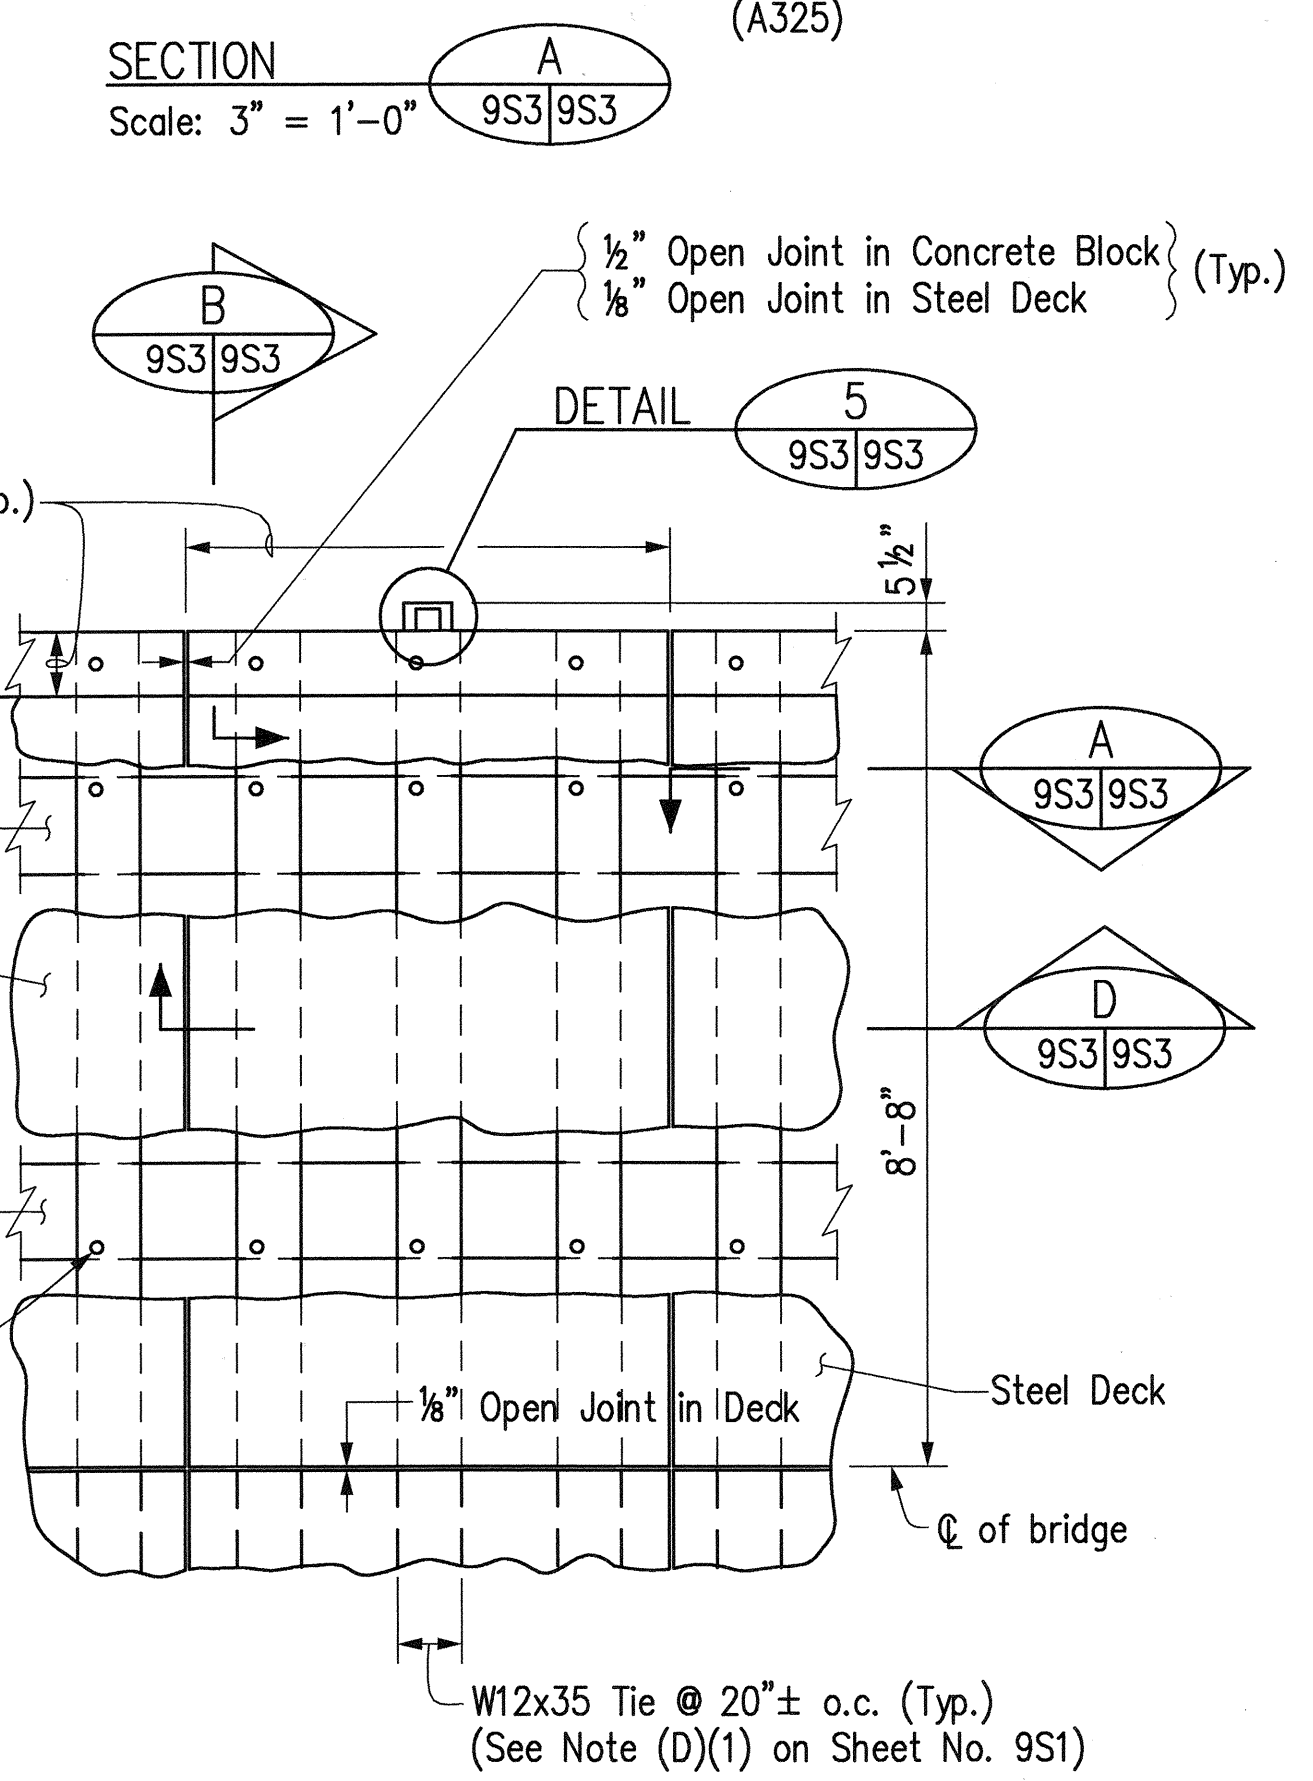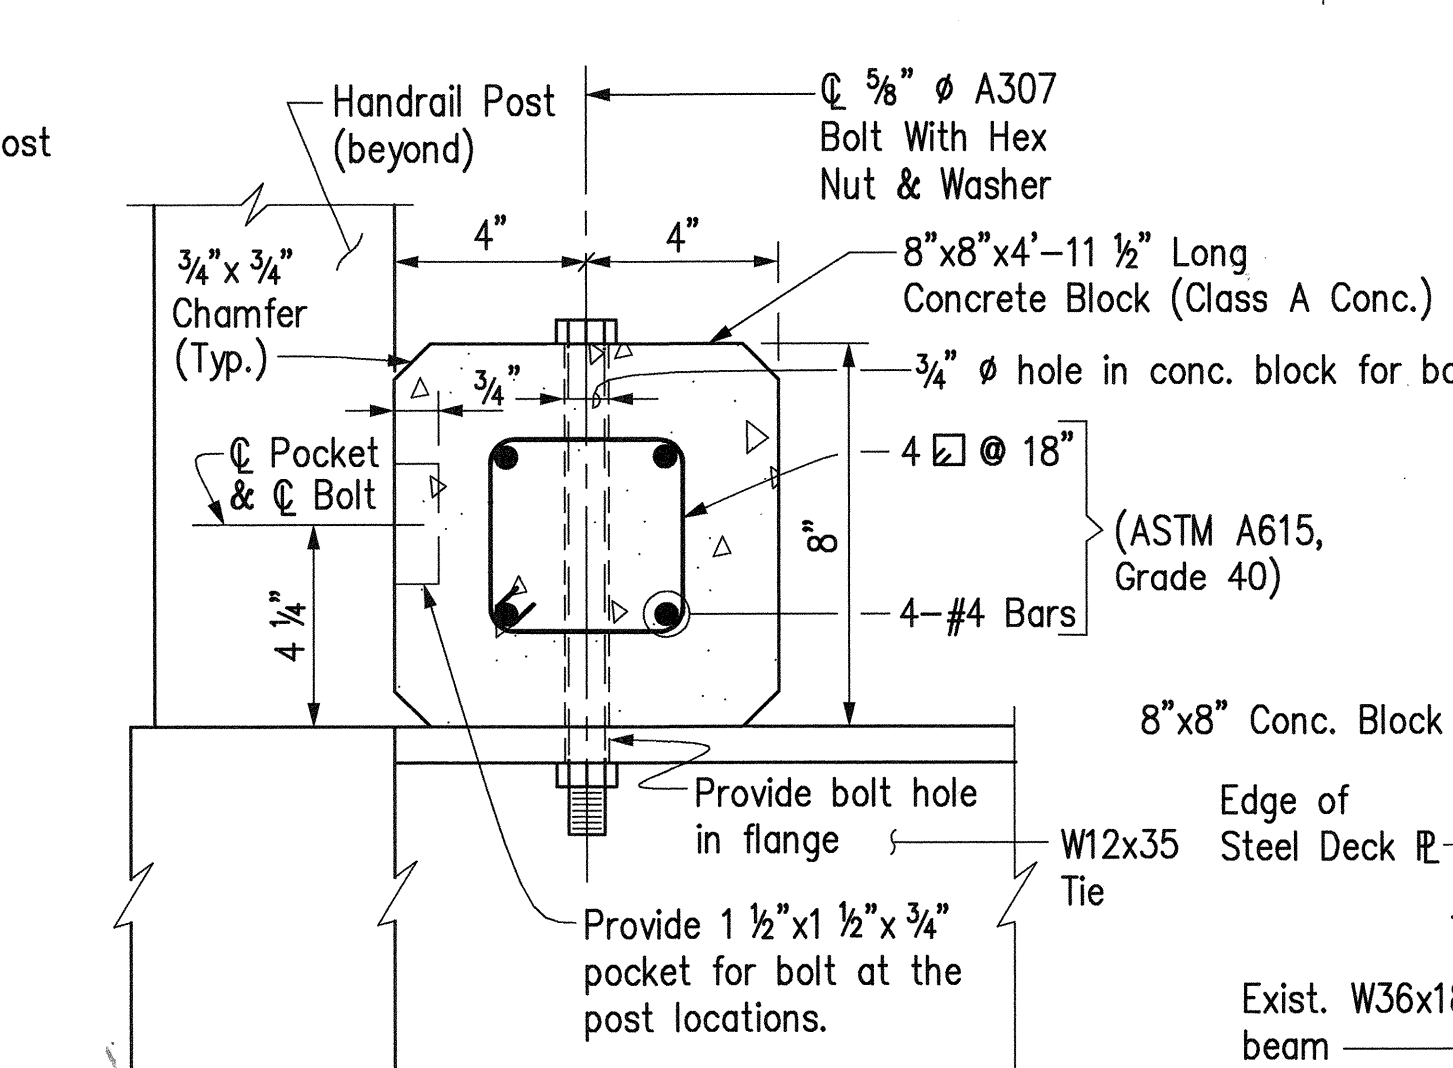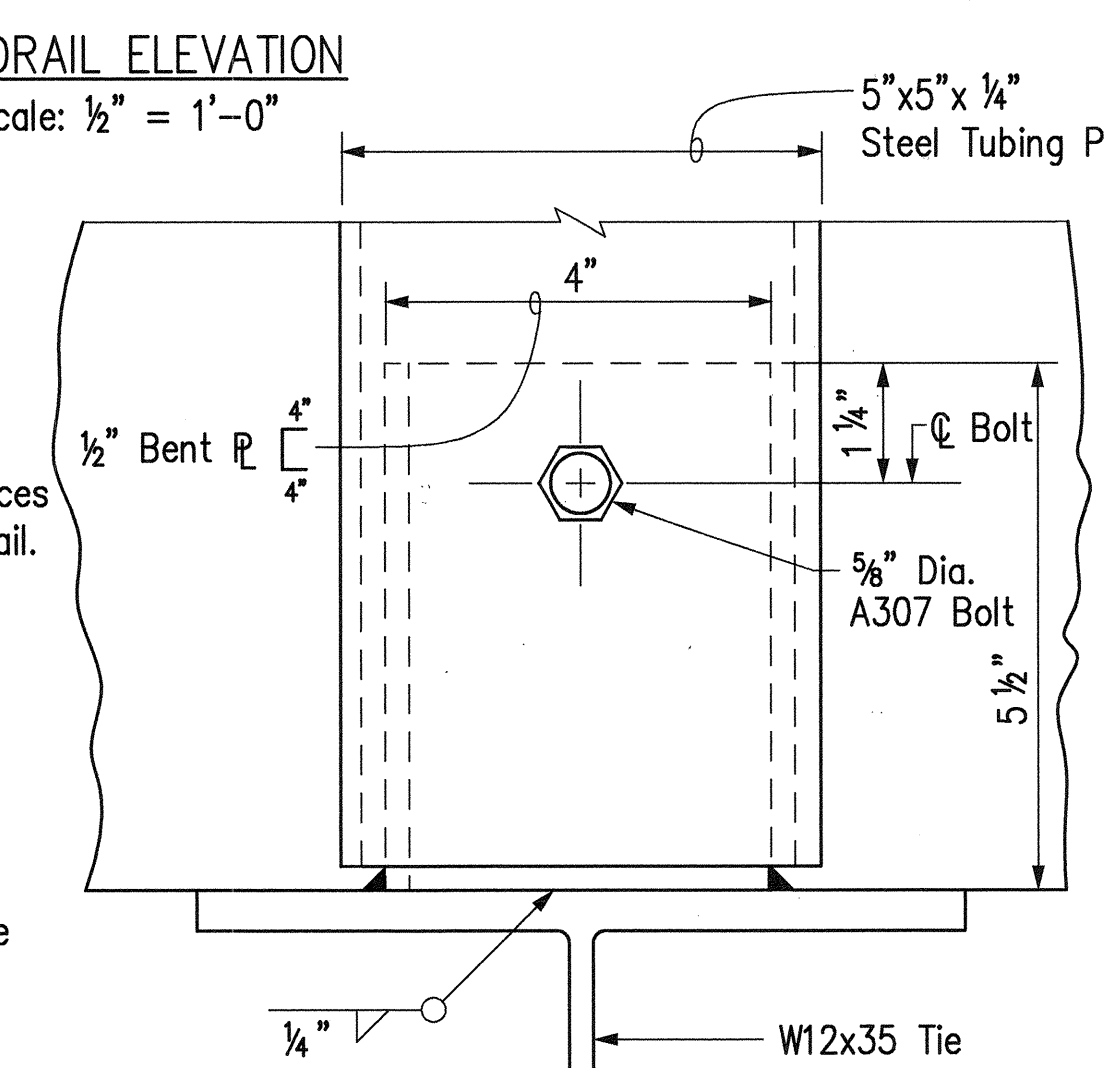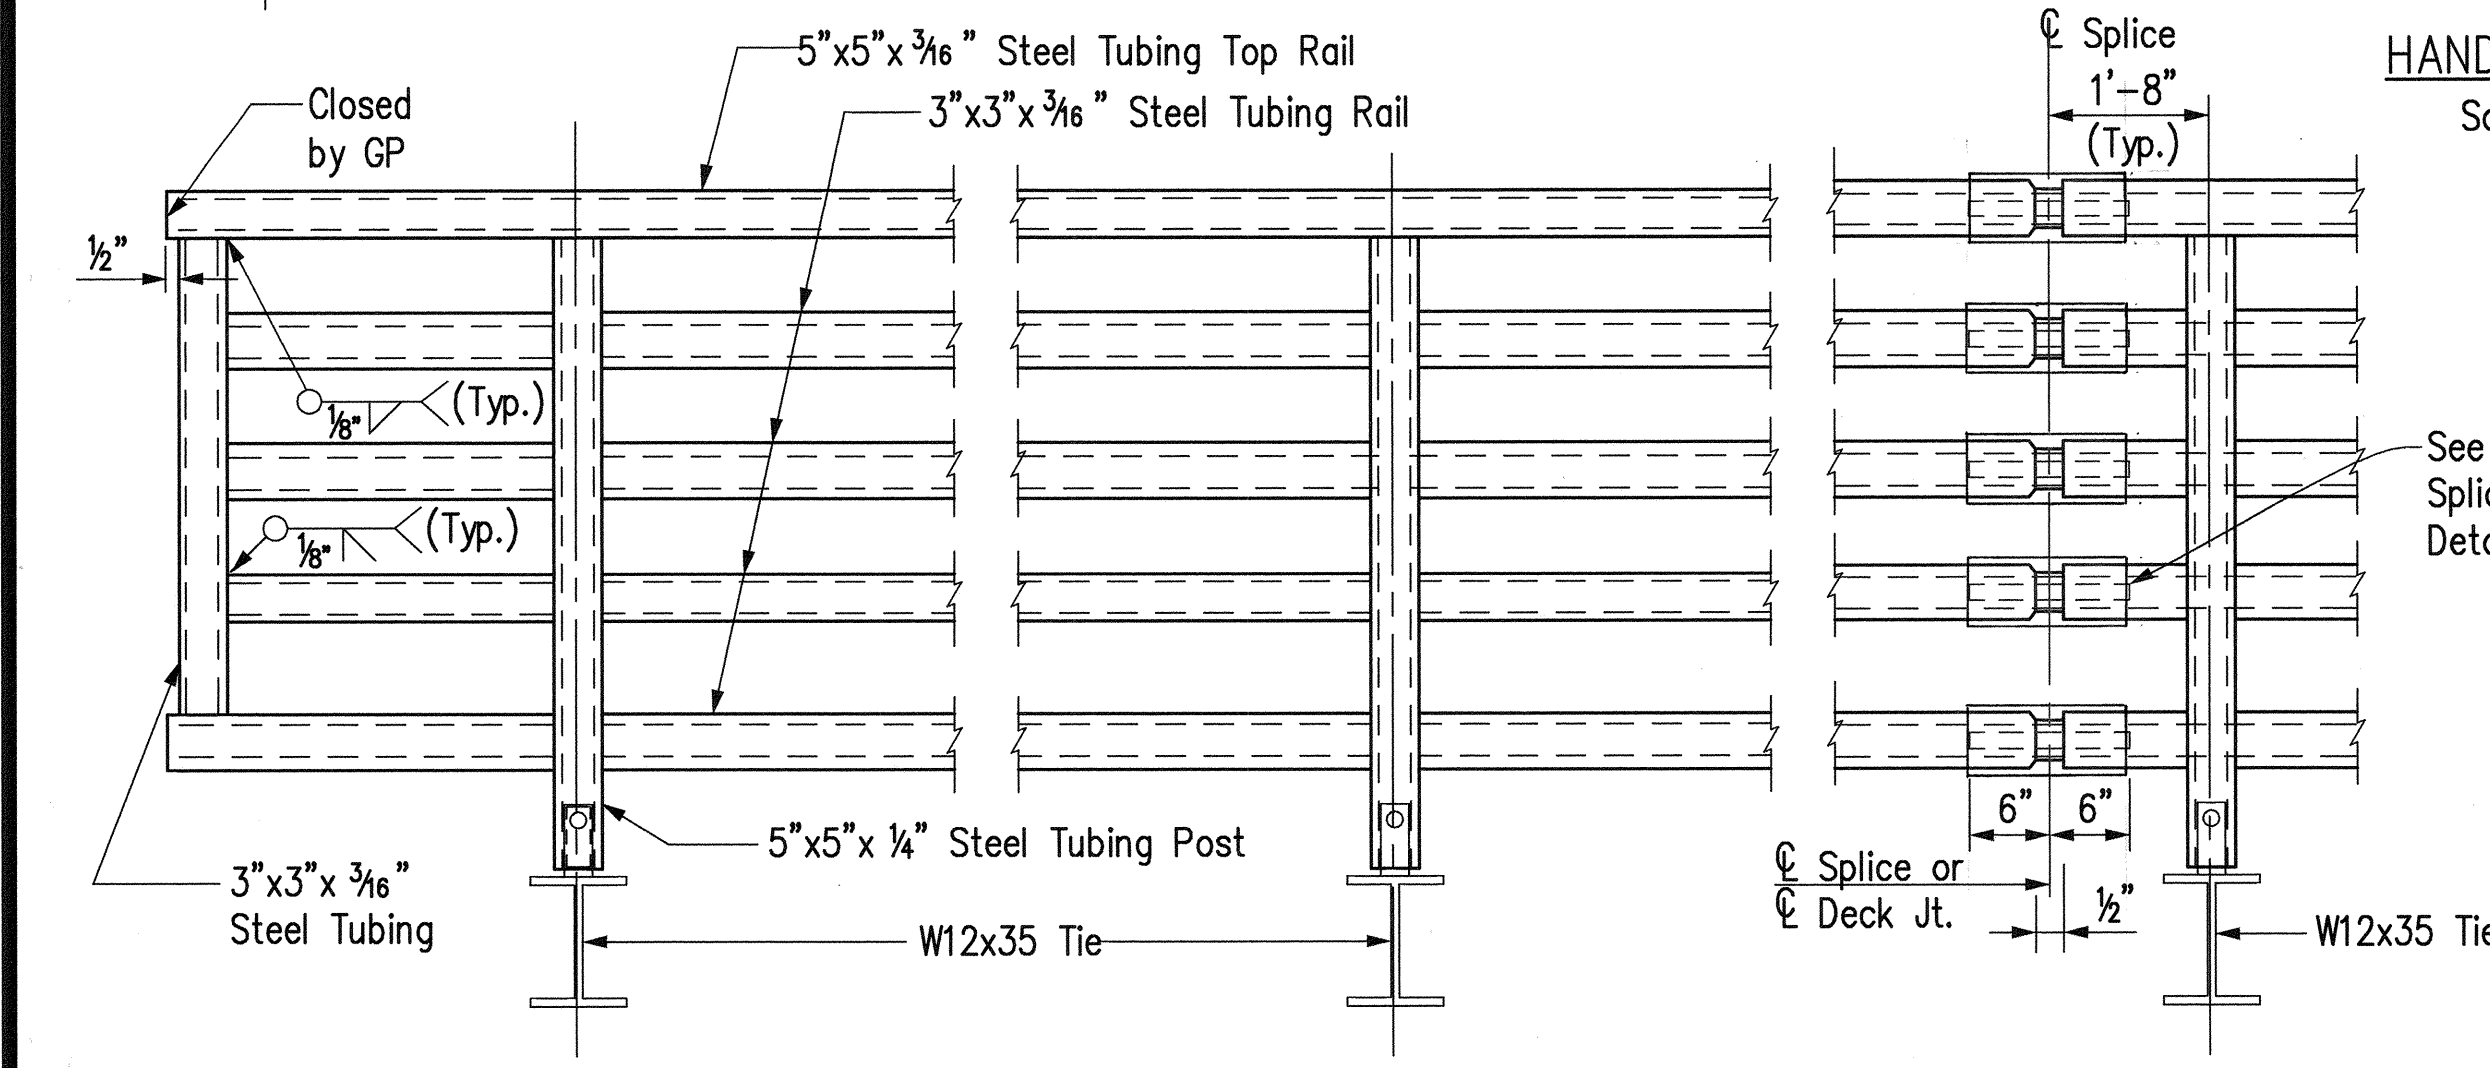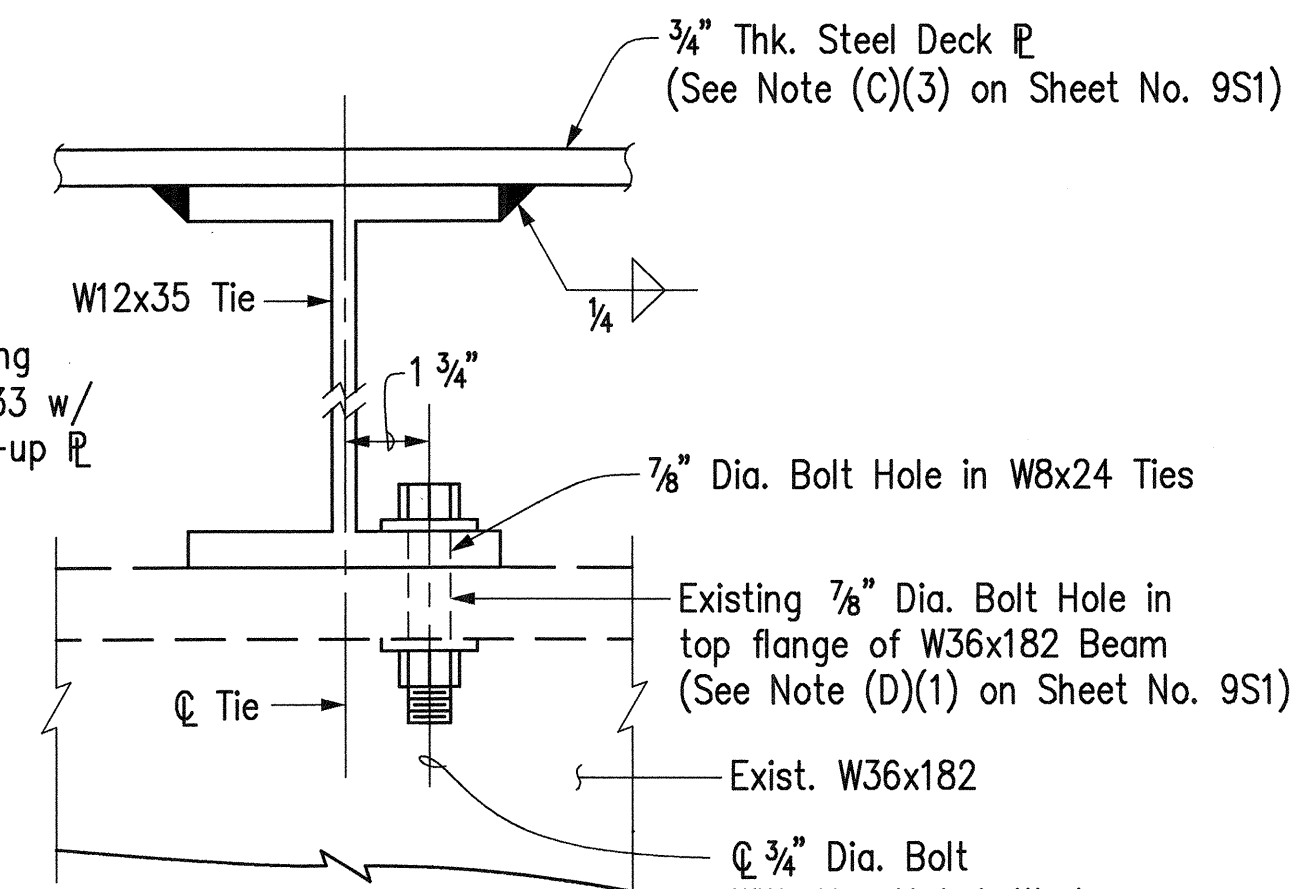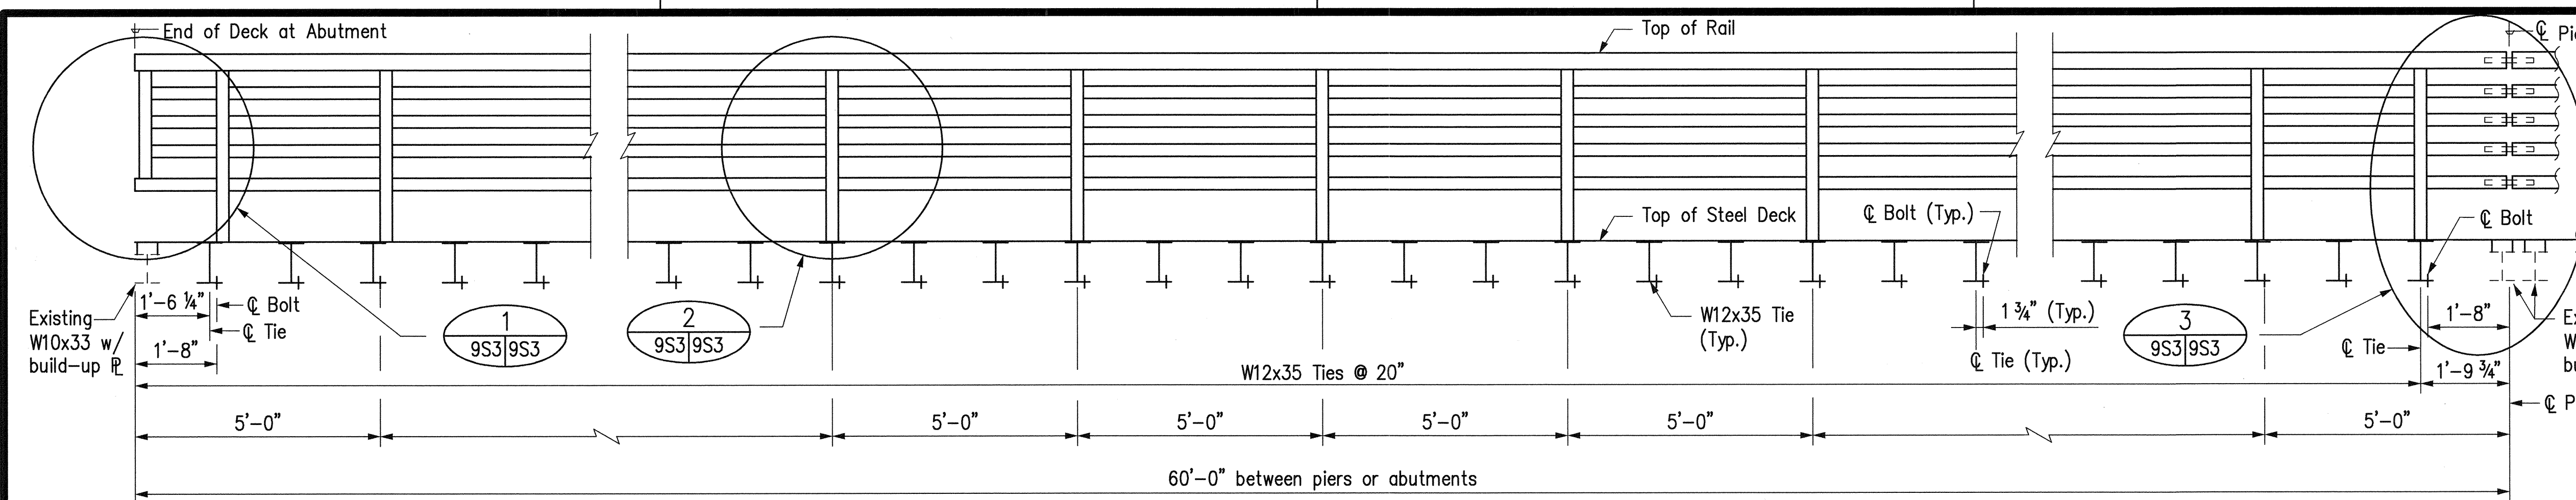

DECK DETAIL 4
Scale: 1/2" = 1'-0"

10/13/95
Revised Handrail Elevation, Handrail Detail, Details 1/9S3 thru 5/9S3, Sections A/9S3, B/9S3, C/9S3 & D/9S3.

Date Revision

STATE OF HAWAII
DEPARTMENT OF TRANSPORTATION
HIGHWAYS DIVISION

HAIKU ACCESS ROAD RESTORATION

BRIDGE DETAILS - 2

HAIKU ACCESS ROAD

H-3 FINISH (UNIT III)
FAIP NO. I-H3-1(75), UNIT III
I.K. TUNNEL/ACCESS ROADS

SCALE: AS SHOWN DATE: JUNE 1995

SHEET NO. 9S3 OF 3 SHEETS

ADD.347

SURVEY PLOTTED BY	DATE
DRAWN BY	
DESIGNED BY	
NOTED BY	
CHECKED BY	
ORIGINAL PLAN	
NOTE BOOK	
QUANTITIES BY	
No.	

GAD by J. Minura, 95-52

Last Saved: J:\H3R\U3\DET\BR-DTL2.dwg 10/09/95 at 13:48