

FED. ROAD DIST. NO.	STATE	FED. AID PROJ. NO.	FISCAL YEAR	SHEET NO.	TOTAL SHEETS
HAWAII	HAW.	1-H3-1(75) UNIT III	1994	210	353




NOTES:

1. BASE MAP BY AIR SURVEY HAWAII, INC. FEB. 28, 1994.
2. LAYOUT OF EARTH RETAINING WALLS TO GENERALLY CONFORM TO PLAN DIMENSIONS AS SHOWN.
3. ALL FINISHED GRADES SHOWN AT OPEN CUT EXCAVATION SLOPES AND AT BACKFILL SLOPES BEHIND EARTH RETAINING WALLS ARE AT TOP OF TOPSOIL. AT OPEN CUT EXCAVATION CUT 3" BELOW CONTOUR ELEVATIONS SHOWN ON PLANS. AT BACKFILL SLOPES PROVIDE BACKFILL 3" BELOW SLOPES SHOWN ON PLANS.
4. COVER FINISHED GRADE SURFACES OF BACKFILLED SLOPES WITH EROSION CONTROL MATTING. SEE SECTION 663 OF THE SPECIAL PROVISIONS.
5. FOR CONCRETE SWALES, SEE SHEET NO. 5C8.

FOR DETAIL AS-BUILT INFORMATION
REFER TO CONSTRUCTION SUBMITTALS

DATE	REVISION
3/17/97	DCN 75-014: MODIFIED EAST END OF KNOLL WALL AT EL 1142
4/18/96	DCN 75-001: REV. SWALE ALONG PORTAL BLDG WALL PER RESPONSE TO RFI NO. 4097-25
10/27/95	ADDENDUM 2 - REVISED NOTE 5
STATE OF HAWAII DEPARTMENT OF TRANSPORTATION HIGHWAYS DIVISION SITE PLAN KNOLL REMEDIATION H-3 FINISH (UNIT III) FAIP NO. 1-H3-1(75), UNIT III T.K. TUNNEL / ACCESS ROADS SCALE: 1"=20'-0" DATE: JUN 1995	
SHEET NO.	4S1 OF 3 SHEETS


ORIGINAL PLAN	DATE
SURVEY PLOTTED BY	JAN 95
DRAWN BY	B. VOONG
TRACED BY	G. TE BOKERHIST
DESIGNED BY	JAN 95
CHECKED BY	D. MANITI
NO.	

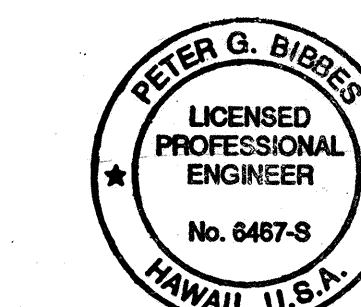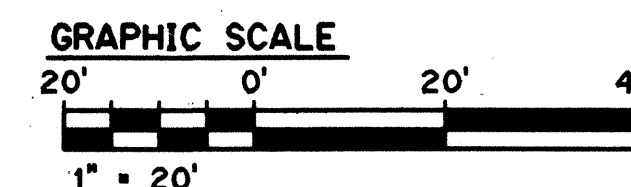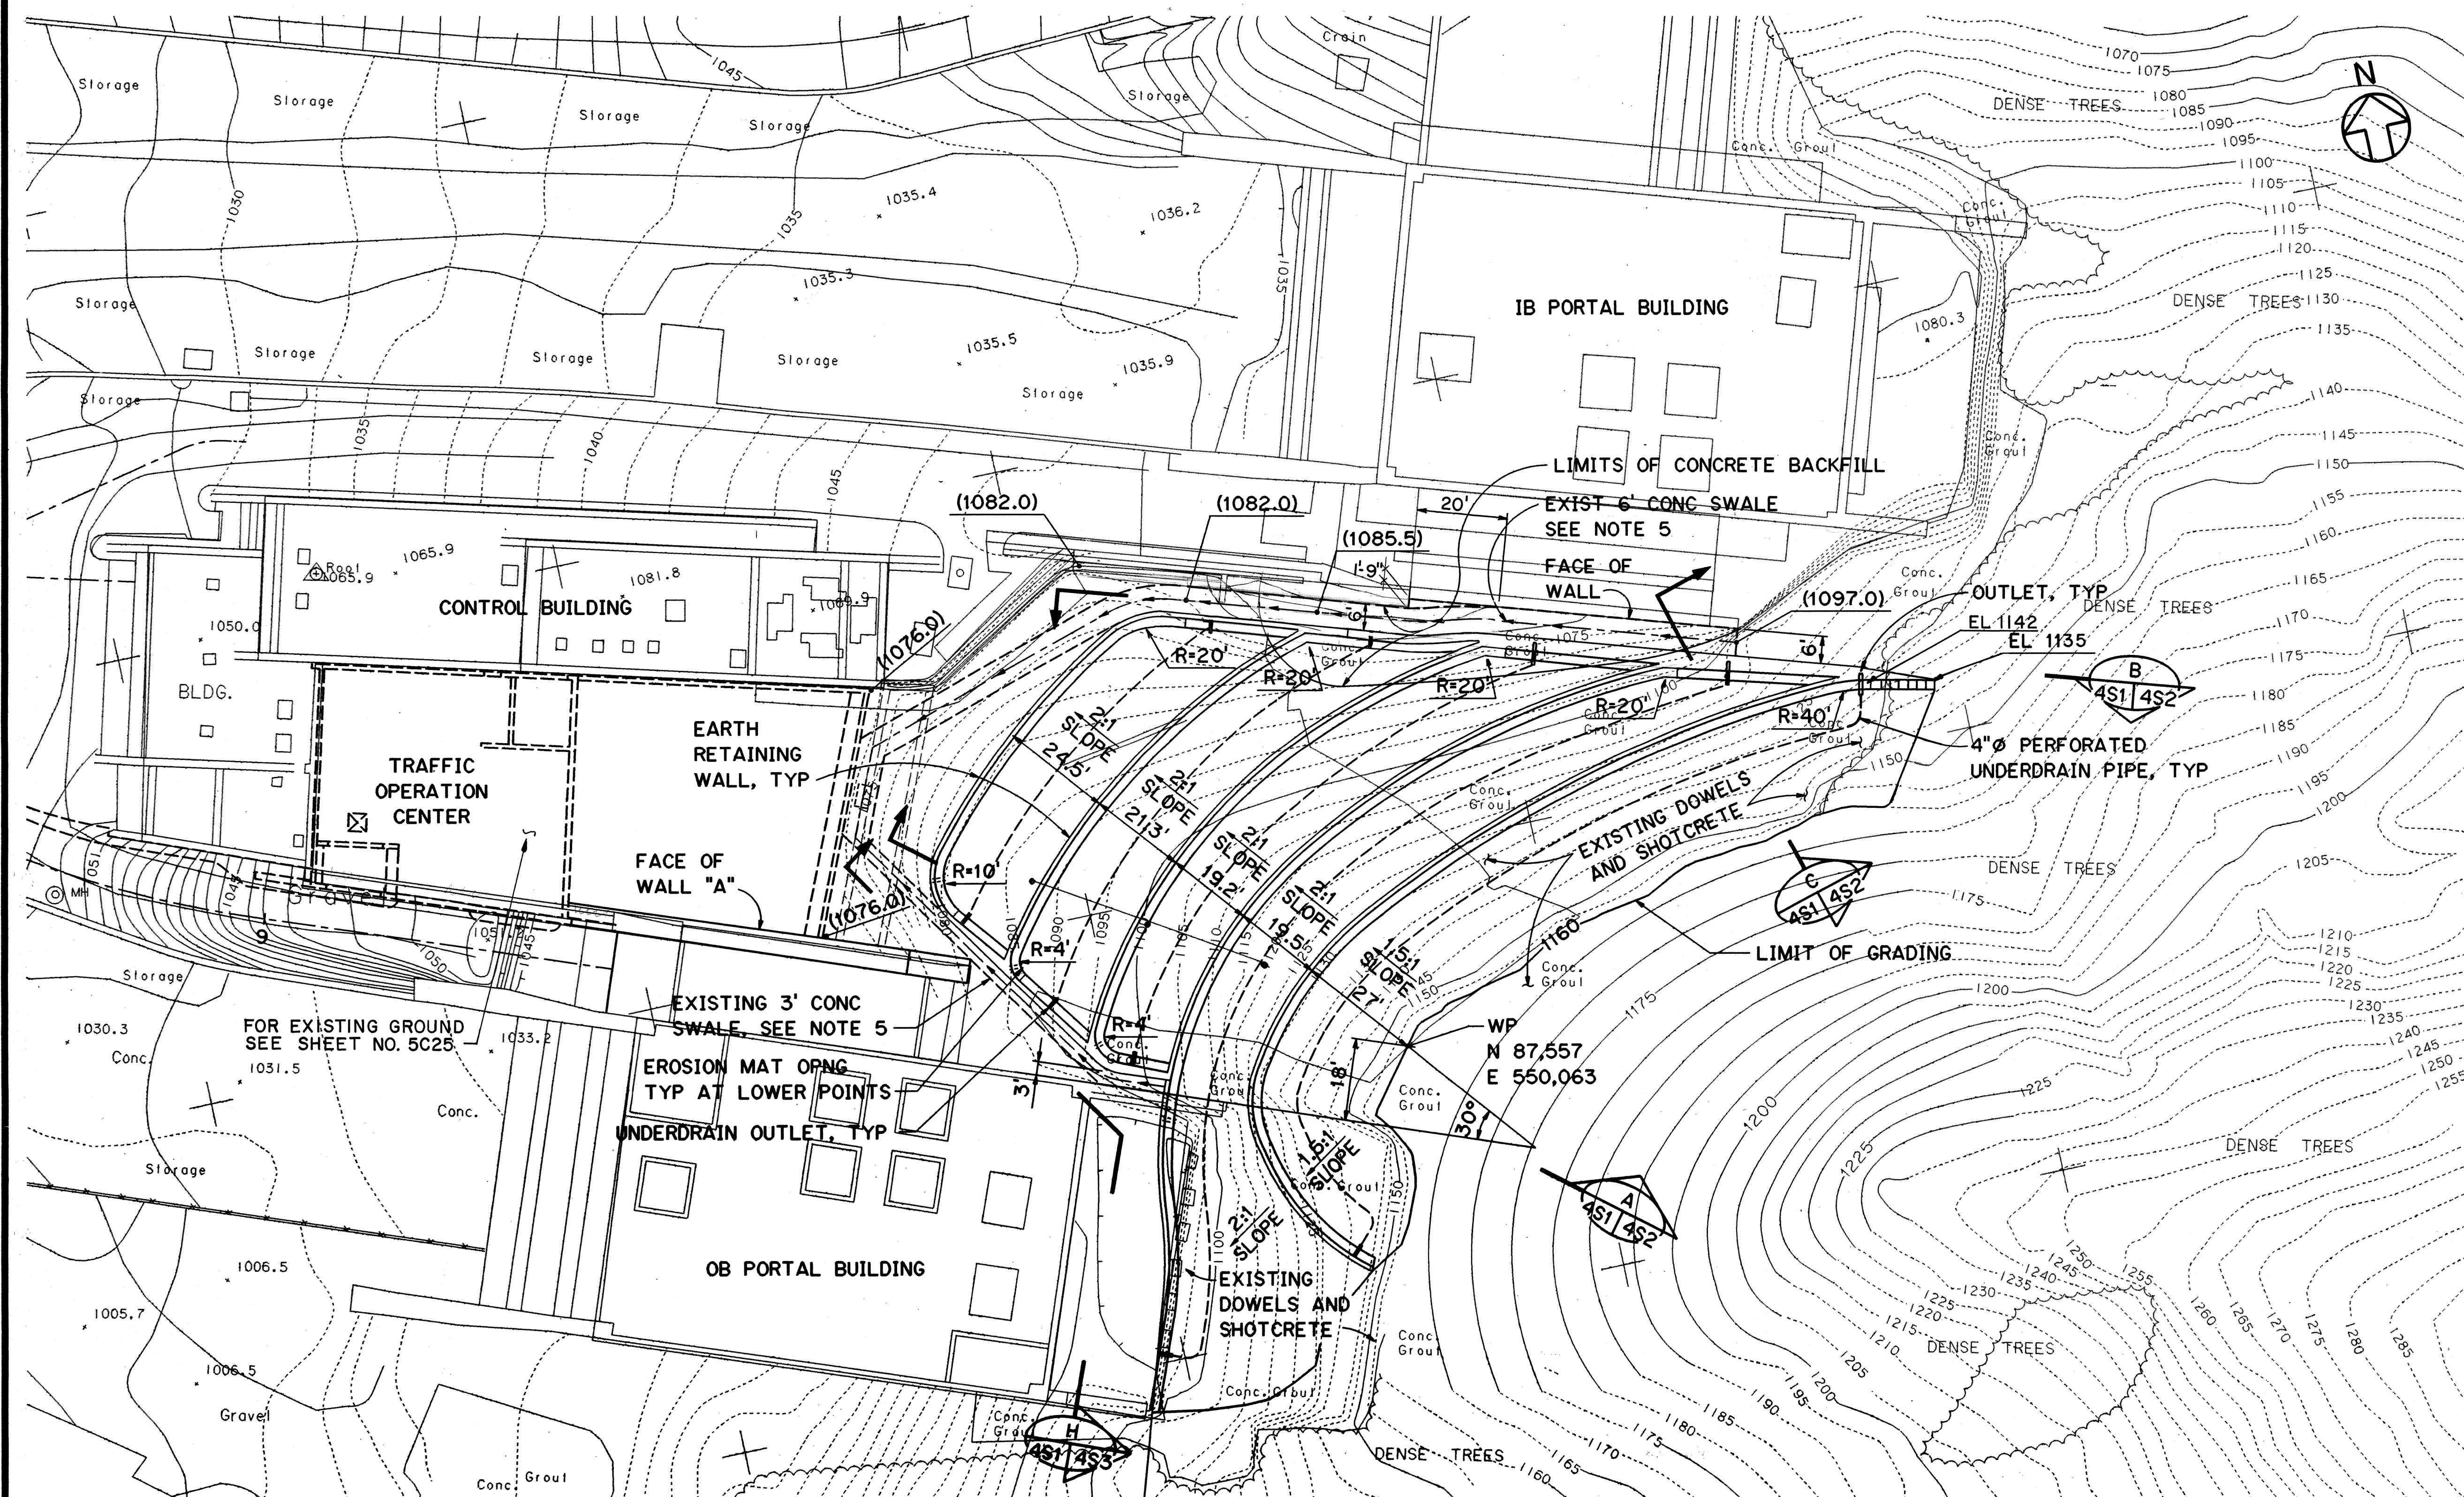


THIS WORK WAS PREPARED BY ME
OR UNDER MY SUPERVISION

Peter G. Birges


FED. ROAD DIST. NO.	STATE	FED. AID PROJ. NO.	FISCAL YEAR	SHEET NO.	TOTAL SHEETS
HAWAII	HAW.	I-H3-1(75) UNIT III	1994	211	353

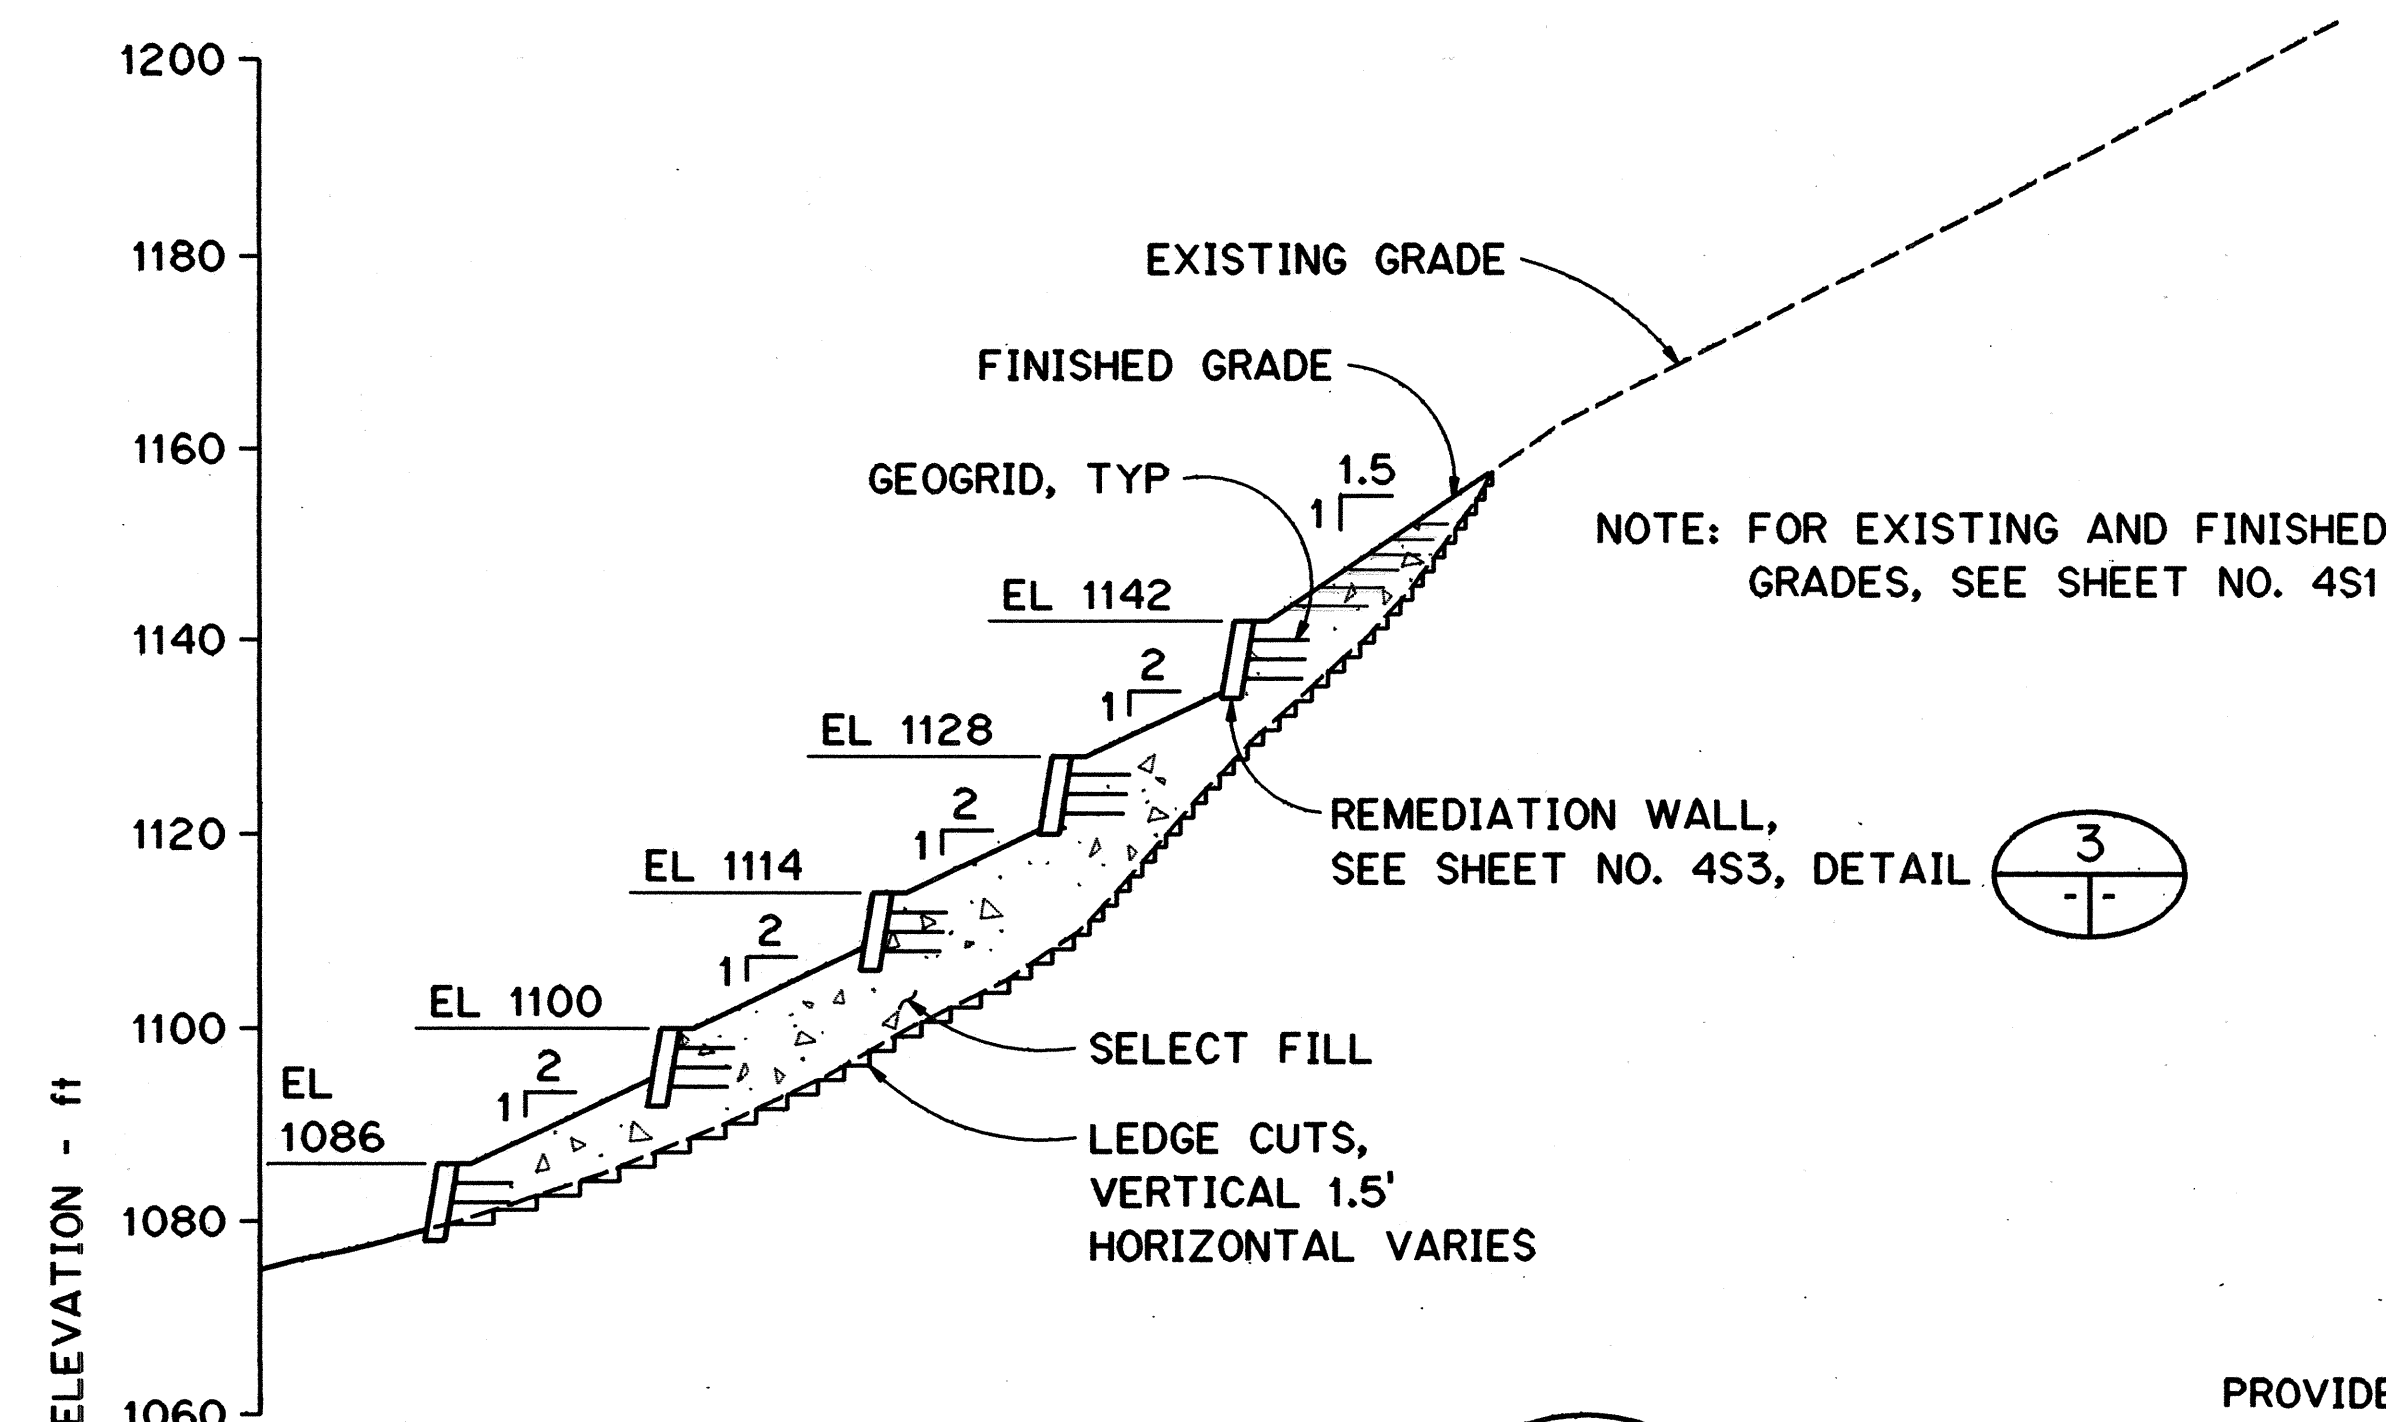


SECTION A
SCALE: 1"=20'
4S1 4S2

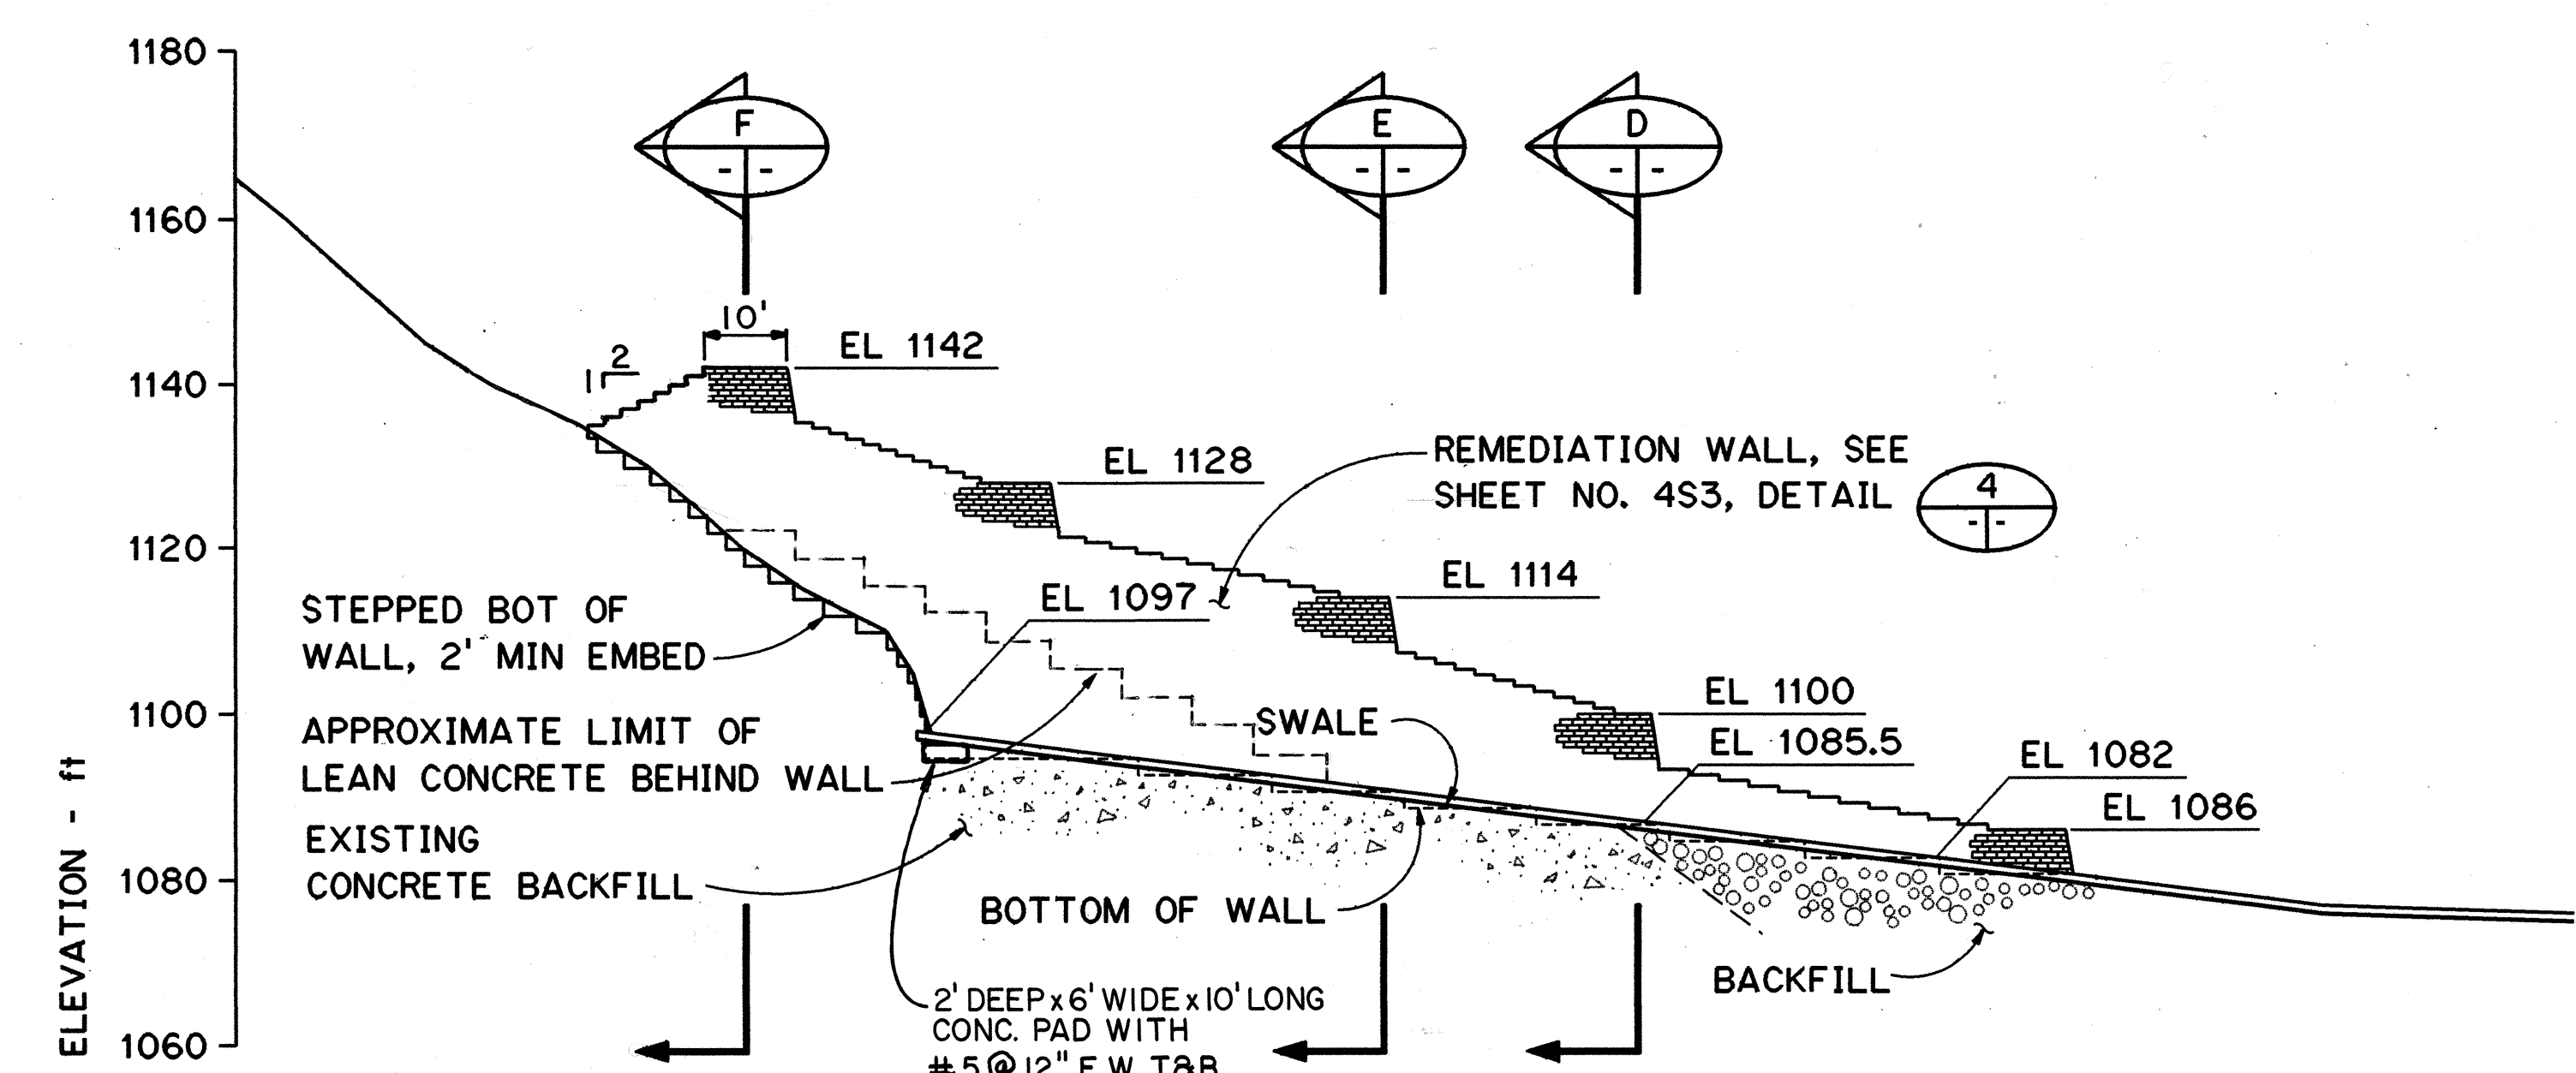


ELEVATION B
SCALE: 1"=20'
4S1 4S2

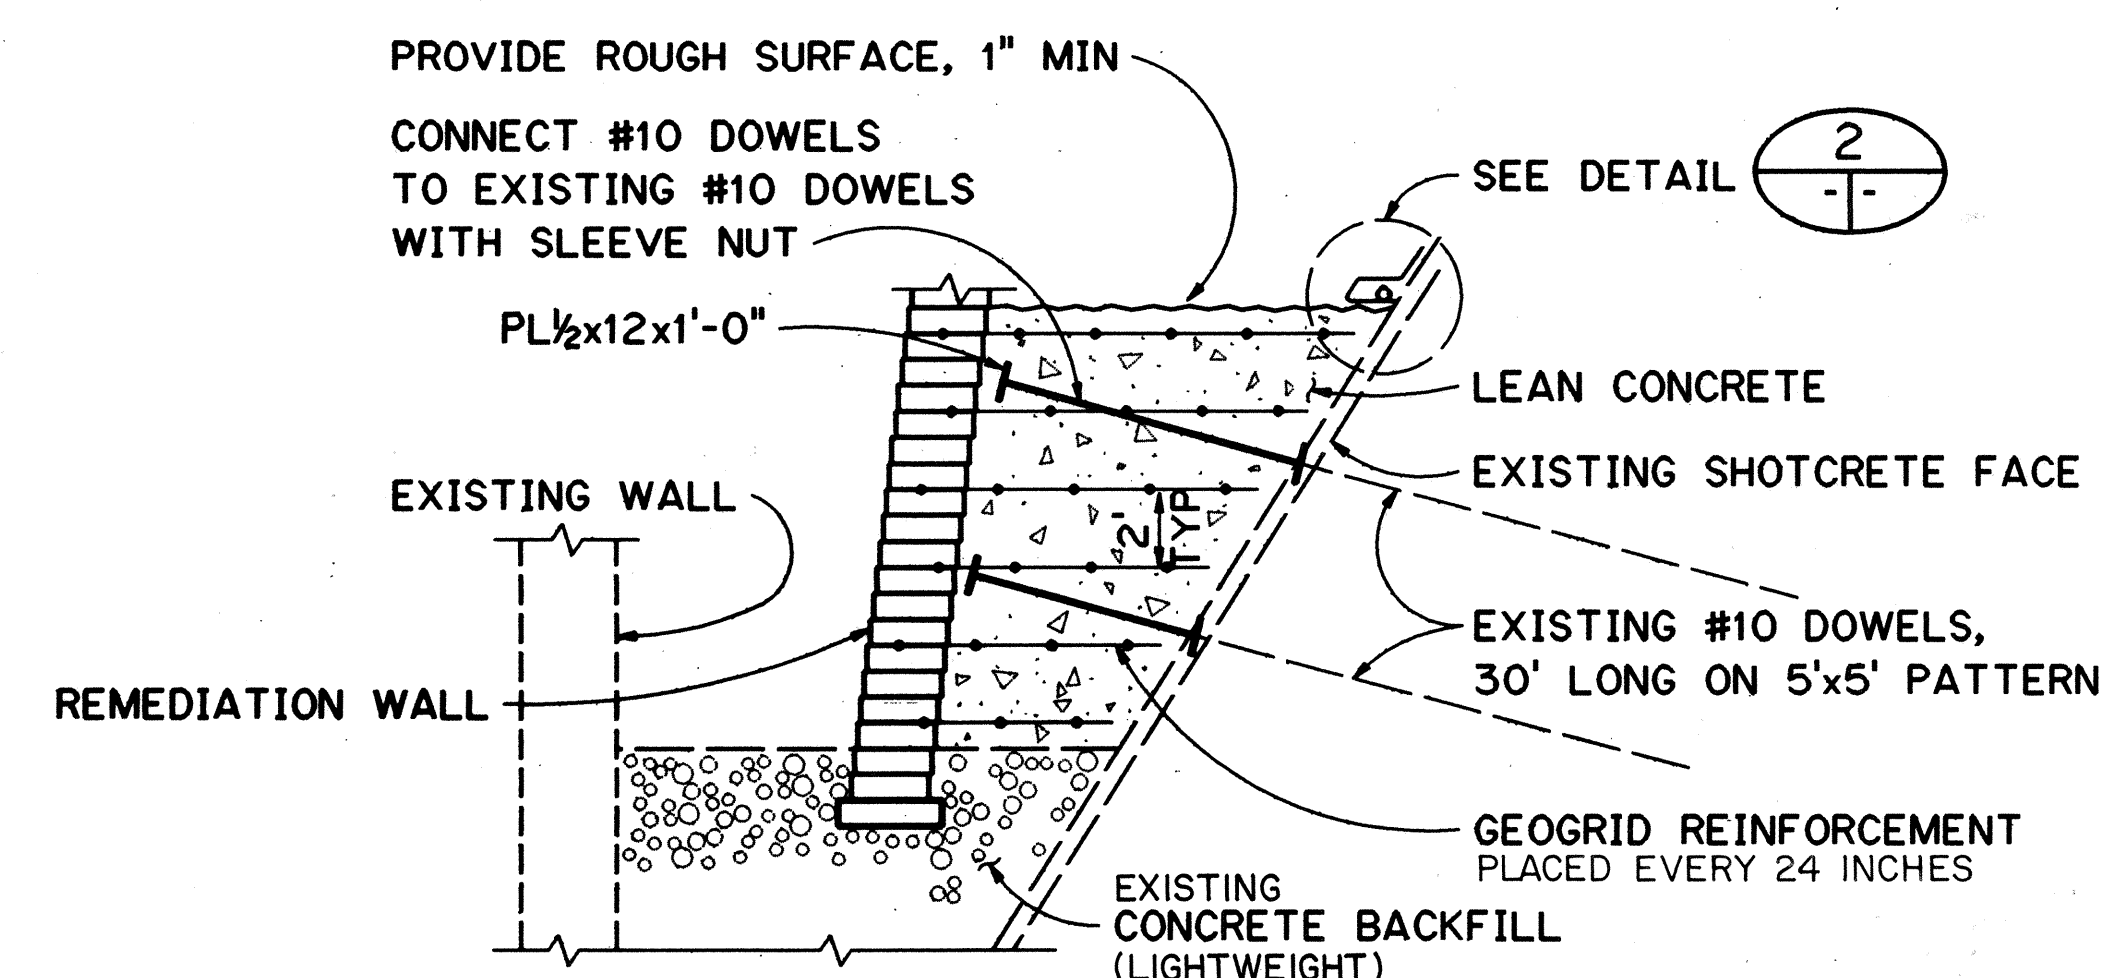


DETAIL 1
NTS

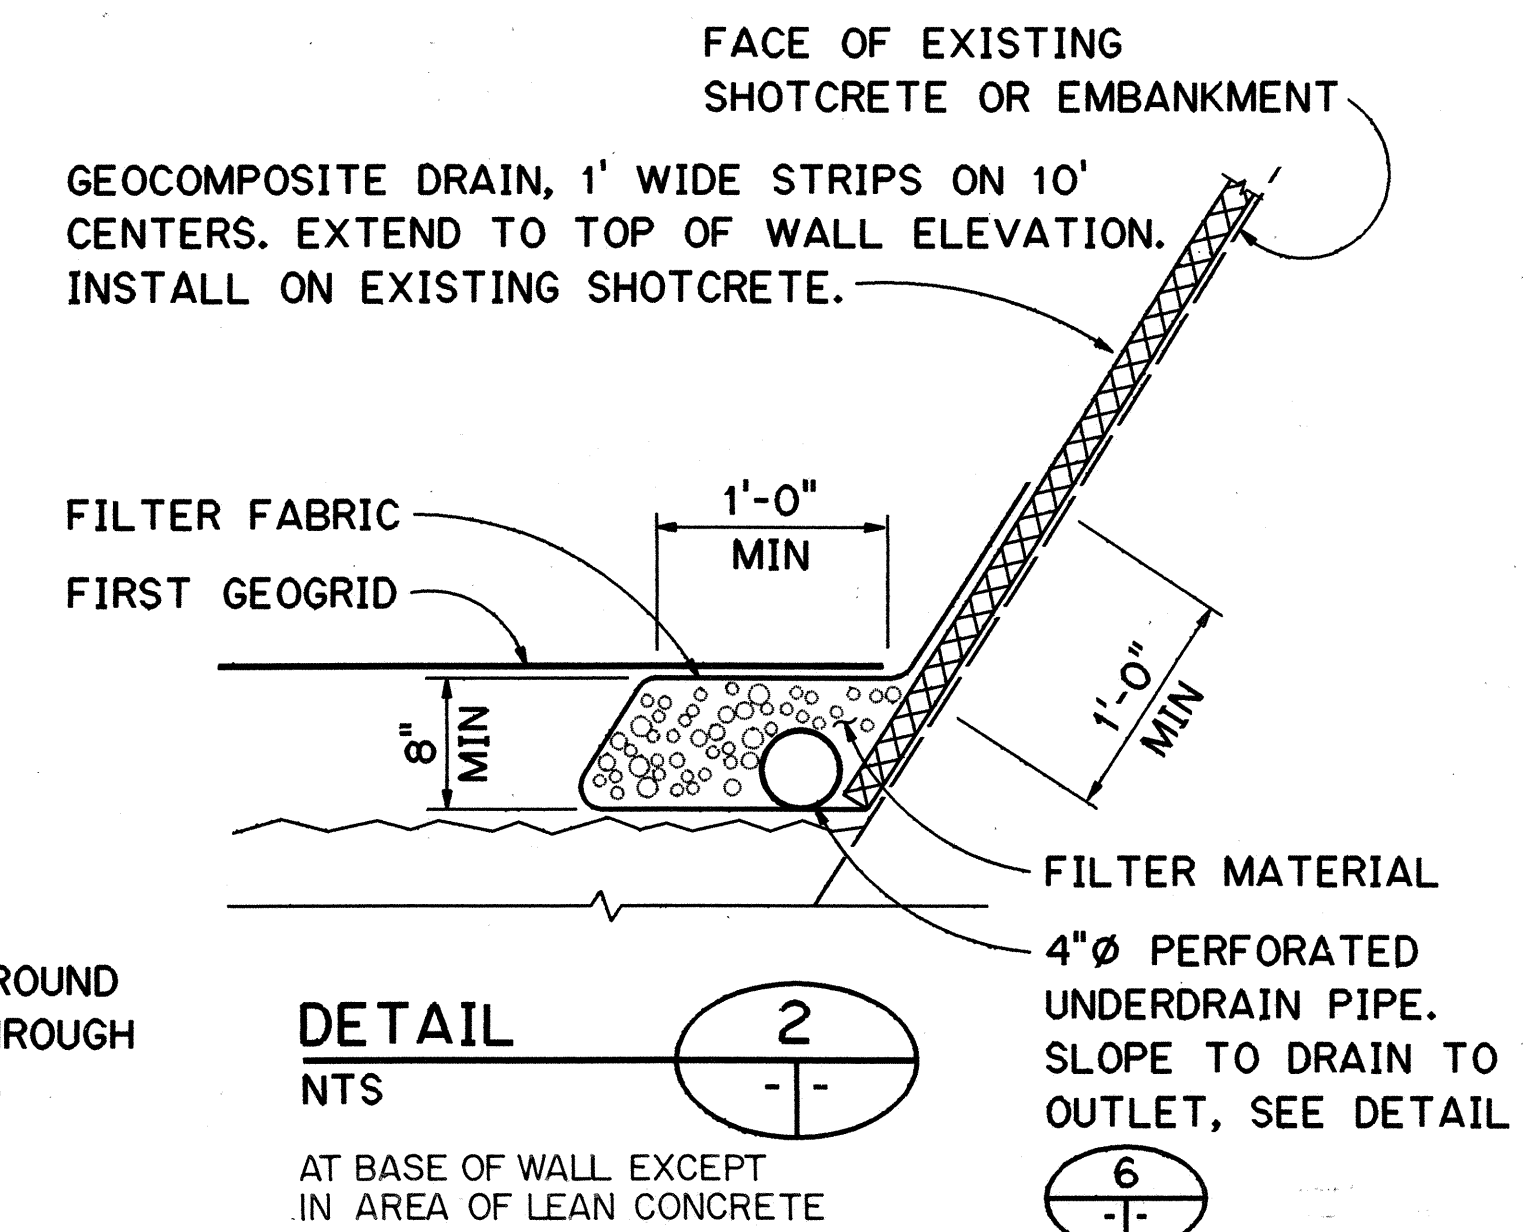


DETAIL 2
NTS

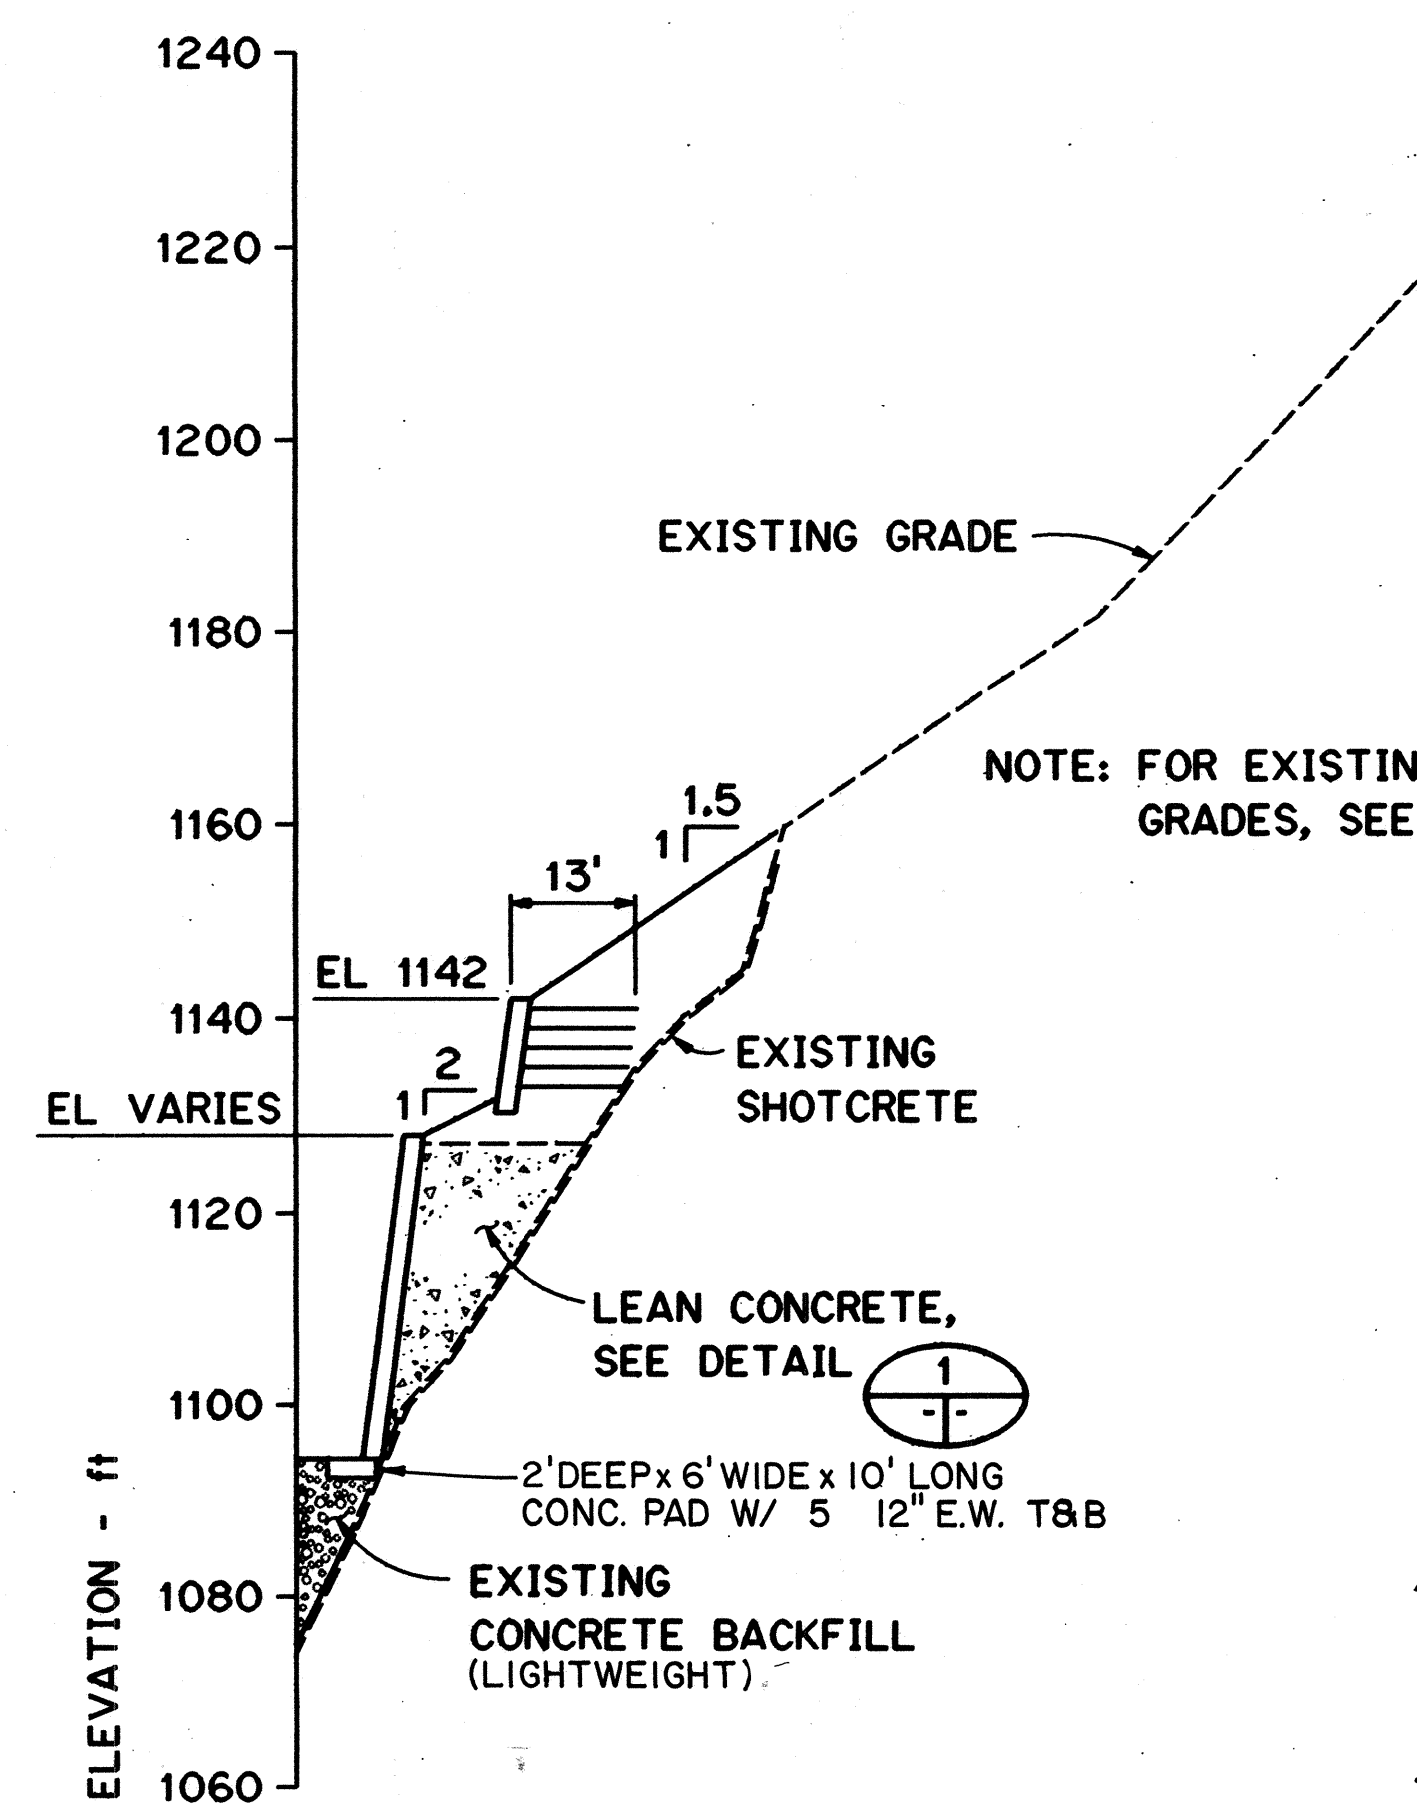


SECTION C
SCALE: 1"=20'
4S1 4S2

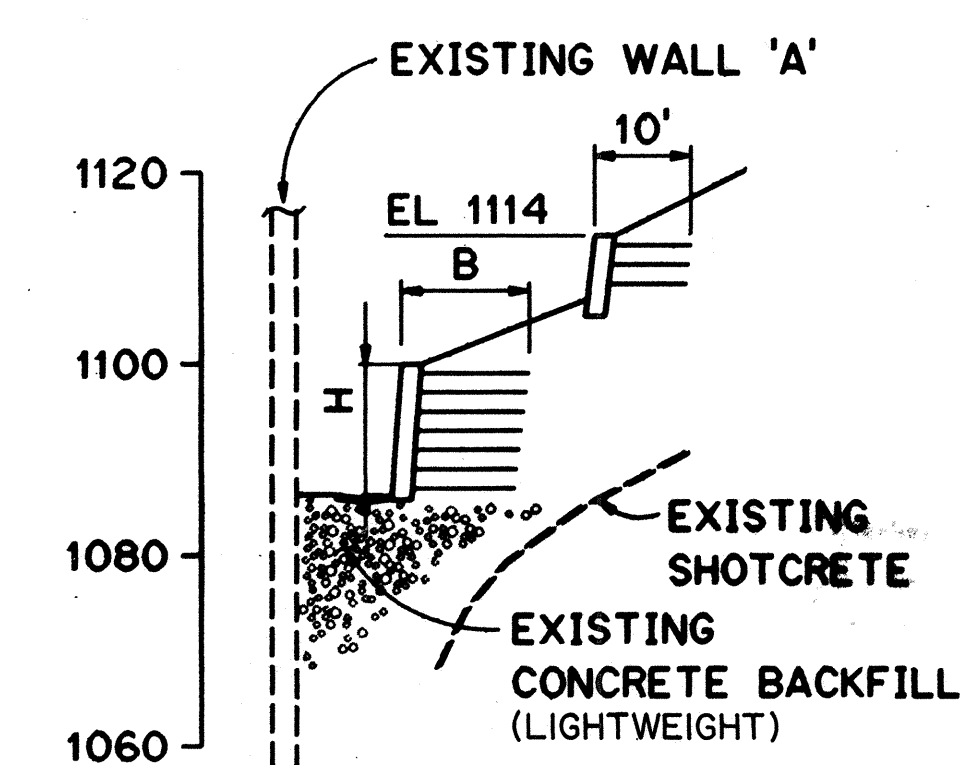


SECTION D
SCALE: 1"=20'
4S1 4S2

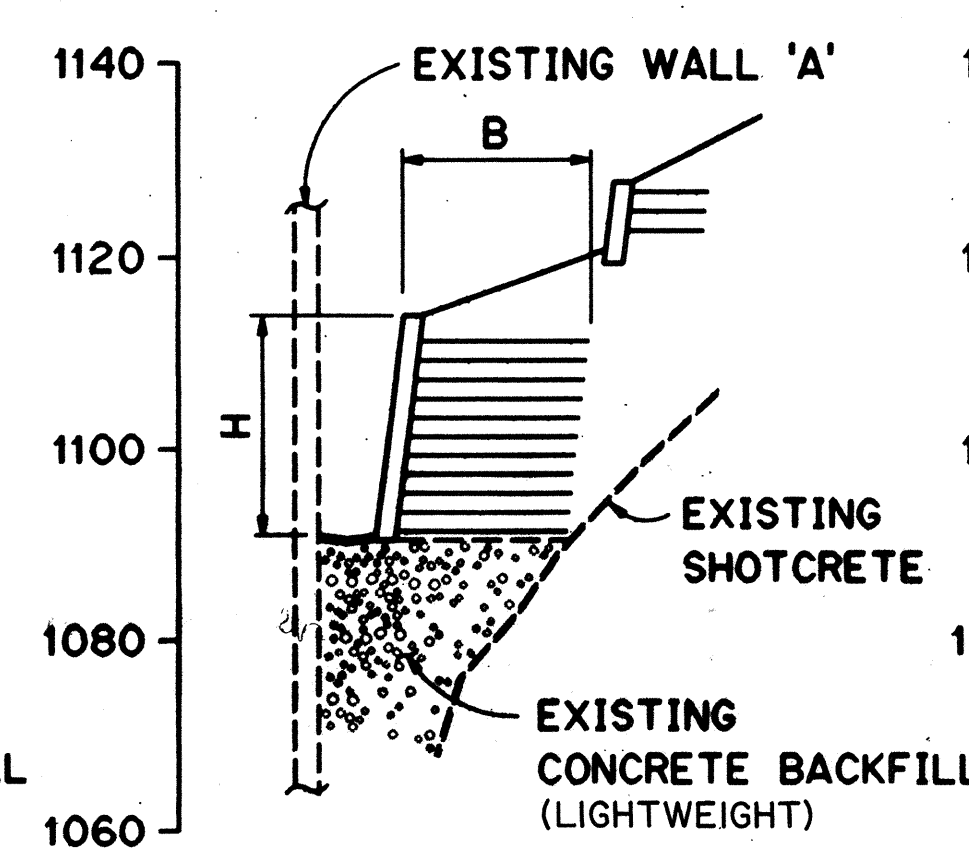



SECTION E
SCALE: 1"=20'
4S1 4S2

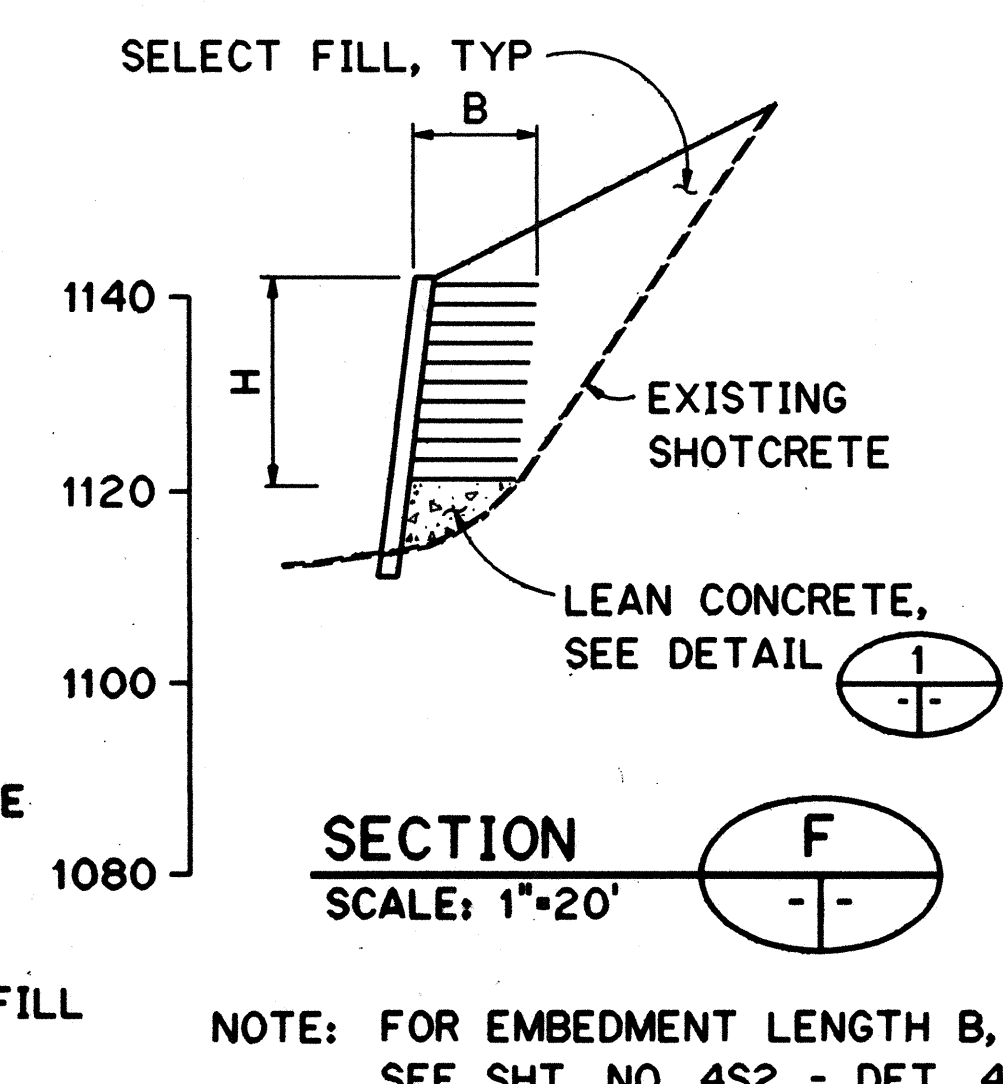

SECTION F
SCALE: 1"=20'
4S1 4S2

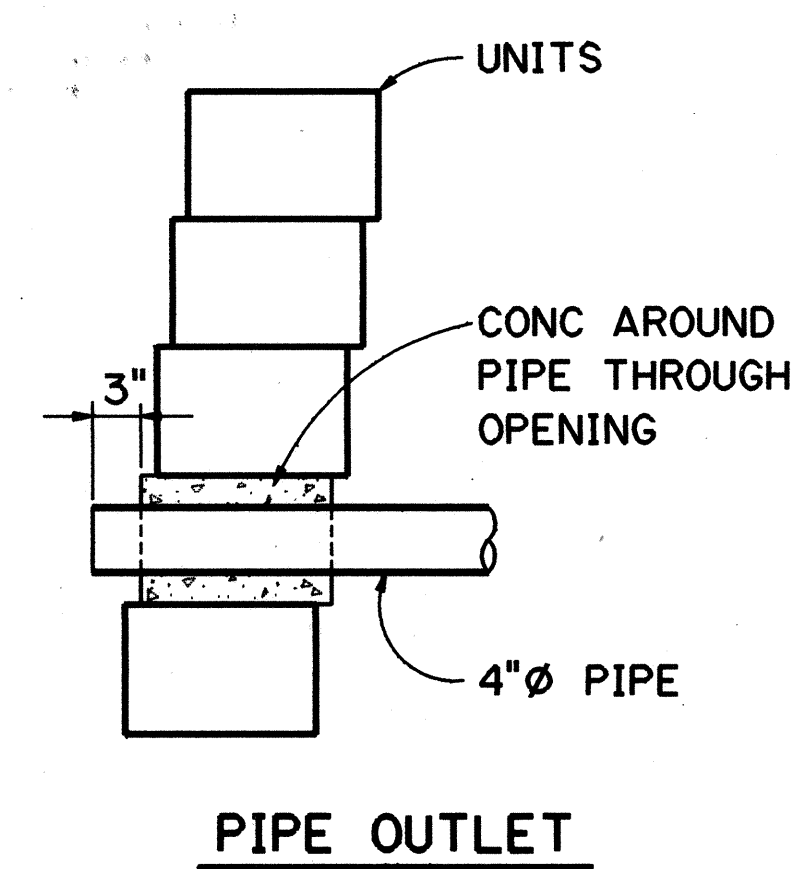

DETAIL 6
NTS

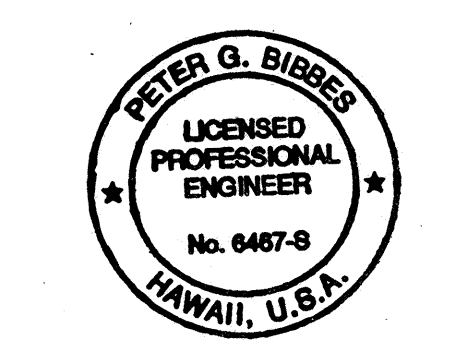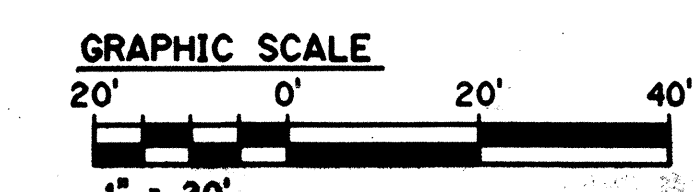

THIS WORK WAS PREPARED BY ME
OR UNDER MY SUPERVISION
Peter G. Birder

DATE	REVISION
3/17/97	DCN75-014: MODIFIED KNOLL WALL AT EL 1142, ELEVATION 'B'
STATE OF HAWAII DEPARTMENT OF TRANSPORTATION HIGHWAYS DIVISION SECTIONS AND DETAILS - 1 KNOLL REMEDIATION H-3 FINISH (UNIT III) FAIP NO. I-H3-1(75), UNIT III T.K. TUNNEL / ACCESS ROADS SCALE: AS NOTED DATE: JUN 1995 SHEET NO. 4S2 OF 3 SHEETS	

DATE	JAN 95
DESIGNED BY	G. TE. BOEKHOFF
CHECKED BY	D. MANTY
NO.	

