

ADD. 292S-2, ADD. 292S-3, ADD. 292S-4, ADD. 292S-5,

(7) ADD. 30IS-I, ADD. 30IS-2, C.O. 30IS-3, C.O. 30IS-4,

8 (8) C.O. 305S-1 TO ADD. s and C.O. 305S-19 are

supplementary sheets to this project, added during C.O.,

TOTAL SHEET COUNT after Addendum & "AS BUILT"

Addendum & "AS BUILT" postings.

ADD. 2925-6, 2925-7, C.O. 2925-8, C.O. 2925-9,

STATE OF HAWAII

DEPARTMENT OF TRANSPORTATION

HIGHWAYS DIVISION

HONOLULU, HAWAII

"AS-BUILT"

PLANS FOR


CONSTRUCTION OF A PORTION OF

INTERSTATE ROUTE H-3

Plan Sht. Nos. DADD.165-I, ADD.1575-I, ADD.2015-I, ADD

DISTRICTS OF KOOLAUPOKO AND EWA ISLAND OF OAHU

PROJECT LOCATION
F.A.I. PROJEC

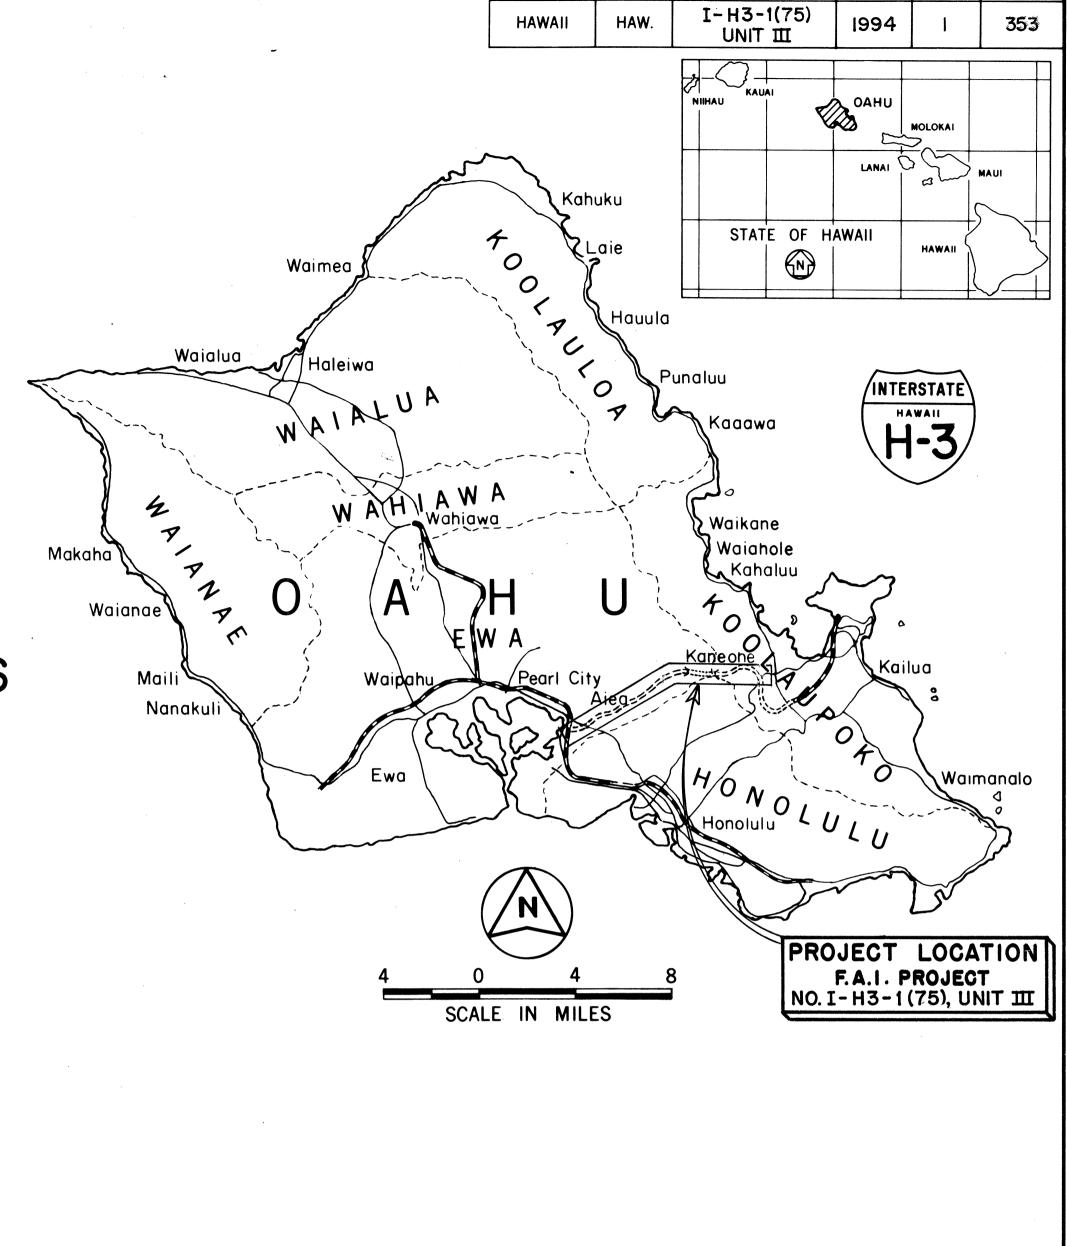

FED. ROAD DIST. NO.

PROJ. NO.

NO.

CHANGES MADE DURING CONSTRUCTION HAVE BEEN INCORPORATED ON THESE PLANS EXCEPT CHANGES IN THE ORIGINAL THEORETICAL QUANTITIES, FOR ACTUAL QUANTITIES, REFER TO PROJECT LEDGER AND/OR COMPUTATION BOOK.

RESIDENT ENGINEER

DATE

DEPARTMENT OF TRANSPORTATION
STATE OF HAWAII

APPROVED:

JAMCALLEY

JOHR. OF TRANSPORTATION

SHEET NO. 1 G1 OF 16 SHEETS

PB-HA DESIGNED BY