
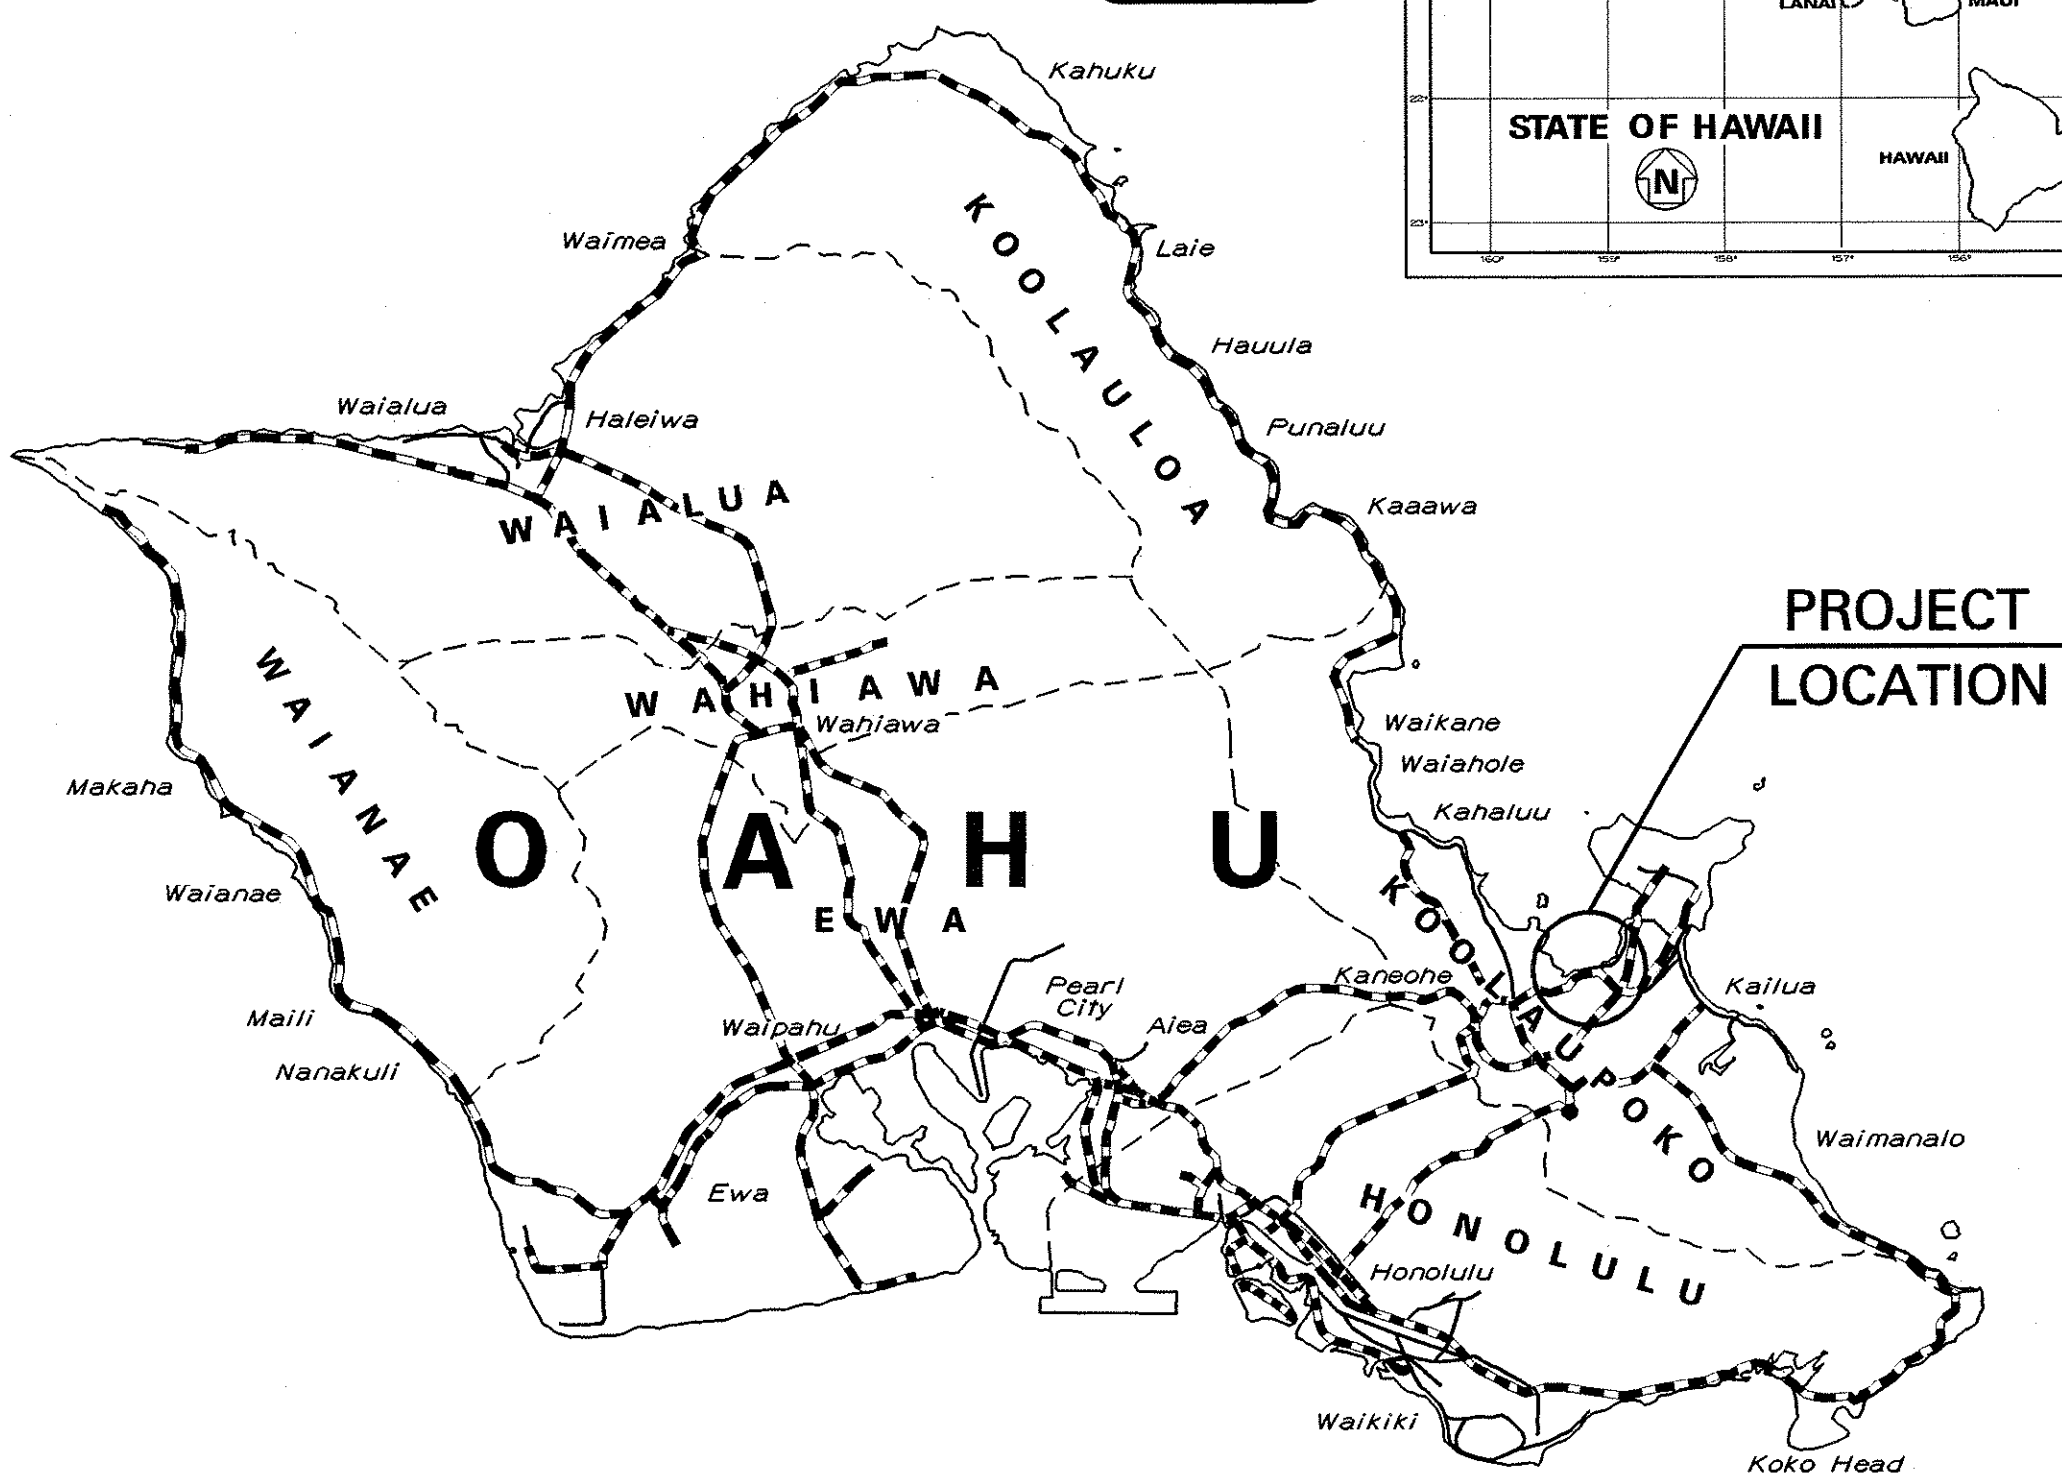


INDEX TO DRAWINGS	
SHEET NO.	DESCRIPTION
1	TITLE SHEET
2	STANDARD PLANS SUMMARY
3	GENERAL NOTES
4-5	WATER POLLUTION & EROSION CONTROL NOTES
① 6-13	KAILUA INTERCHANGE STRUCTURE - RETROFIT DETAILS
14	CONSTRUCTION PHASE NOTES AND LEGEND
15	CONSTRUCTION PHASE PLAN
16-19	KAILUA INTERCHANGE STRUCTURE - AS-BUILT PLANS


SHEET NO. ① C.O.S.-1 IS SUPPLEMENTARY SHEET TO THIS PROJECT. TOTAL SHEET COUNT AFTER "AS BUILT" POSTING 20 SHEETS.

STATE OF HAWAII
DEPARTMENT OF TRANSPORTATION
HIGHWAYS DIVISION
HONOLULU, HAWAII
"AS-BUILT"
PLANS FOR
INTERSTATE ROUTE H-3
KAILUA INTERCHANGE SEISMIC RETROFIT
FEDERAL AID PROJECT NO. NH-H3-1(78)
DISTRICT OF KOOLAUPOKO
ISLAND OF OAHU


FED. ROAD DIST. NO.	STATE	FED. AID PROJ. NO.	FISCAL YEAR	SHEET NO.	TOTAL SHEETS
HAWAII	HAW.	NH-H3-1(78)	2002	1	19

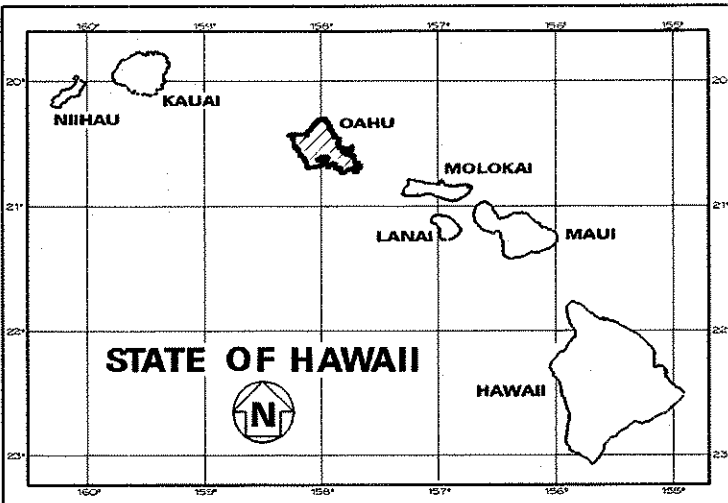

LOCATION MAP

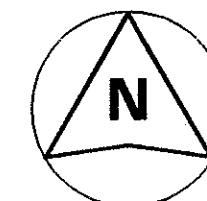

SCALE IN MILES

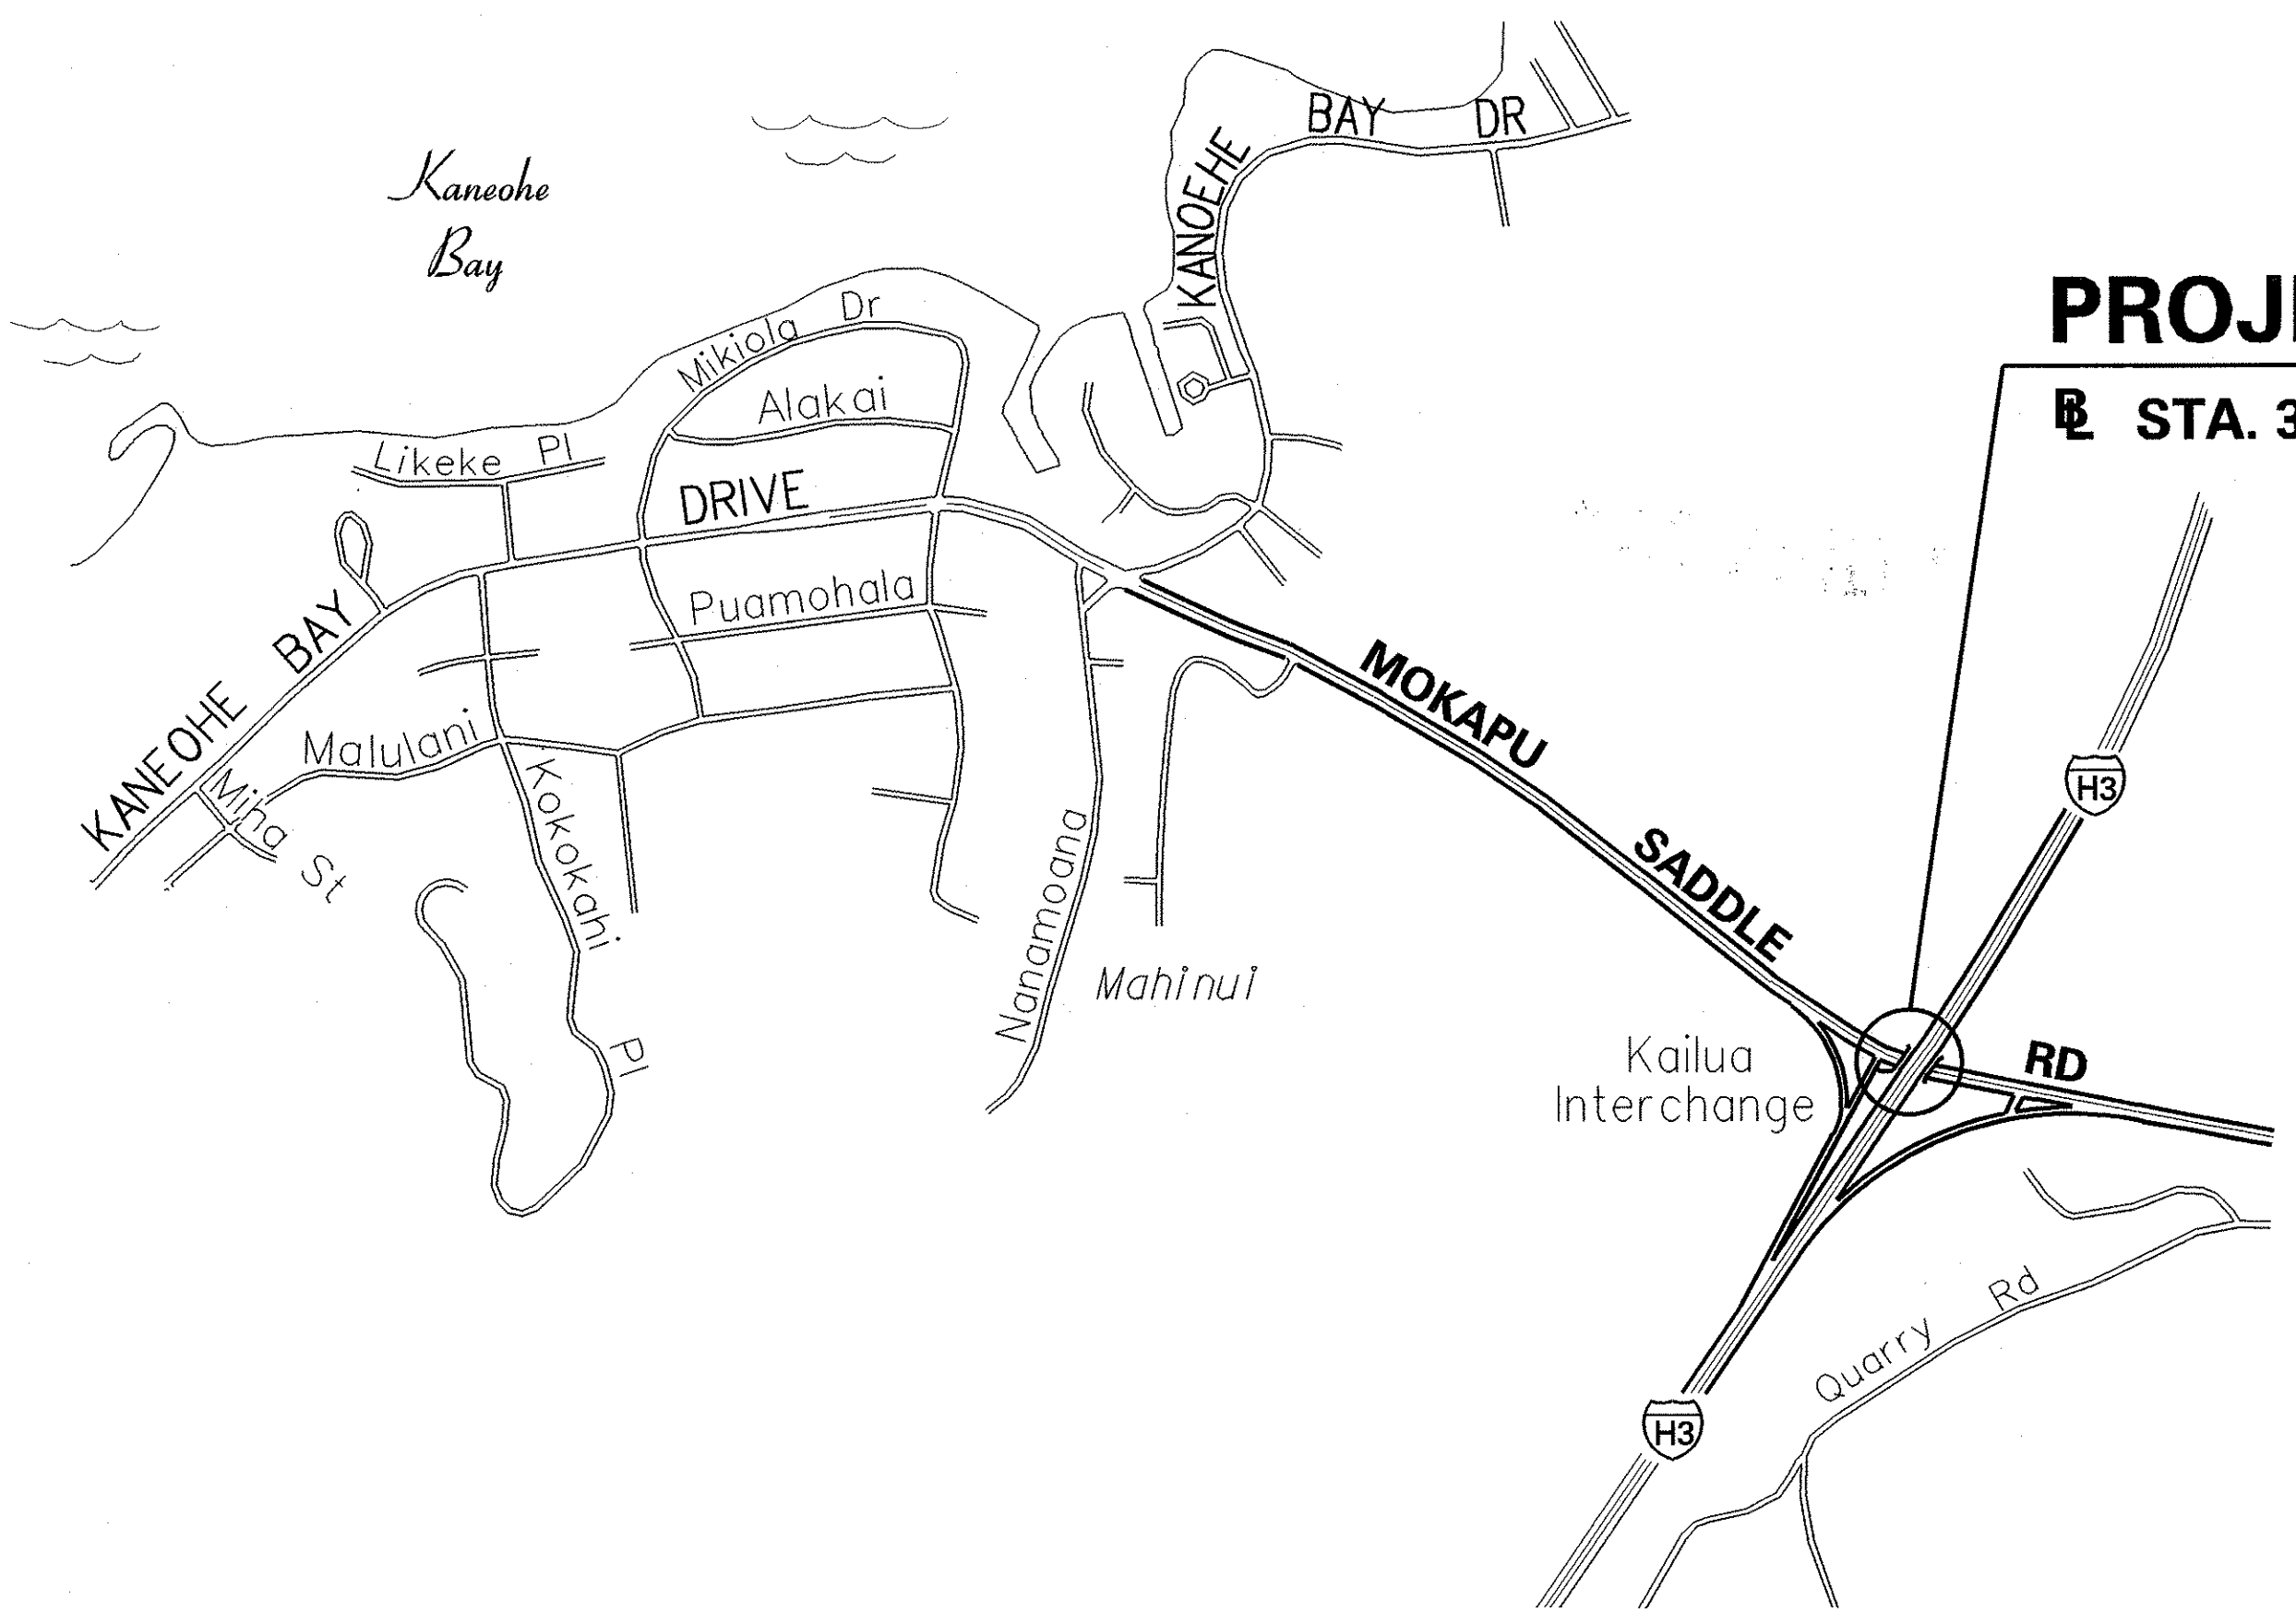

PROJECT LOCATION

STA. 34+55± TO STA. 36+03±

----- FEDERAL AID PROJECTS PREVIOUSLY CONSTRUCTED OR UNDER CONSTRUCTION

MILE POST 13.16 TO MILE POST 13.16

LAYOUT PLAN



SCALE IN HUNDRED FEET

CHANGES MADE DURING CONSTRUCTION HAVE BEEN INCORPORATED ON THESE PLANS EXCEPT CHANGES IN THE ORIGINAL THEORETICAL QUANTITIES. FOR ACTUAL QUANTITIES, REFER TO PROJECT LEDGER AND/OR COMPUTATION BOOK.

[Signature] RESIDENT ENGINEER *[Signature]* DATE

DEPARTMENT OF TRANSPORTATION STATE OF HAWAII	
APPROVED:	
<i>[Signature]</i> for DIR. OF TRANSPORTATION	01/29/02 DATE

HWY-DB
DESIGNED BY
James Fu
P. S. & E. BY
692-7613
PHONE
Jan. 2002
DATE