

INDEX TO DRAWINGS	
SHEET NO.	DESCRIPTION
1	TITLE SHEET
2	STANDARD PLANS SUMMARY
3-4	LOCATION MAP
5	GENERAL NOTES, LEGEND AND ABBREVIATIONS
6-7	WATER POLLUTION AND EROSION CONTROL NOTES
8-21	LANDSCAPE PLAN
22	NORTH HALAWA VALLEY GRADING AND MEDIAN MODIFICATIONS
23-42	ELECTRICAL MODIFICATIONS
43	HARANO TUNNELS CROSSOVERS ADDITIONAL TRAFFIC LOOP DETECTORS
44-60	TUNNEL MAINTENANCE AREA MODIFICATIONS

STATE OF HAWAII
DEPARTMENT OF TRANSPORTATION
HIGHWAYS DIVISION
HONOLULU, HAWAII
"AS-BUILT"


PLANS FOR CONSTRUCTION OF A PORTION OF

INTERSTATE ROUTE H-3
H-3 FINISH (UNIT VIIA)


FEDERAL-AID INTERSTATE
PROJECT NO. I-H3-1 (75), UNIT VIIA

DISTRICTS OF EWA AND KOOLAUPOKO
ISLAND OF OAHU

FED. ROAD DIST. NO.	STATE	FED. AID PROJ. NO.	FISCAL YEAR	SHEET NO.	TOTAL SHEETS
HAWAII	HAW.	I-H3-I(75), UNIT VIIA	2003	1	60

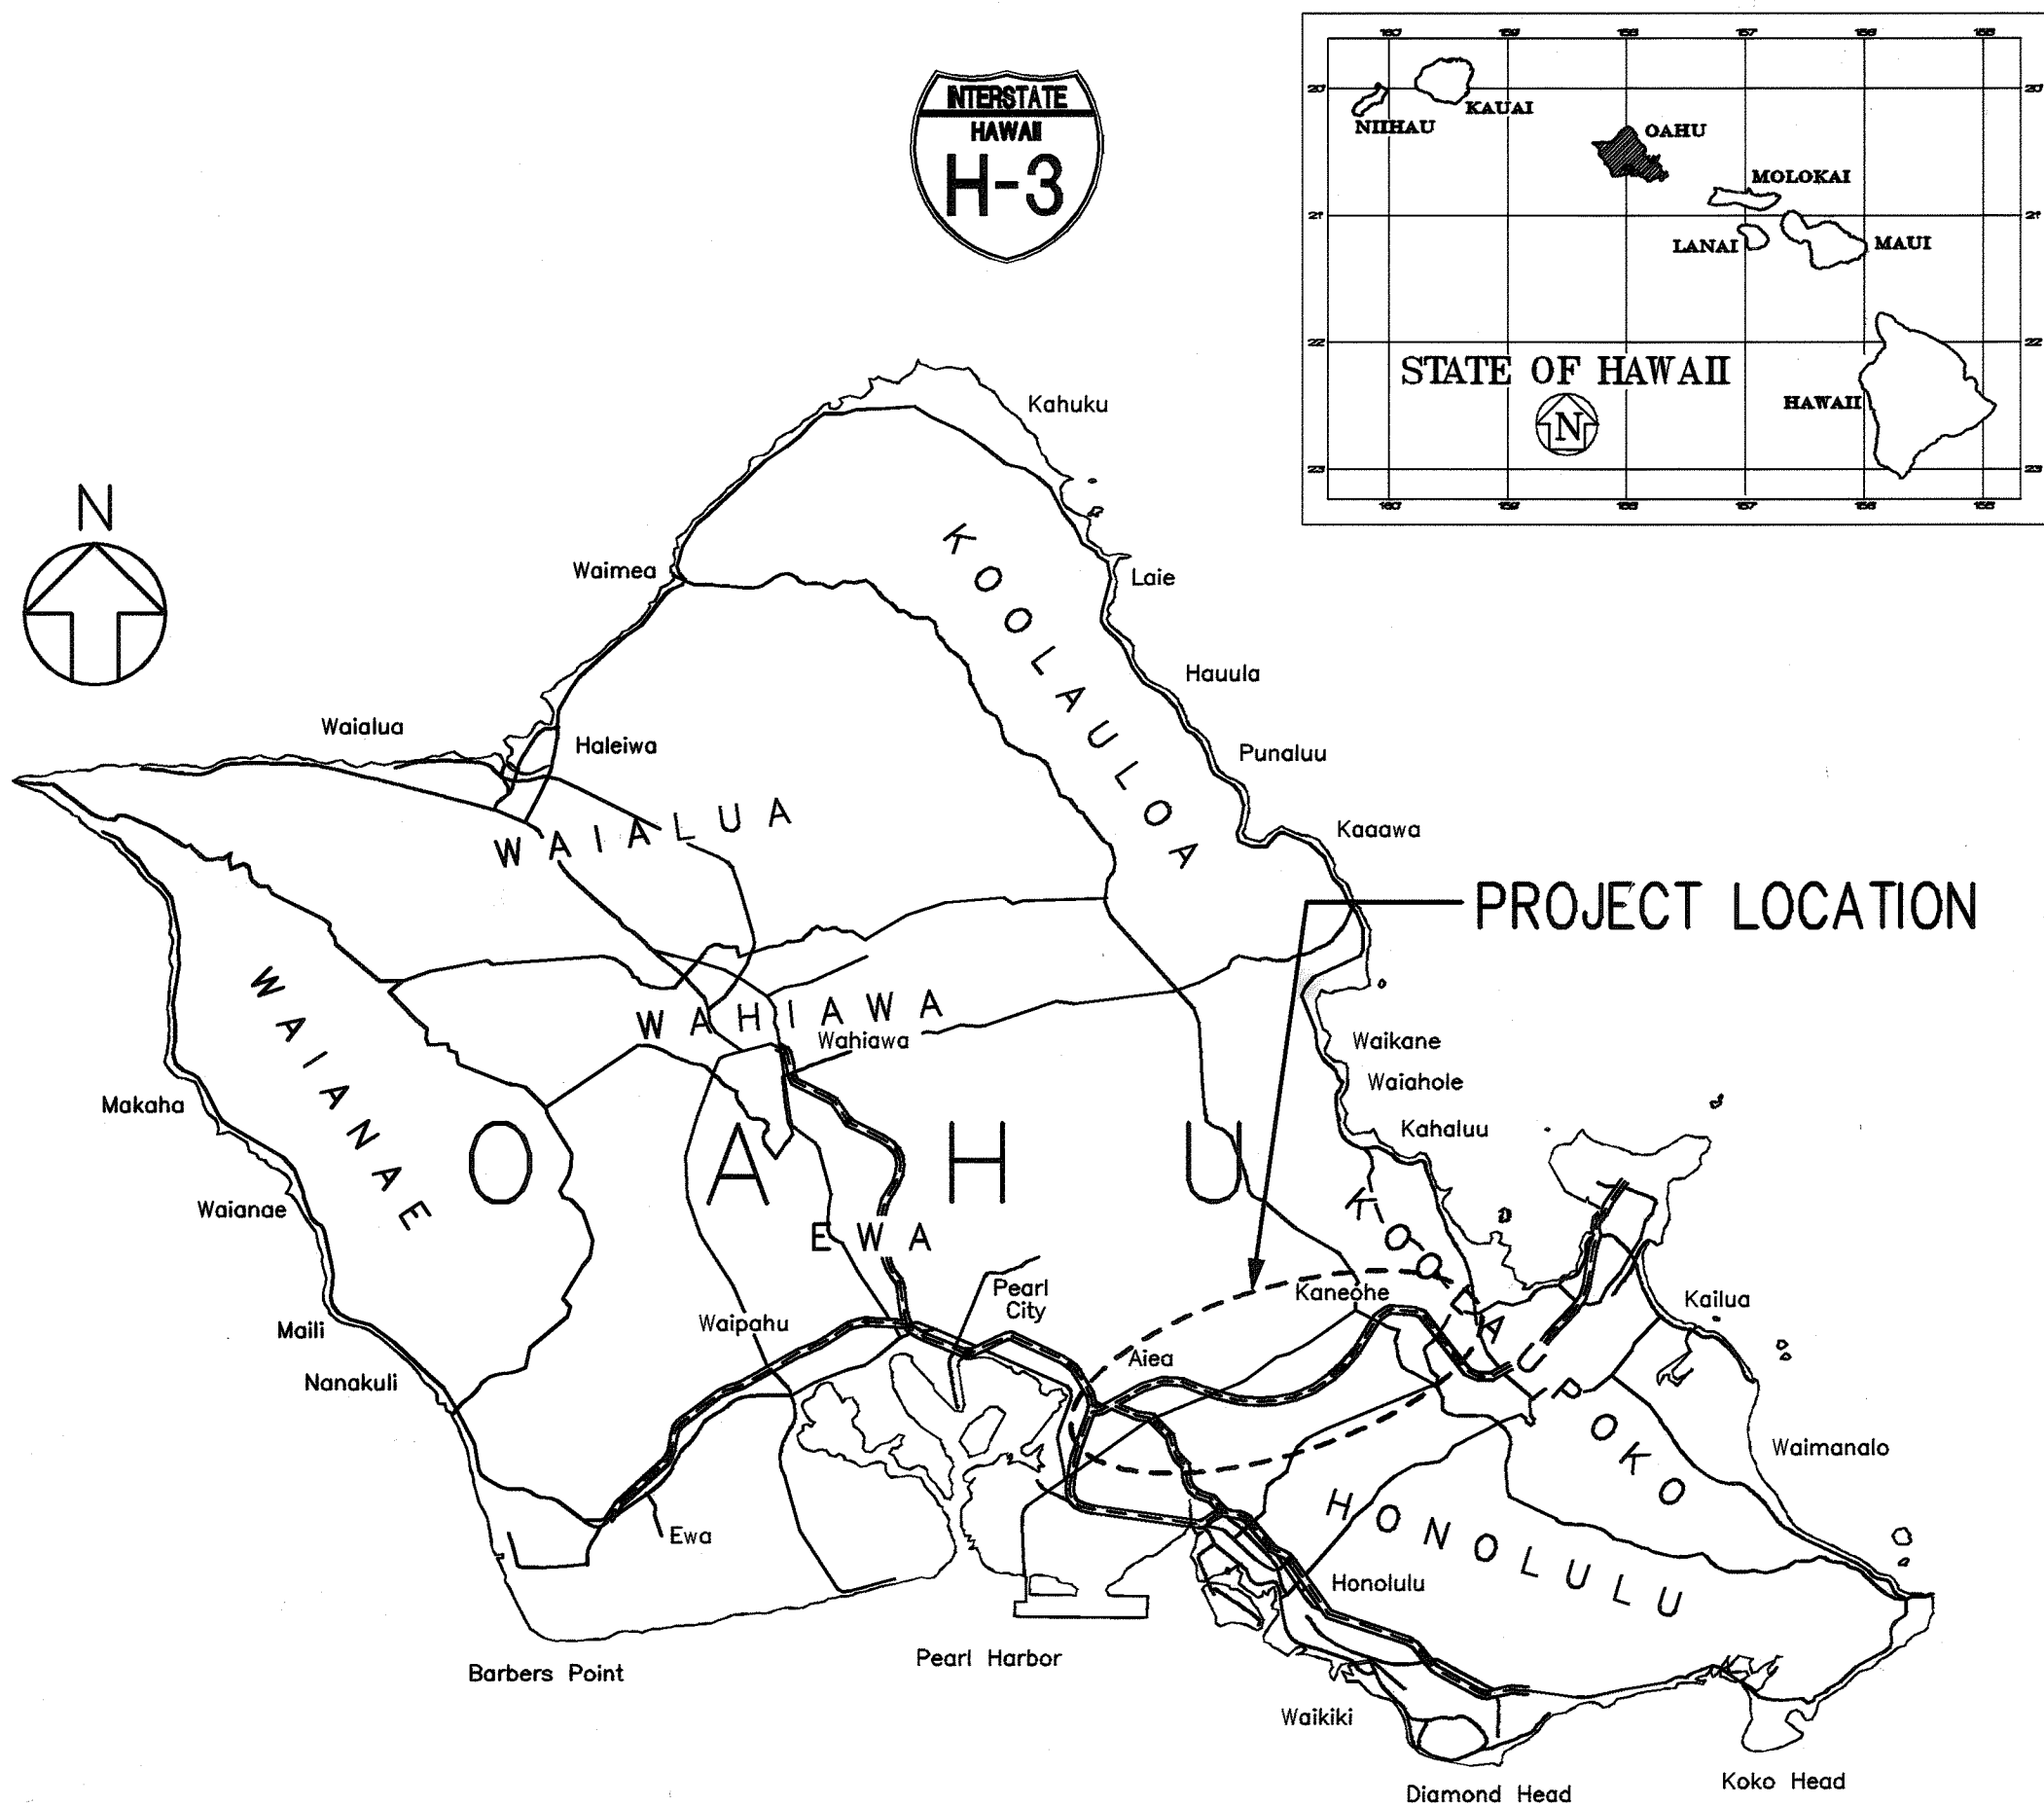

FEDERAL AID INTERSTATE PROJECTS PREVIOUSLY
CONSTRUCTED OR UNDER CONSTRUCTION

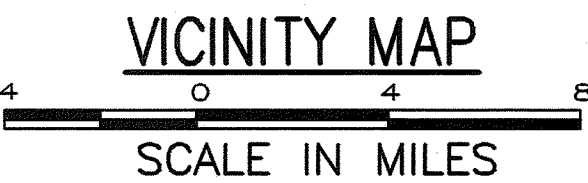

MILEPOST 0.0 TO MILEPOST 7.0

DESIGN DESIGNATION

FUTURE ADT (1998).	39,430
DESIGN ADT (2008).	45,220
DHV	4,282
D	76/24
T ₂₄	4.1%
V	60 MPH

CHANGES MADE DURING CONSTRUCTION HAVE BEEN
INCORPORATED ON THESE PLANS EXCEPT CHANGES
IN THE ORIGINAL THEORETICAL CONDITIONS FOR
ACTUAL CONDITIONS, REFER TO PROJECT LEDGER
AND/OR COMPUTATION BOOK.

RESIDENT ENGINEER
DATE

DEPARTMENT OF TRANSPORTATION
STATE OF HAWAII



APPROVED:

for DIR. OF TRANSPORTATION

DATE

ORIGINAL PLAN	DATE
DESIGNED BY	
NOTED BY	
QUANTITIES BY	
CHECKED BY	
No.	

PBHA
DESIGNED BY
K. CHUN
P. S. & E. BY
692-7552
PHONE
AUGUST 2001
DATE

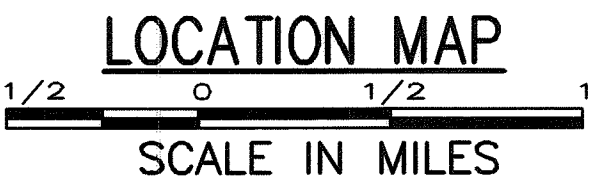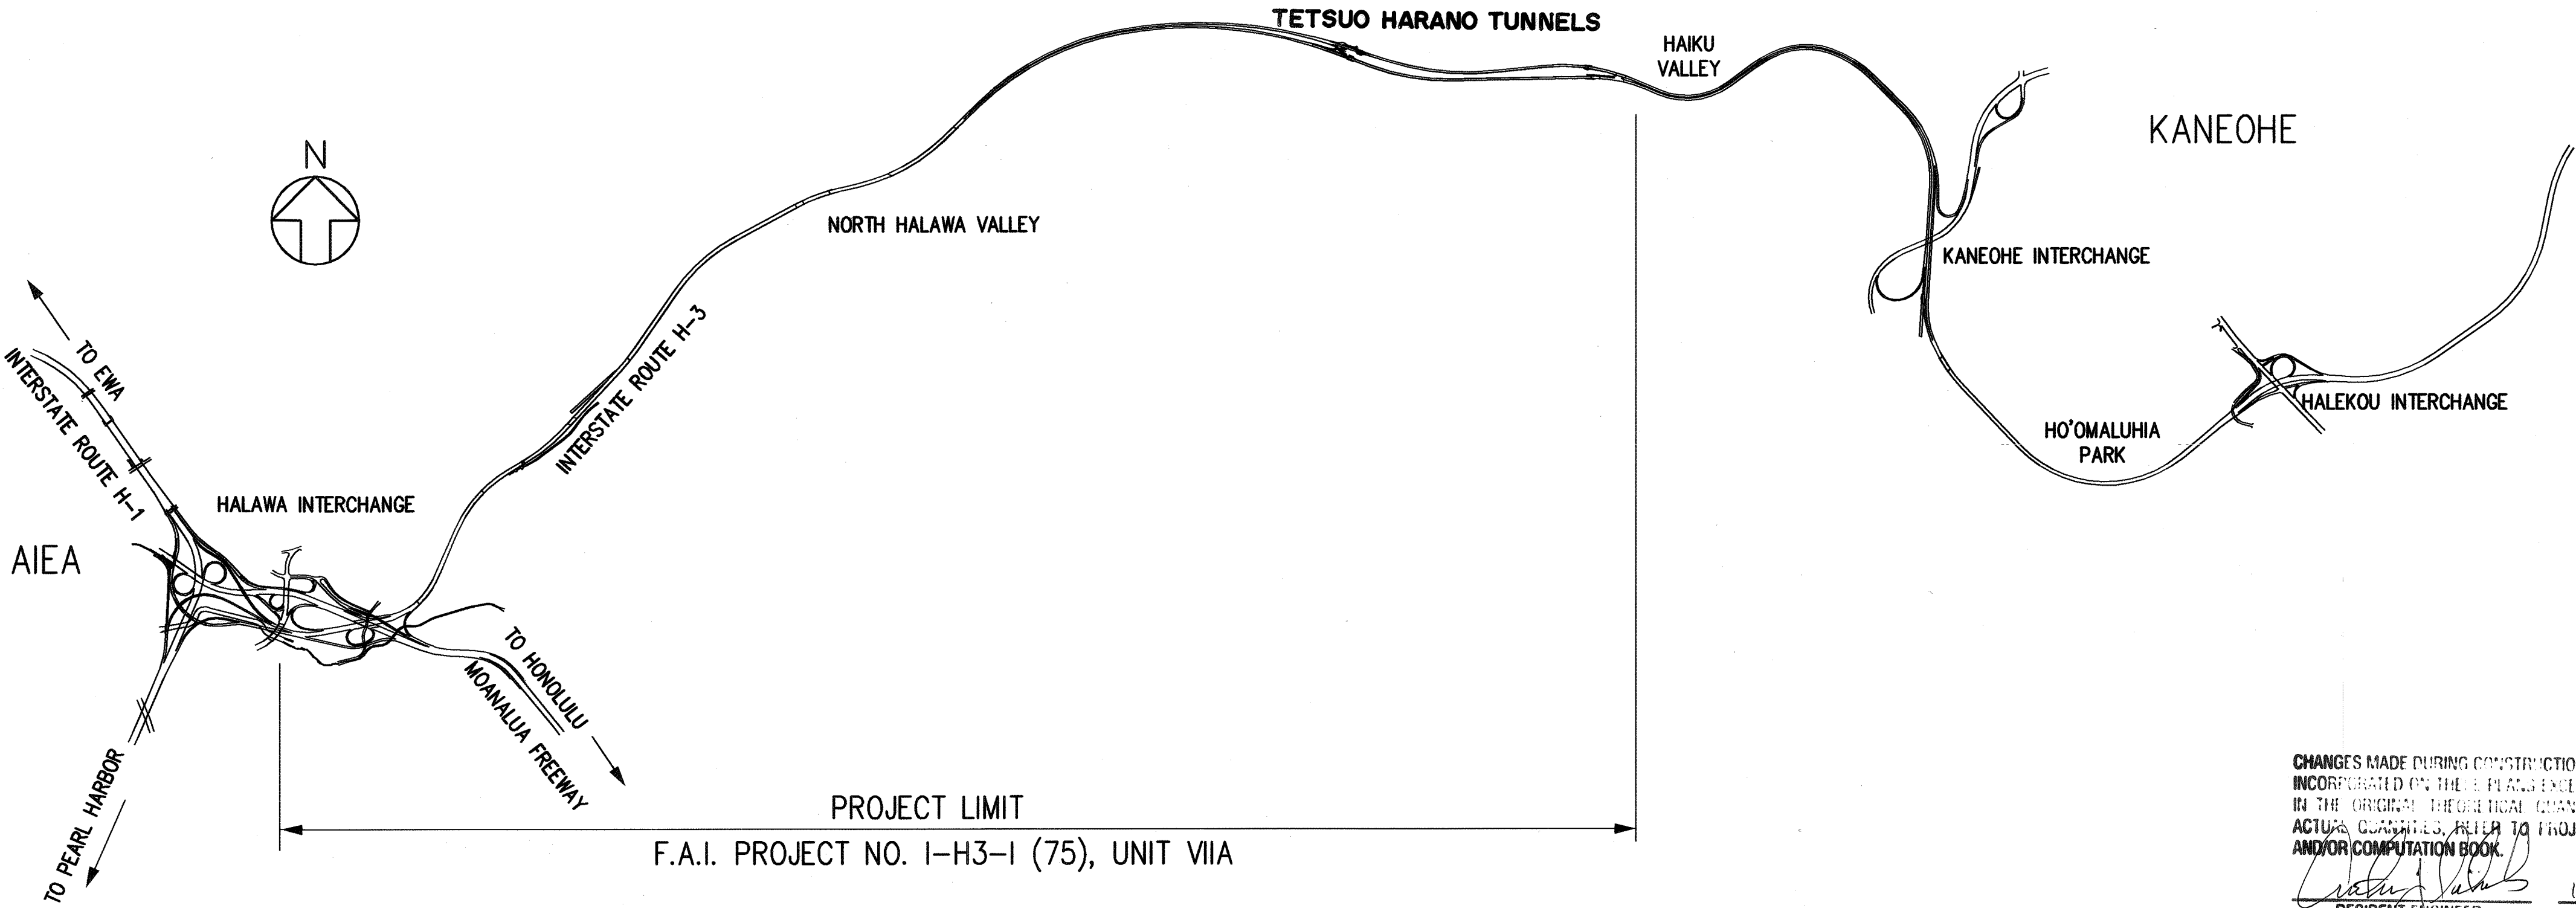

LENGTH OF PROJECT . . . 7.0 MILES