
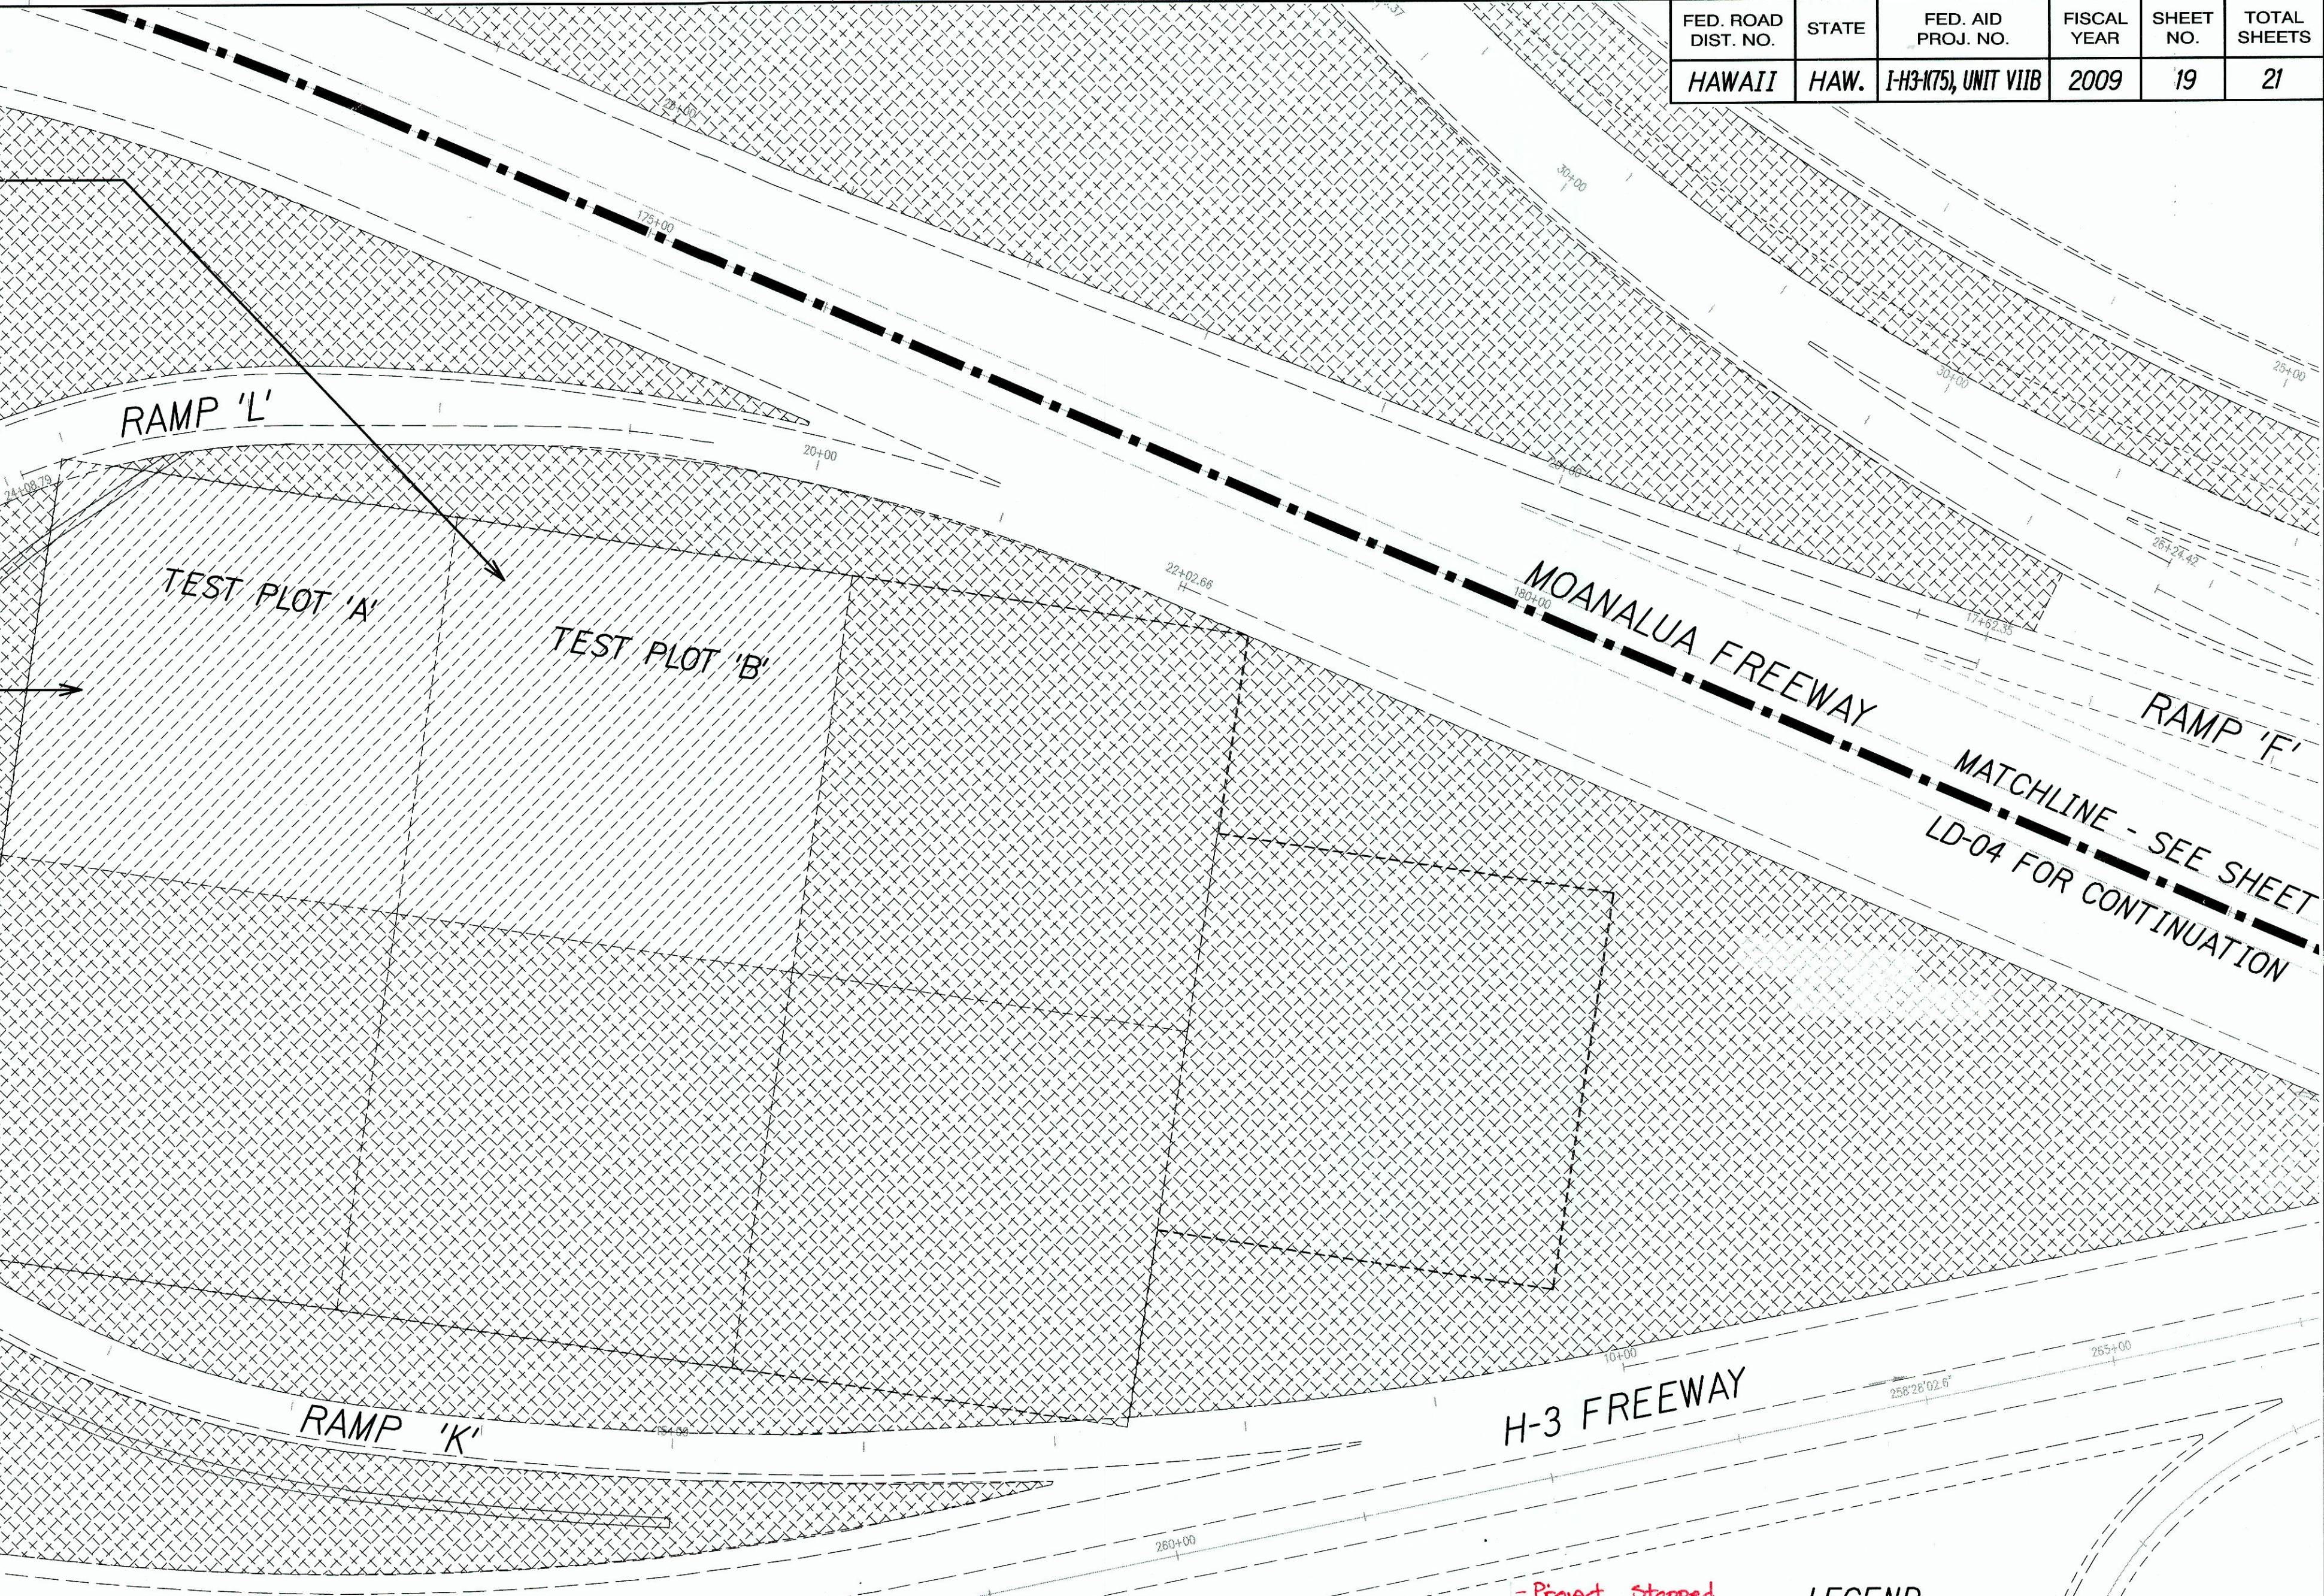


FED. ROAD DIST. NO.	STATE	FED. AID PROJ. NO.	FISCAL YEAR	SHEET NO.	TOTAL SHEETS
HAWAII	HAW.	I-H3-K75, UNIT VIIIB	2009	19	21

43,560 S.F. State Test Plot 'B': Contractor shall clear and grub Test Plot 'B' as part of Phase 1 work. Contractor shall coordinate with the Engineer to remove/eradicate existing non-native seed bank from test plot through the use of approved herbicides or by alternative means as directed by the State. Contractor shall protect all existing trees during construction operations.

43,560 S.F. State Test Plot 'A': Contractor shall clear and grub test plot 'A' as part of Phase 1 work. Contractor shall coordinate with the Engineer to remove/eradicate existing non-native seed bank from test plot through the use of approved herbicides or by alternative means as directed by the State. Contractor will protect all existing trees during construction operations.

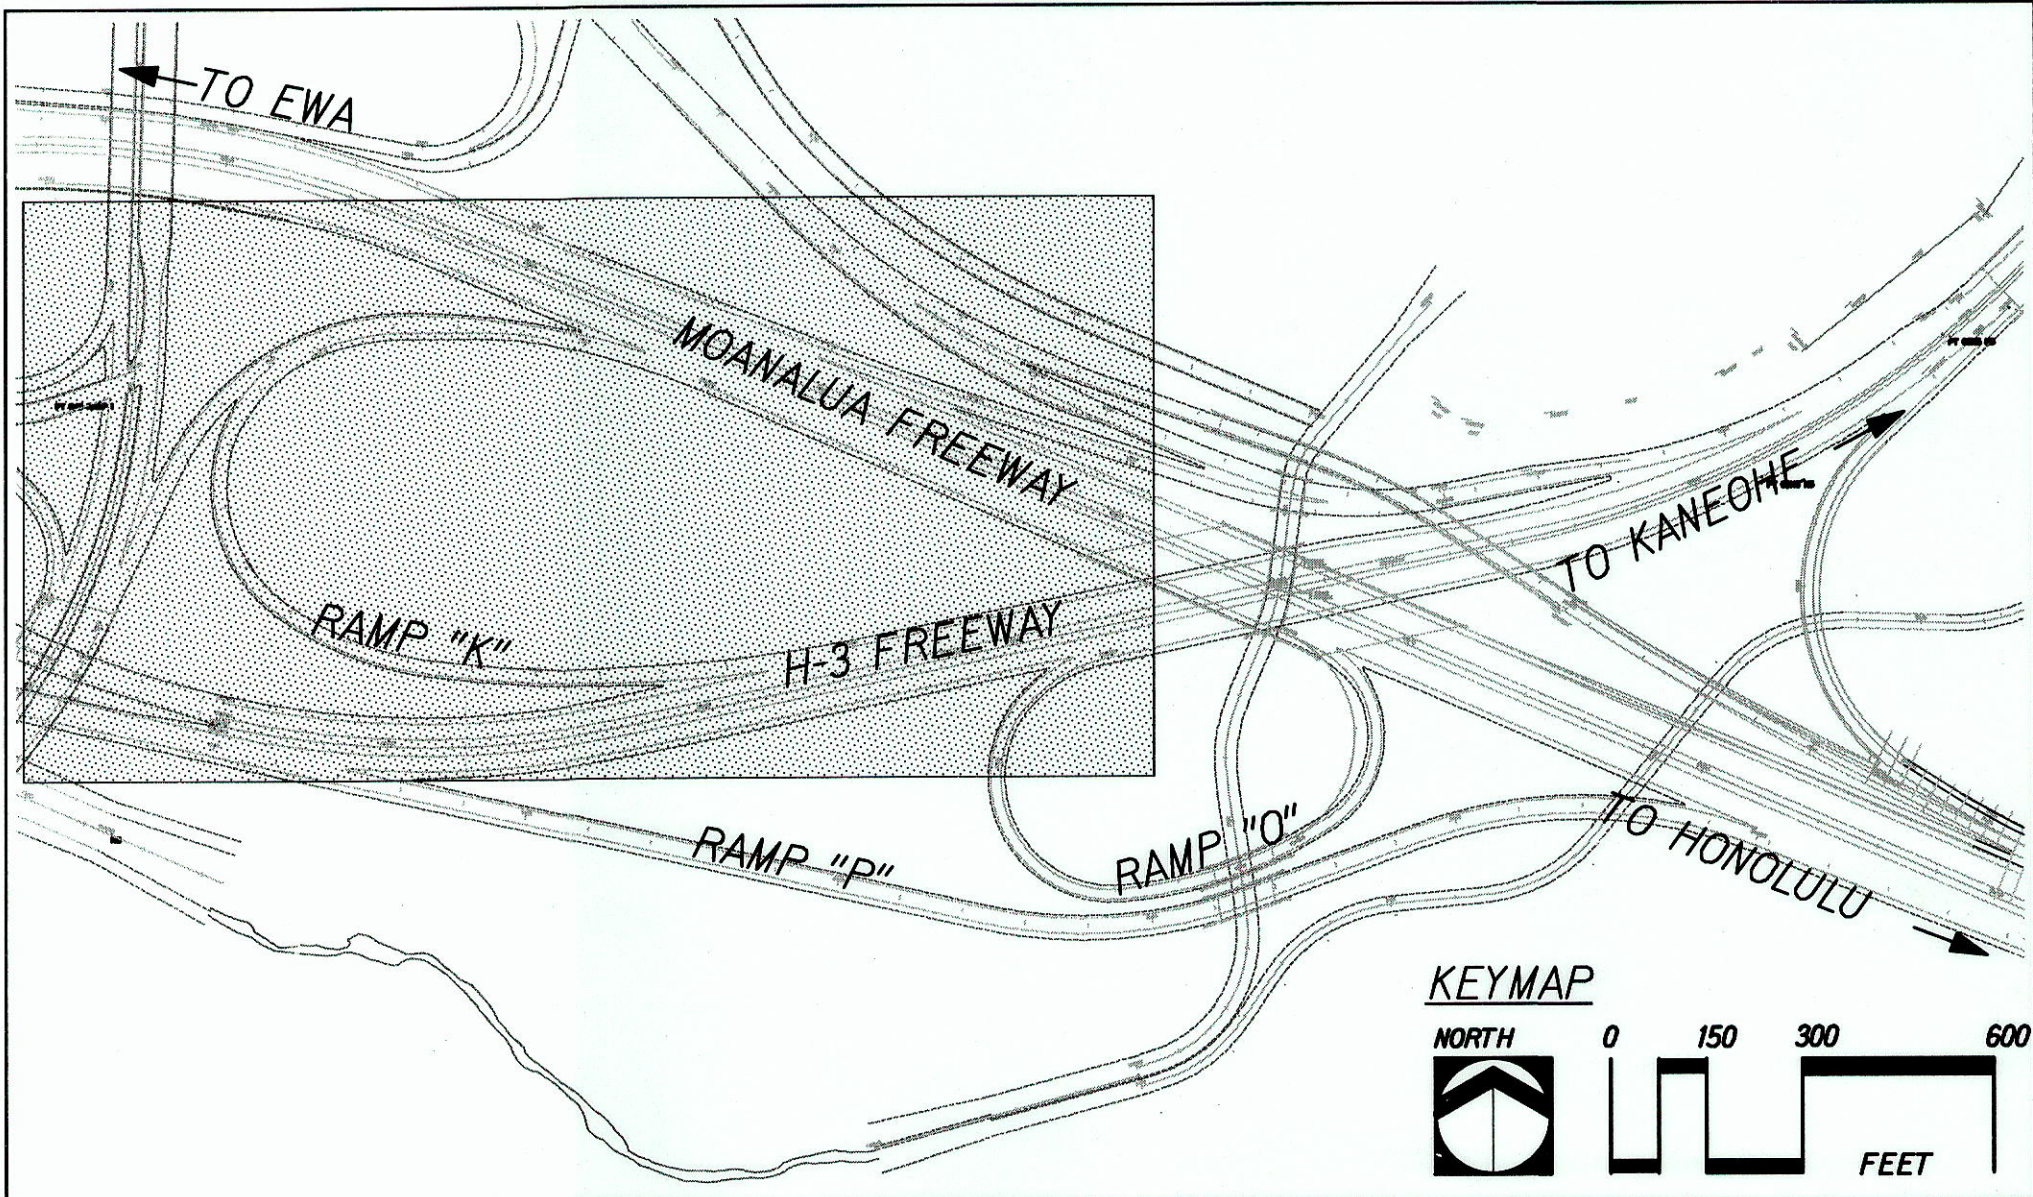

TO PEARL HARBOR

563,480 S.F. Phase 2 (this sheet): Upon completion of the native seed test program, clear, grub, and remove non-native seed bank using methods furnished by the Engineer. Hydroseed the balance of the project site with Engineer furnished seeds and seeding rate. Contractor shall protect all existing trees during construction operations.

- LEGEND:**
- Phase 1: State hydroseed test plots
 - Phase 2: Balance of project area for hydroseed

Note:
1. Upon completion of Phase 1 clearing and grubbing of Test Plots 'A' and 'B', the Contractor shall have a standby period of approximately seven (7) months to allow for the hydroseed application on the test plots. The Contractor shall demobilize until notified by the Engineer to resume work. The Contractor will be required to maintain the silt fence (or approved equivalent) for Phase 1 through the duration of the standby period.

2. Only Test Plot 'A' and Test Plot 'B' were planted as a test program. Project was stopped since plants did not grow as anticipated. Phase 2 was not started.

ORIGINAL PLAN	DATE
DRAWN BY	
DESIGNED BY	
CHECKED BY	
IN CHARGE	



THIS WORK WAS PREPARED BY ME OR UNDER MY SUPERVISION.
R. Stan Duncan

STATE OF HAWAII
DEPARTMENT OF TRANSPORTATION
HIGHWAYS DIVISION

PLANTING PLAN



H-3 FINISH (UNIT VIIIB)
FAIP NO. I-H3-K75, UNIT VIIIB

Scale: 1"=60'-0" Date: Nov. 2008



SHEET No LD-03 OF 5 SHEETS

"AS-BUILT"

FED. ROAD DIST. NO.	STATE	FED. AID PROJ. NO.	FISCAL YEAR	SHEET NO.	TOTAL SHEETS
HAWAII	HAW.	I-H3-175, UNIT VIIB	2009	20	21

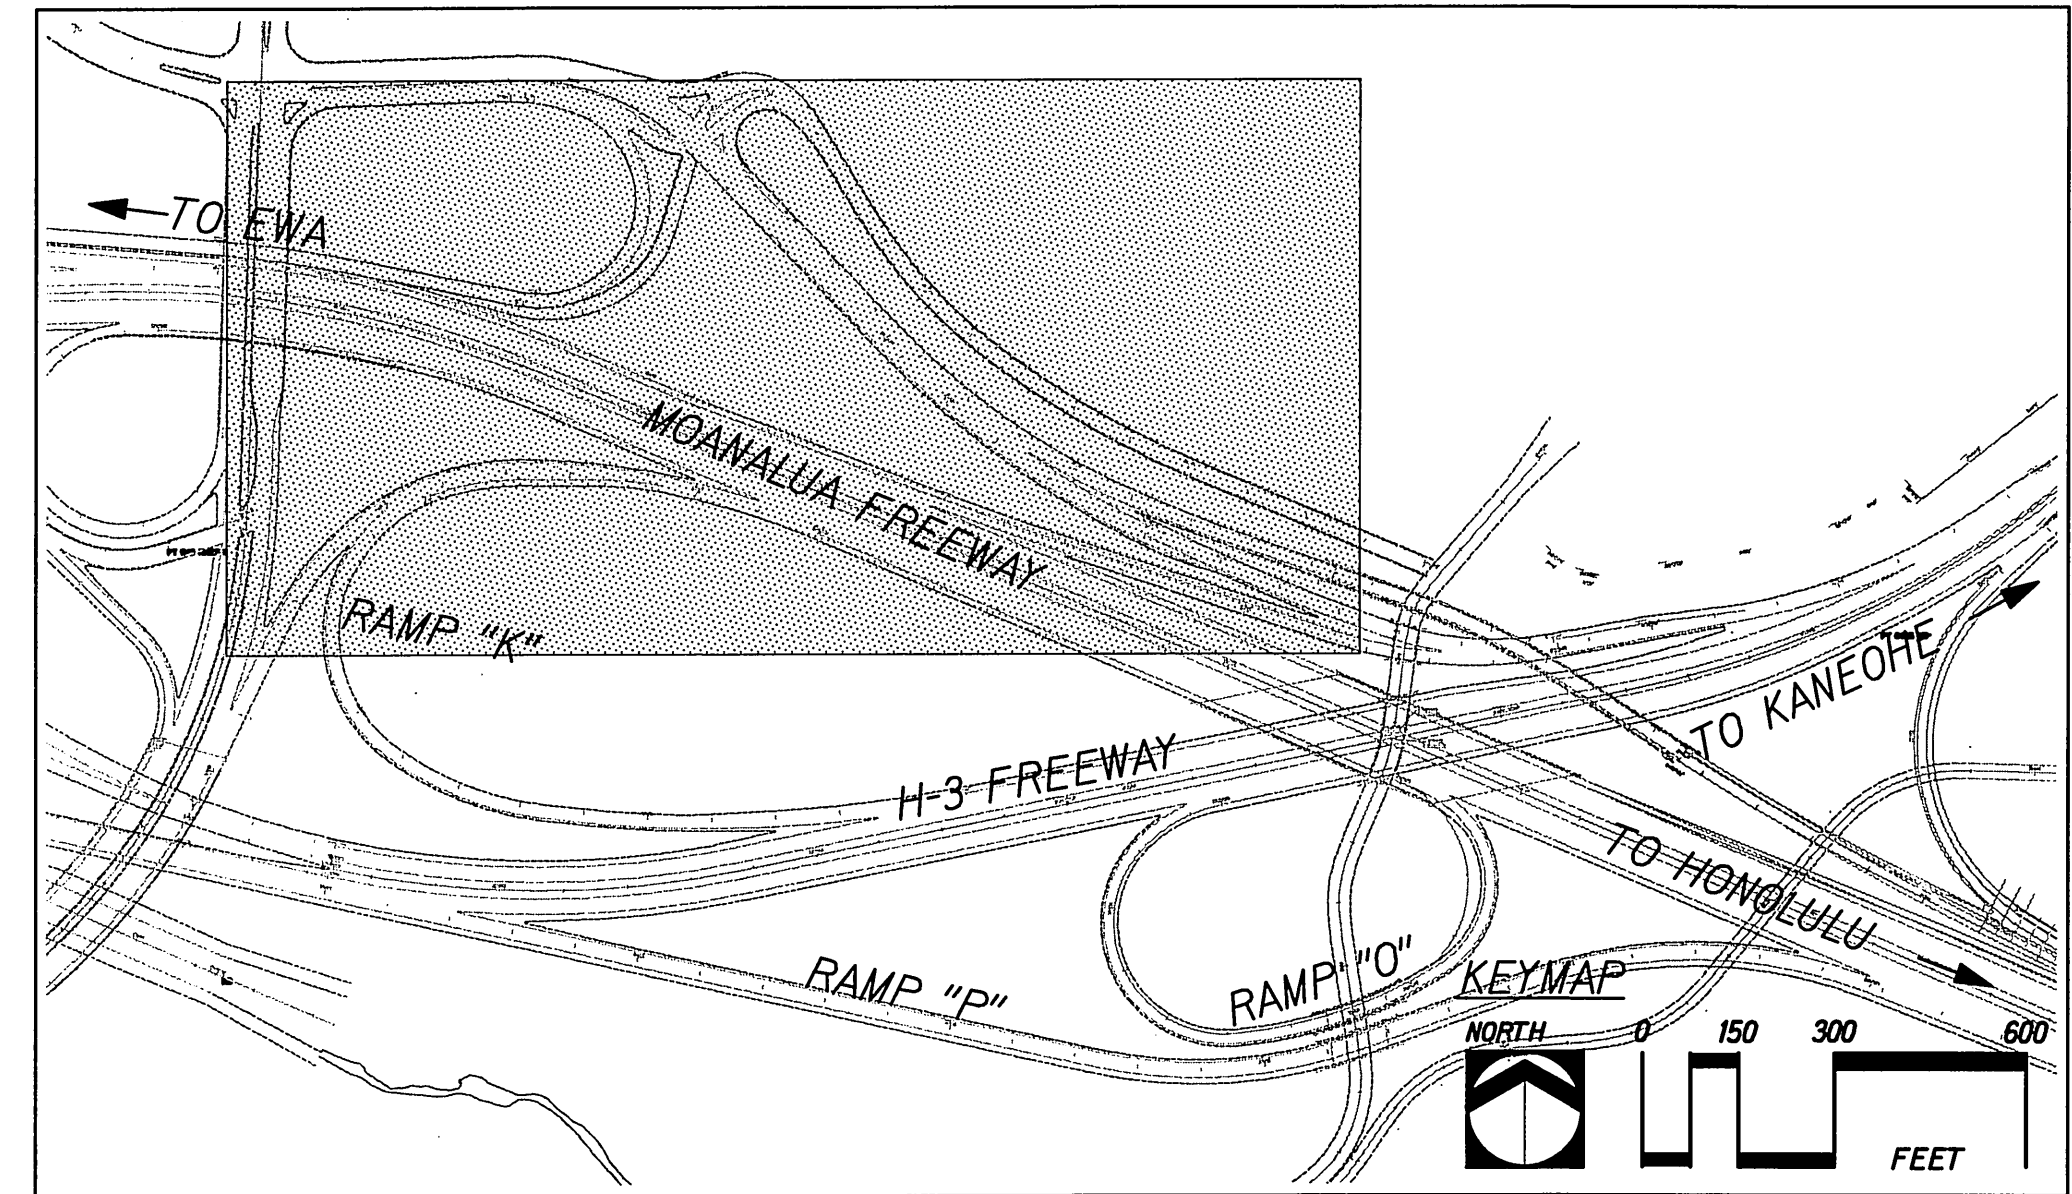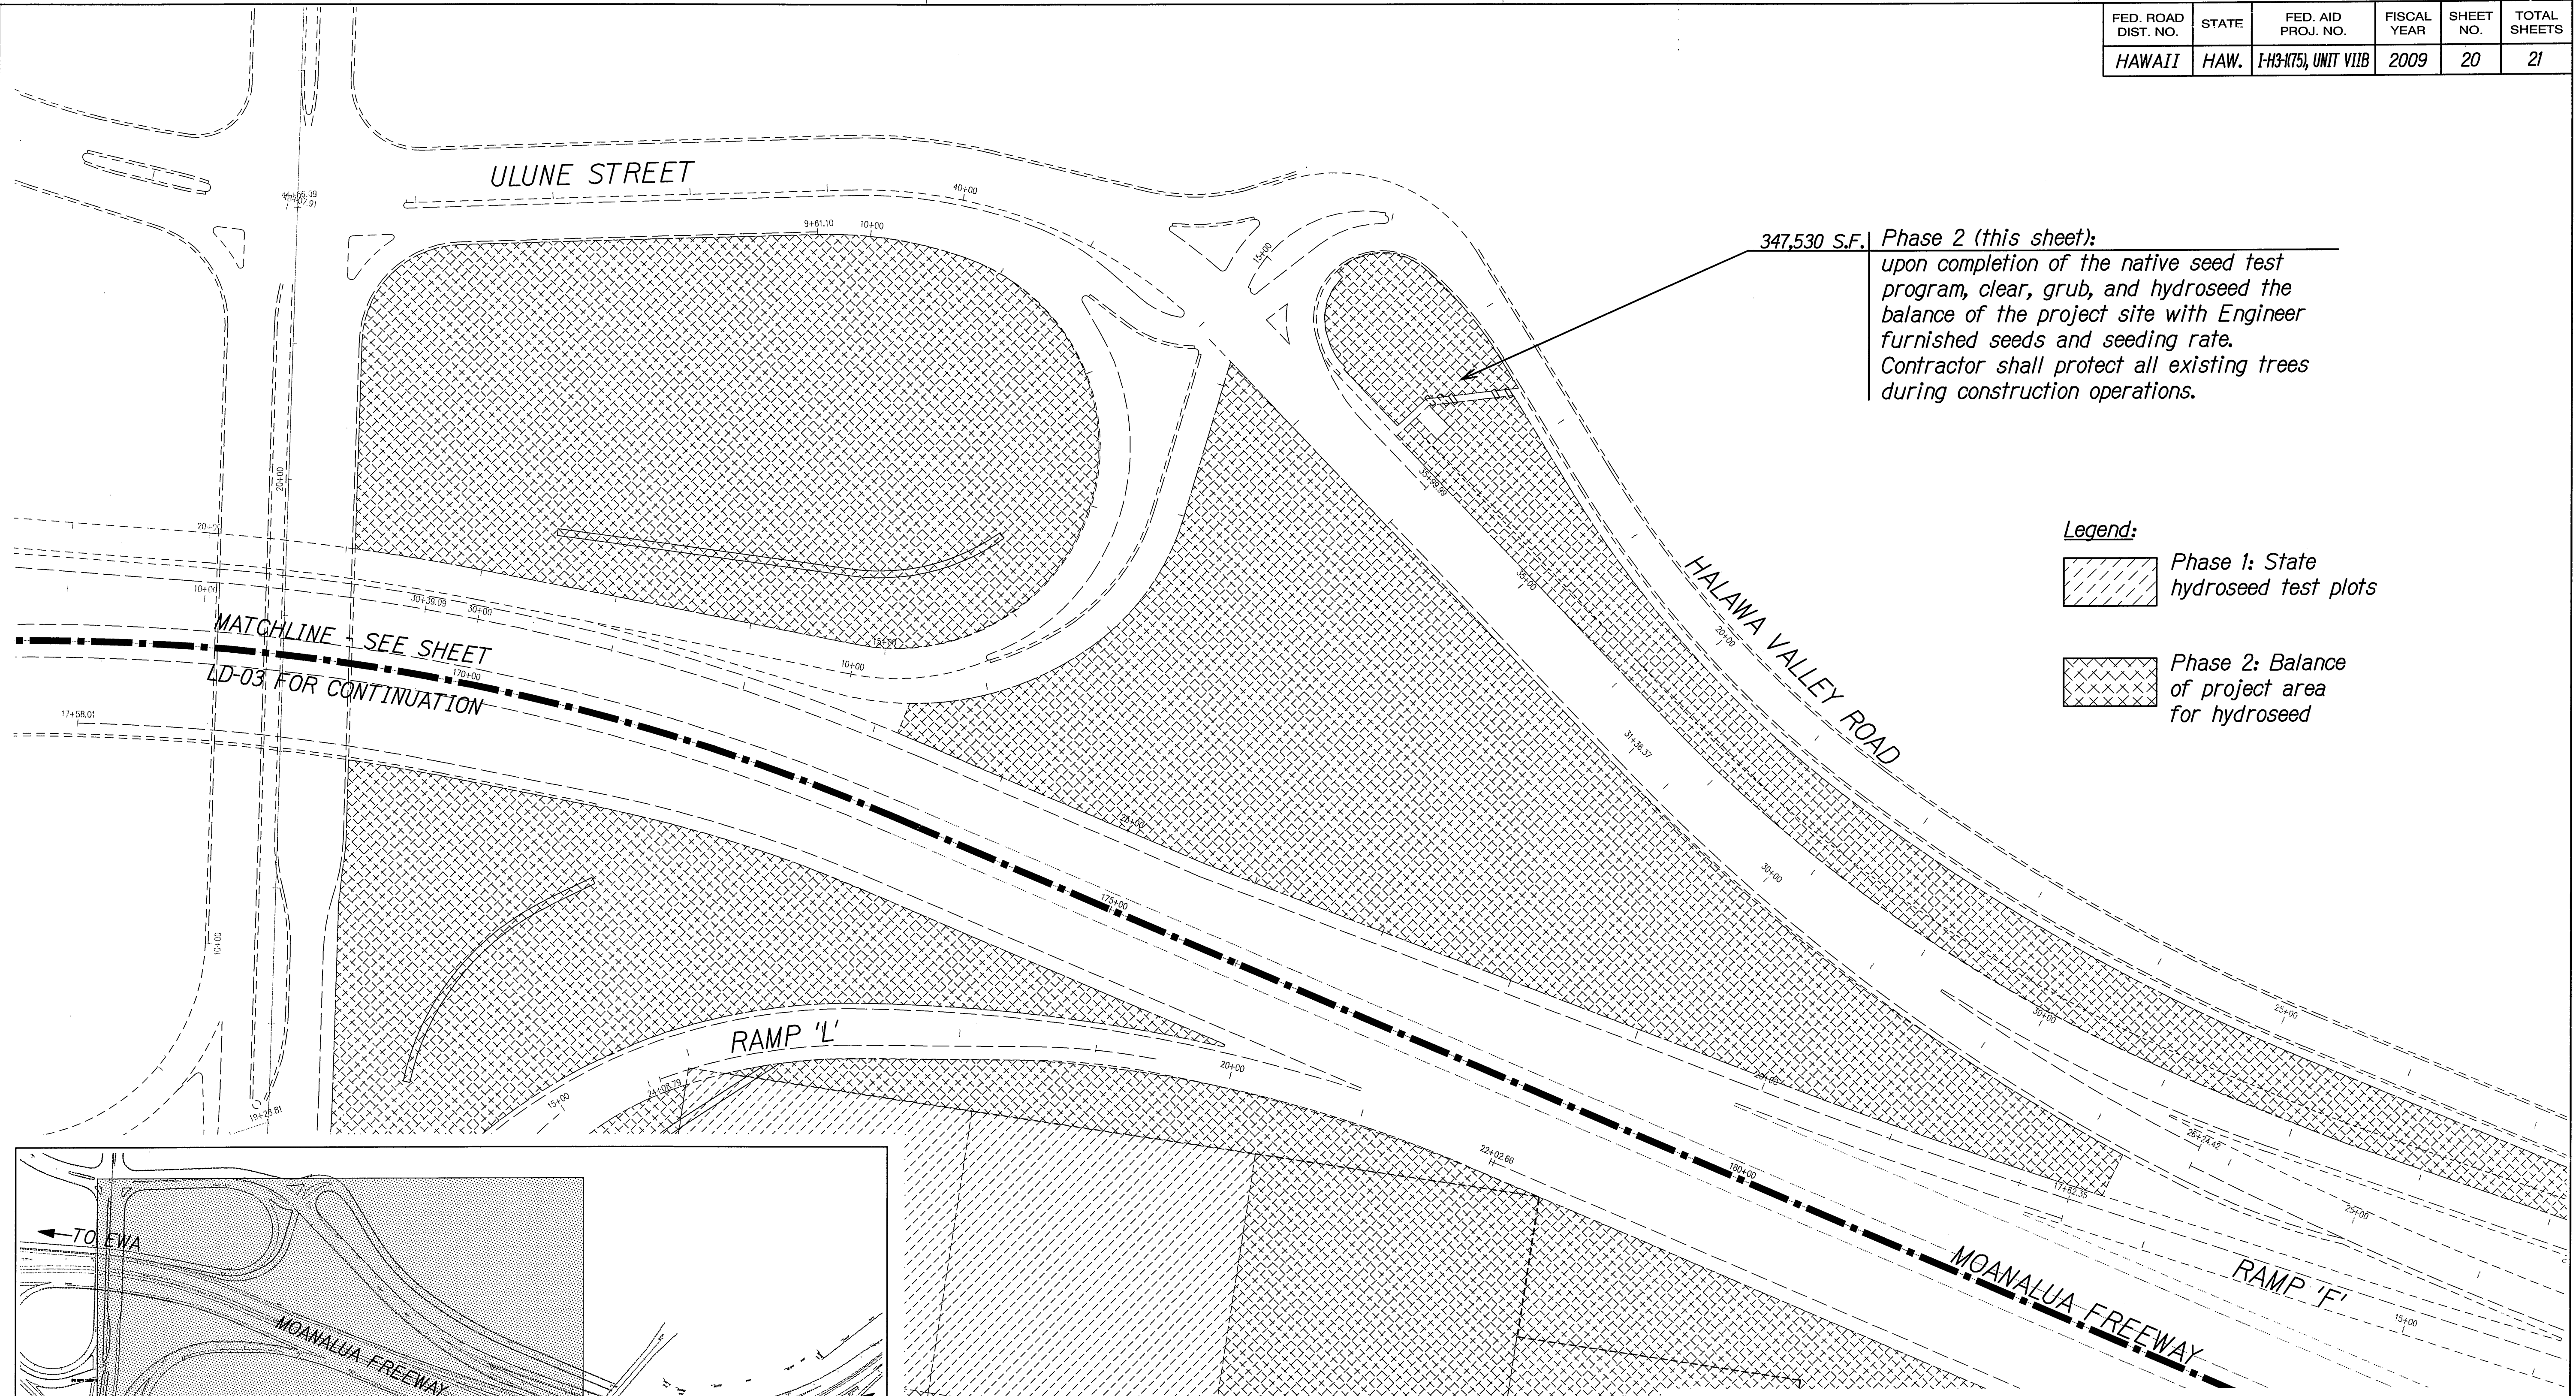

Note:
1. Upon completion of Phase 1 clearing and grubbing of Test Plots 'A' and 'B', the Contractor shall have a standby period of approximately seven (7) months to allow for the hydroseed application on the test plots. The Contractor shall demobilize until notified by the Engineer to resume work. The Contractor shall be required to maintain the silt fence (or approved equivalent) for Phase 1 through the duration of the standby period.

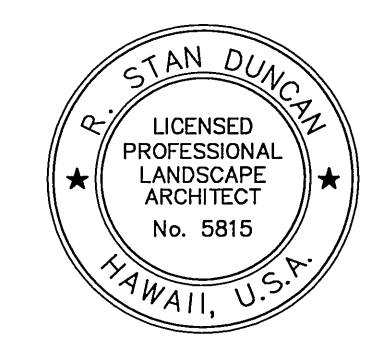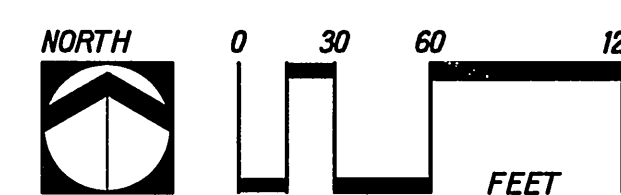

THIS WORK WAS PREPARED BY ME OR UNDER MY SUPERVISION.
R. Stan Duncan

STATE OF HAWAII
DEPARTMENT OF TRANSPORTATION
HIGHWAYS DIVISION

PLANTING PLAN

H-3 FINISH (UNIT VIIB)
FAIP NO. I-H3-175, UNIT VIIB
Scale: 1"=60'-0" Date: Nov. 2008

SHEET No.LD-04 OF 5 SHEETS

DATE	DESIGNED BY	CHECKED BY
	NOTED BY	
	QUANTITIES BY	
	DESIGNED BY	
	TRACED BY	
	DRAWN BY	
	STAFF PLOTTED BY	