

INDEX TO DRAWINGS	
SHEET NO.	DESCRIPTION
1	TITLE SHEET
2	STANDARD PLANS SUMMARY
3	GENERAL NOTES, LEGEND AND ABBREVIATIONS
4 - 6	WATER POLLUTION AND EROSION CONTROL NOTES
7	LOCATION MAP
8 - 12	TEMPORARY IRRIGATION PLAN
13 - 14	TEMPORARY IRRIGATION DETAILS
15	TEMPORARY IRRIGATION NOTES
16	TEMPORARY IRRIGATION LEGEND
17 - 18	EROSION CONTROL PLAN
19 - 20	PLANTING PLAN
21	PLANTING DETAILS

STATE OF HAWAII

DEPARTMENT OF TRANSPORTATION

HIGHWAYS DIVISION

HONOLULU, HAWAII

"AS-BUILT"

PLANS FOR

INTERSTATE ROUTE H-3



H-3 FINISH (UNIT VIIB)

FEDERAL-AID INTERSTATE

PROJECT NO. I-H3-1 (75), UNIT VIIB

DISTRICT OF EWA

ISLAND OF OAHU

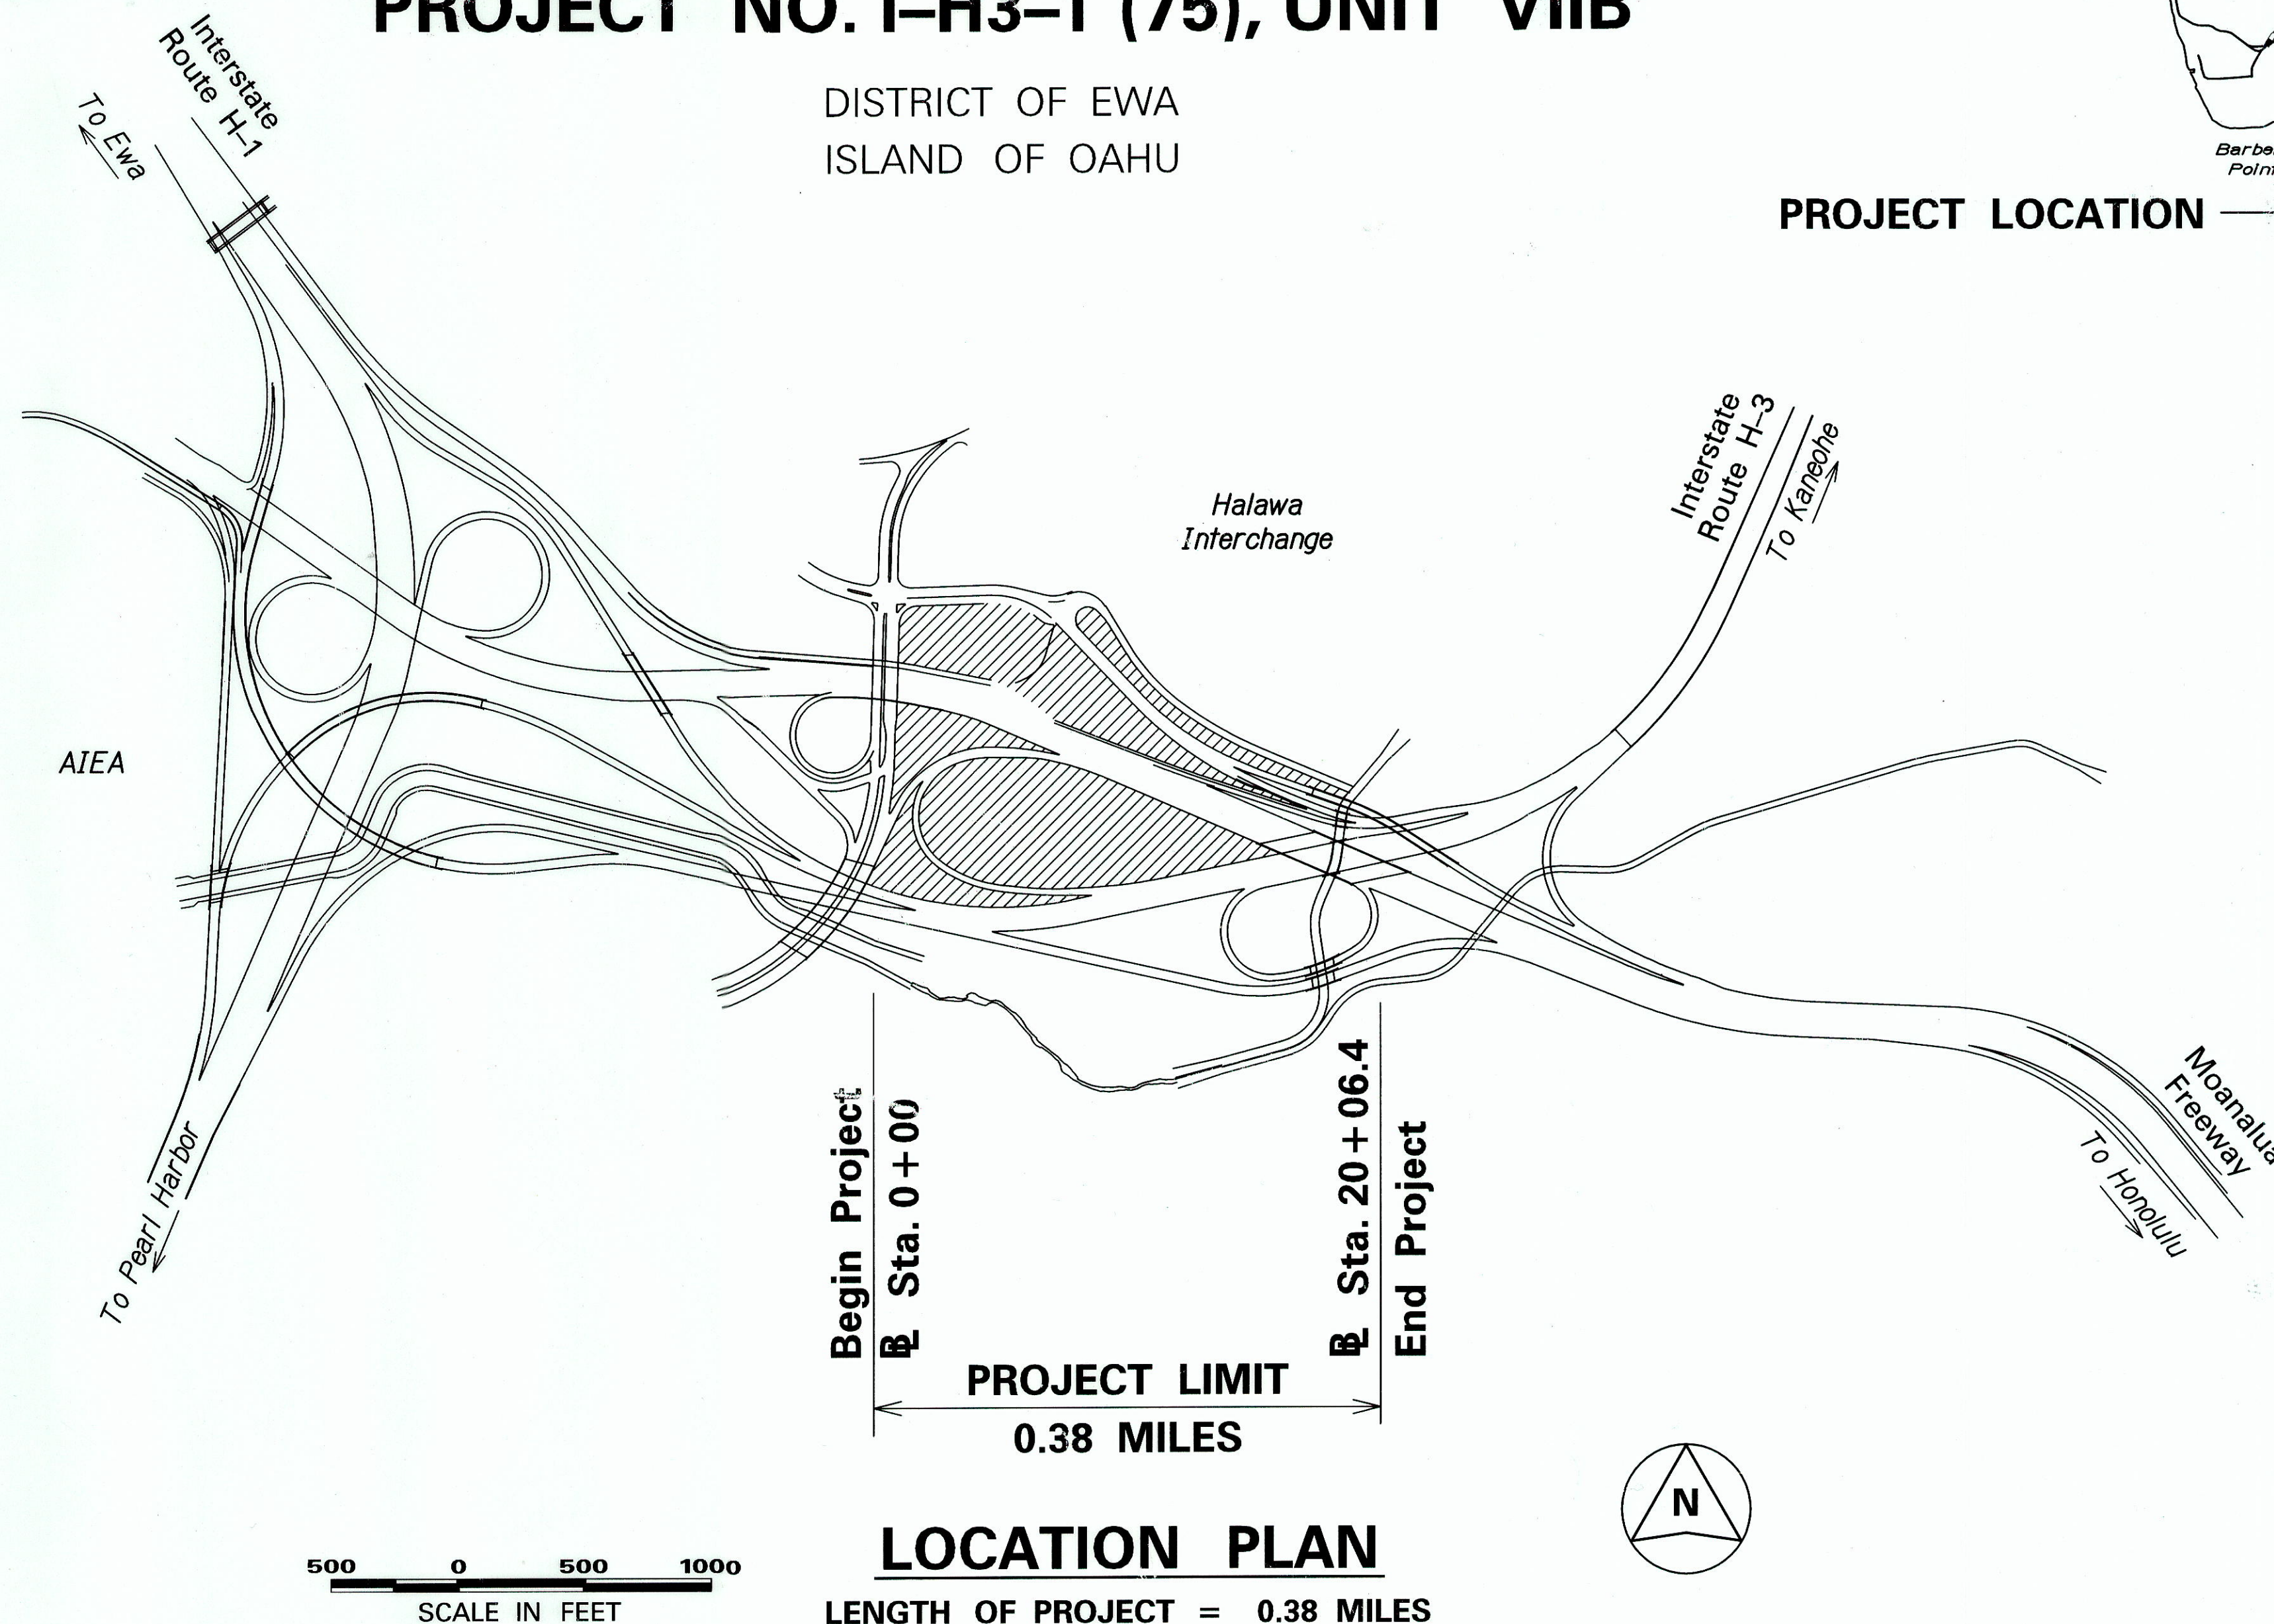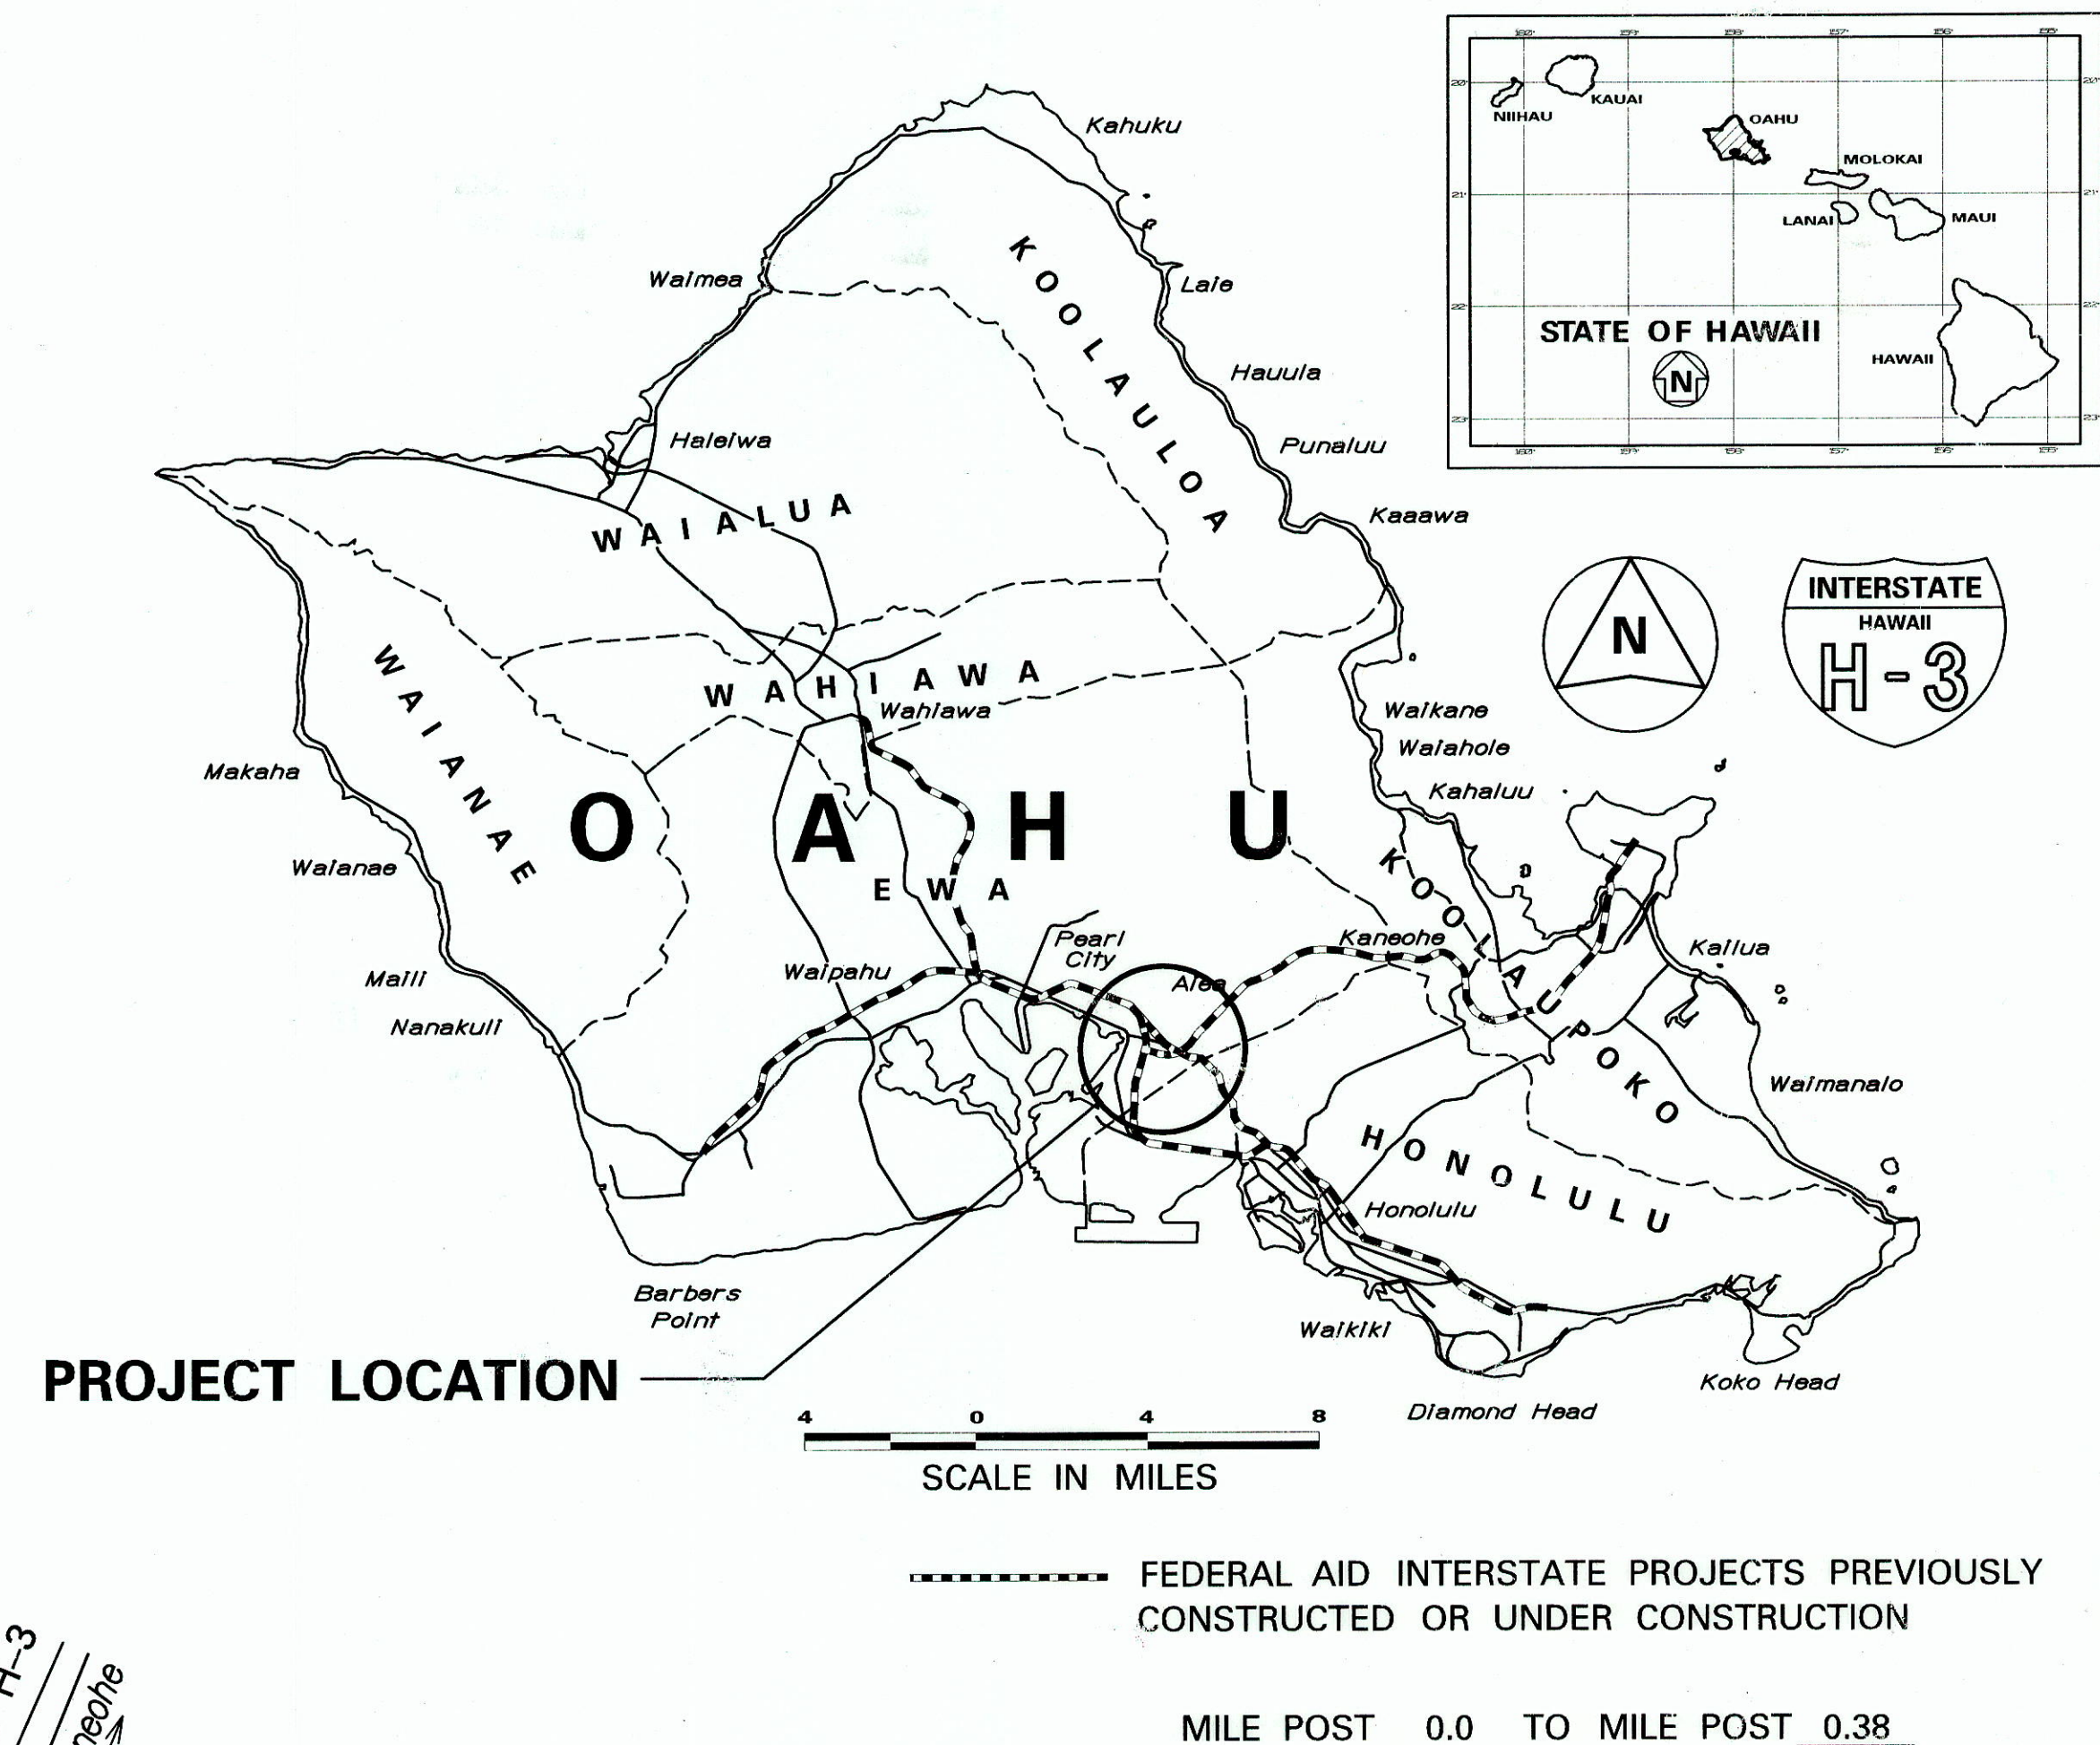

ORIGINAL PLAN	DESIGNED BY	DATE
NOTE BOOK	DRAWN BY	
	DESIGNED BY	
	QUANTITIES BY	
	CHECKED BY	

PBHA

DESIGNED BY

HWY-DS

MANAGED BY:

692-7544

PHONE

DEC 2008

DATE

CHANGES MADE DURING CONSTRUCTION HAVE BEEN INCORPORATED ON THESE PLANS EXCEPT CHANGES IN THE ORIGINAL THEORETICAL QUANTITIES. FOR ACTUAL QUANTITIES, REFER TO PROJECT LEDGER AND/OR COMPUTATION BOOK.

Samuel P. Pimentel

RESIDENT ENGINEER

6/30/2014

DATE

DEPARTMENT OF TRANSPORTATION

STATE OF HAWAII

APPROVED:

12/23/08

DATE