




FED. ROAD DIST. NO.	STATE	FEDERAL AID PROJ. NO.	FISCAL YEAR	SHEET NO.	TOTAL SHEETS
HAWAII	HAW.	BR-H3-1(79)	2010	7	37

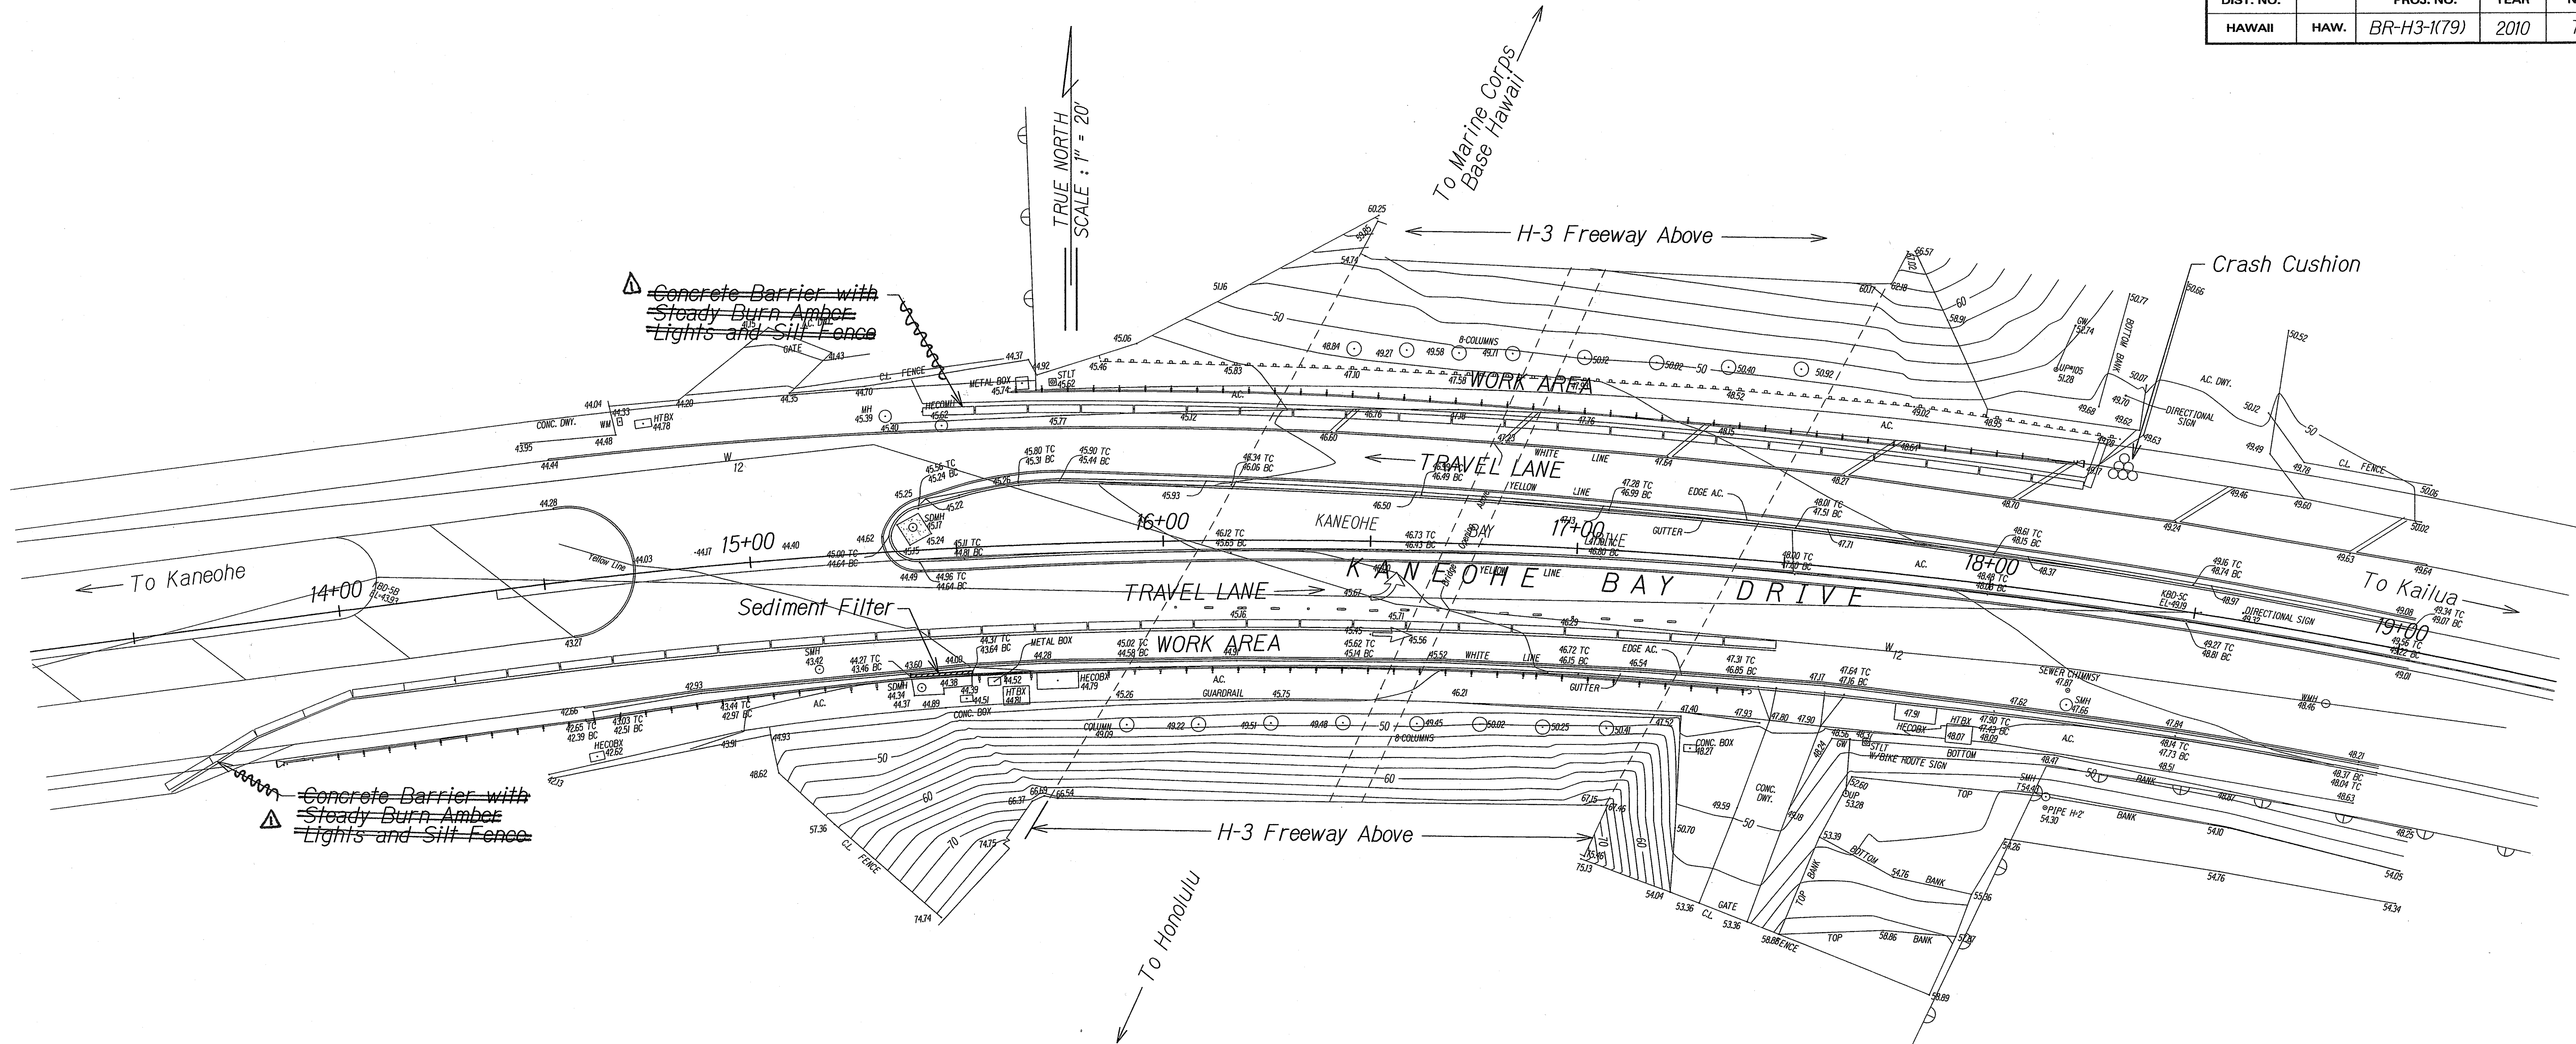


Erosion Control Plan
Scale: 1"=20'

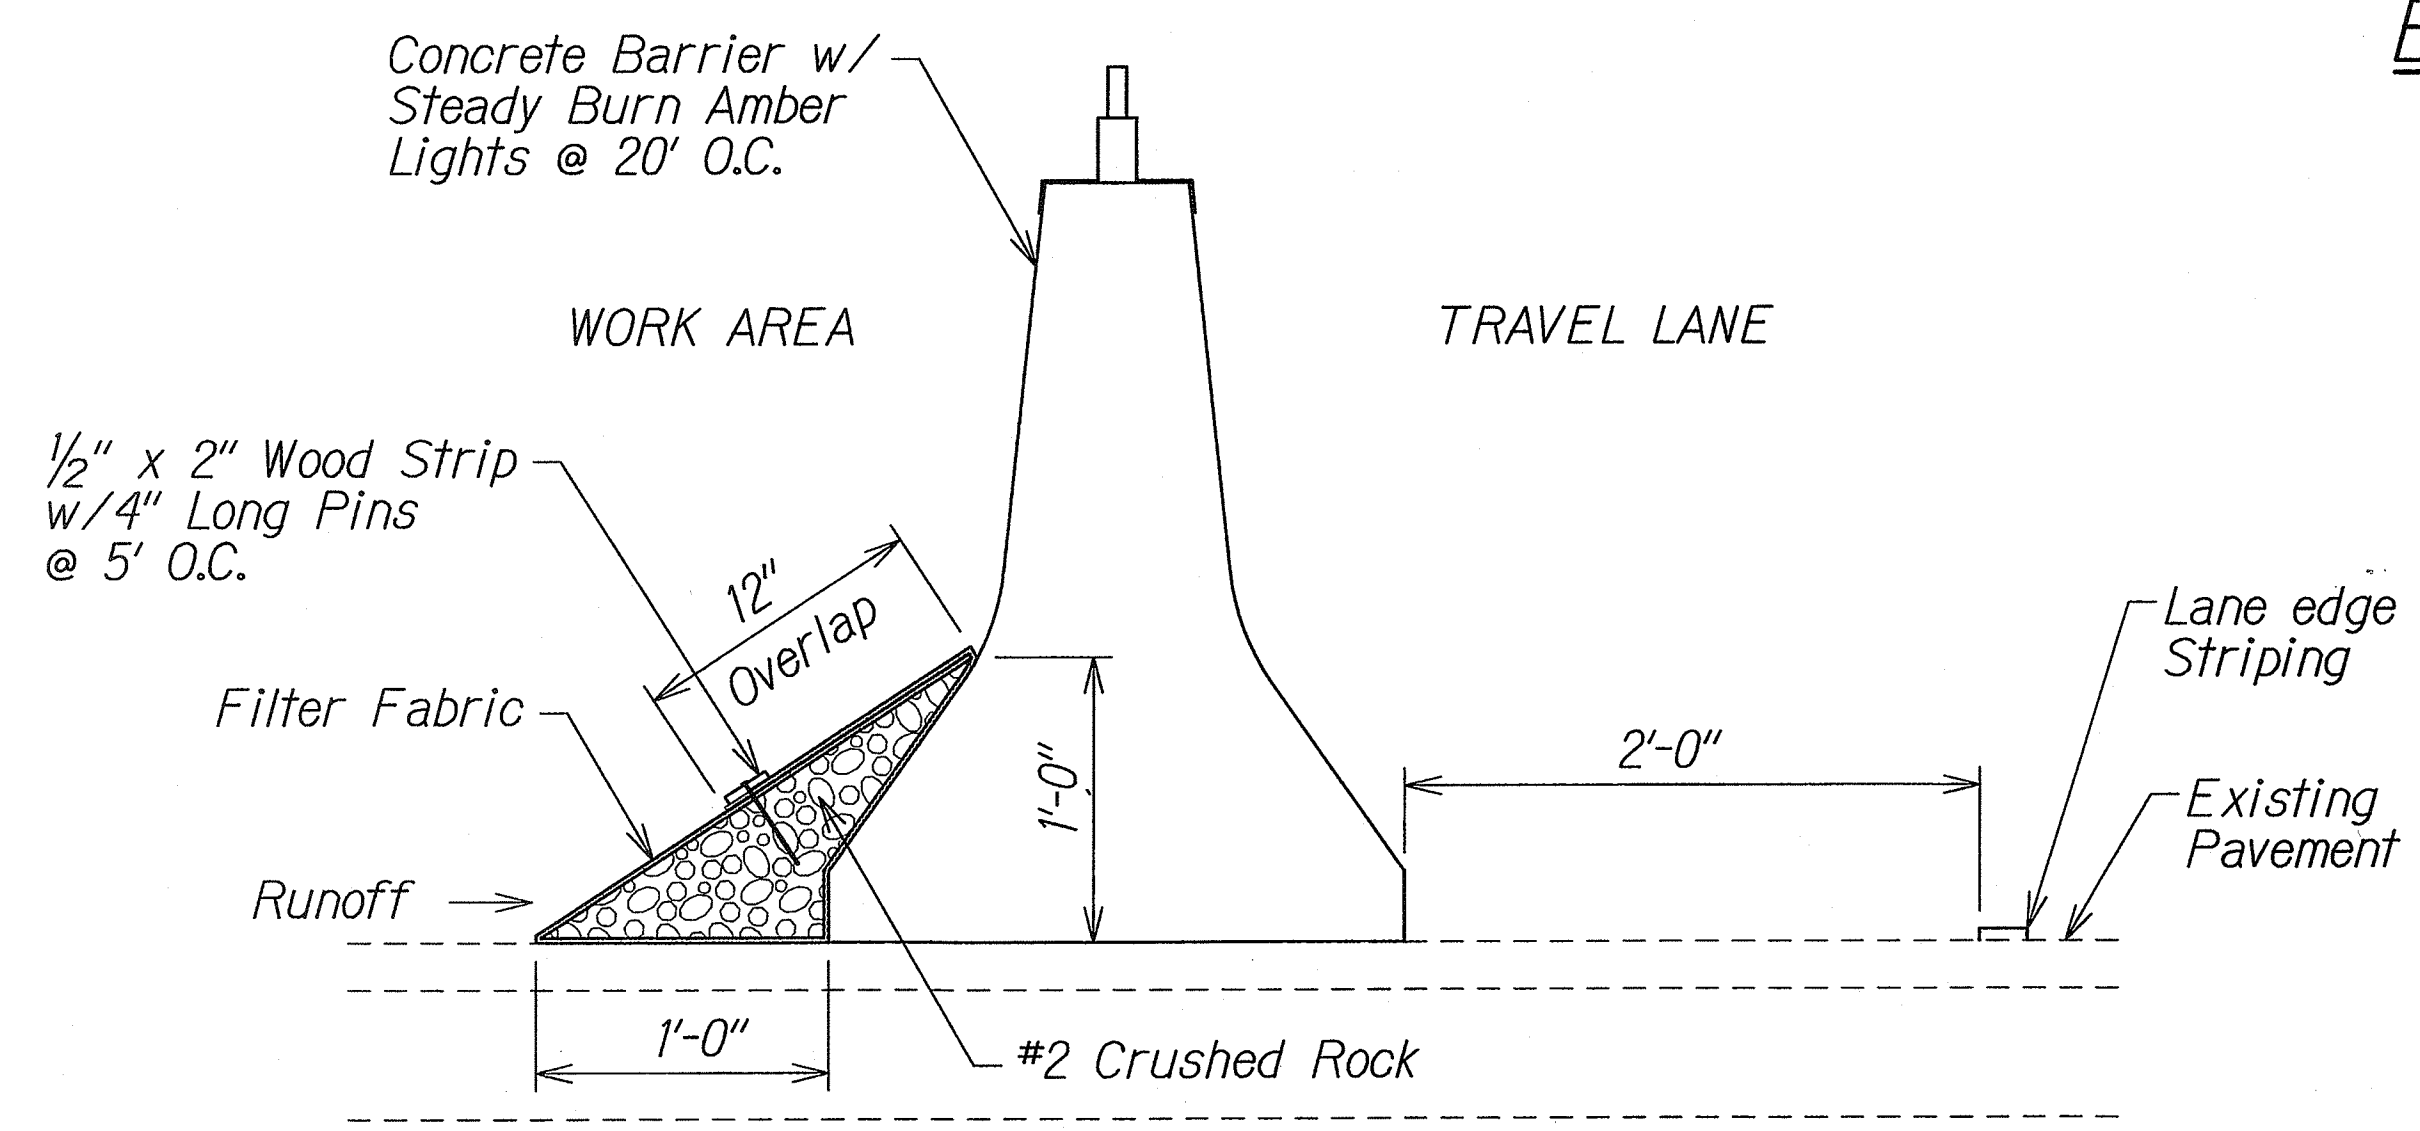

Silt Fence Detail
Scale: N.T.S.

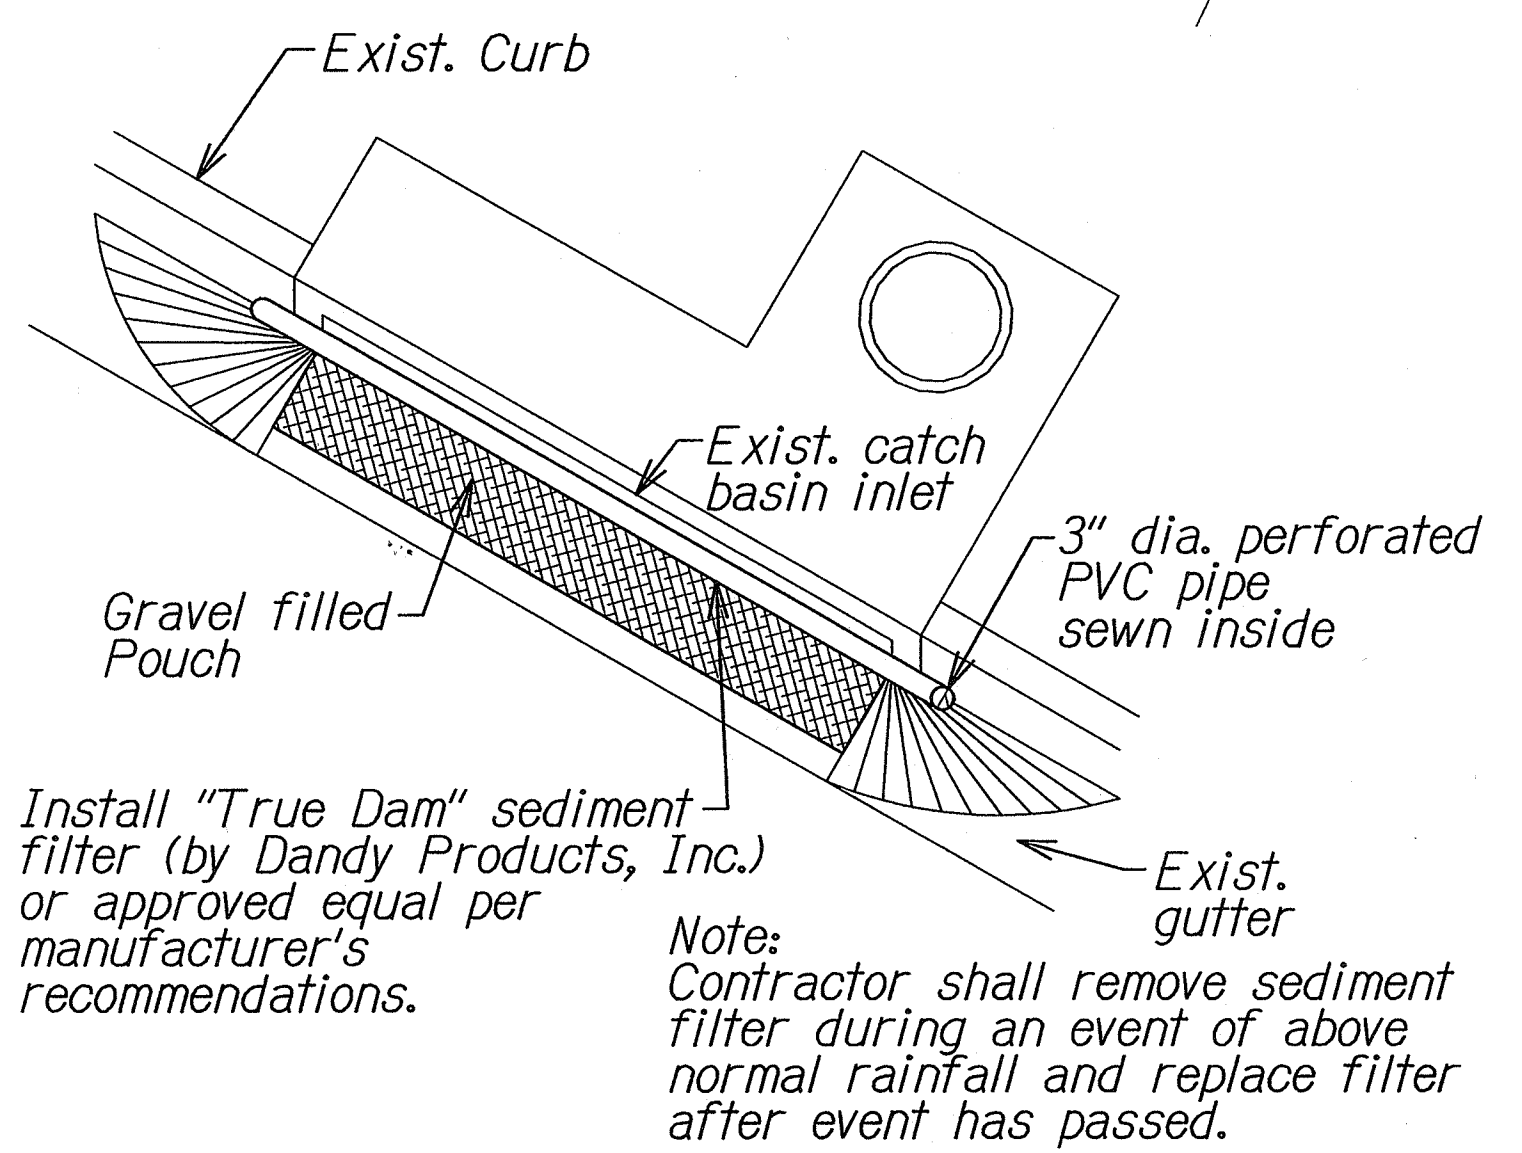

Sediment Filter Detail
Scale: N.T.S.

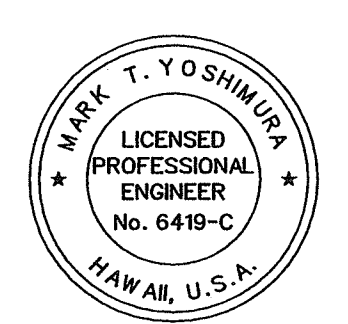

THIS WORK WAS PREPARED BY ME OR UNDER MY SUPERVISION AND CONSTRUCTION OF THIS PROJECT WILL BE UNDER MY OBSERVATION.
Mark T. Yoshimura
EXP. DATE: APRIL 2010

DATE 6-11-10	All construction traffic control shall follow Section 645- Work Zone Traffic Control
	REVISION
STATE OF HAWAII DEPARTMENT OF TRANSPORTATION HIGHWAYS DIVISION	
EROSION CONTROL PLAN	
Interstate Route H-3 Seismic Retrofit of Mokapu Interchange FEDERAL AID PROJECT NO. BR-H3-1(79)	
Scale: 1"=20'	Date: April, 2008
SHEET No. C5 OF 11 SHEETS	

"AS-BUILT"