

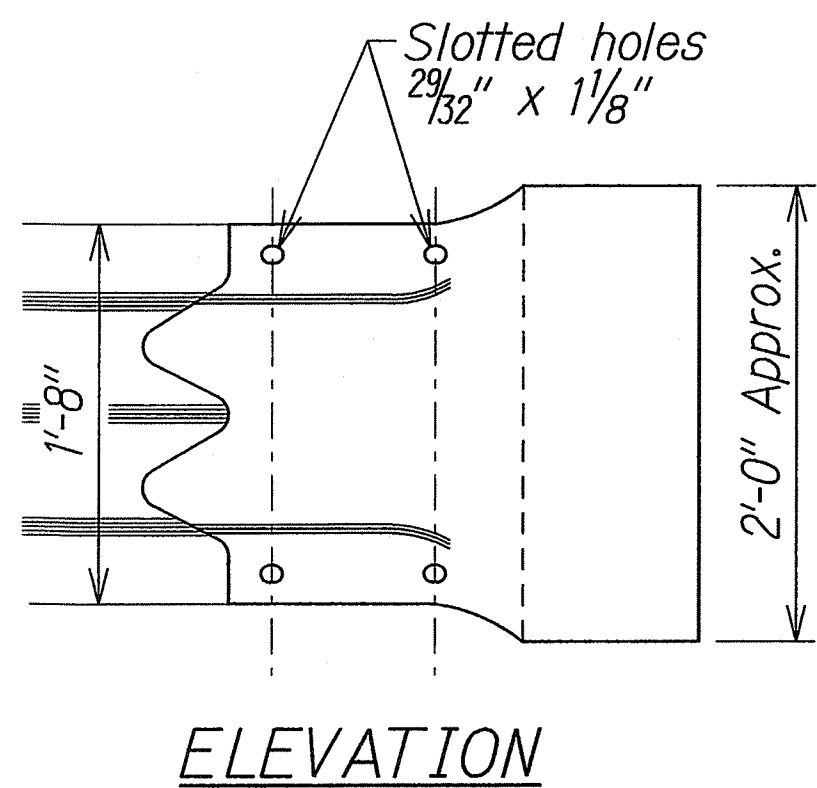


FED. ROAD DIST. NO.	STATE	FEDERAL AID PROJ. NO.	FISCAL YEAR	SHEET NO.	TOTAL SHEETS
HAWAII	HAW.	BR-H3-1(79)	2010	12	37

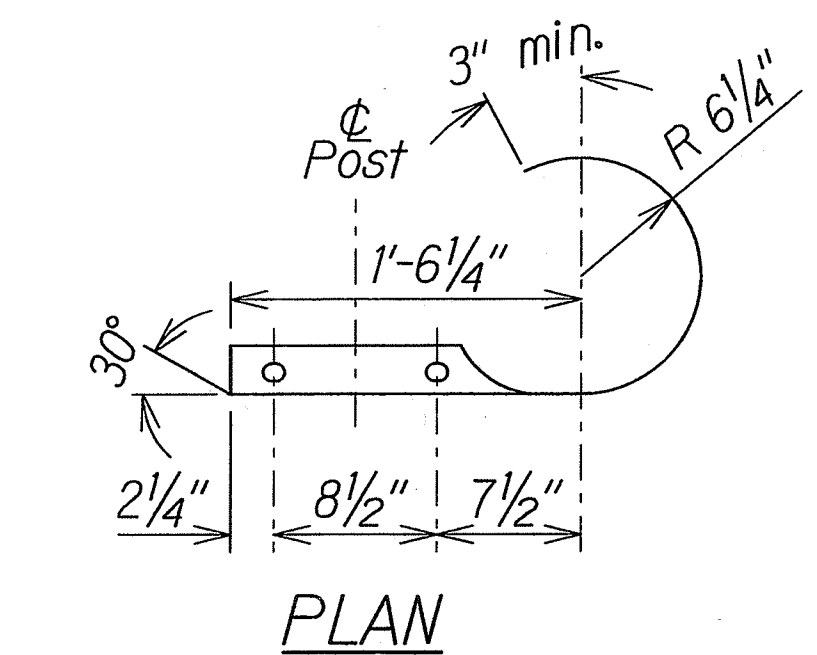


1
C4 C10
SECTION (ROUNDED) (RTE02b)
Scale: N.T.S.

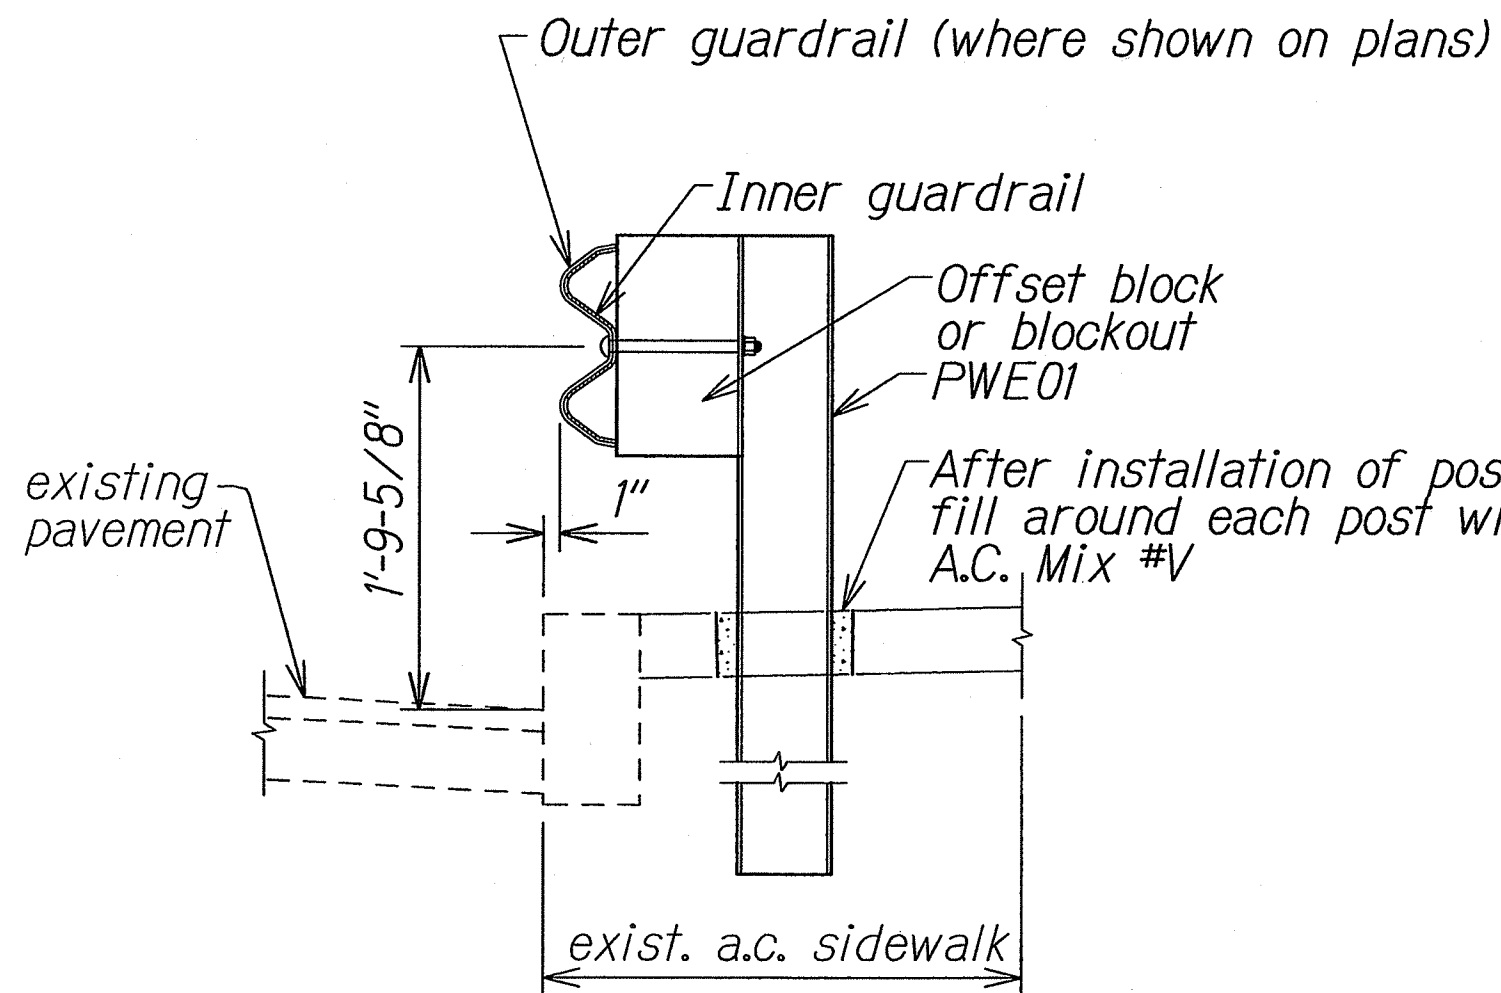


RFI # 7. Install new mauka side guardrail at about same location of existing guardrail. The distance between the faces of the existing concrete curb and new guardrail shall not be less than 6'.

2
C4 C10
Section
Scale: N.T.S.

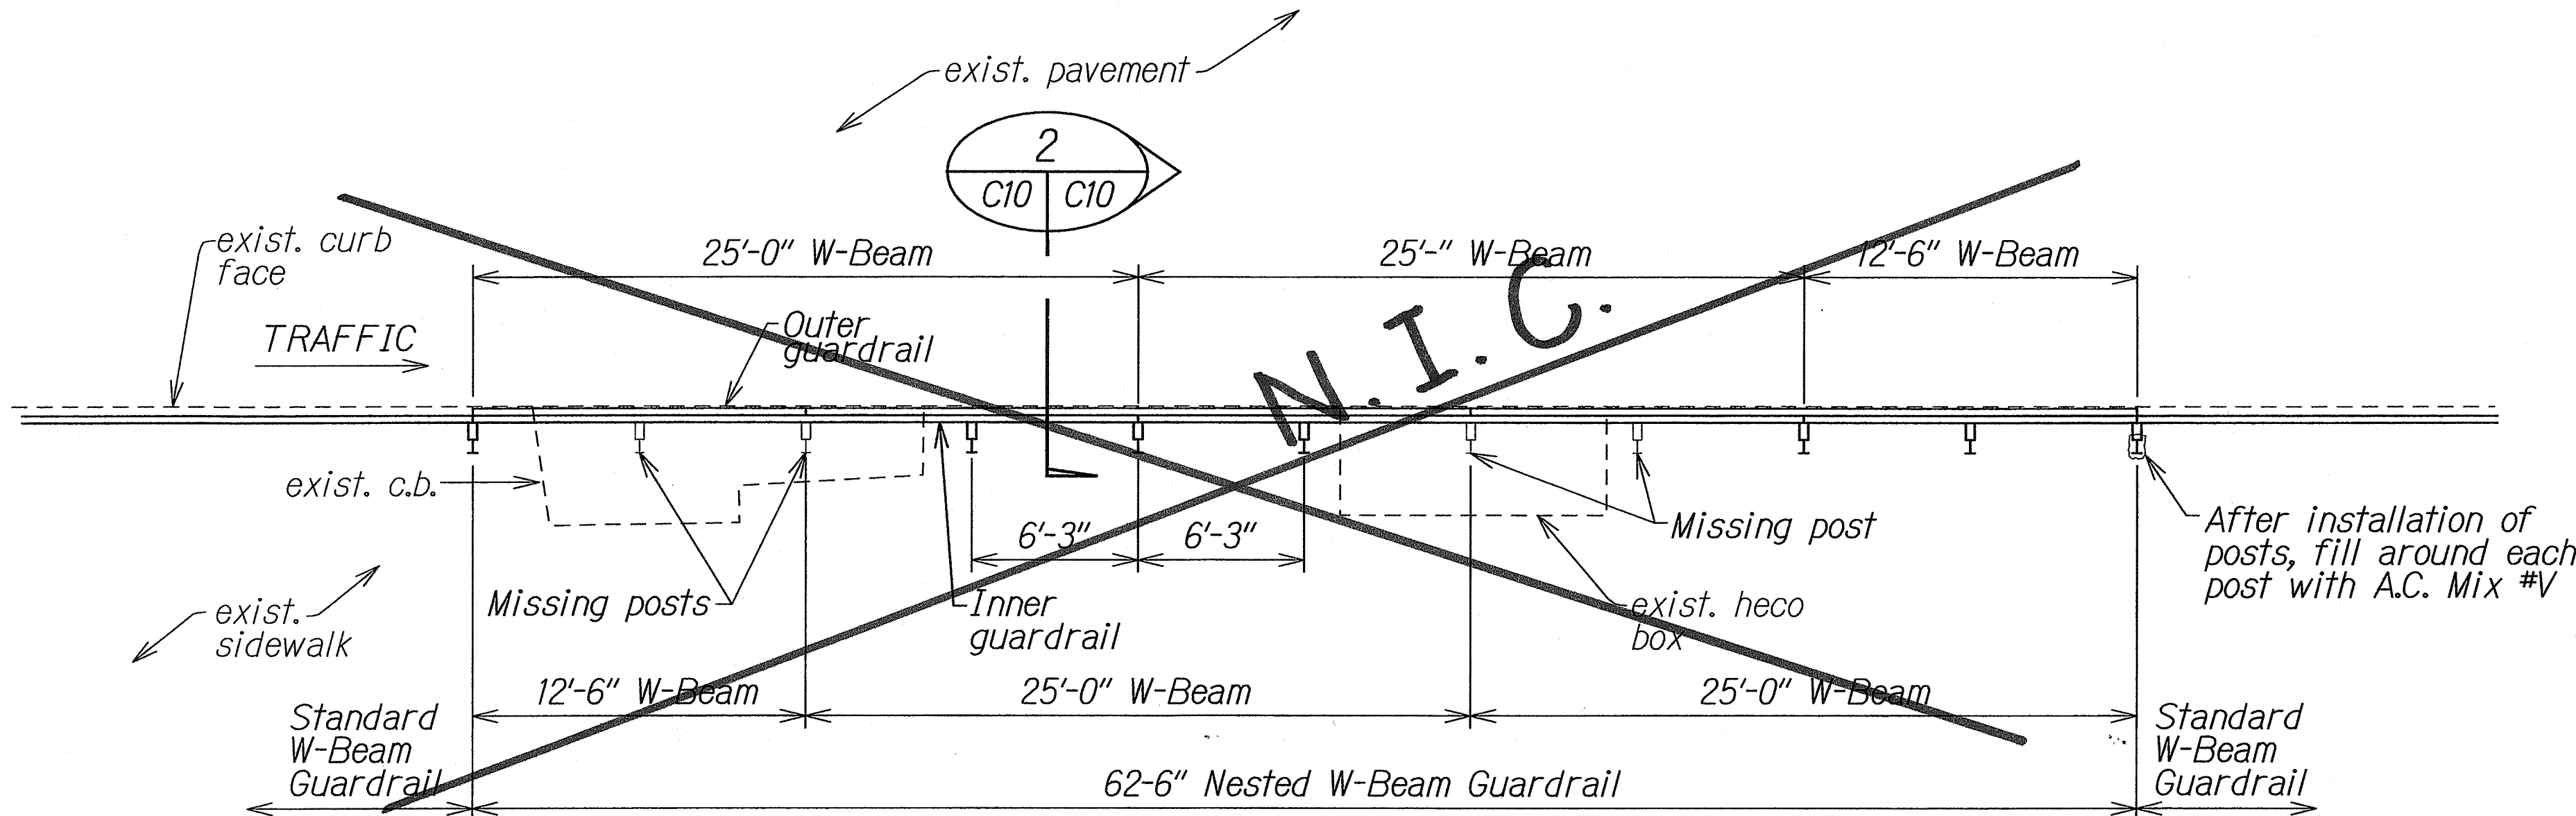

3
C4 C10
Plan - Nested Guardrail
Scale: N.T.S.

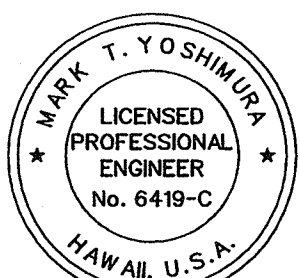

THIS WORK WAS PREPARED BY ME OR UNDER MY SUPERVISION AND CONSTRUCTION OF THIS PROJECT WILL BE UNDER MY OBSERVATION.
Mark T. Yoshimura
EXP. DATE: APRIL 2010

STATE OF HAWAII
DEPARTMENT OF TRANSPORTATION
HIGHWAYS DIVISION

GUARDRAIL DETAILS

Interstate Route H-3
Seismic Retrofit of Mokapu Interchange
FEDERAL AID PROJECT NO. BR-H3-1(79)
Scale: N.T.S. Date: April, 2008
SHEET No. C10 OF 11 SHEETS

DATE	_____
SURVEY PLOTTED BY	_____
TRACED BY	_____
CHECKED BY	_____
NOTE BOOK	_____
NO.	_____

"AS-BUILT"