



FED. ROAD DIST. NO.	STATE	FEDERAL AID PROJ. NO.	FISCAL YEAR	SHEET NO.	TOTAL SHEETS
HAWAII	HAW.	BR-H3-K(79)	2010	13	37

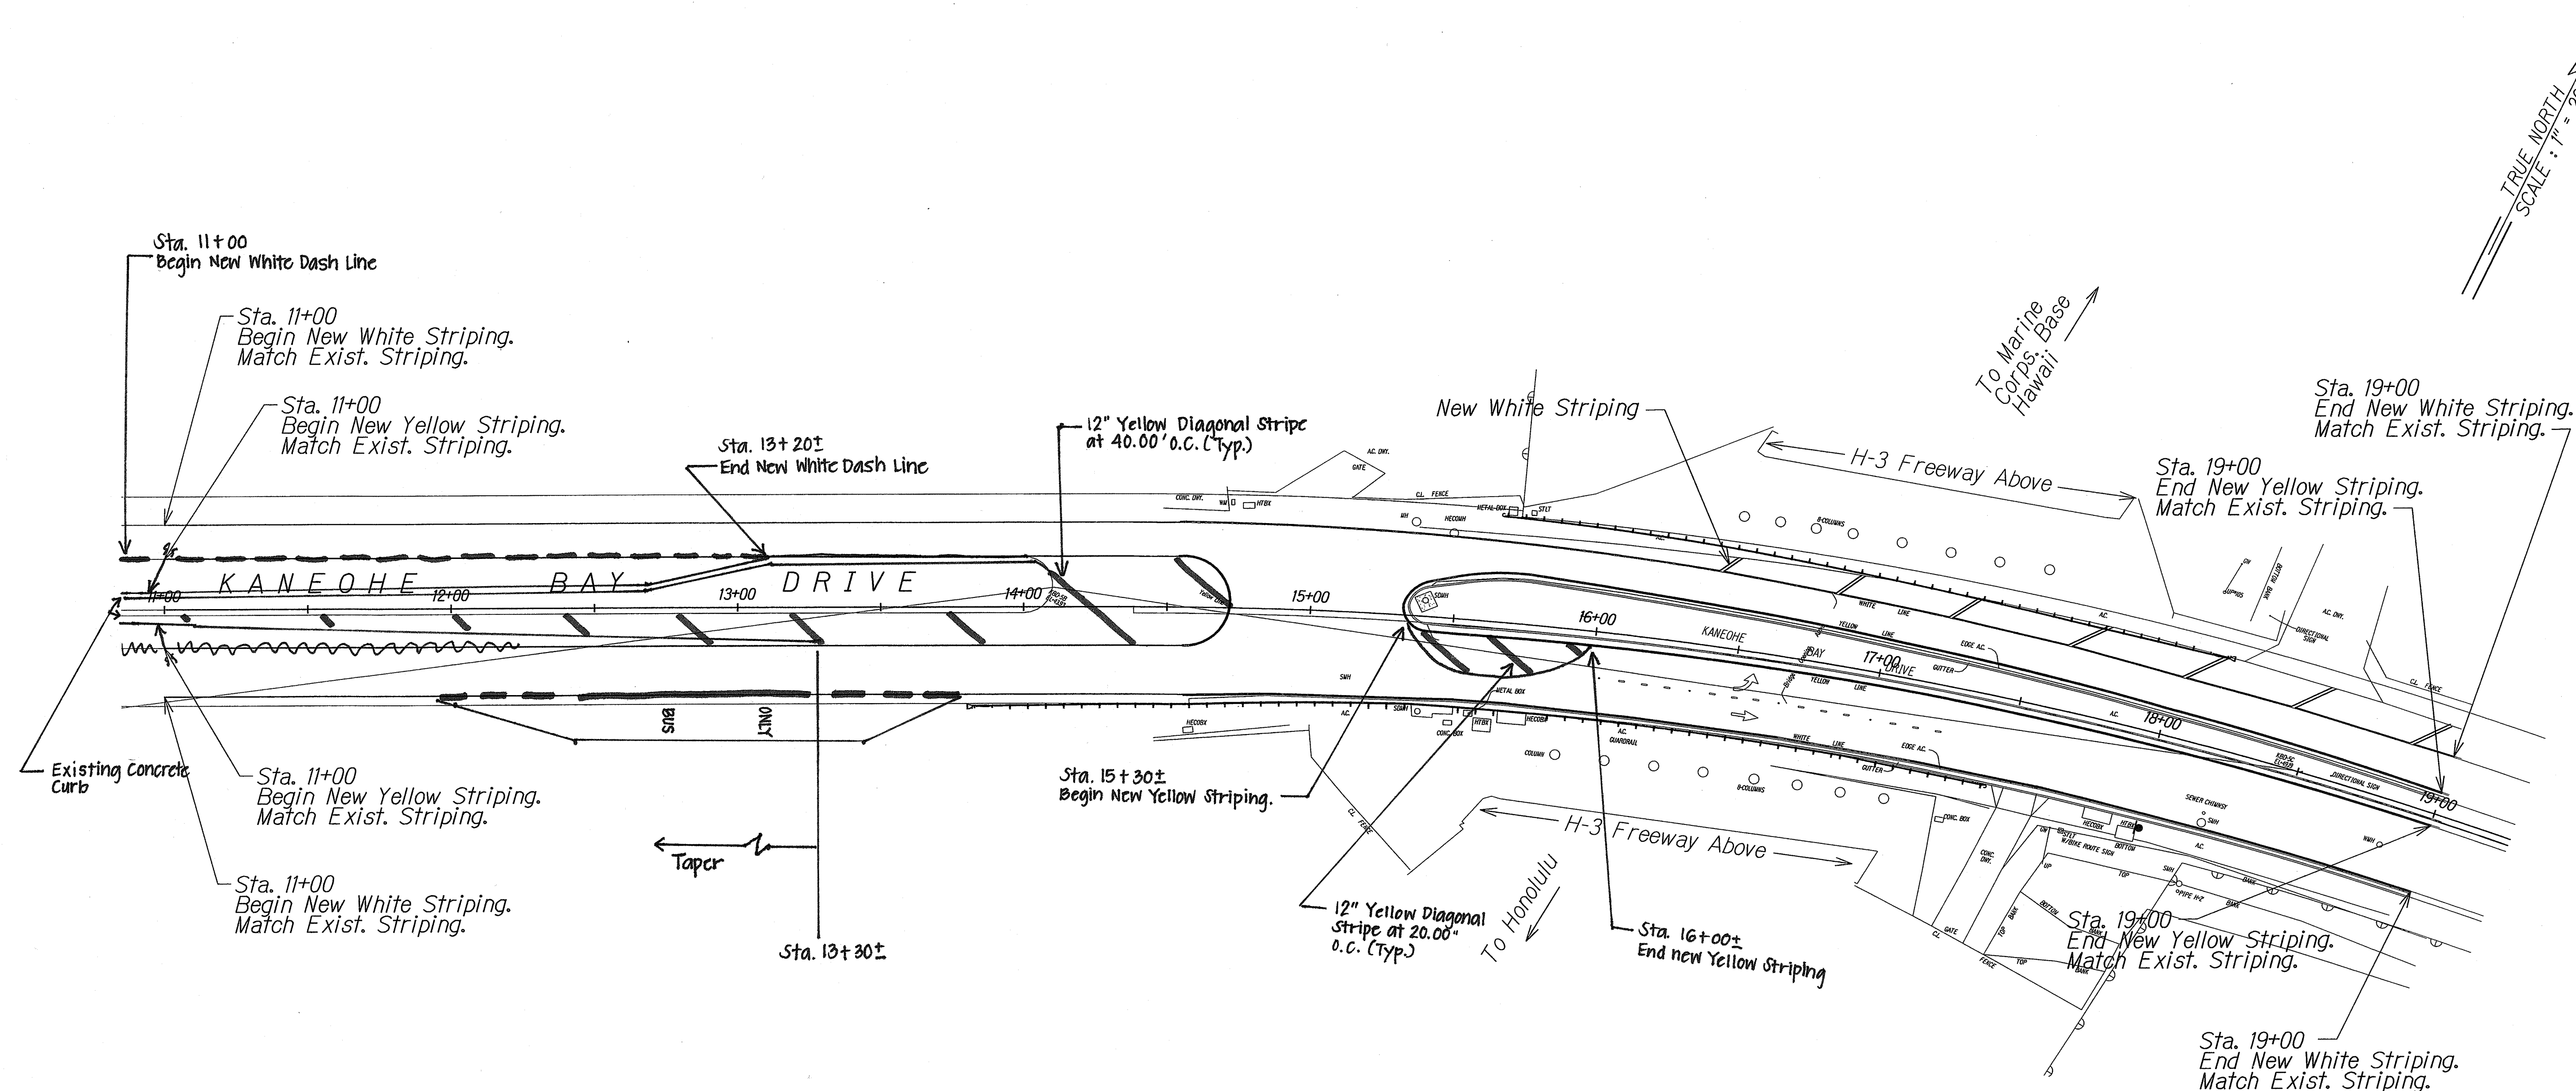

Striping Plan
Scale: 1"=20'

DATE	_____
SURVEY PLOTTED BY	_____
DESIGNED BY	_____
CHECKED BY	_____
ORIGINAL PLAN	_____
NOTE BOOK	_____
No.	_____

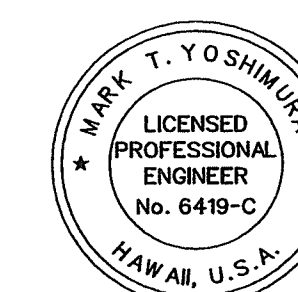

THIS WORK WAS PREPARED BY ME OR UNDER MY SUPERVISION AND CONSTRUCTION OF THIS PROJECT WILL BE UNDER MY OBSERVATION.
Mark T. Yoshimura
EXP. DATE: APRIL 2010

STATE OF HAWAII
DEPARTMENT OF TRANSPORTATION
HIGHWAYS DIVISION

STRIPING PLAN

*Interstate Route H-3
Seismic Retrofit of Mokapu Interchange*
FEDERAL AID PROJECT NO. BR-H3-K(79)
Scale: N.T.S. Date: April, 2008

SHEET No. C11 OF 11 SHEETS

"AS-BUILT"