

INDEX TO DRAWINGS	
SHEET NO.	DESCRIPTION
1	TITLE SHEET
2	STANDARD PLANS SUMMARY
3	GENERAL NOTES
4 - 5	WATER POLLUTION AND EROSION CONTROL NOTES
6	SITE PLAN
7	EROSION CONTROL PLAN
8	TRAFFIC CONTROL PLAN
9	GUARDRAIL DETAILS & NOTES
10	STRONG POST W-BEAM GUARDRAIL
11	SEQUENTIAL KINKING TERMINAL
12	GUARDRAIL DETAILS
13	STRIPING PLAN
14 - 37	STRUCTURAL PLANS

STATE OF HAWAII

DEPARTMENT OF TRANSPORTATION

HIGHWAYS DIVISION

HONOLULU, HAWAII


"AS-BUILT"

PLANS FOR

INTERSTATE ROUTE H-3

SEISMIC RETROFIT OF MOKAPU INTERCHANGE


FEDERAL AID PROJECT NO. BR-H3-1(79)

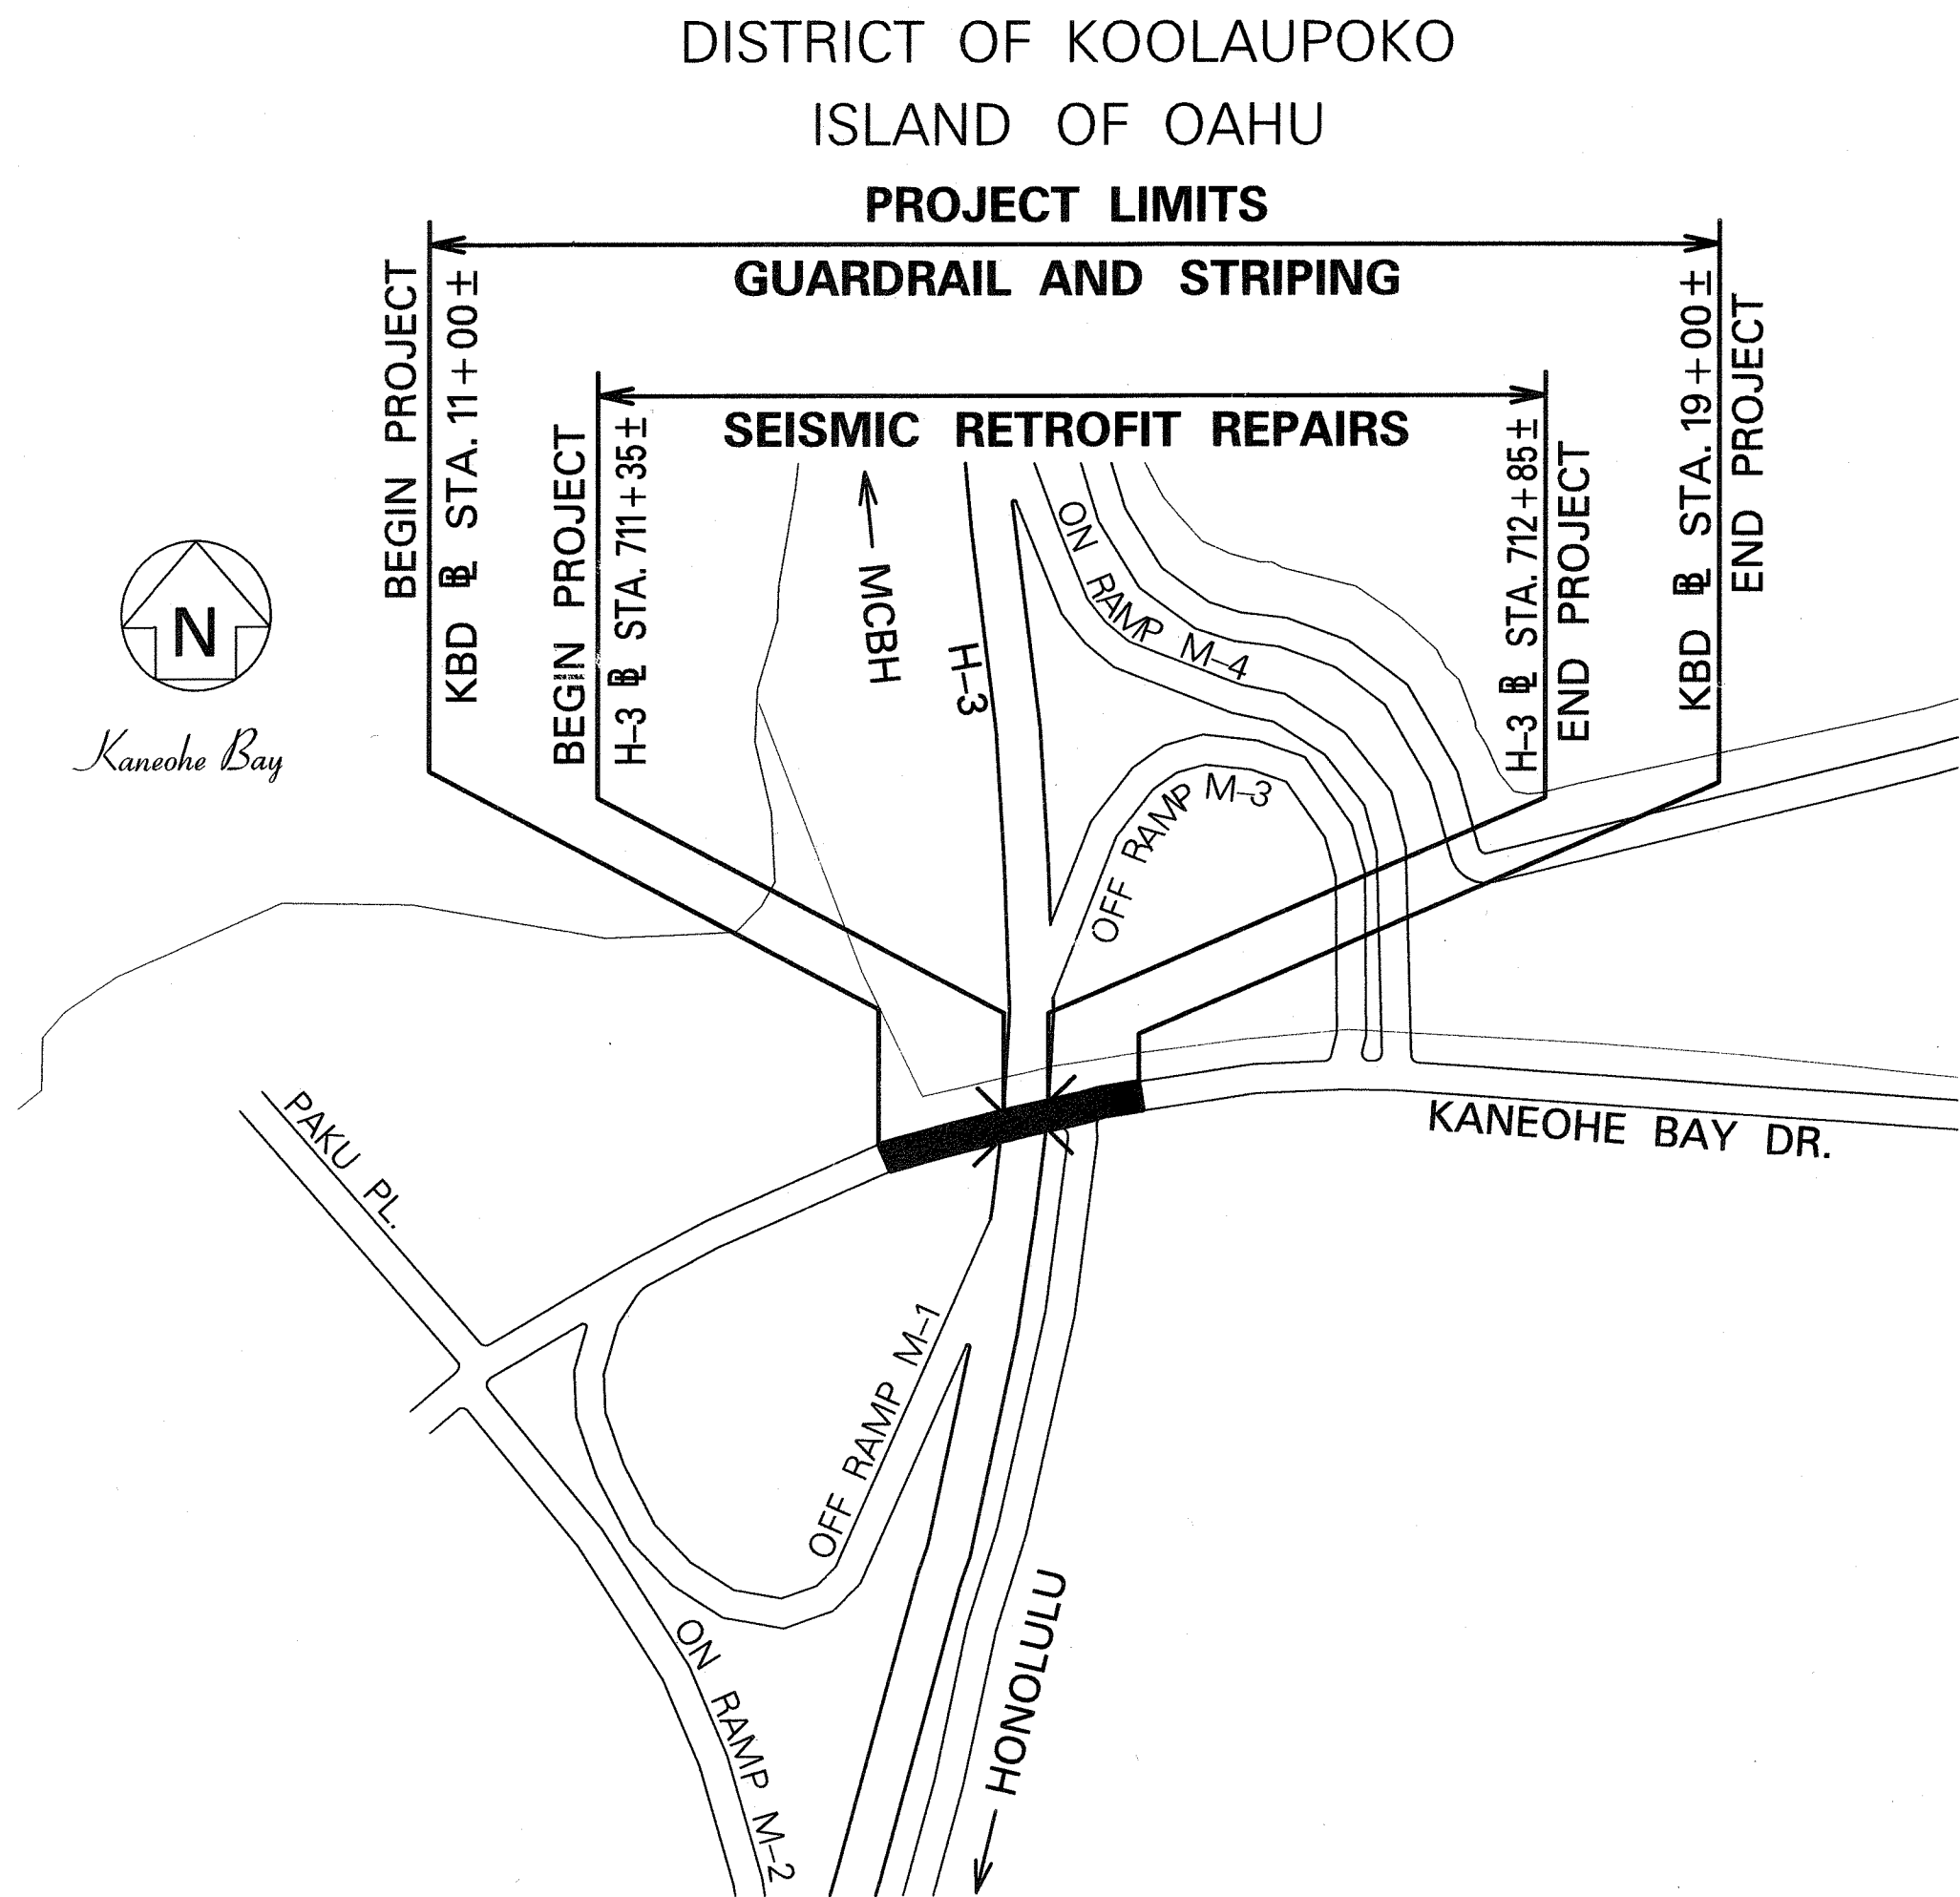



LAYOUT PLAN

GROSS LENGTH OF PROJECT..... 0.03 MILES

NET LENGTH OF PROJECT..... 0.03 MILES

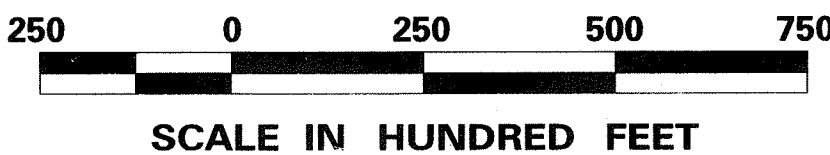

FED. ROAD DIST. NO.	STATE	FED. AID PROJ. NO.	FISCAL YEAR	SHEET NO.	TOTAL SHEETS
HAWAII	HAW.	BR-H3-1(79)	2010	1	37

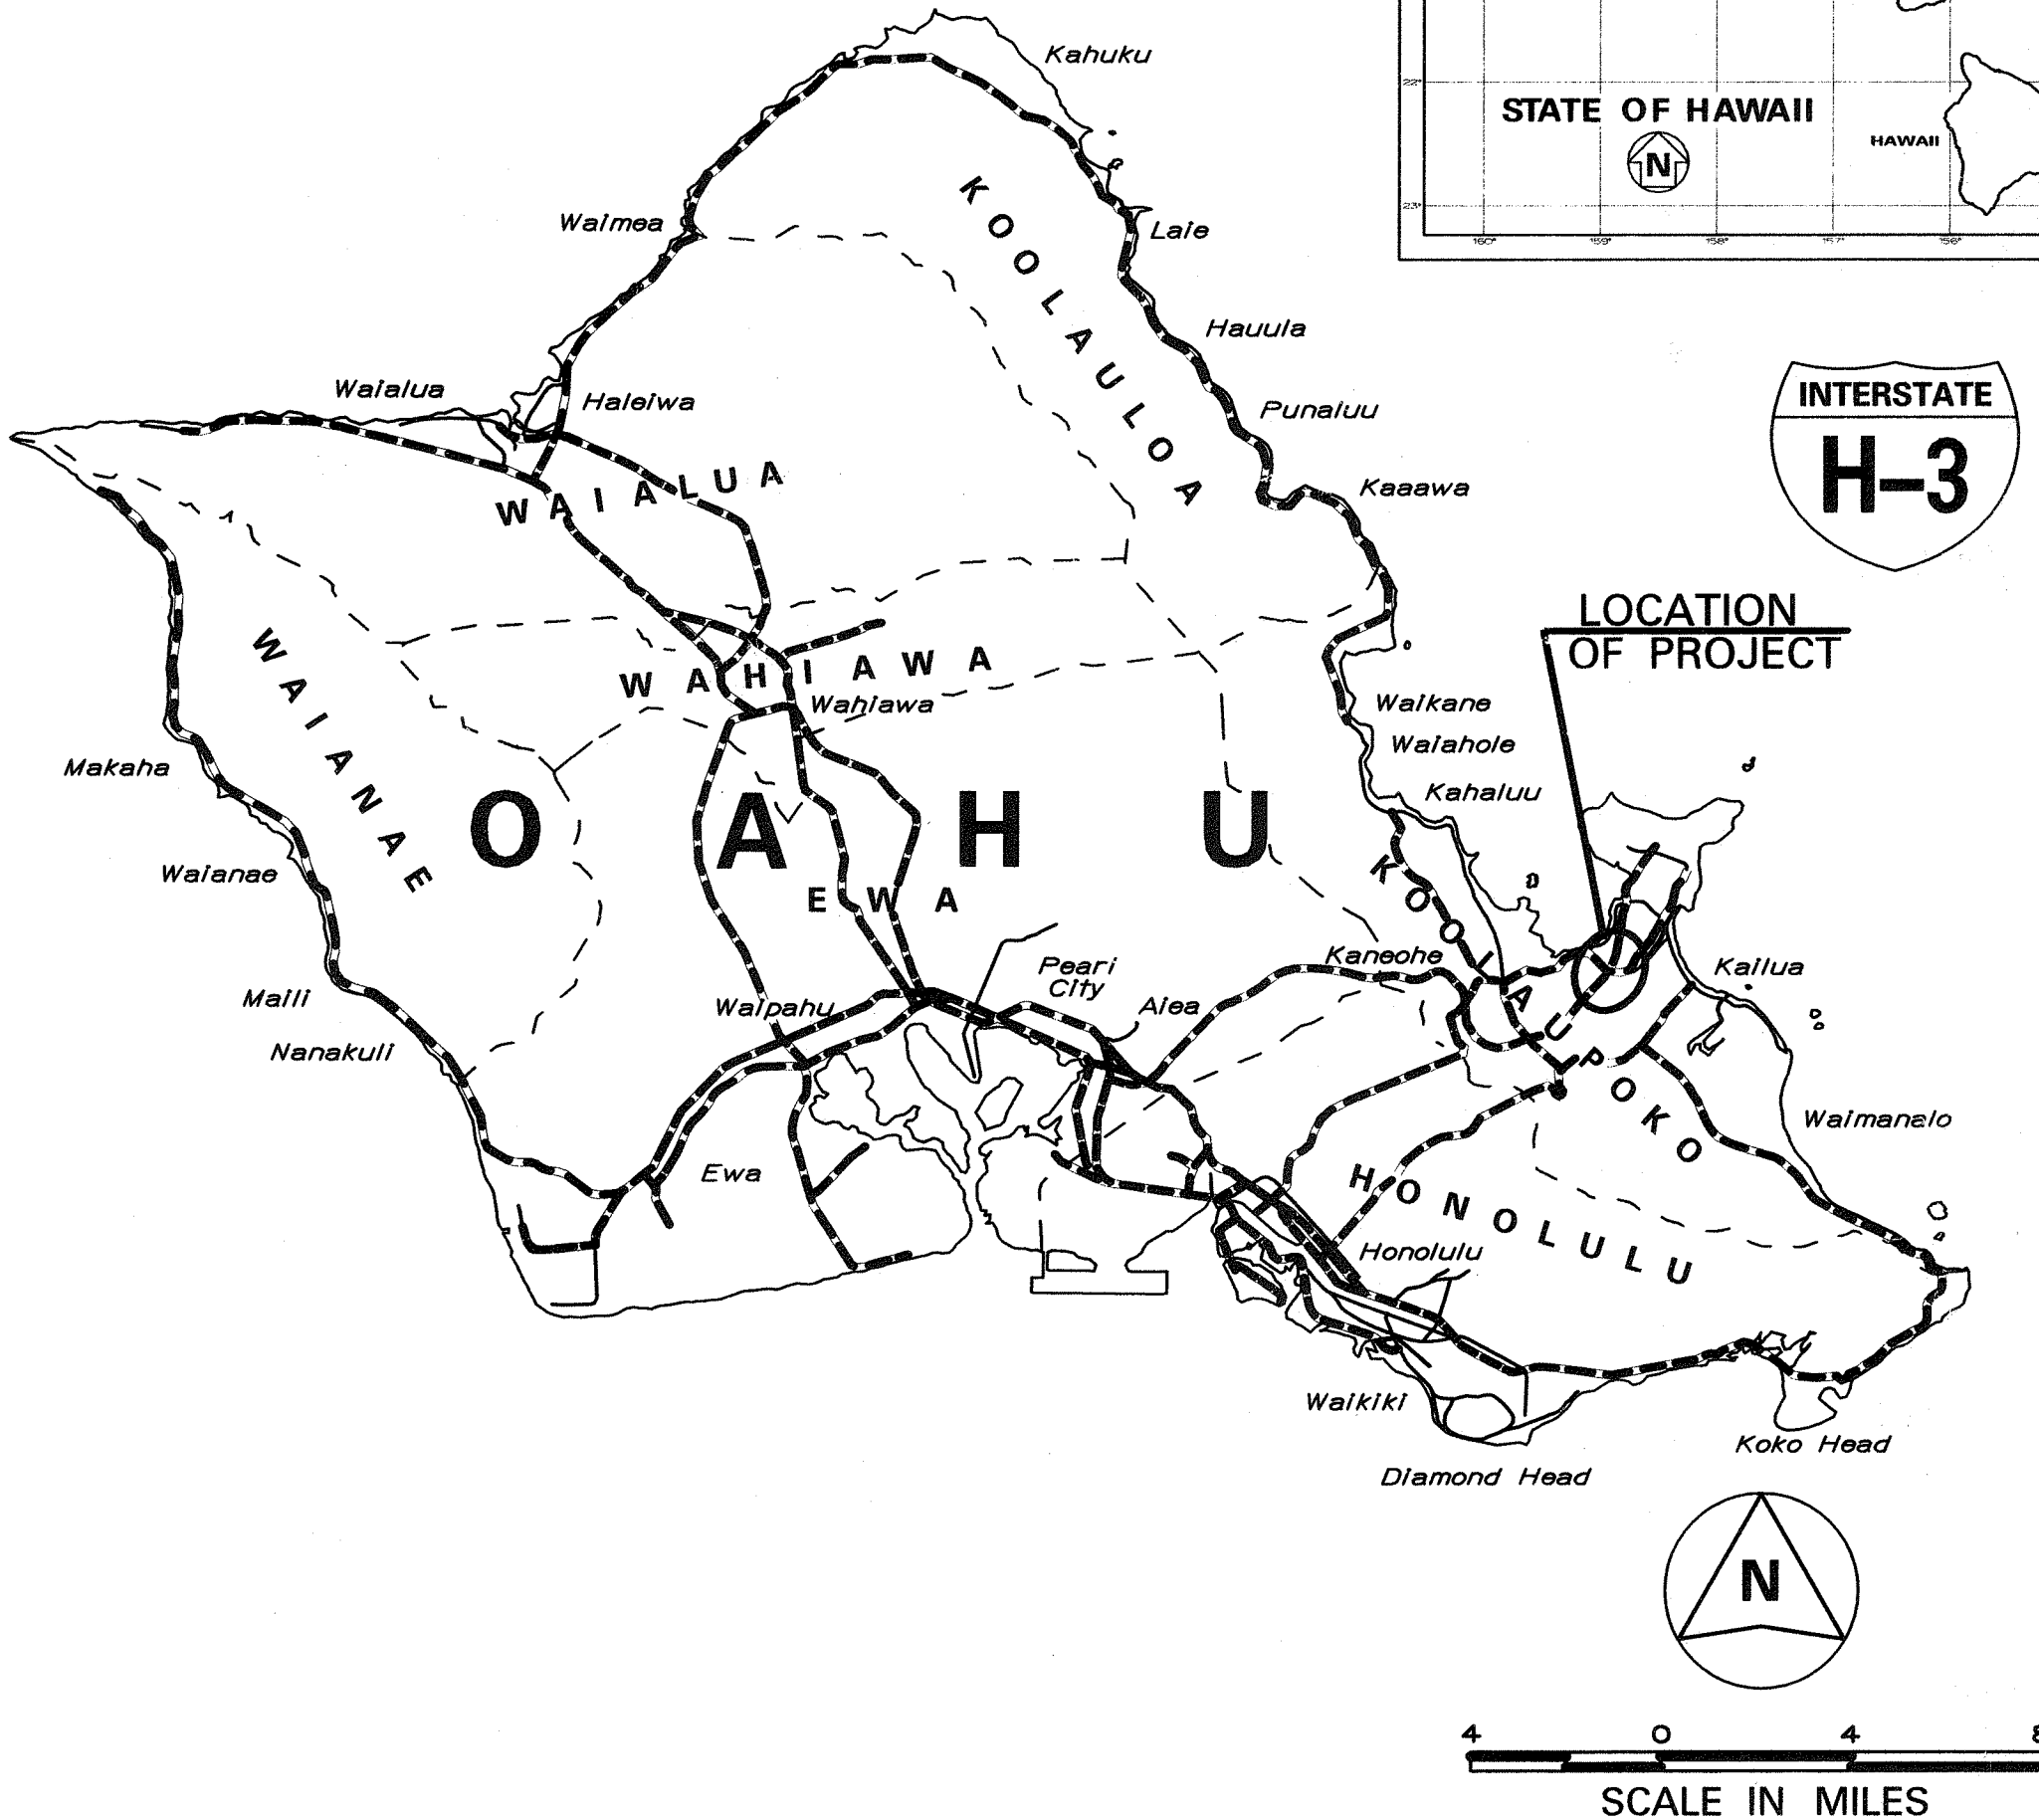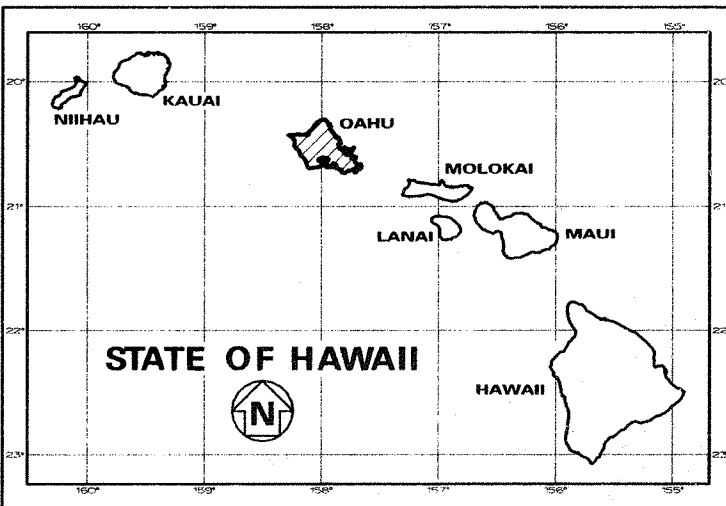

----- FEDERAL AID PROJECTS PREVIOUSLY CONSTRUCTED OR UNDER CONSTRUCTION

MILE POST 14.67 TO MILE POST 14.70

DESIGN DESIGNATION

ADT (2018).....19,700

DHV 1,580

D 60/40

T 3.0 %

T24 3.5 %

V 30 M.P.H.

CHANGES MADE DURING CONSTRUCTION HAVE BEEN INCORPORATED ON THESE PLANS EXCEPT CHANGES IN THE ORIGINAL THEORETICAL QUANTITIES. FOR ACTUAL QUANTITIES, REFER TO PROJECT LEDGER AND/OR COMPUTATION BOOK.

RESIDENT ENGINEER

DATE

DEPARTMENT OF TRANSPORTATION

STATE OF HAWAII

APPROVED:

DIR. OF TRANSPORTATION

DATE

DESIGNED BY

MANAGED BY

DATE

PHONE