


FED. ROAD DIST. NO.	STATE	FED. AID PROJ. NO.	FISCAL YEAR	SHEET NO.	TOTAL SHEETS
HAWAII	HAW.	IM-H3-1(80)	2006	37	66

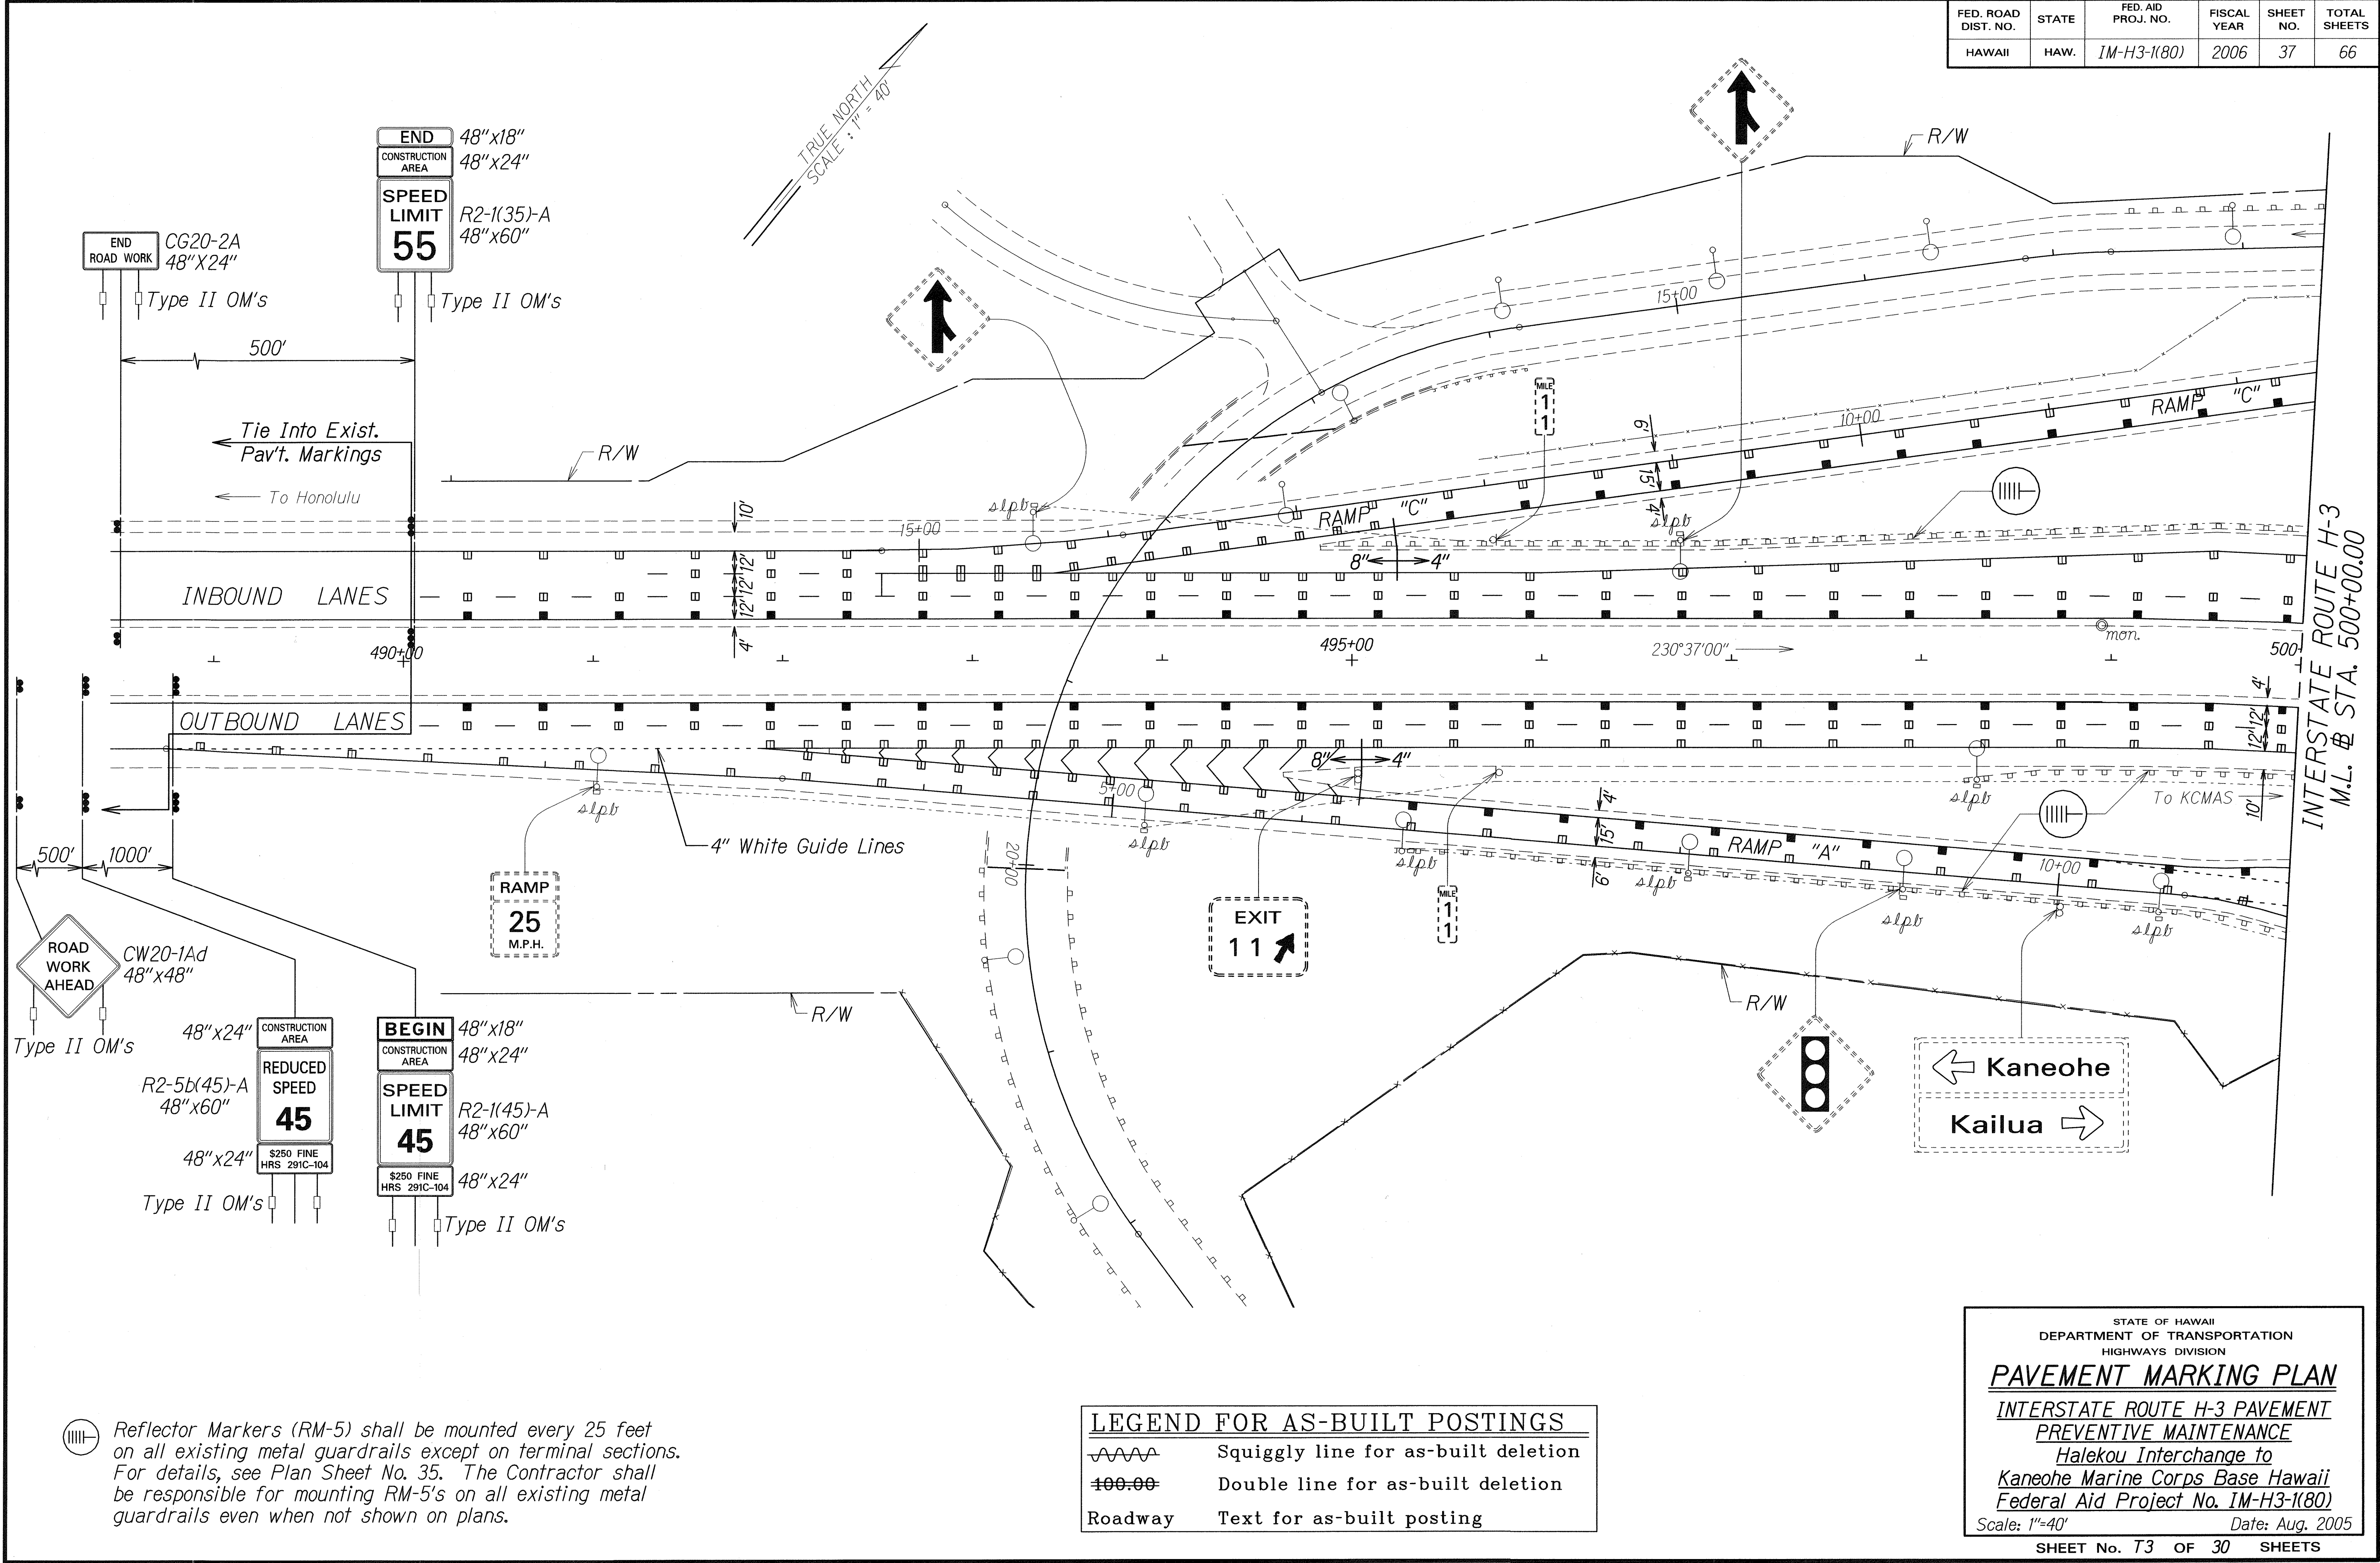

FED. ROAD DIST. NO.	STATE	FED. AID PROJ. NO.	FISCAL YEAR	SHEET NO.	TOTAL SHEETS
HAWAII	HAW.	IM-H3-1(80)	2006	38	66

LEGEND FOR
AS-BUILT POSTINGS


Squiggly line for as-built deletion

Double line for as-built deletion

Roadway

Text for as-built posting

Reflector Markers (RM-5) shall be mounted every 25 feet on all existing metal guardrails except on terminal sections. For details, see Plan Sheet No. 35. The Contractor shall be responsible for mounting RM-5's on all existing metal guardrails even when not shown on plans.

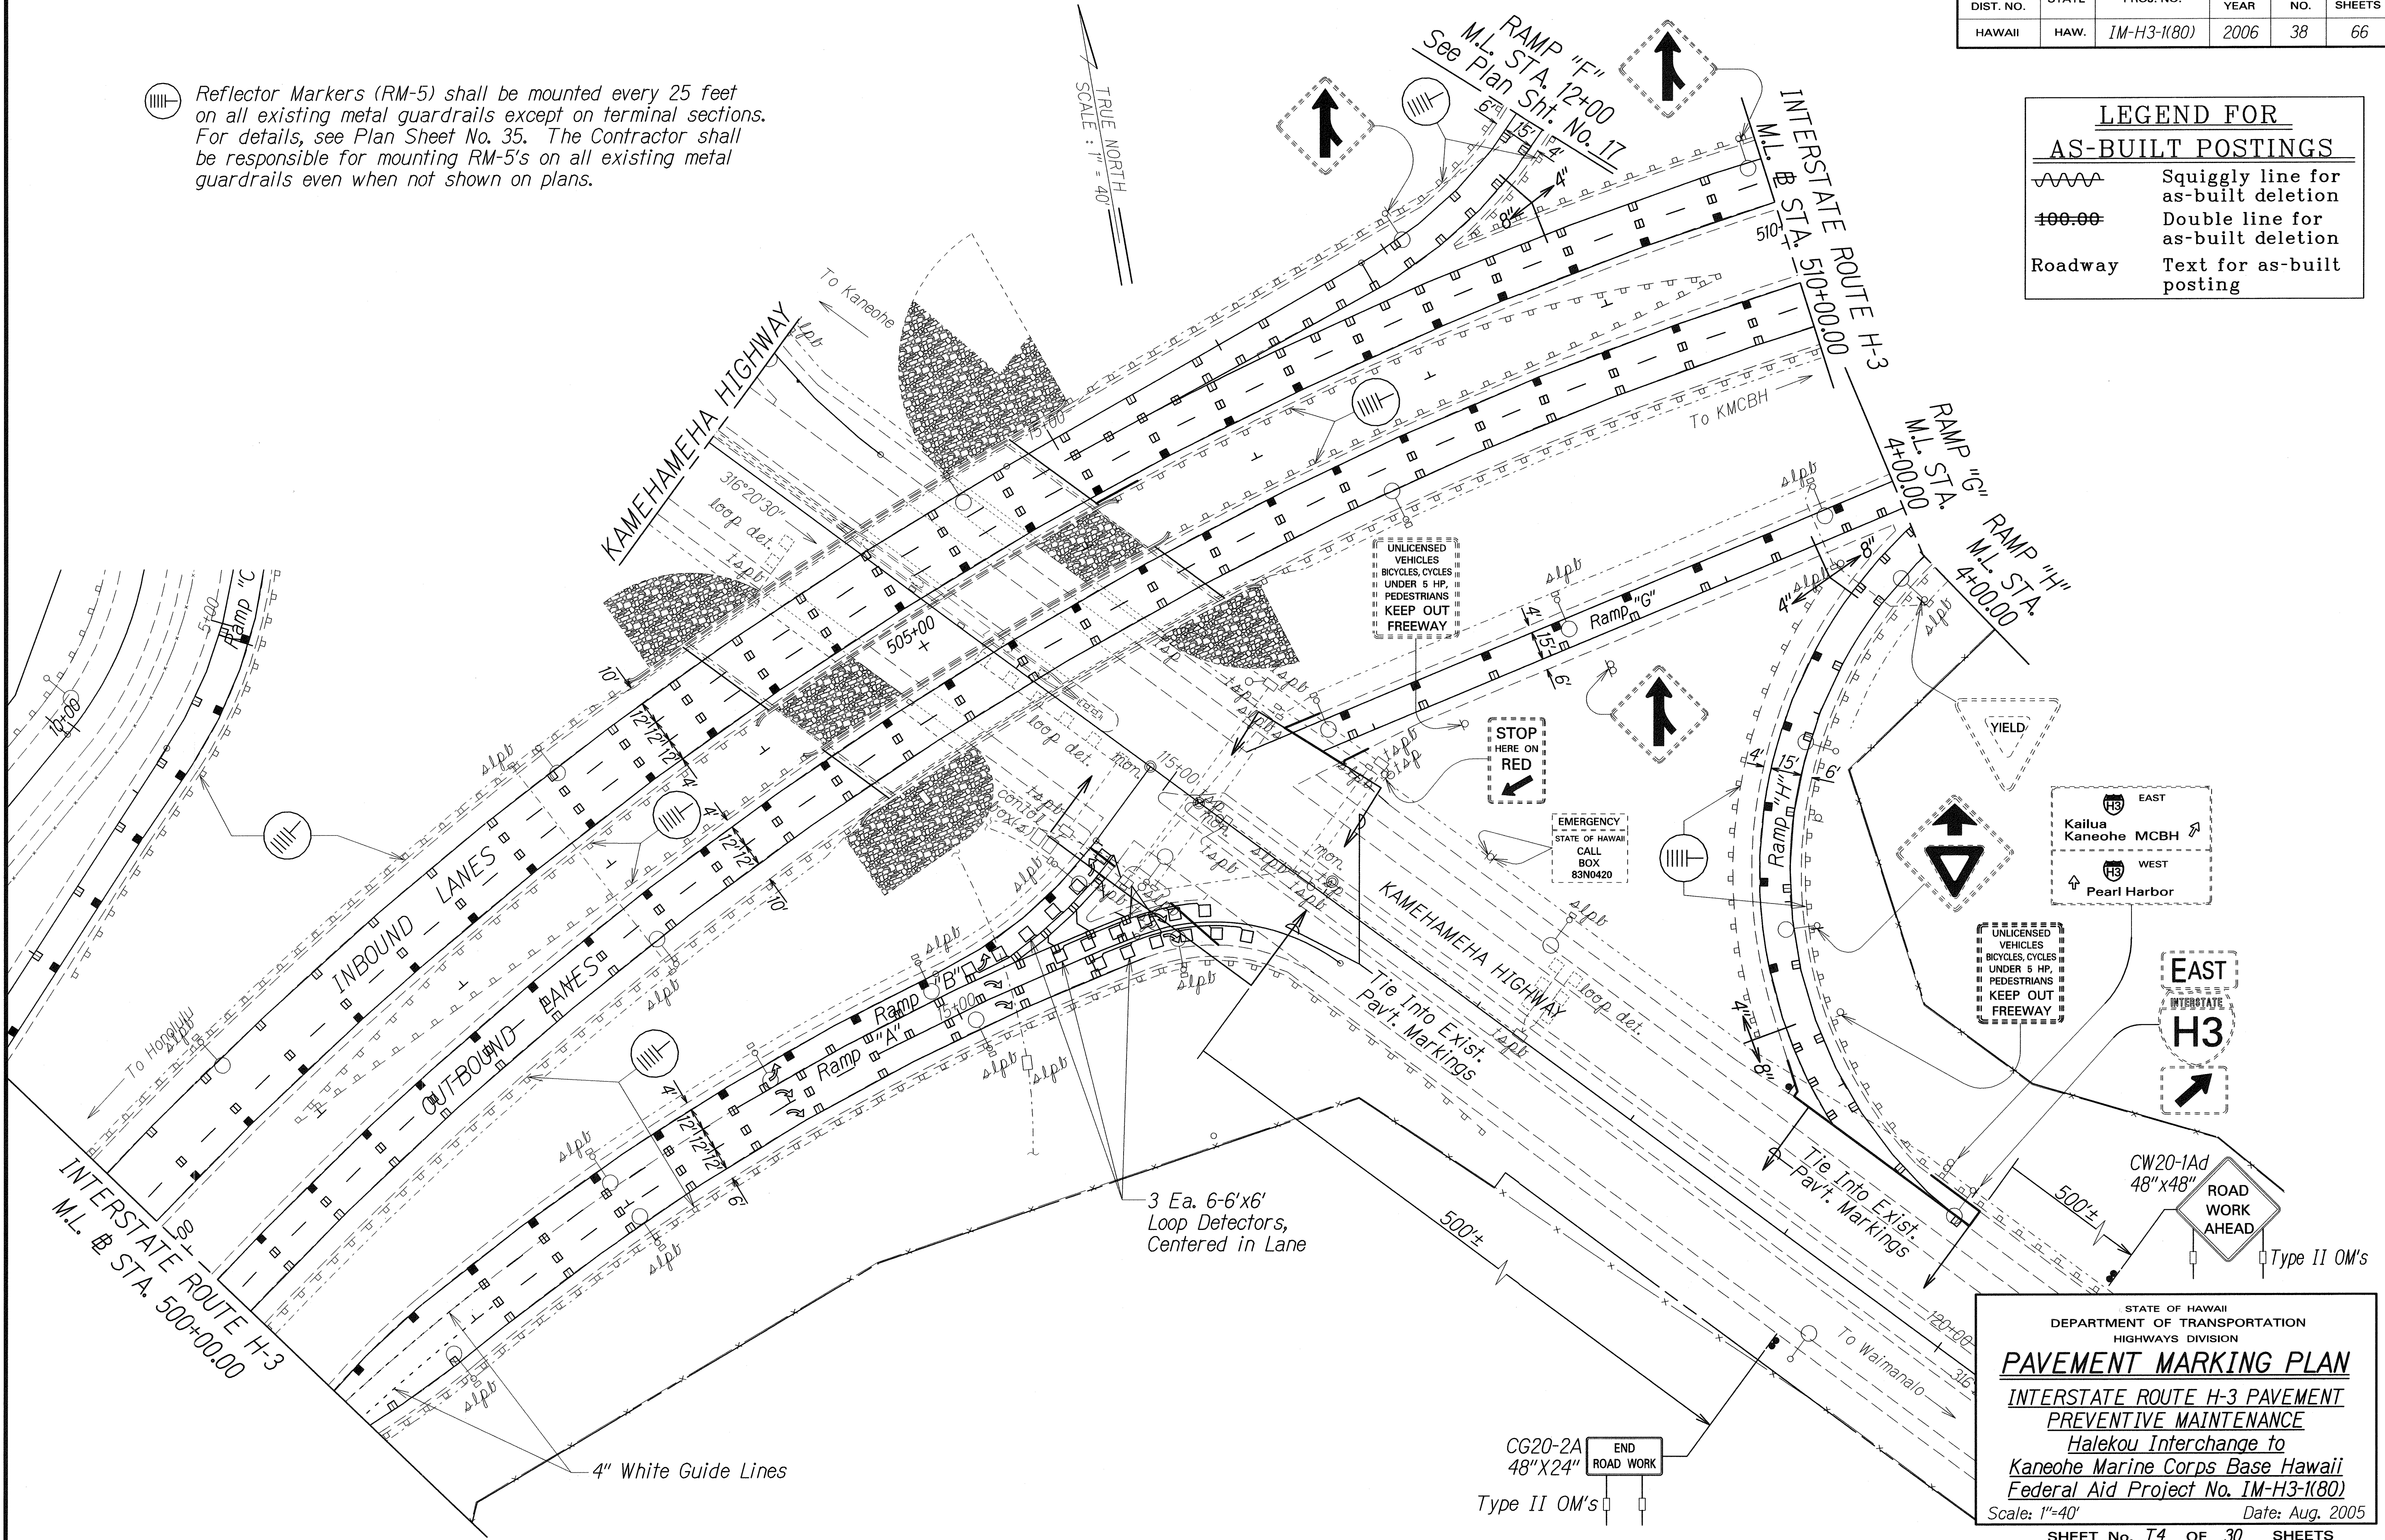

ORIGINAL PLAN	SURVEY PLOTTED BY	DATE
NOTED BOOK	DRAWN BY	
DESIGNED BY	TRACED BY	
CHECKED BY	DESIGNED BY	
	CHECKED BY	


STATE OF HAWAII
DEPARTMENT OF TRANSPORTATION
HIGHWAYS DIVISION

PAVEMENT MARKING PLAN
INTERSTATE ROUTE H-3 PAVEMENT PREVENTIVE MAINTENANCE
Halekou Interchange to Kaneohe Marine Corps Base Hawaii
Federal Aid Project No. IM-H3-1(80)
Scale: 1"=40'
Date: Aug. 2005

SHEET No. 74 OF 30 SHEETS

"AS-BUILT"


FED. ROAD DIST. NO.	STATE	FED. AID PROJ. NO.	FISCAL YEAR	SHEET NO.	TOTAL SHEETS
HAWAII	HAW.	IM-H3-1(80)	2006	39	66

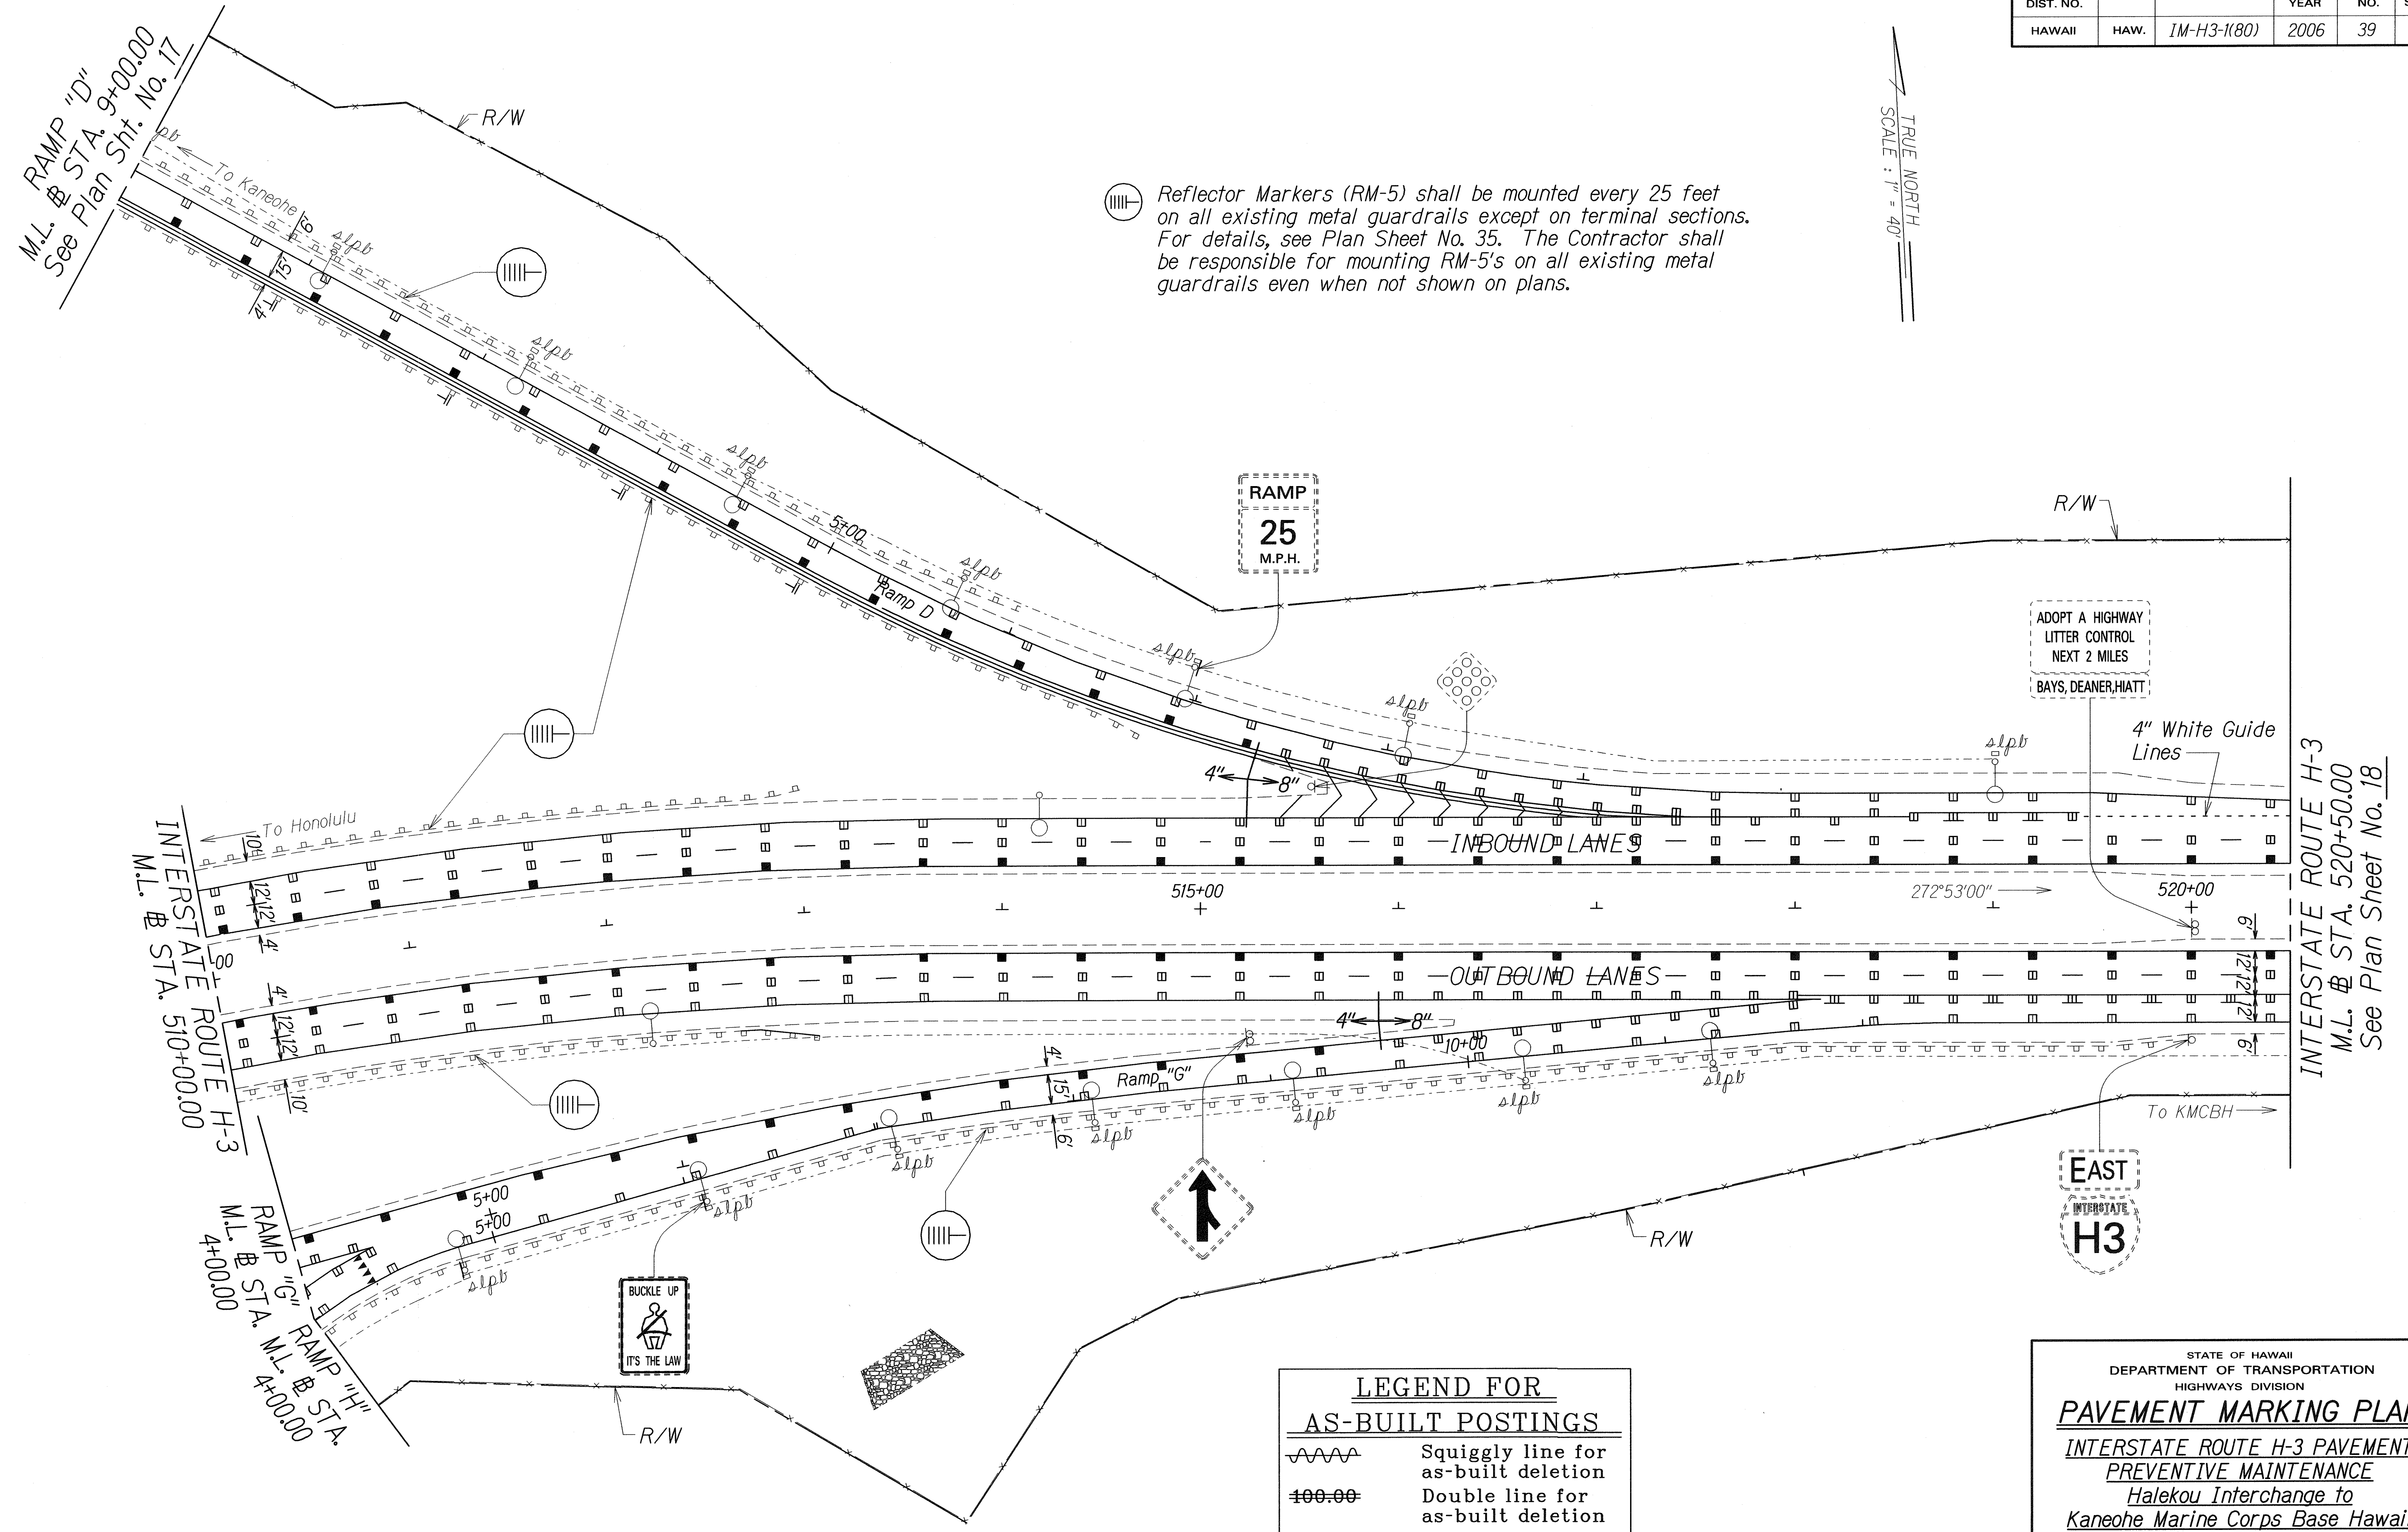

ORIGINAL PLAN	SURVEY PLOTTED BY	DATE
NOTED	DRAWN BY	
DESIGNED BY	TRACED BY	
CHECKED BY	CHECKED BY	
4/13/2003		

"AS-BUILT"

FED. ROAD DIST. NO.	STATE	FED. AID PROJ. NO.	FISCAL YEAR	SHEET NO.	TOTAL SHEETS
HAWAII	HAW.	IM-H3-1(80)	2006	40	66

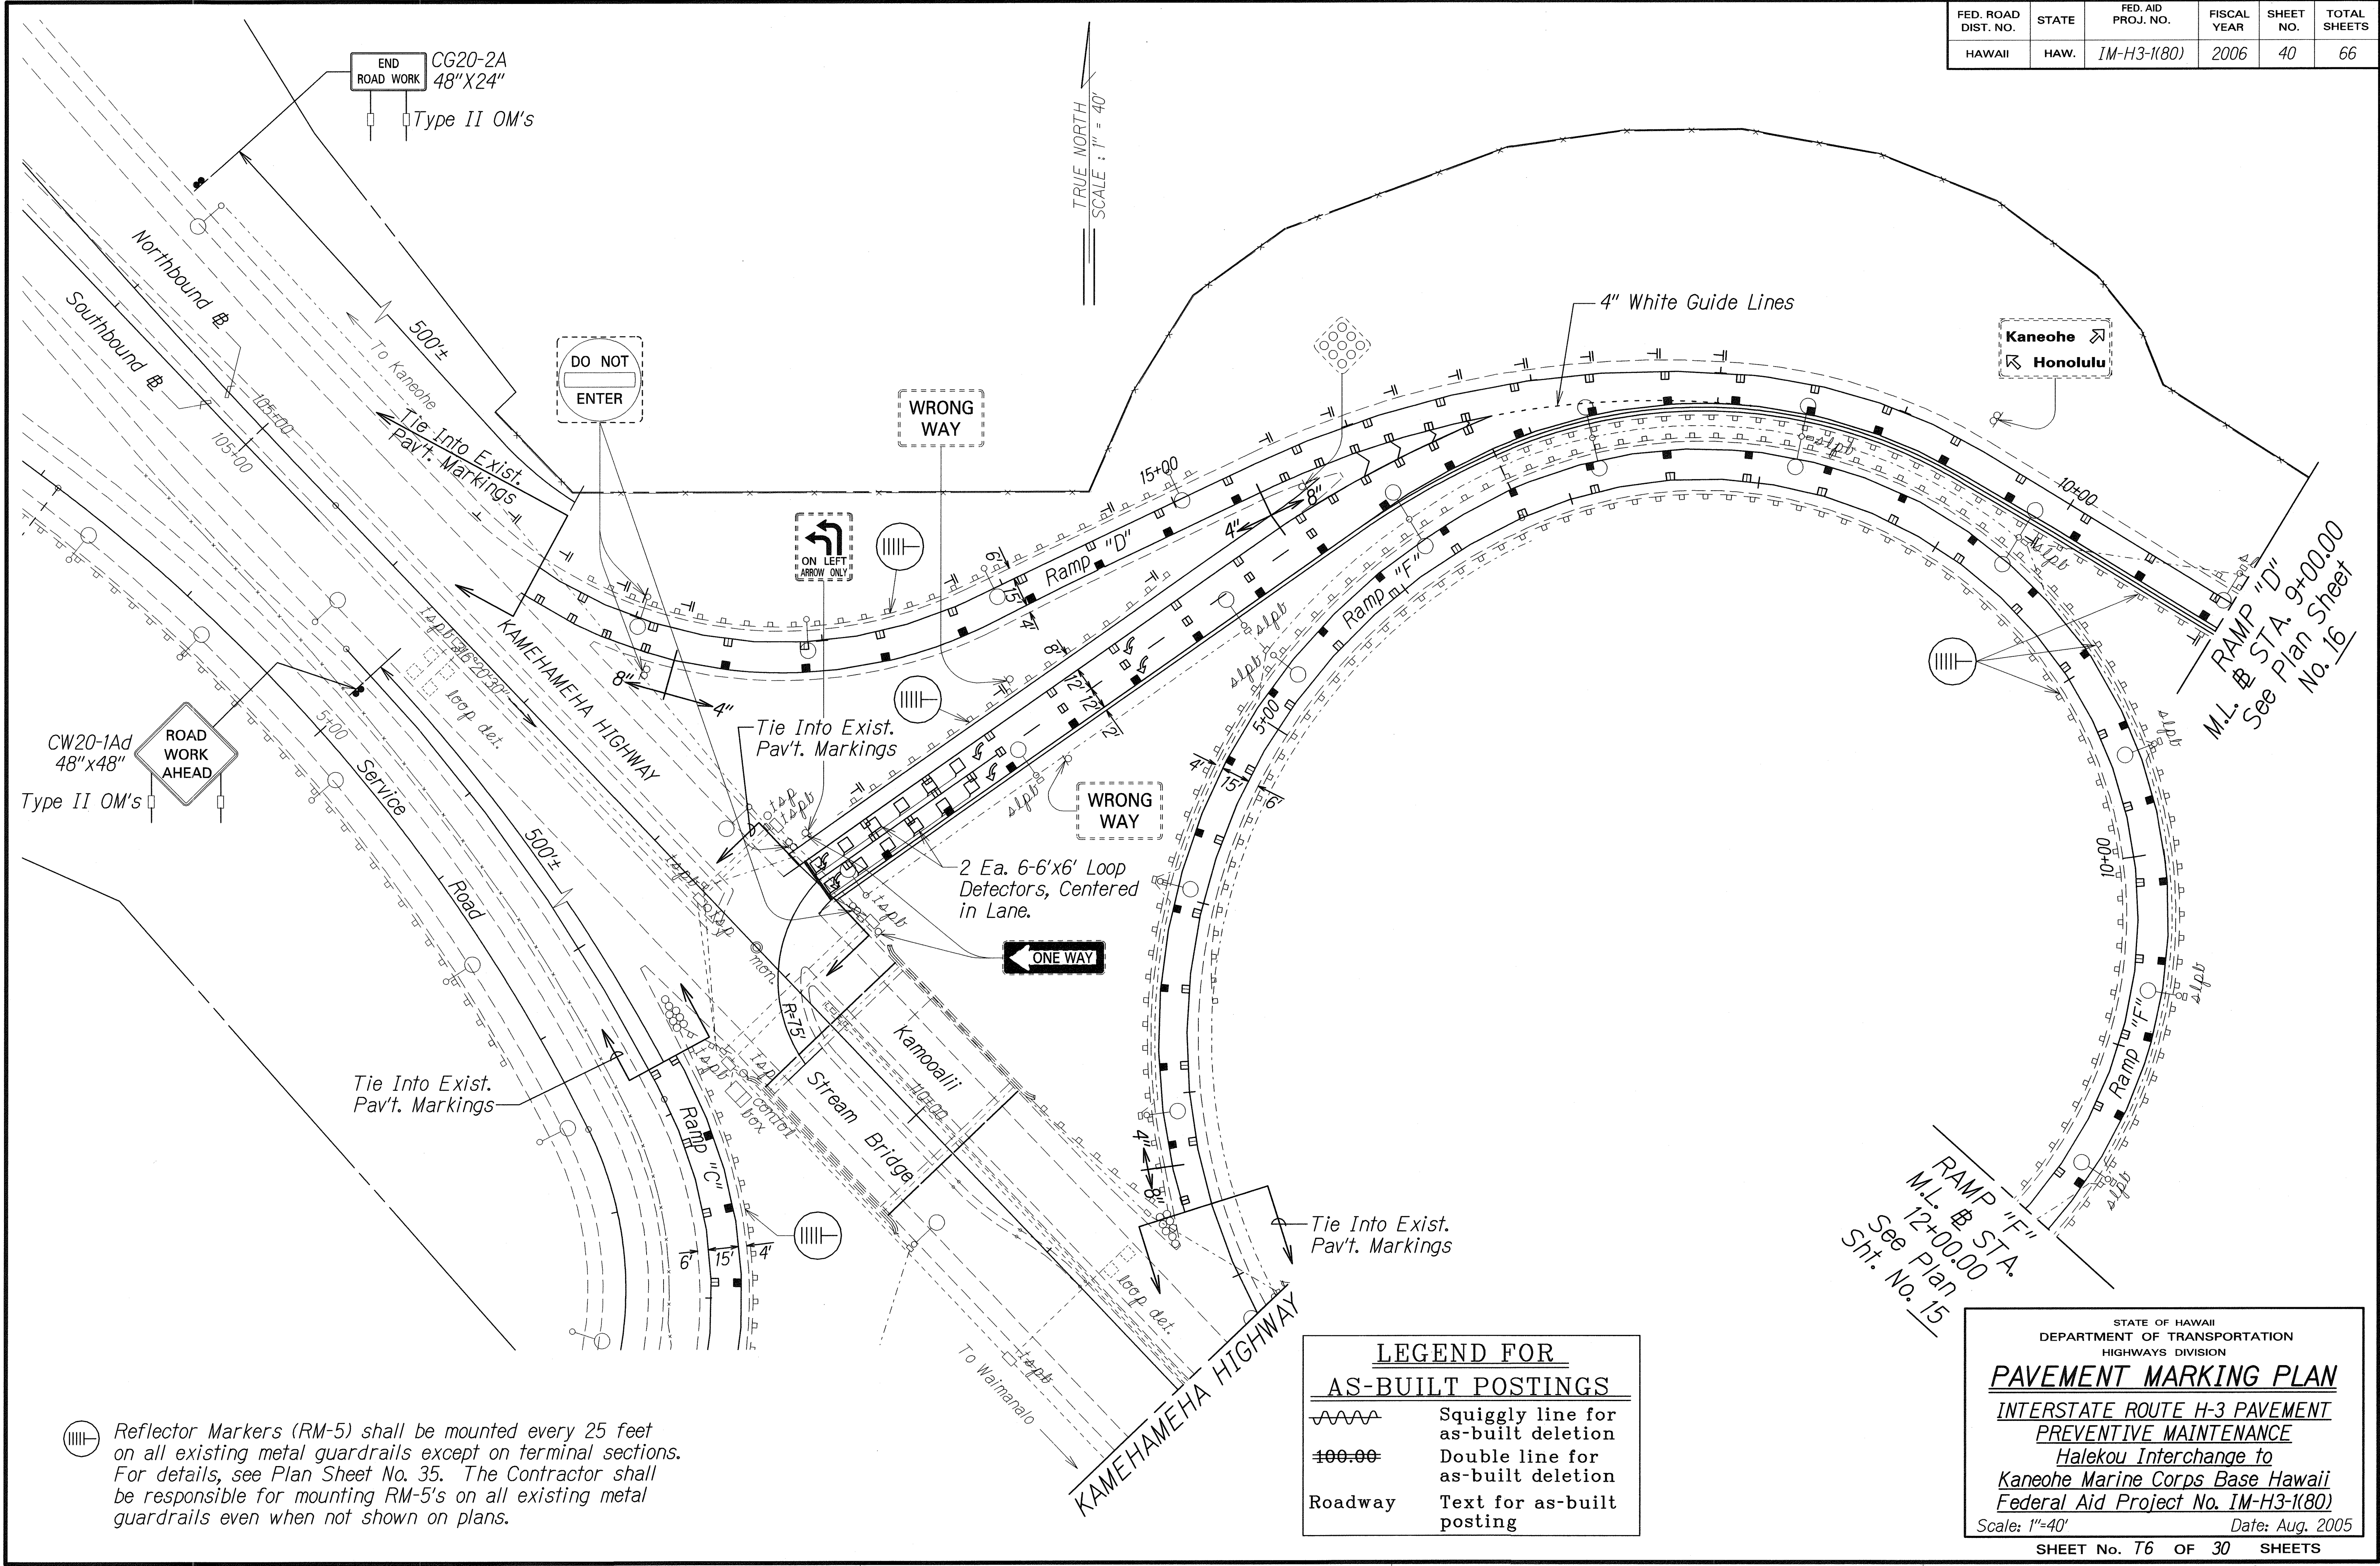

ORIGINAL PLAN	SURVEY PLOTTED BY	DATE
NOTE BOOK	DRAWN BY	
REVISIONS	TRACED BY	
NO. 41131004	DESIGNED BY	
	CHECKED BY	

Reflector Markers (RM-5) shall be mounted every 25 feet on all existing metal guardrails except on terminal sections. For details, see Plan Sheet No. 35. The Contractor shall be responsible for mounting RM-5's on all existing metal guardrails even when not shown on plans.

LEGEND FOR AS-BUILT POSTINGS	
	Squiggly line for as-built deletion
	Double line for as-built deletion
Roadway	Text for as-built posting

STATE OF HAWAII
 DEPARTMENT OF TRANSPORTATION
 HIGHWAYS DIVISION


PAVEMENT MARKING PLAN
 INTERSTATE ROUTE H-3 PAVEMENT
 PREVENTIVE MAINTENANCE
 Halekou Interchange to
 Kaneohe Marine Corps Base Hawaii
 Federal Aid Project No. IM-H3-1(80)
 Scale: 1"=40' Date: Aug. 2005

SHEET No. 76 OF 30 SHEETS

FED. ROAD DIST. NO.	STATE	FED. AID PROJ. NO.	FISCAL YEAR	SHEET NO.	TOTAL SHEETS
HAWAII	HAW.	IM-H3-1(80)	2006	41	66

INTERSTATE ROUTE H-3
M.L. & STA. 520+50.00
See Plan Sht. No. 16

ORIGINAL PLAN	SURVEY PLOTTED BY	DATE
NOTED BOOK	DRAWN BY	
DESIGNED BY	TRACED BY	
CHECKED BY	CHECKED BY	

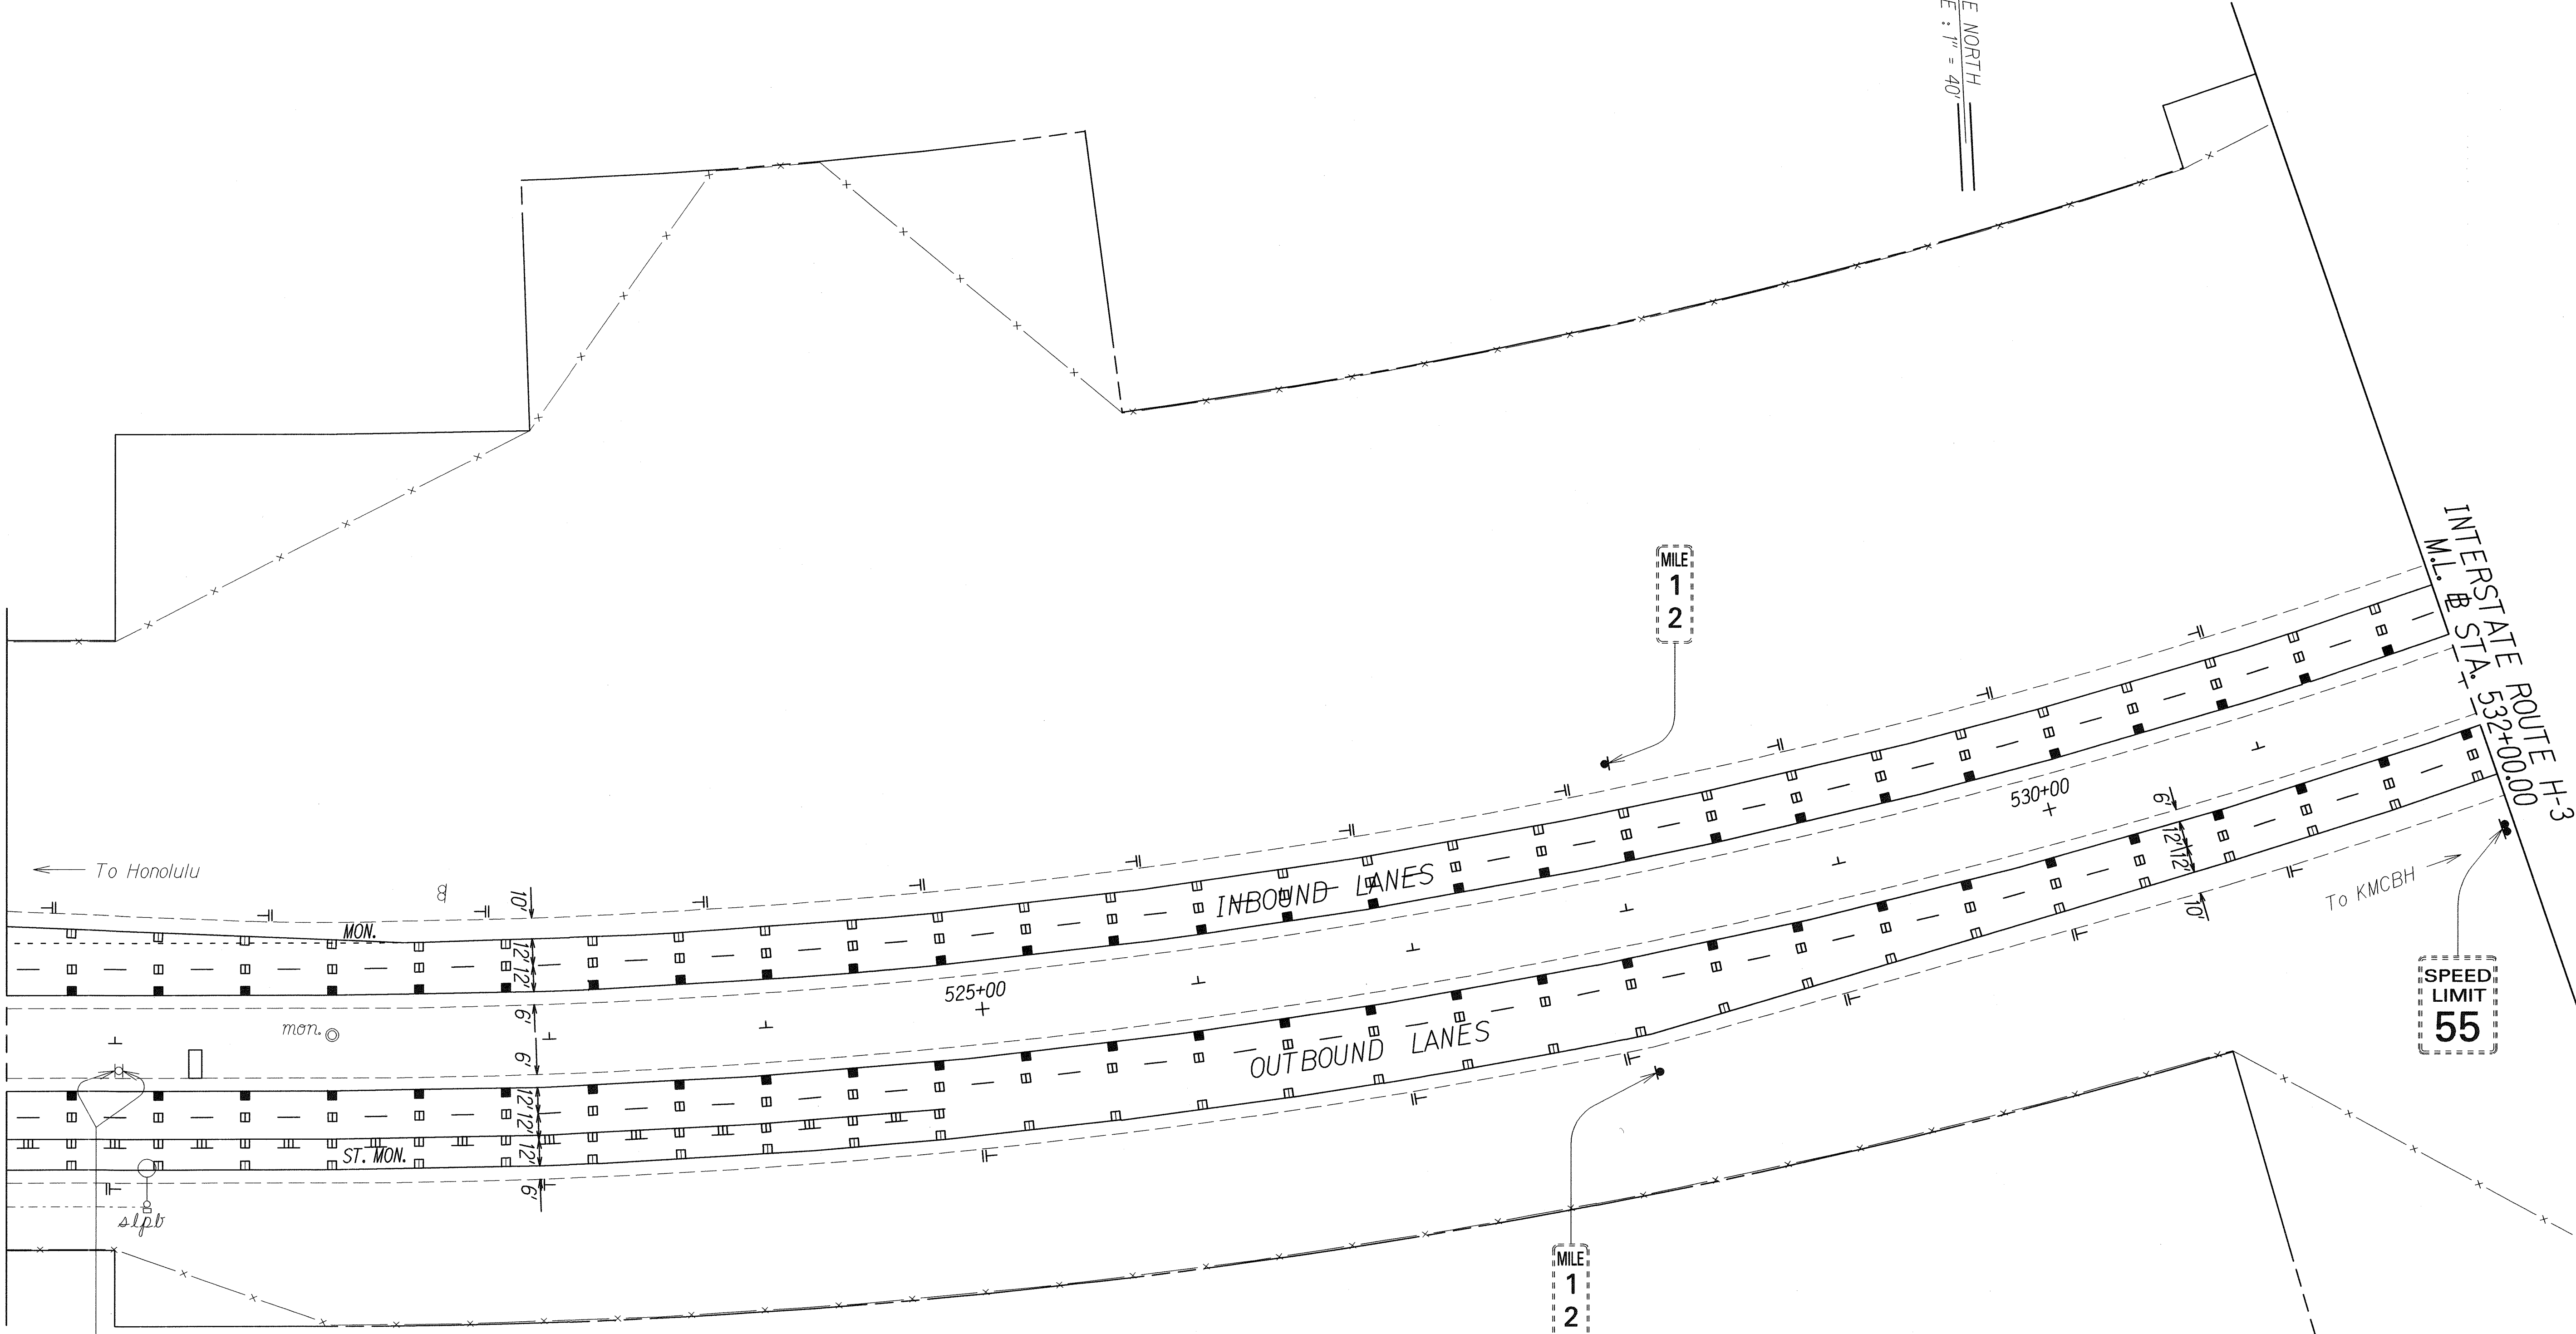

EMERGENCY
STATE OF HAWAII
CALL
BOX
H3E01120

⊙ Reflecter Markers (RM-5) shall be mounted every 25 feet on all existing metal guardrails except on terminal sections. For details, see Plan Sheet No. 35. The Contractor shall be responsible for mounting RM-5's on all existing metal guardrails even when not shown on plans.

LEGEND FOR AS-BUILT POSTINGS	
	Squiggly line for as-built deletion
	Double line for as-built deletion
Roadway	Text for as-built posting

STATE OF HAWAII
DEPARTMENT OF TRANSPORTATION
HIGHWAYS DIVISION


PAVEMENT MARKING PLAN
INTERSTATE ROUTE H-3 PAVEMENT
PREVENTIVE MAINTENANCE
Halekou Interchange to
Kaneohe Marine Corps Base Hawaii
Federal Aid Project No. IM-H3-1(80)
Scale: 1"=40'
Date: Aug. 2005

SHEET No. 77 OF 30 SHEETS

FED. ROAD DIST. NO.	STATE	FED. AID PROJ. NO.	FISCAL YEAR	SHEET NO.	TOTAL SHEETS
HAWAII	HAW.	IM-H3-1(80)	2006	42	66

⦶ Reflecter Markers (RM-5) shall be mounted every 25 feet on all existing metal guardrails except on terminal sections. For details, see Plan Sheet No. 35. The Contractor shall be responsible for mounting RM-5's on all existing metal guardrails even when not shown on plans.

TRUE NORTH
SCALE: 1" = 40'

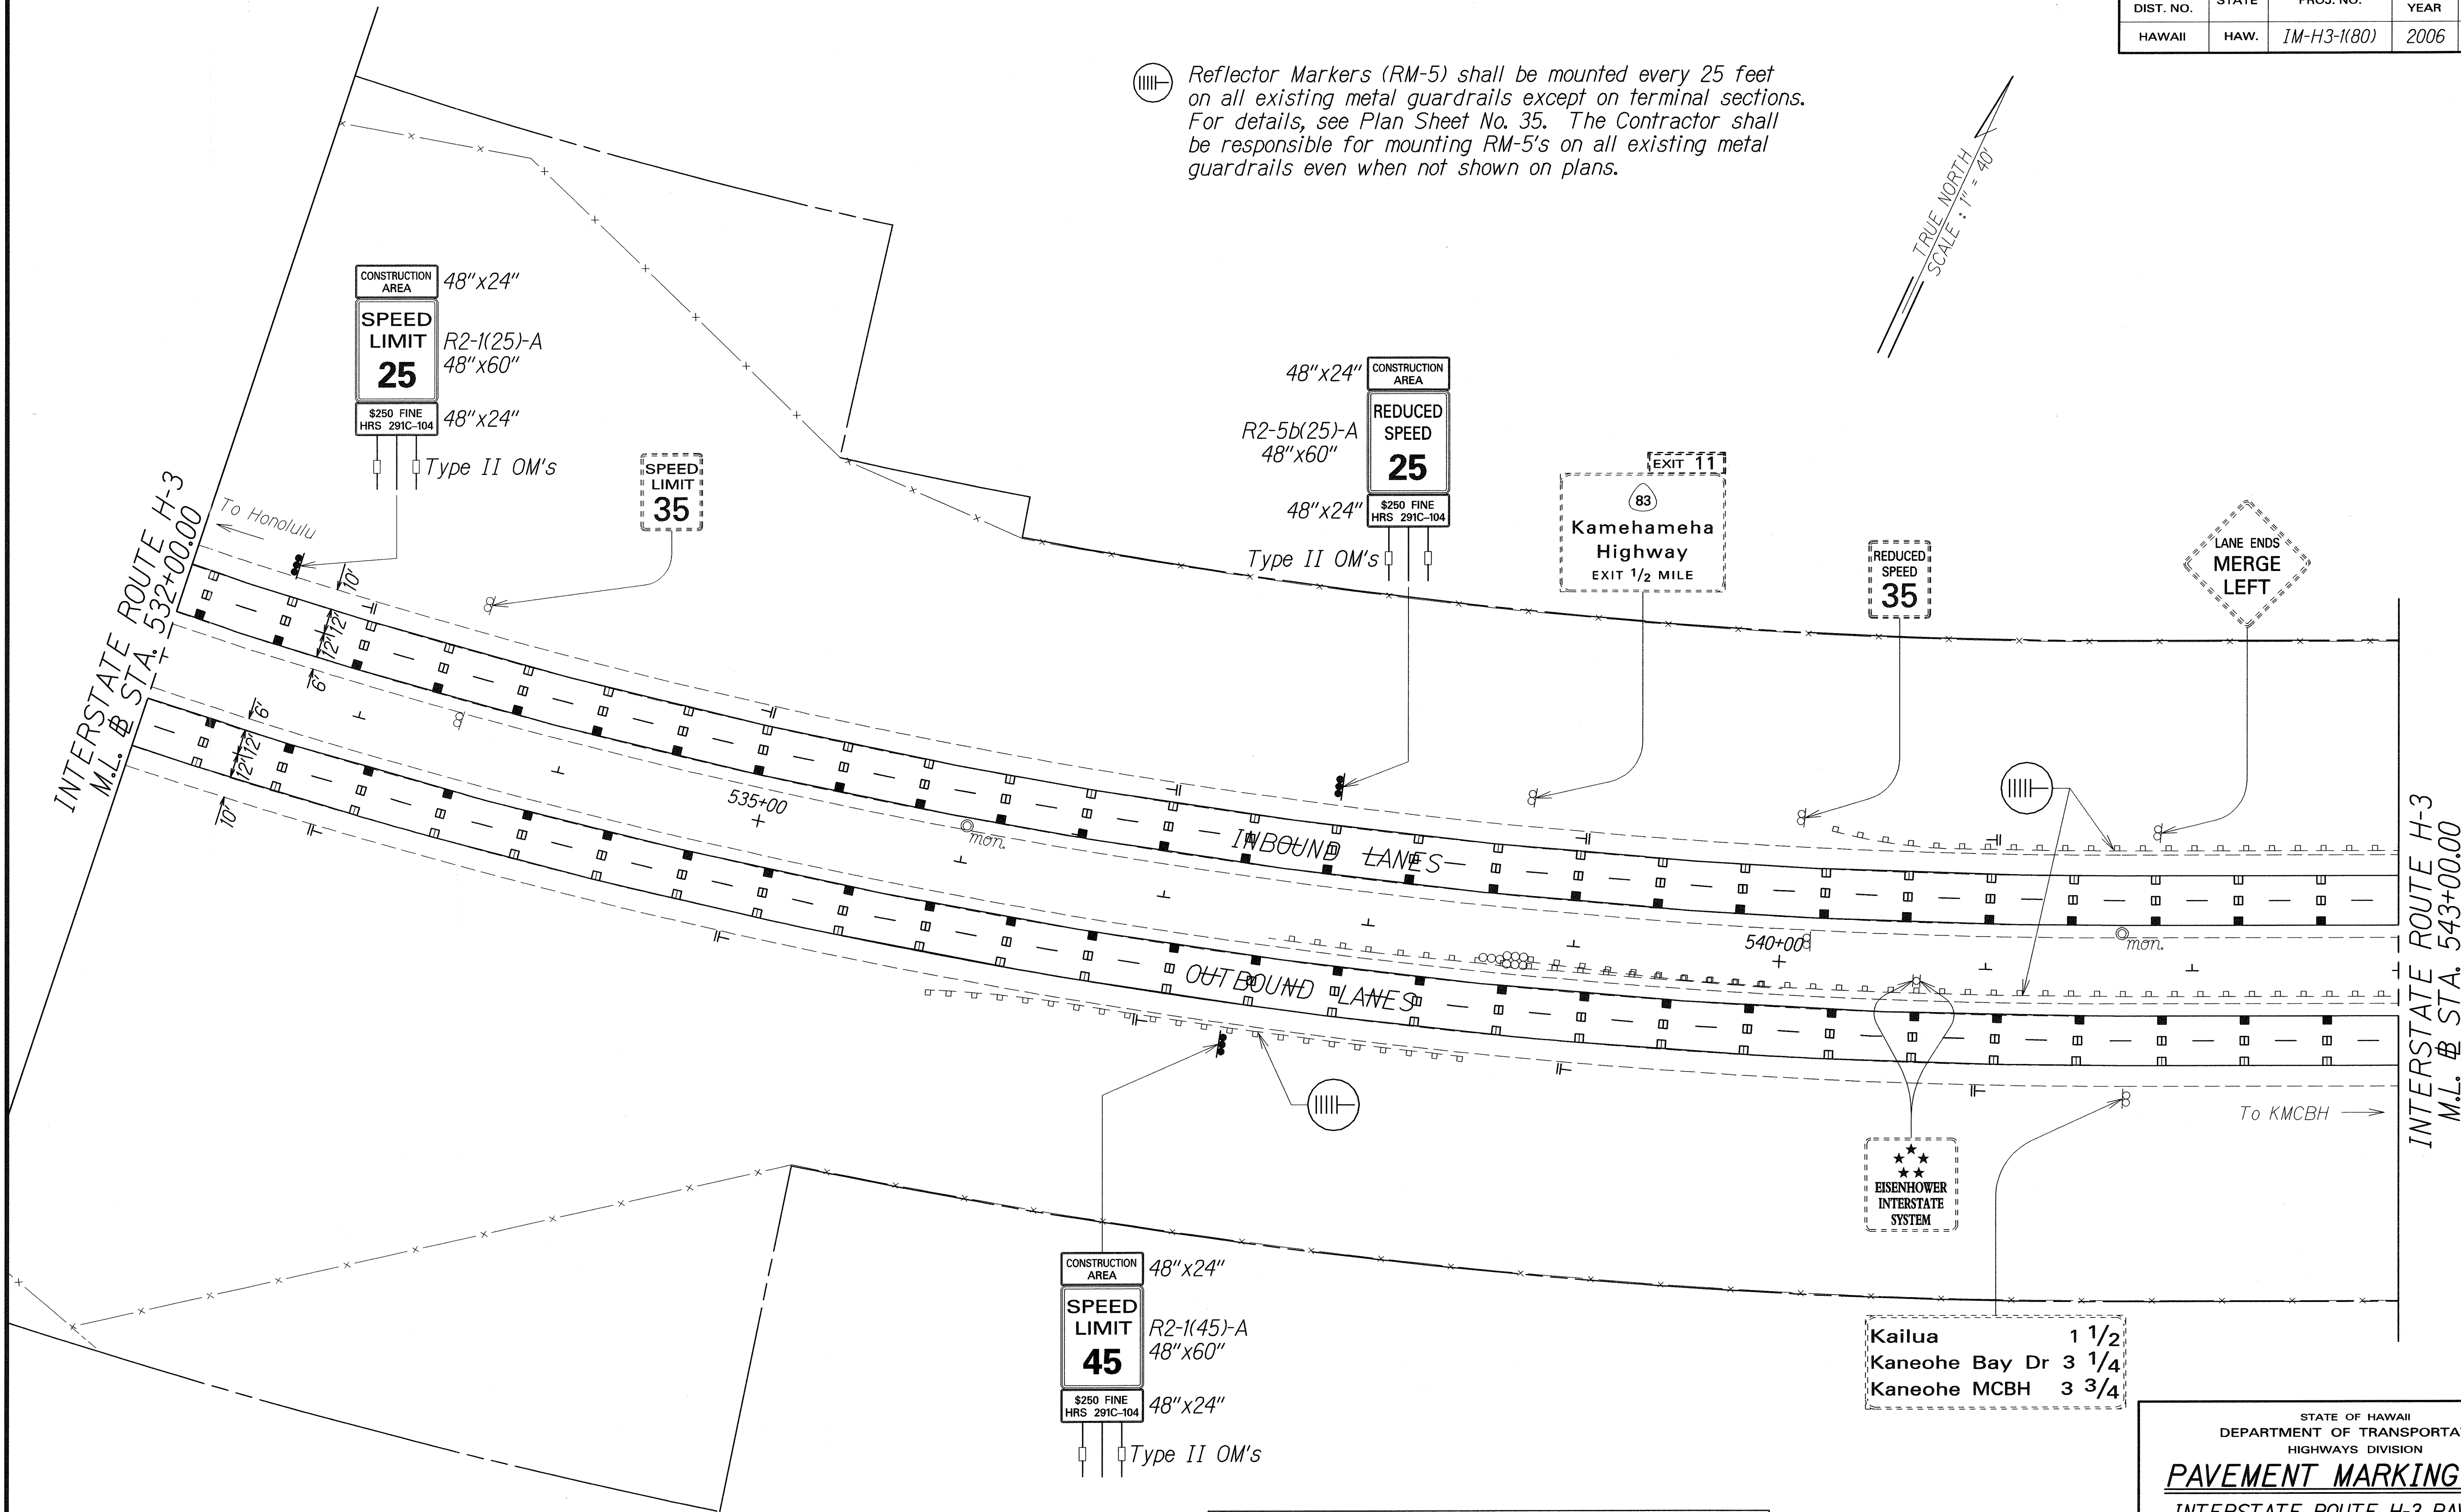

ORIGINAL PLAN	SURVEY PLOTTED BY	DATE
NOTED	DRAWN BY	
DESIGNED BY	CHECKED BY	
DATE		

LEGEND FOR AS-BUILT POSTINGS	
	Squiggly line for as-built deletion
	Double line for as-built deletion
Roadway	Text for as-built posting


STATE OF HAWAII
DEPARTMENT OF TRANSPORTATION
HIGHWAYS DIVISION

PAVEMENT MARKING PLAN
INTERSTATE ROUTE H-3 PAVEMENT
PREVENTIVE MAINTENANCE
Halekou Interchange to
Kaneohe Marine Corps Base Hawaii
Federal Aid Project No. IM-H3-1(80)
Scale: 1"=40' Date: Aug. 2005

SHEET No. 78 OF 30 SHEETS

FED. ROAD DIST. NO.	STATE	FED. AID PROJ. NO.	FISCAL YEAR	SHEET NO.	TOTAL SHEETS
HAWAII	HAW.	IM-H3-1(80)	2006	43	66

⦶ Reflecter Markers (RM-5) shall be mounted every 25 feet on all existing metal guardrails except on terminal sections. For details, see Plan Sheet No. 35. The Contractor shall be responsible for mounting RM-5's on all existing metal guardrails even when not shown on plans.

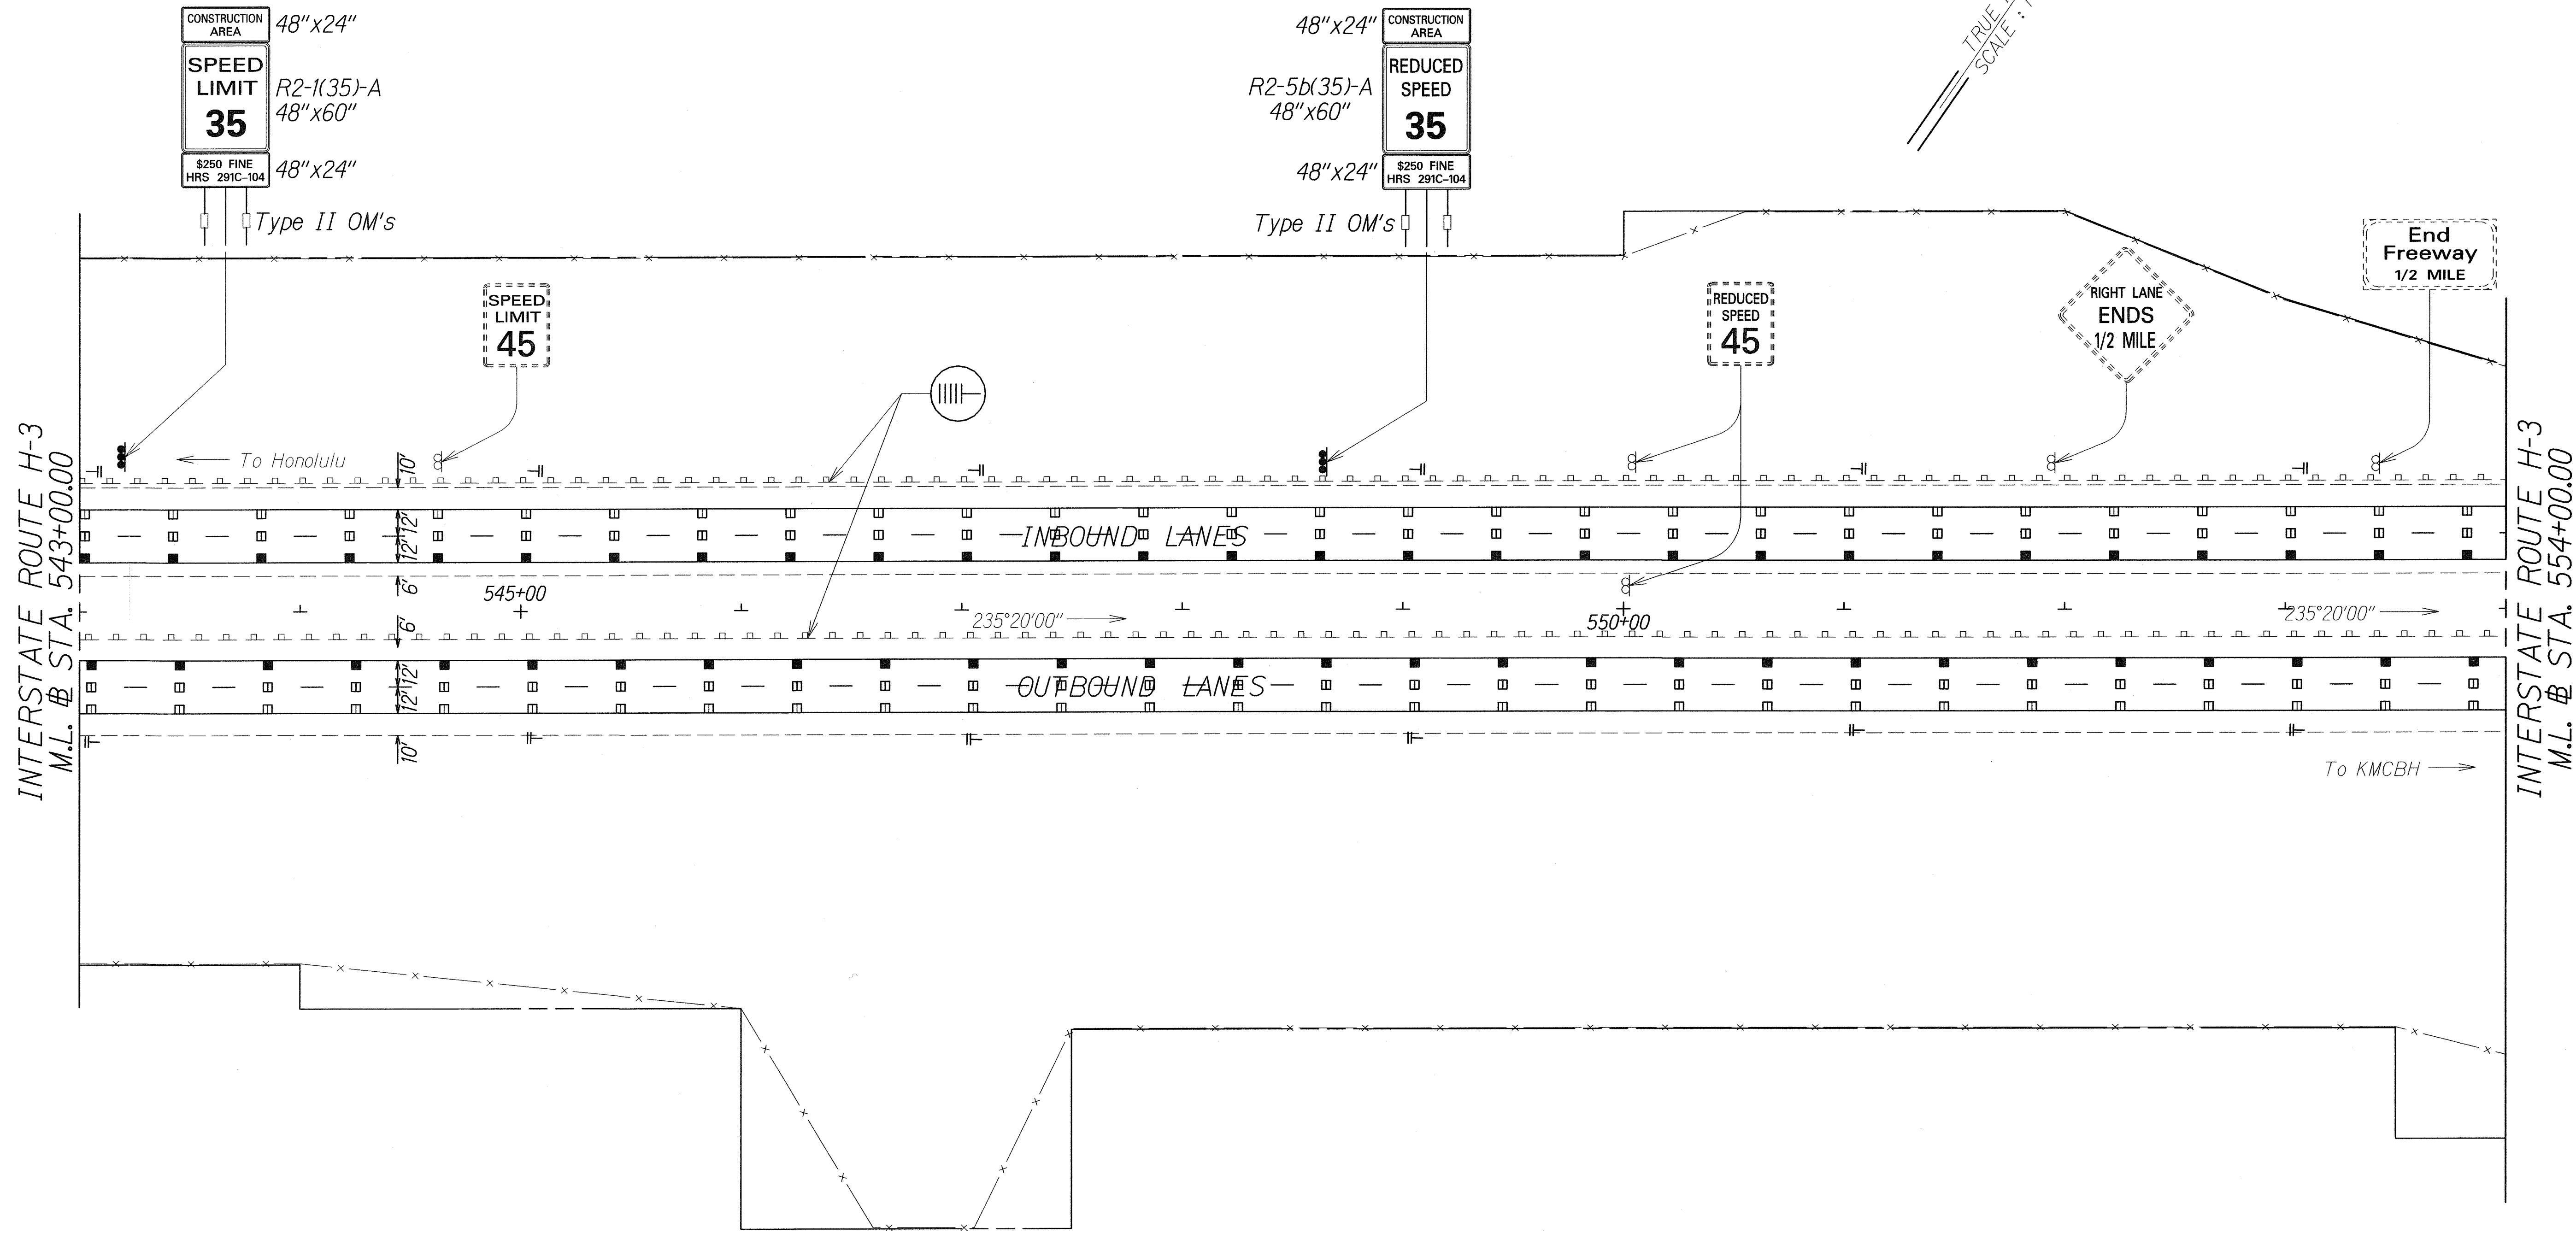

ORIGINAL PLAN	SURVEY PLOTTED BY	DATE
NOTED	DRAWN BY	
DESIGNED BY		
CHECKED BY		

LEGEND FOR AS-BUILT POSTINGS	
	Squiggly line for as-built deletion
	Double line for as-built deletion
Roadway	Text for as-built posting

STATE OF HAWAII
DEPARTMENT OF TRANSPORTATION
HIGHWAYS DIVISION

PAVEMENT MARKING PLAN
INTERSTATE ROUTE H-3 PAVEMENT PREVENTIVE MAINTENANCE
Halekou Interchange to Kaneohe Marine Corps Base Hawaii
Federal Aid Project No. IM-H3-1(80)
Scale: 1"=40' Date: Aug. 2005

SHEET No. 79 OF 27 SHEETS

"AS-BUILT"

FED. ROAD DIST. NO.	STATE	FED. AID PROJ. NO.	FISCAL YEAR	SHEET NO.	TOTAL SHEETS
HAWAII	HAW.	IM-H3-1(80)	2006	44	66

 Reflector Markers (RM-5) shall be mounted every 25 feet on all existing metal guardrails except on terminal sections. For details, see Plan Sheet No. 35. The Contractor shall be responsible for mounting RM-5's on all existing metal guardrails even when not shown on plans.

TRUE NORTH
 SCALE: 1" = 40'

EXIT 11
 83
 Kamehameha Highway
 EXIT 1 MILE

Quarry Access Road "A-1"

INTERSTATE ROUTE H-3
 M.L. @ STA. 565+50.00

To KMCBH

Kapaa Quarry
 Separation
 Structure No. 2

EMERGENCY
 STATE OF HAWAII
 CALL
 BOX
 H3W0126

INTERSTATE ROUTE H-3
 M.L. @ STA. 554+00.00



To Honolulu

INBOUND LANES

OUTBOUND LANES

ORIGINAL PLAN	SURVEY PLOTTED BY	DATE
NOTED	DRAWN BY	
DESIGNED BY	TRACED BY	
CHECKED BY	DESIGNED BY	
NO. 41031003		

LEGEND FOR AS-BUILT POSTINGS

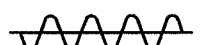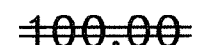-  Squiggly line for as-built deletion
-  Double line for as-built deletion
- Roadway Text for as-built posting

STATE OF HAWAII
 DEPARTMENT OF TRANSPORTATION
 HIGHWAYS DIVISION



PAVEMENT MARKING PLAN
 INTERSTATE ROUTE H-3 PAVEMENT
 PREVENTIVE MAINTENANCE
 Halekou Interchange to
 Kaneohe Marine Corps Base Hawaii
 Federal Aid Project No. IM-H3-1(80)
 Scale: 1"=40'

Date: Aug. 2005
 SHEET No. 710 OF 30 SHEETS


"AS-BUILT"

FED. ROAD DIST. NO.	STATE	FED. AID PROJ. NO.	FISCAL YEAR	SHEET NO.	TOTAL SHEETS
HAWAII	HAW.	IM-H3-1(80)	2006	45	66

 Reflector Markers (RM-5) shall be mounted every 25 feet on all existing metal guardrails except on terminal sections. For details, see Plan Sheet No. 35. The Contractor shall be responsible for mounting RM-5's on all existing metal guardrails even when not shown on plans.

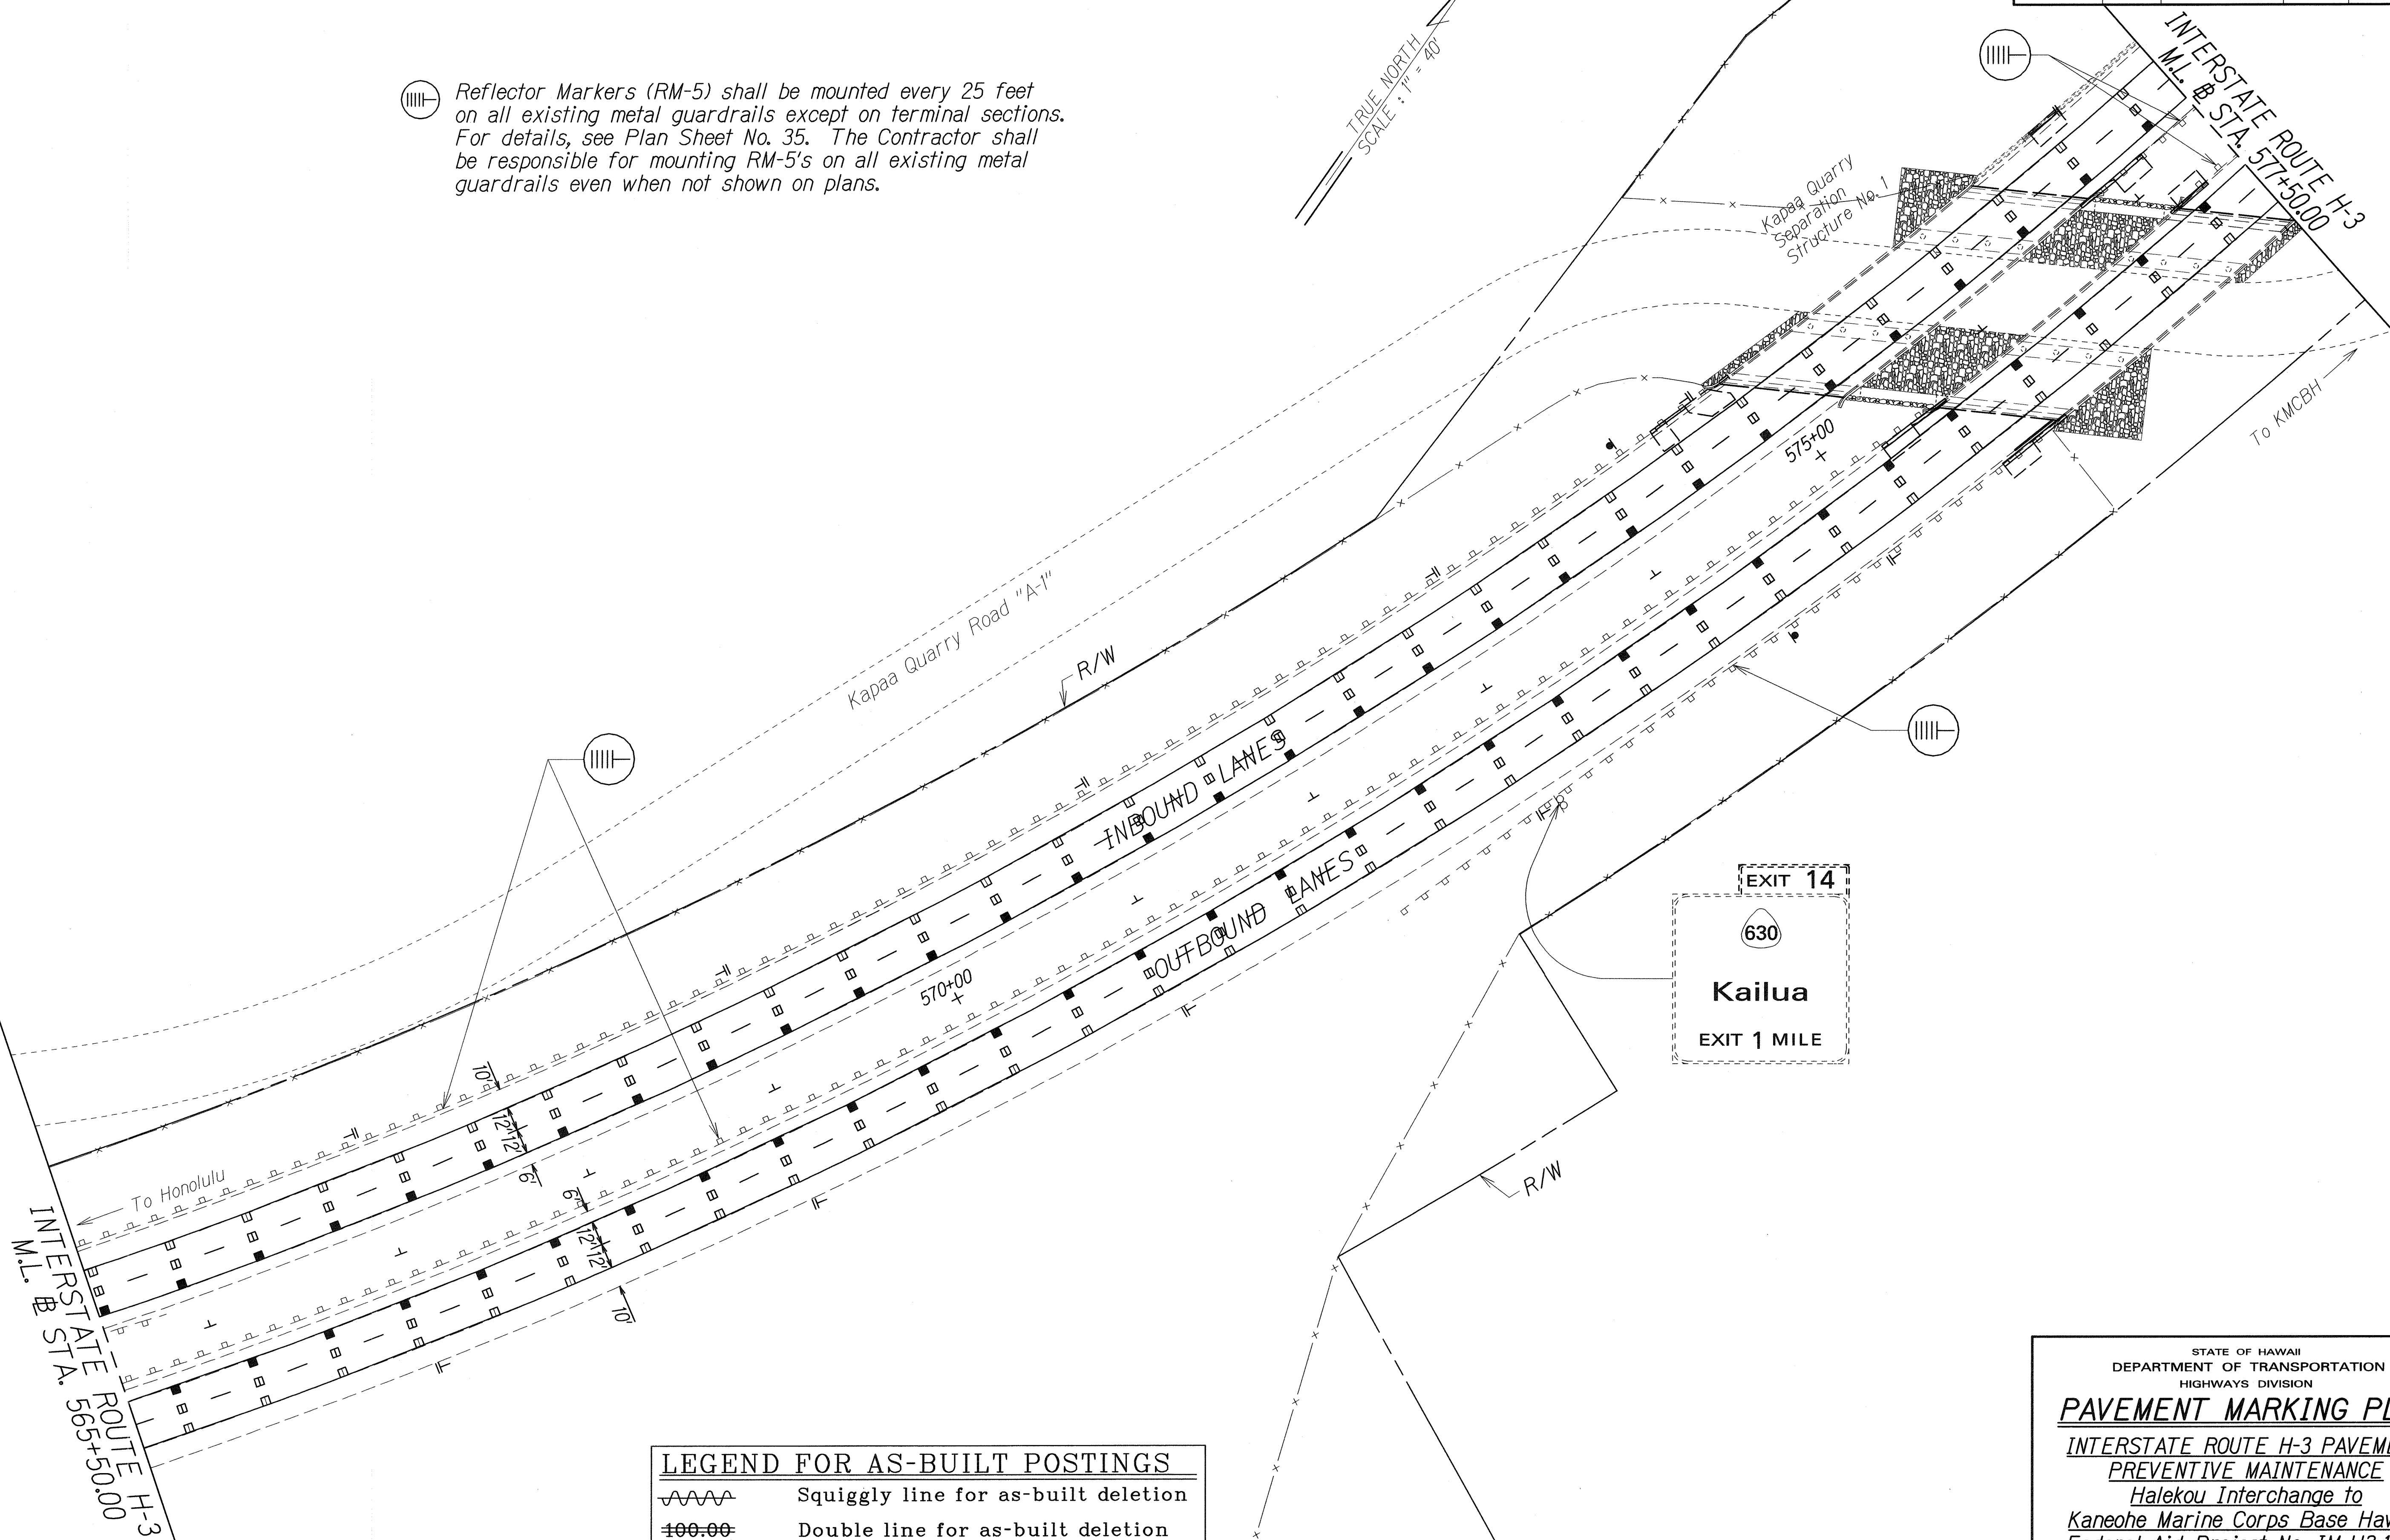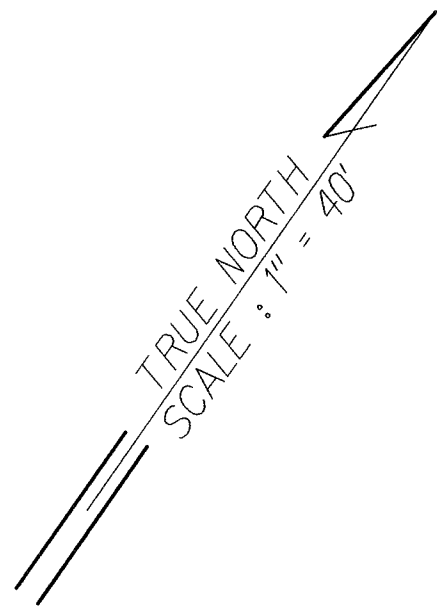

ORIGINAL PLAN	SURVEY PLOTTED BY	DATE
NOTED	DRAWN BY	
DESIGNED BY	TRACED BY	
CHECKED BY	CHECKED BY	
No. 41131003		


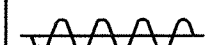
LEGEND FOR AS-BUILT POSTINGS	
	Squiggly line for as-built deletion
	Double line for as-built deletion
Roadway	Text for as-built posting

STATE OF HAWAII
 DEPARTMENT OF TRANSPORTATION
 HIGHWAYS DIVISION



PAVEMENT MARKING PLAN
 INTERSTATE ROUTE H-3 PAVEMENT
 PREVENTIVE MAINTENANCE
 Halekou Interchange to
 Kaneohe Marine Corps Base Hawaii
 Federal Aid Project No. IM-H3-1(80)
 Scale: 1"=40' Date: Aug. 2005
 SHEET No. 711 OF 30 SHEETS

FED. ROAD DIST. NO.	STATE	FED. AID PROJ. NO.	FISCAL YEAR	SHEET NO.	TOTAL SHEETS
HAWAII	HAW.	IM-H3-1(80)	2006	47	66

 Reflector Markers (RM-5) shall be mounted every 25 feet on all existing metal guardrails except on terminal sections. For details, see Plan Sheet No. 35. The Contractor shall be responsible for mounting RM-5's on all existing metal guardrails even when not shown on plans.

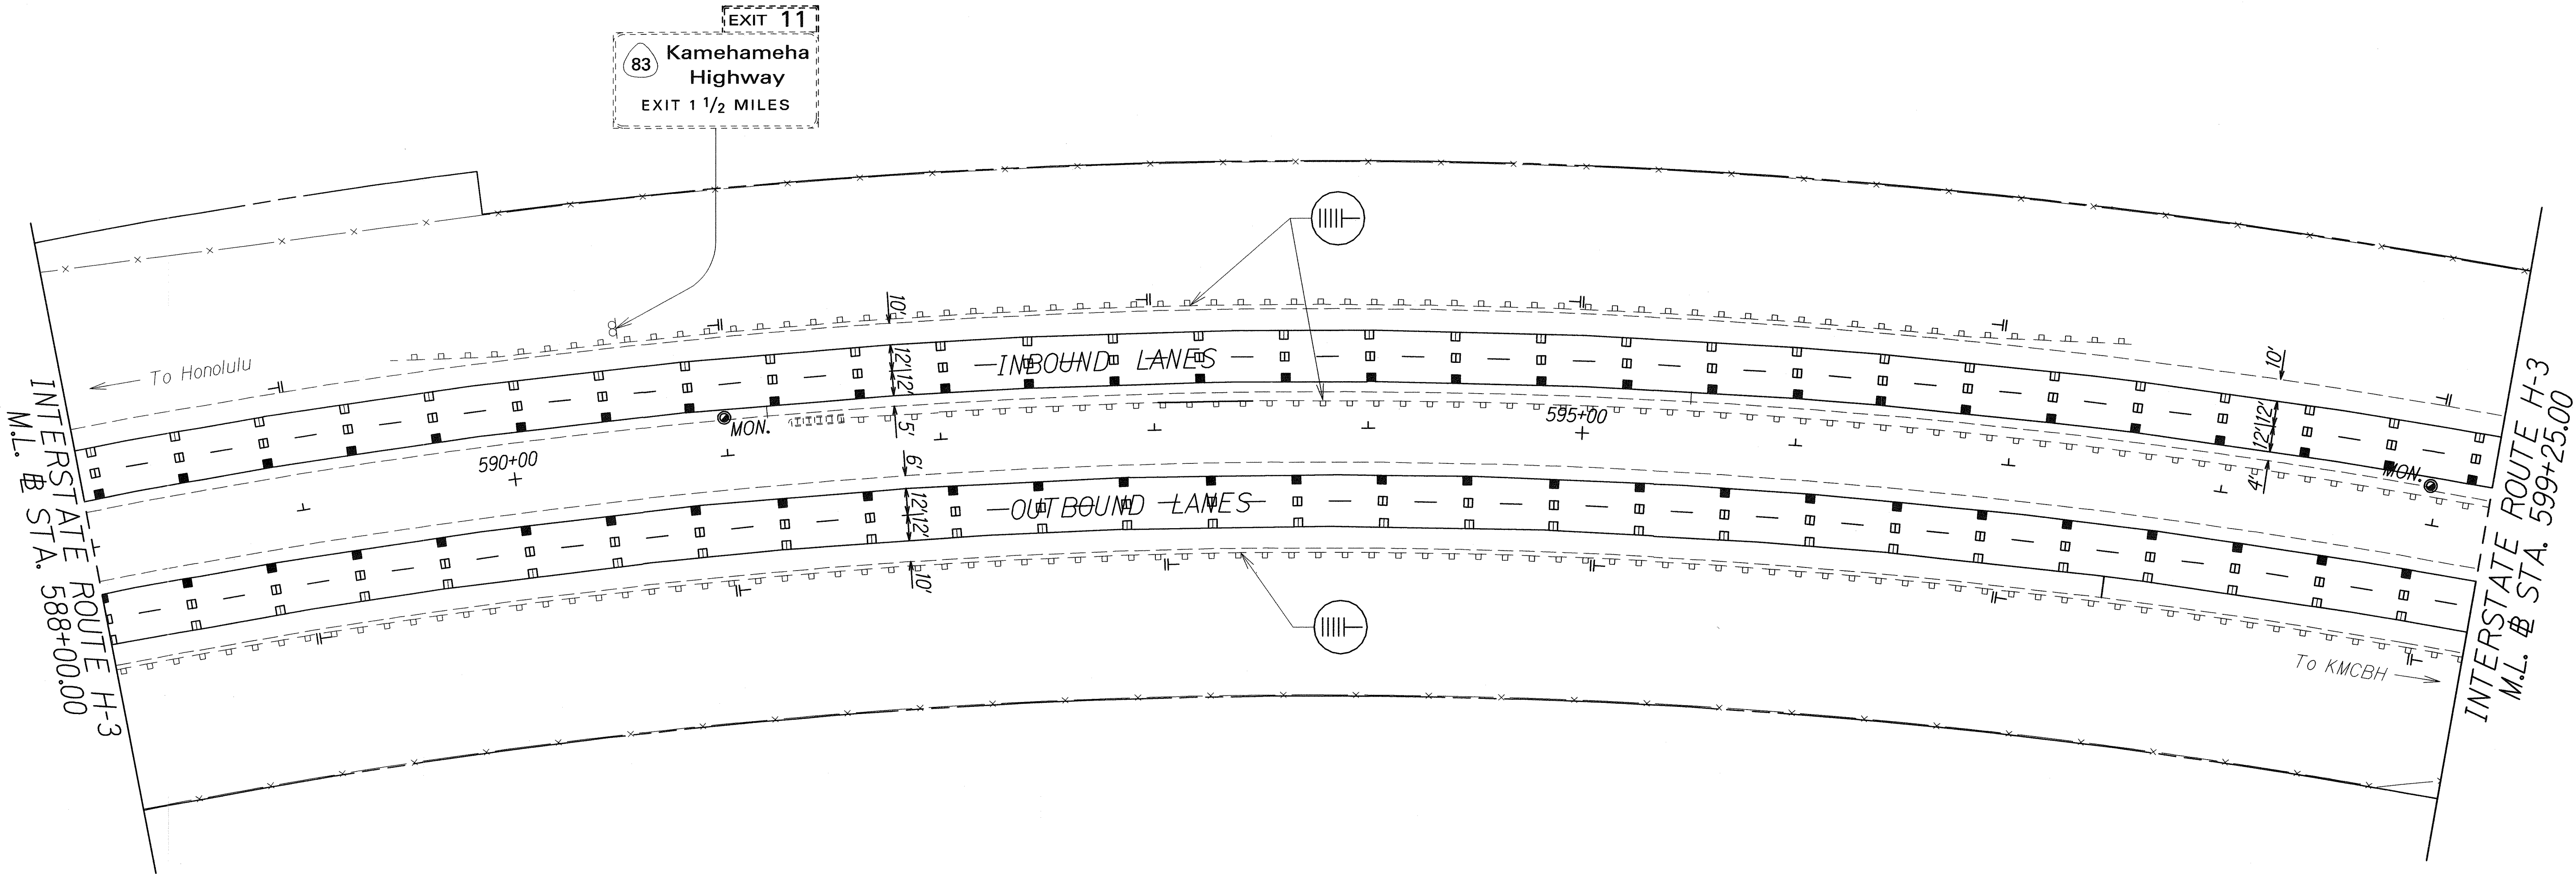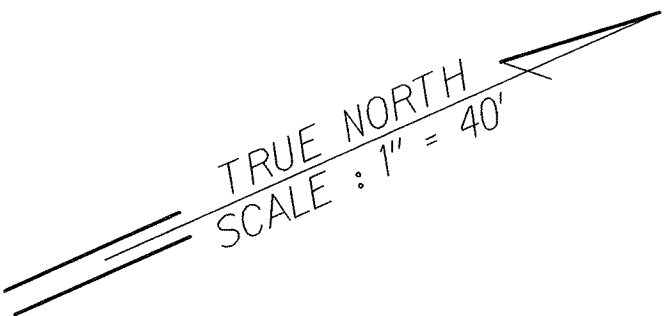

ORIGINAL PLAN	SURVEY PLOTTED BY	DATE
NOTE BOOK	DRAWN BY	
4/1/06	DESIGNED BY	
4/1/06	CHECKED BY	

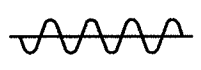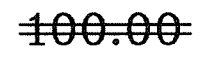LEGEND FOR AS-BUILT POSTINGS	
	Squiggly line for as-built deletion
	Double line for as-built deletion
Roadway	Text for as-built posting

STATE OF HAWAII
 DEPARTMENT OF TRANSPORTATION
 HIGHWAYS DIVISION



PAVEMENT MARKING PLAN
 INTERSTATE ROUTE H-3 PAVEMENT
 PREVENTIVE MAINTENANCE
 Halekou Interchange to
 Kaneohe Marine Corps Base Hawaii
 Federal Aid Project No. IM-H3-1(80)
 Scale: 1"=40'

Date: Aug. 2005
 SHEET No. 713 OF 30 SHEETS

"AS-BUILT"

FED. ROAD DIST. NO.	STATE	FED. AID PROJ. NO.	FISCAL YEAR	SHEET NO.	TOTAL SHEETS
HAWAII	HAW.	IM-H3-1(80)	2006	48	66

 Reflector Markers (RM-5) shall be mounted every 25 feet on all existing metal guardrails except on terminal sections. For details, see Plan Sheet No. 35. The Contractor shall be responsible for mounting RM-5's on all existing metal guardrails even when not shown on plans.

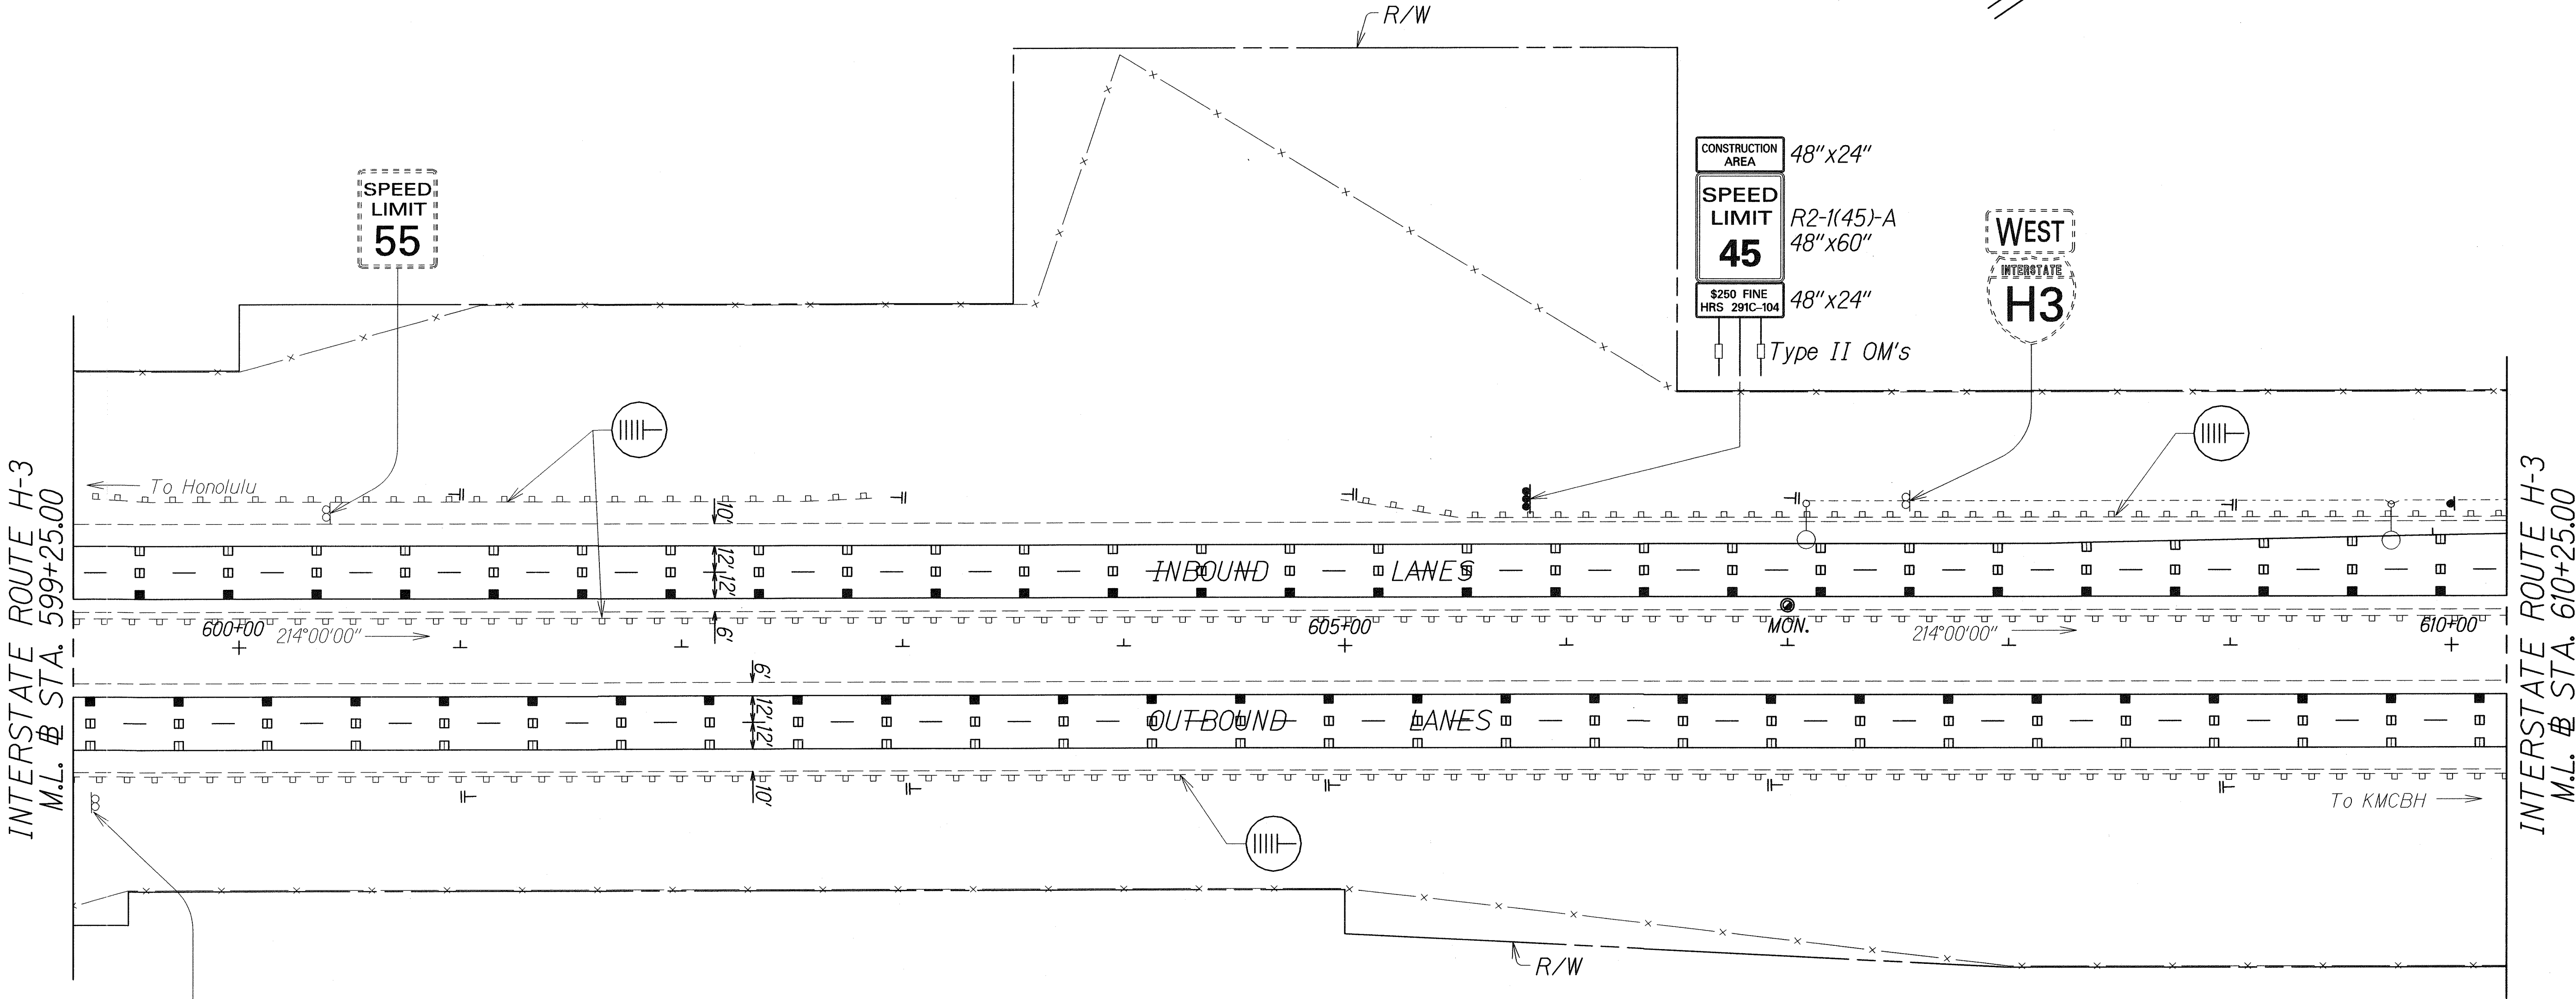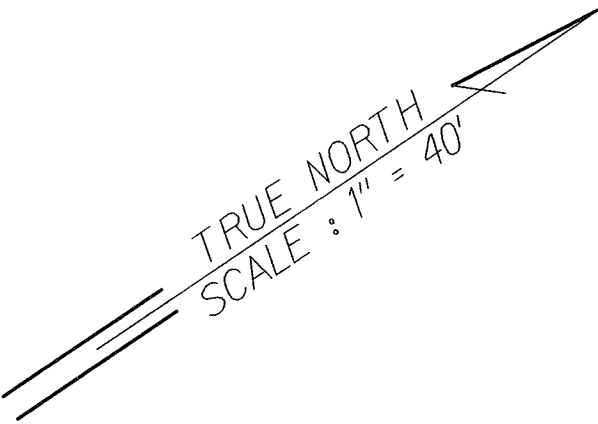



INTERSTATE ROUTE H-3
 M.L. # STA. 599+25.00

INTERSTATE ROUTE H-3
 M.L. # STA. 610+25.00

EXIT 14

 Kailua
 EXIT 1/2 MILE

ORIGINAL PLAN	SURVEY PLOTTED BY	DATE
NOTE BOOK	DRAWN BY	
DESIGNED BY		
CHECKED BY		
DATE		

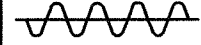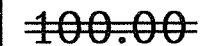LEGEND FOR AS-BUILT POSTINGS	
	Squiggly line for as-built deletion
	Double line for as-built deletion
Roadway	Text for as-built posting

STATE OF HAWAII
 DEPARTMENT OF TRANSPORTATION
 HIGHWAYS DIVISION



PAVEMENT MARKING PLAN
 INTERSTATE ROUTE H-3 PAVEMENT
 PREVENTIVE MAINTENANCE
 Halekou Interchange to
 Kaneohe Marine Corps Base Hawaii
 Federal Aid Project No. IM-H3-1(80)
 Scale: 1"=40'

Date: Aug. 2005
 SHEET No. 714 OF 30 SHEETS



"AS-BUILT"

FED. ROAD DIST. NO.	STATE	FED. AID PROJ. NO.	FISCAL YEAR	SHEET NO.	TOTAL SHEETS
HAWAII	HAW.	IM-H3-1(80)	2006	49	66

 Reflector Markers (RM-5) shall be mounted every 25 feet on all existing metal guardrails except on terminal sections. For details, see Plan Sheet No. 35. The Contractor shall be responsible for mounting RM-5's on all existing metal guardrails even when not shown on plans.

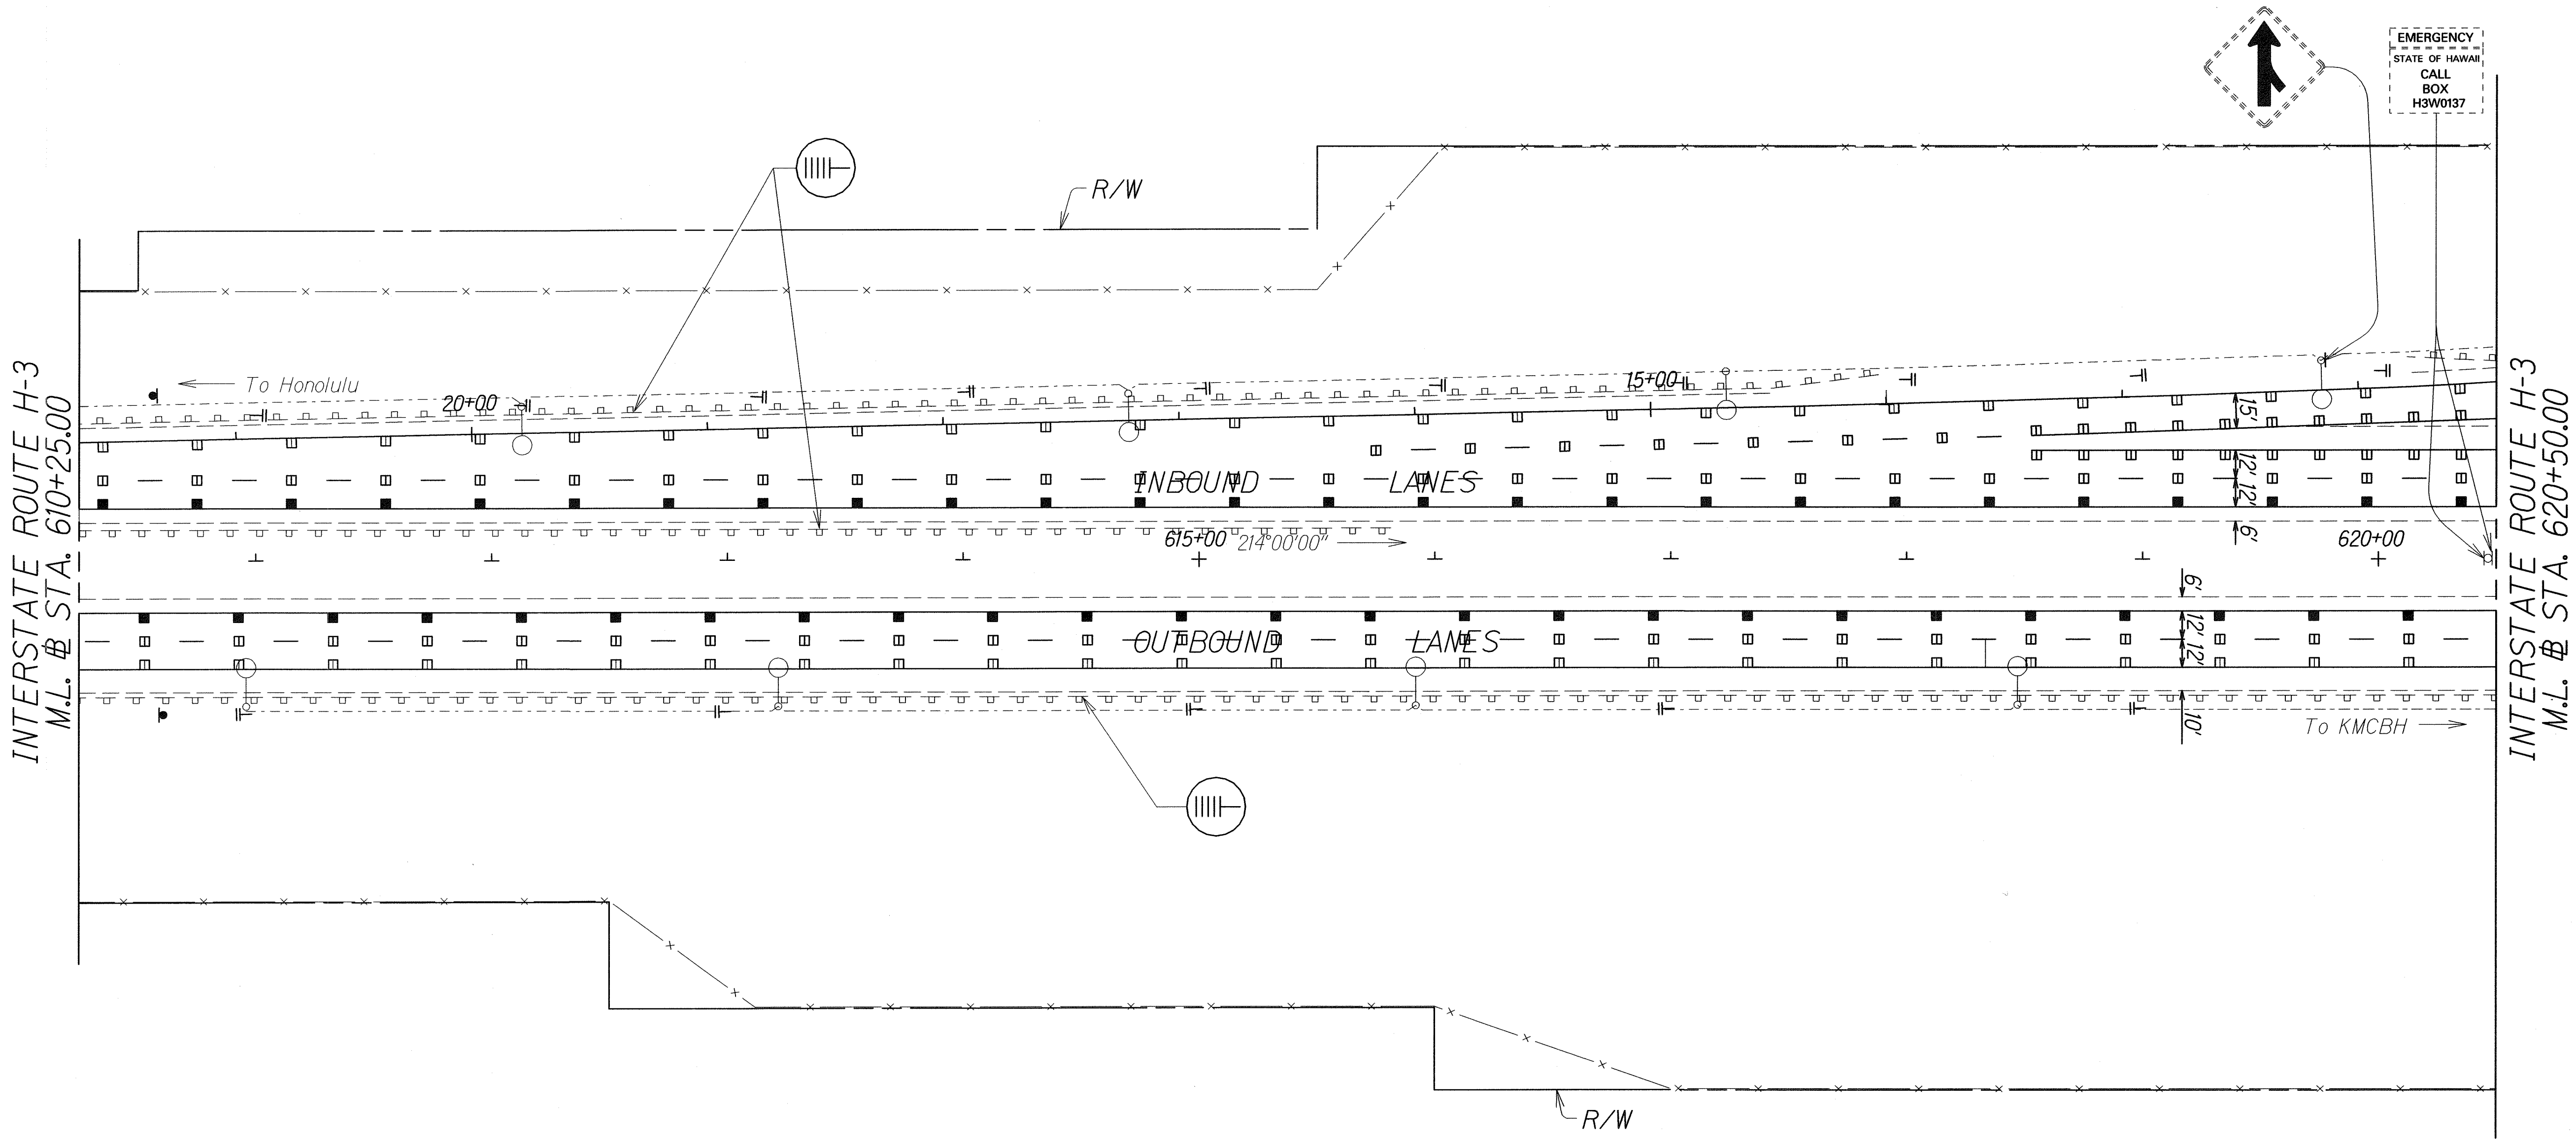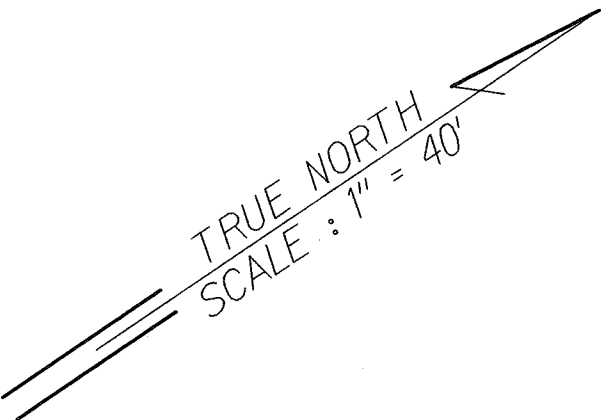

ORIGINAL PLAN	SURVEY PLOTTED BY	DATE
NOTE BOOK	DRAWN BY	
DESIGNED BY	TRACED BY	
CHECKED BY	CHECKED BY	
No. 4113193		

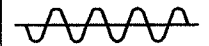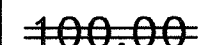
LEGEND FOR AS-BUILT POSTINGS	
	Squiggly line for as-built deletion
	Double line for as-built deletion
Roadway	Text for as-built posting

STATE OF HAWAII
 DEPARTMENT OF TRANSPORTATION
 HIGHWAYS DIVISION

PAVEMENT MARKING PLAN
 INTERSTATE ROUTE H-3 PAVEMENT
 PREVENTIVE MAINTENANCE
 Halekou Interchange to
 Kaneohe Marine Corps Base Hawaii
 Federal Aid Project No. IM-H3-1(80)
 Scale: 1"=40' Date: Aug. 2005

SHEET No. 715 OF 30 SHEETS

FED. ROAD DIST. NO.	STATE	FED. AID PROJ. NO.	FISCAL YEAR	SHEET NO.	TOTAL SHEETS
HAWAII	HAW.	IM-H3-1(80)	2006	50	66

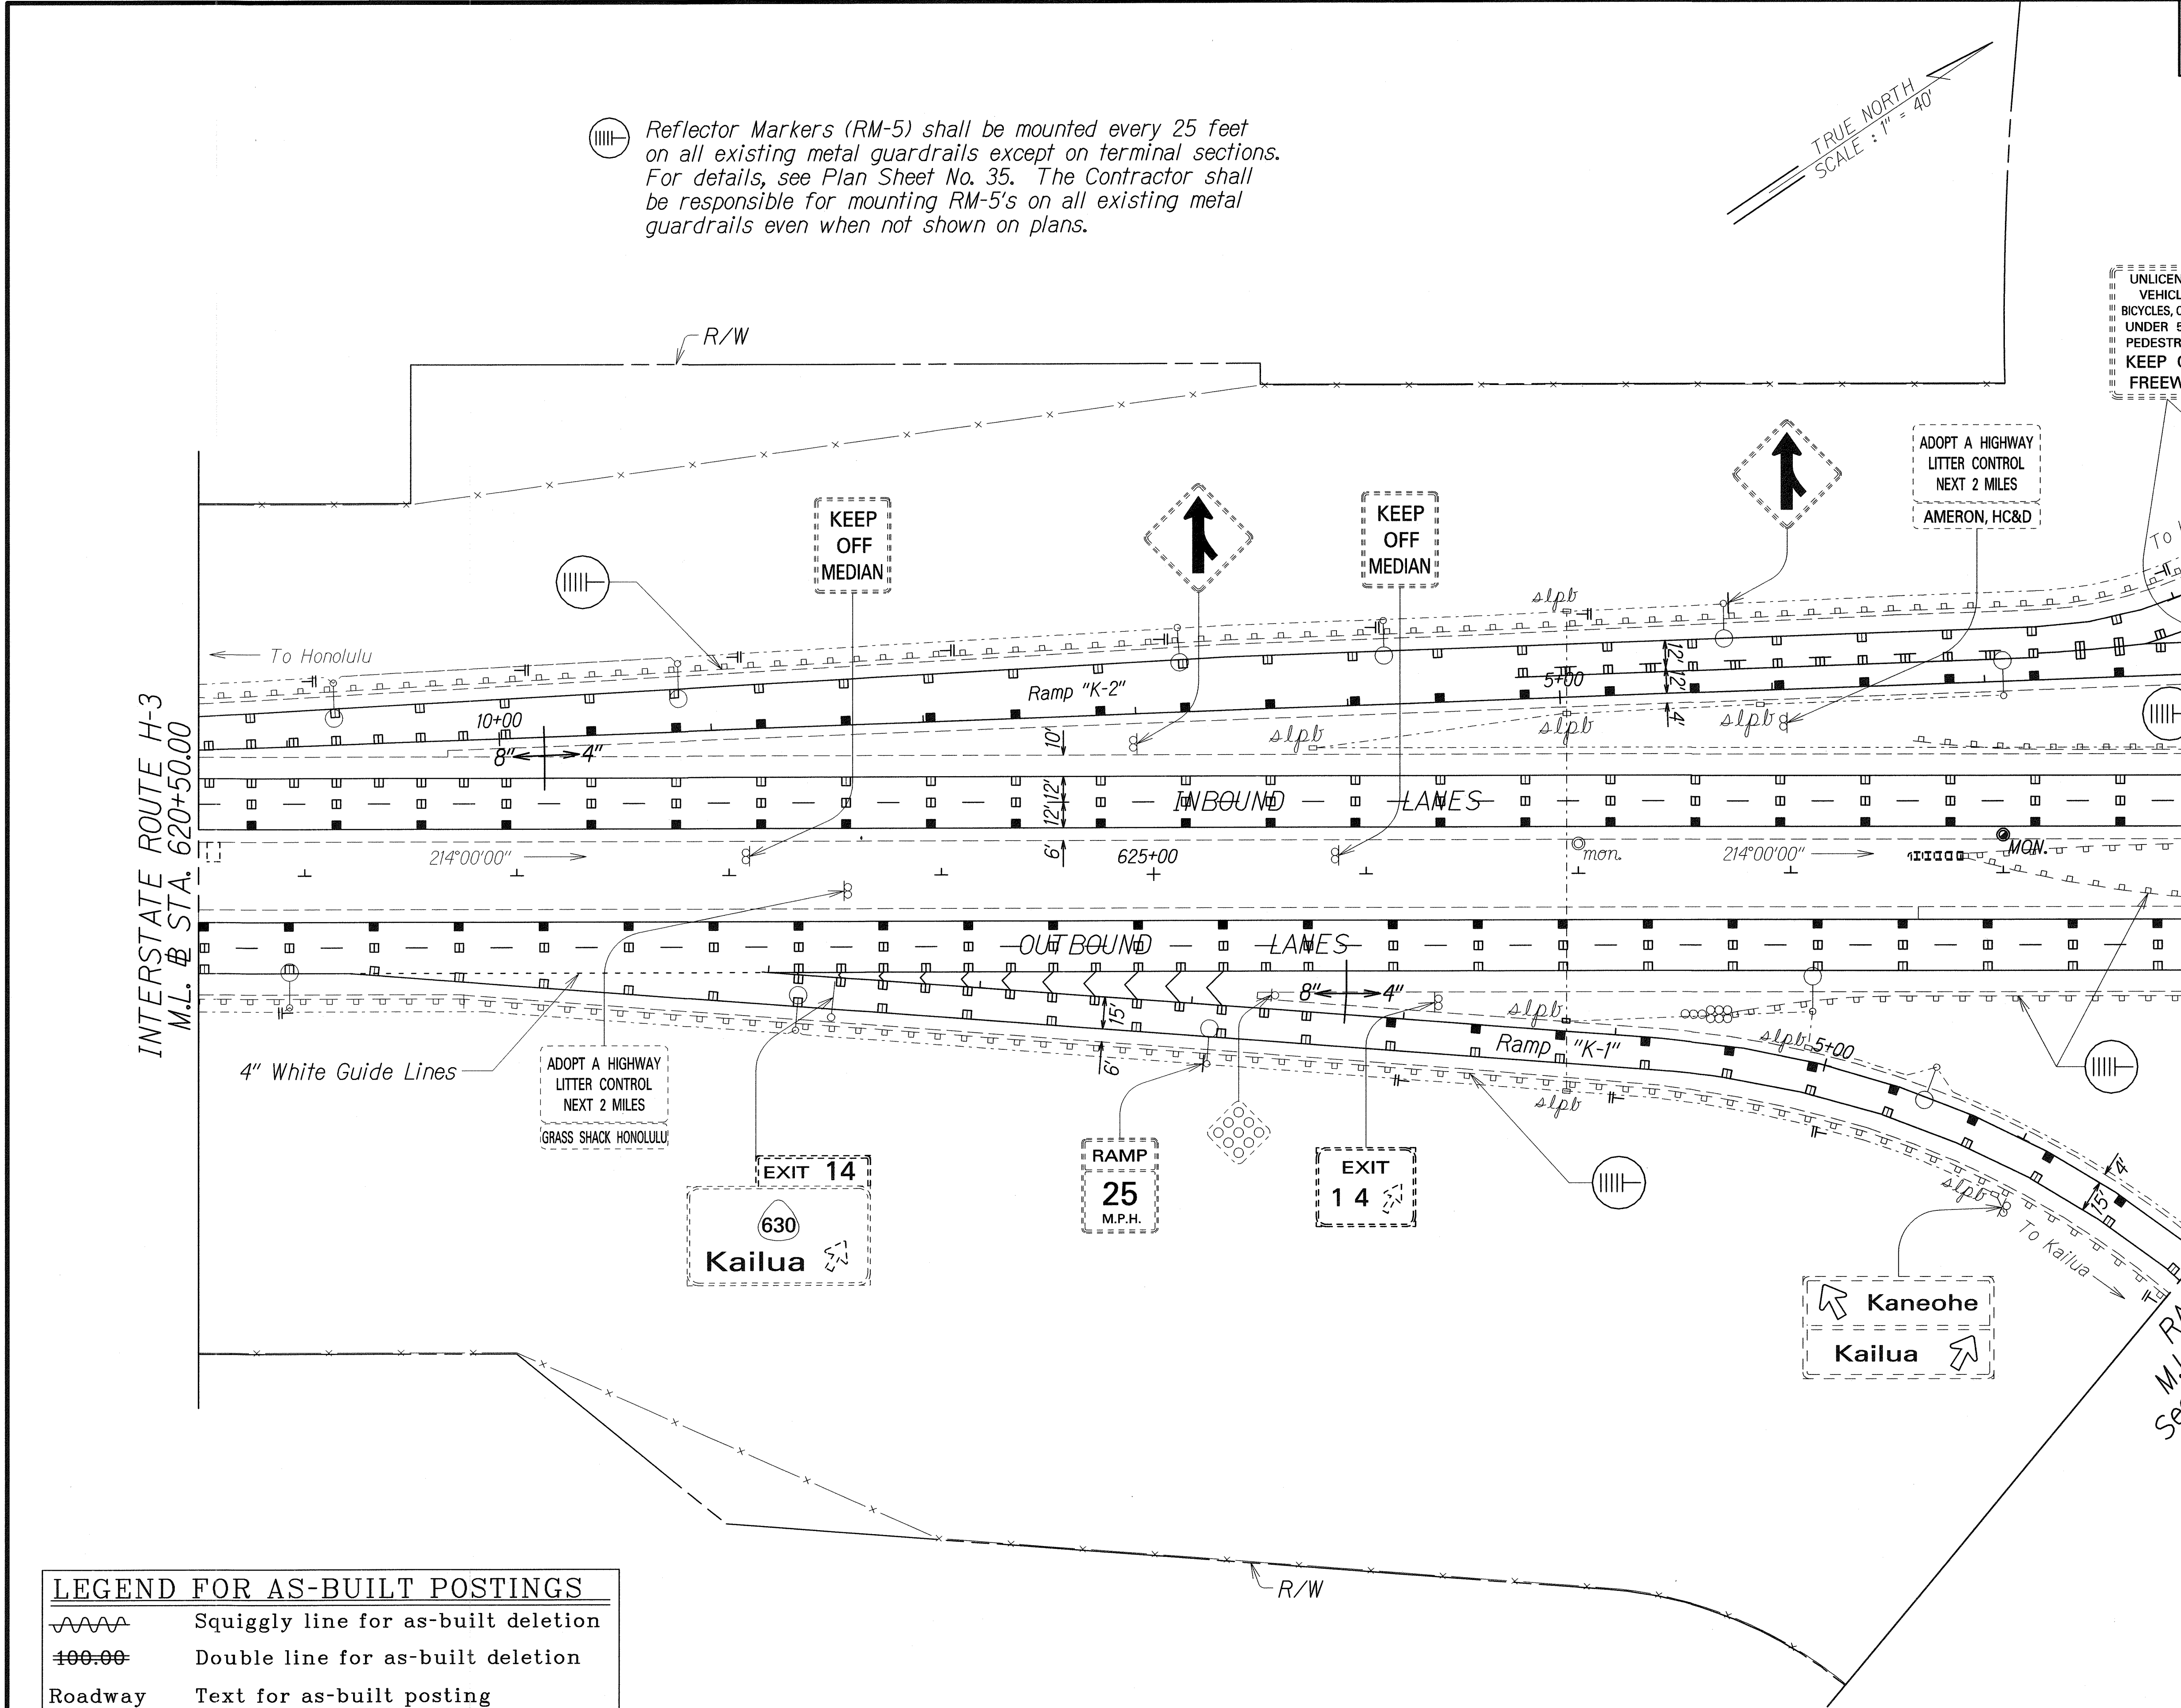

ORIGINAL PLAN	SURVEY PLOTTED BY	DATE
NOTED BY	DRAWN BY	
DESIGNED BY	CHECKED BY	
NO. 41131/4		


LEGEND FOR AS-BUILT POSTINGS	
	Squiggly line for as-built deletion
	Double line for as-built deletion
Roadway	Text for as-built posting

STATE OF HAWAII
DEPARTMENT OF TRANSPORTATION
HIGHWAYS DIVISION

PAVEMENT MARKING PLAN
INTERSTATE ROUTE H-3 PAVEMENT
PREVENTIVE MAINTENANCE
Halekou Interchange to
Kaneohe Marine Corps Base Hawaii
Federal Aid Project No. IM-H3-1(80)
Scale: 1"=40' Date: Aug. 2005

SHEET No. 716 OF 30 SHEETS

FED. ROAD DIST. NO.	STATE	FED. AID PROJ. NO.	FISCAL YEAR	SHEET NO.	TOTAL SHEETS
HAWAII	HAW.	IM-H3-1(80)	2006	51	66

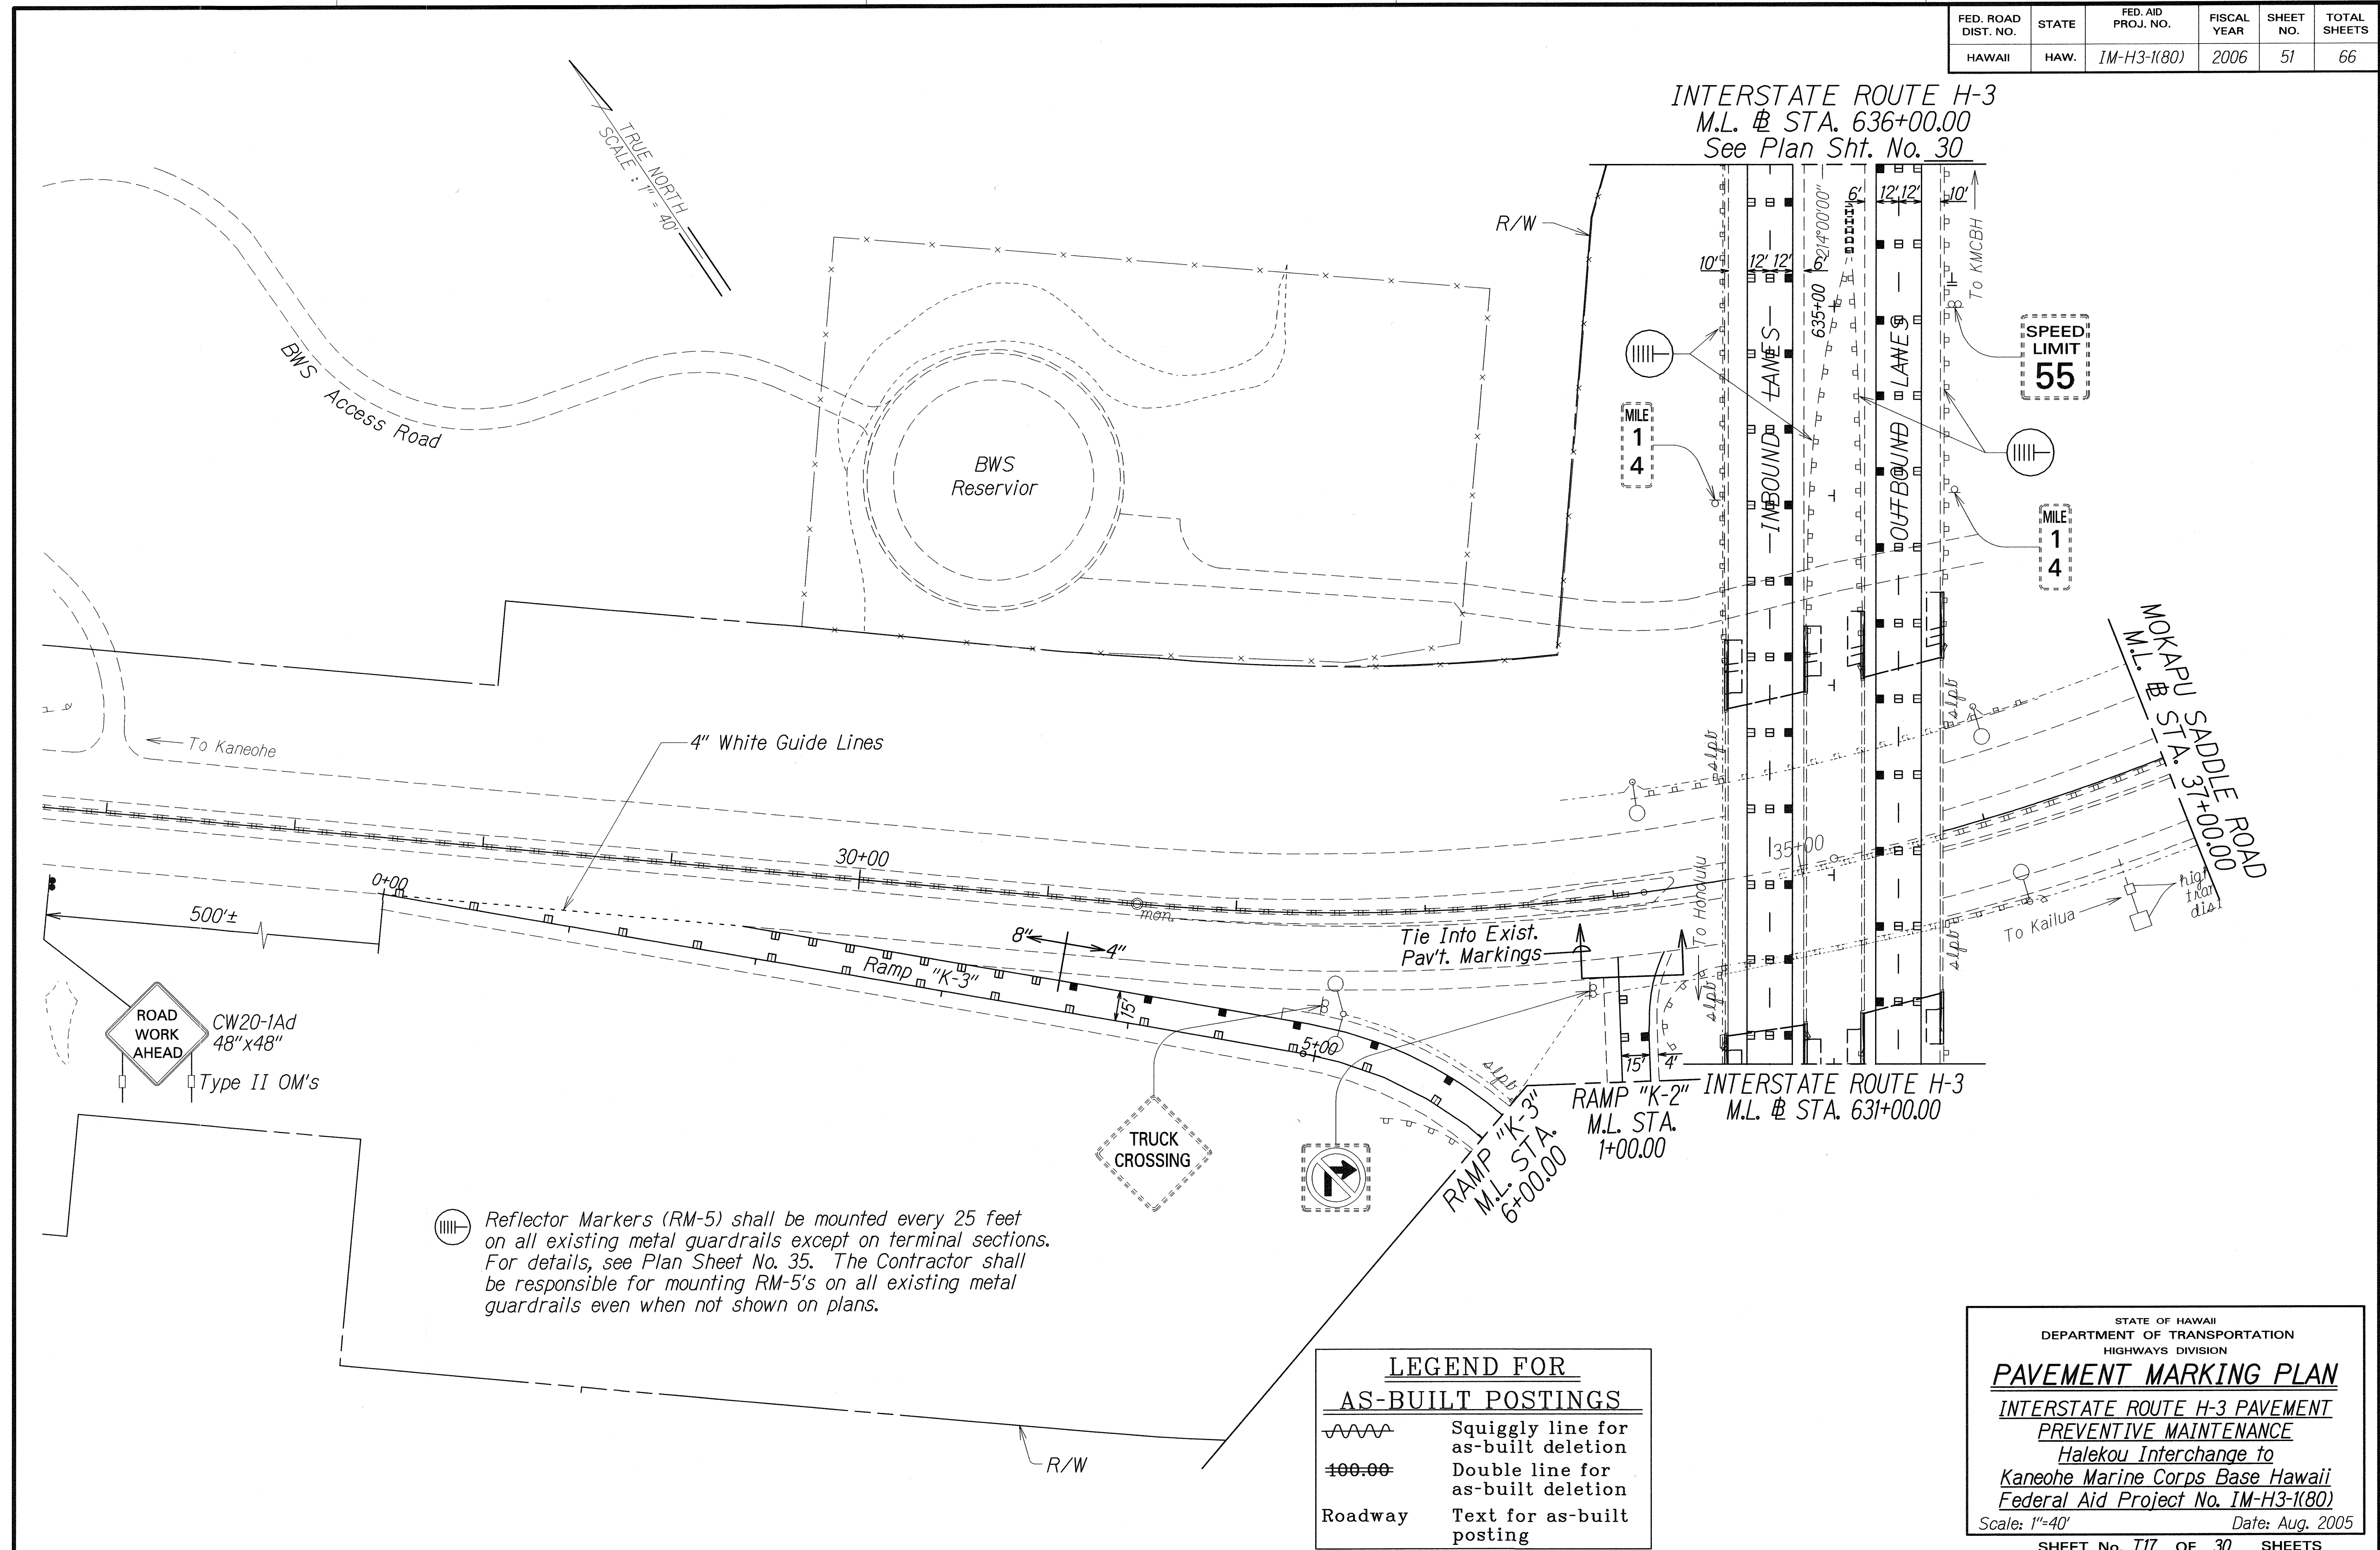

ORIGINAL PLAN	DATE
SURVEY PLOTTED BY	
DRAWN BY	
NOTED BY	
DESIGNED BY	
CHECKED BY	
NO. 413/205	

Reflector Markers (RM-5) shall be mounted every 25 feet on all existing metal guardrails except on terminal sections. For details, see Plan Sheet No. 35. The Contractor shall be responsible for mounting RM-5's on all existing metal guardrails even when not shown on plans.

LEGEND FOR AS-BUILT POSTINGS	
	Squiggly line for as-built deletion
	Double line for as-built deletion
Roadway	Text for as-built posting

STATE OF HAWAII
DEPARTMENT OF TRANSPORTATION
HIGHWAYS DIVISION

PAVEMENT MARKING PLAN

INTERSTATE ROUTE H-3 PAVEMENT PREVENTIVE MAINTENANCE


Halekou Interchange to Kaneohe Marine Corps Base Hawaii

Federal Aid Project No. IM-H3-1(80)

Scale: 1"=40' Date: Aug. 2005

SHEET No. 717 OF 30 SHEETS

FED. ROAD DIST. NO.	STATE	FED. AID PROJ. NO.	FISCAL YEAR	SHEET NO.	TOTAL SHEETS
HAWAII	HAW.	IM-H3-1(80)	2006	52	66

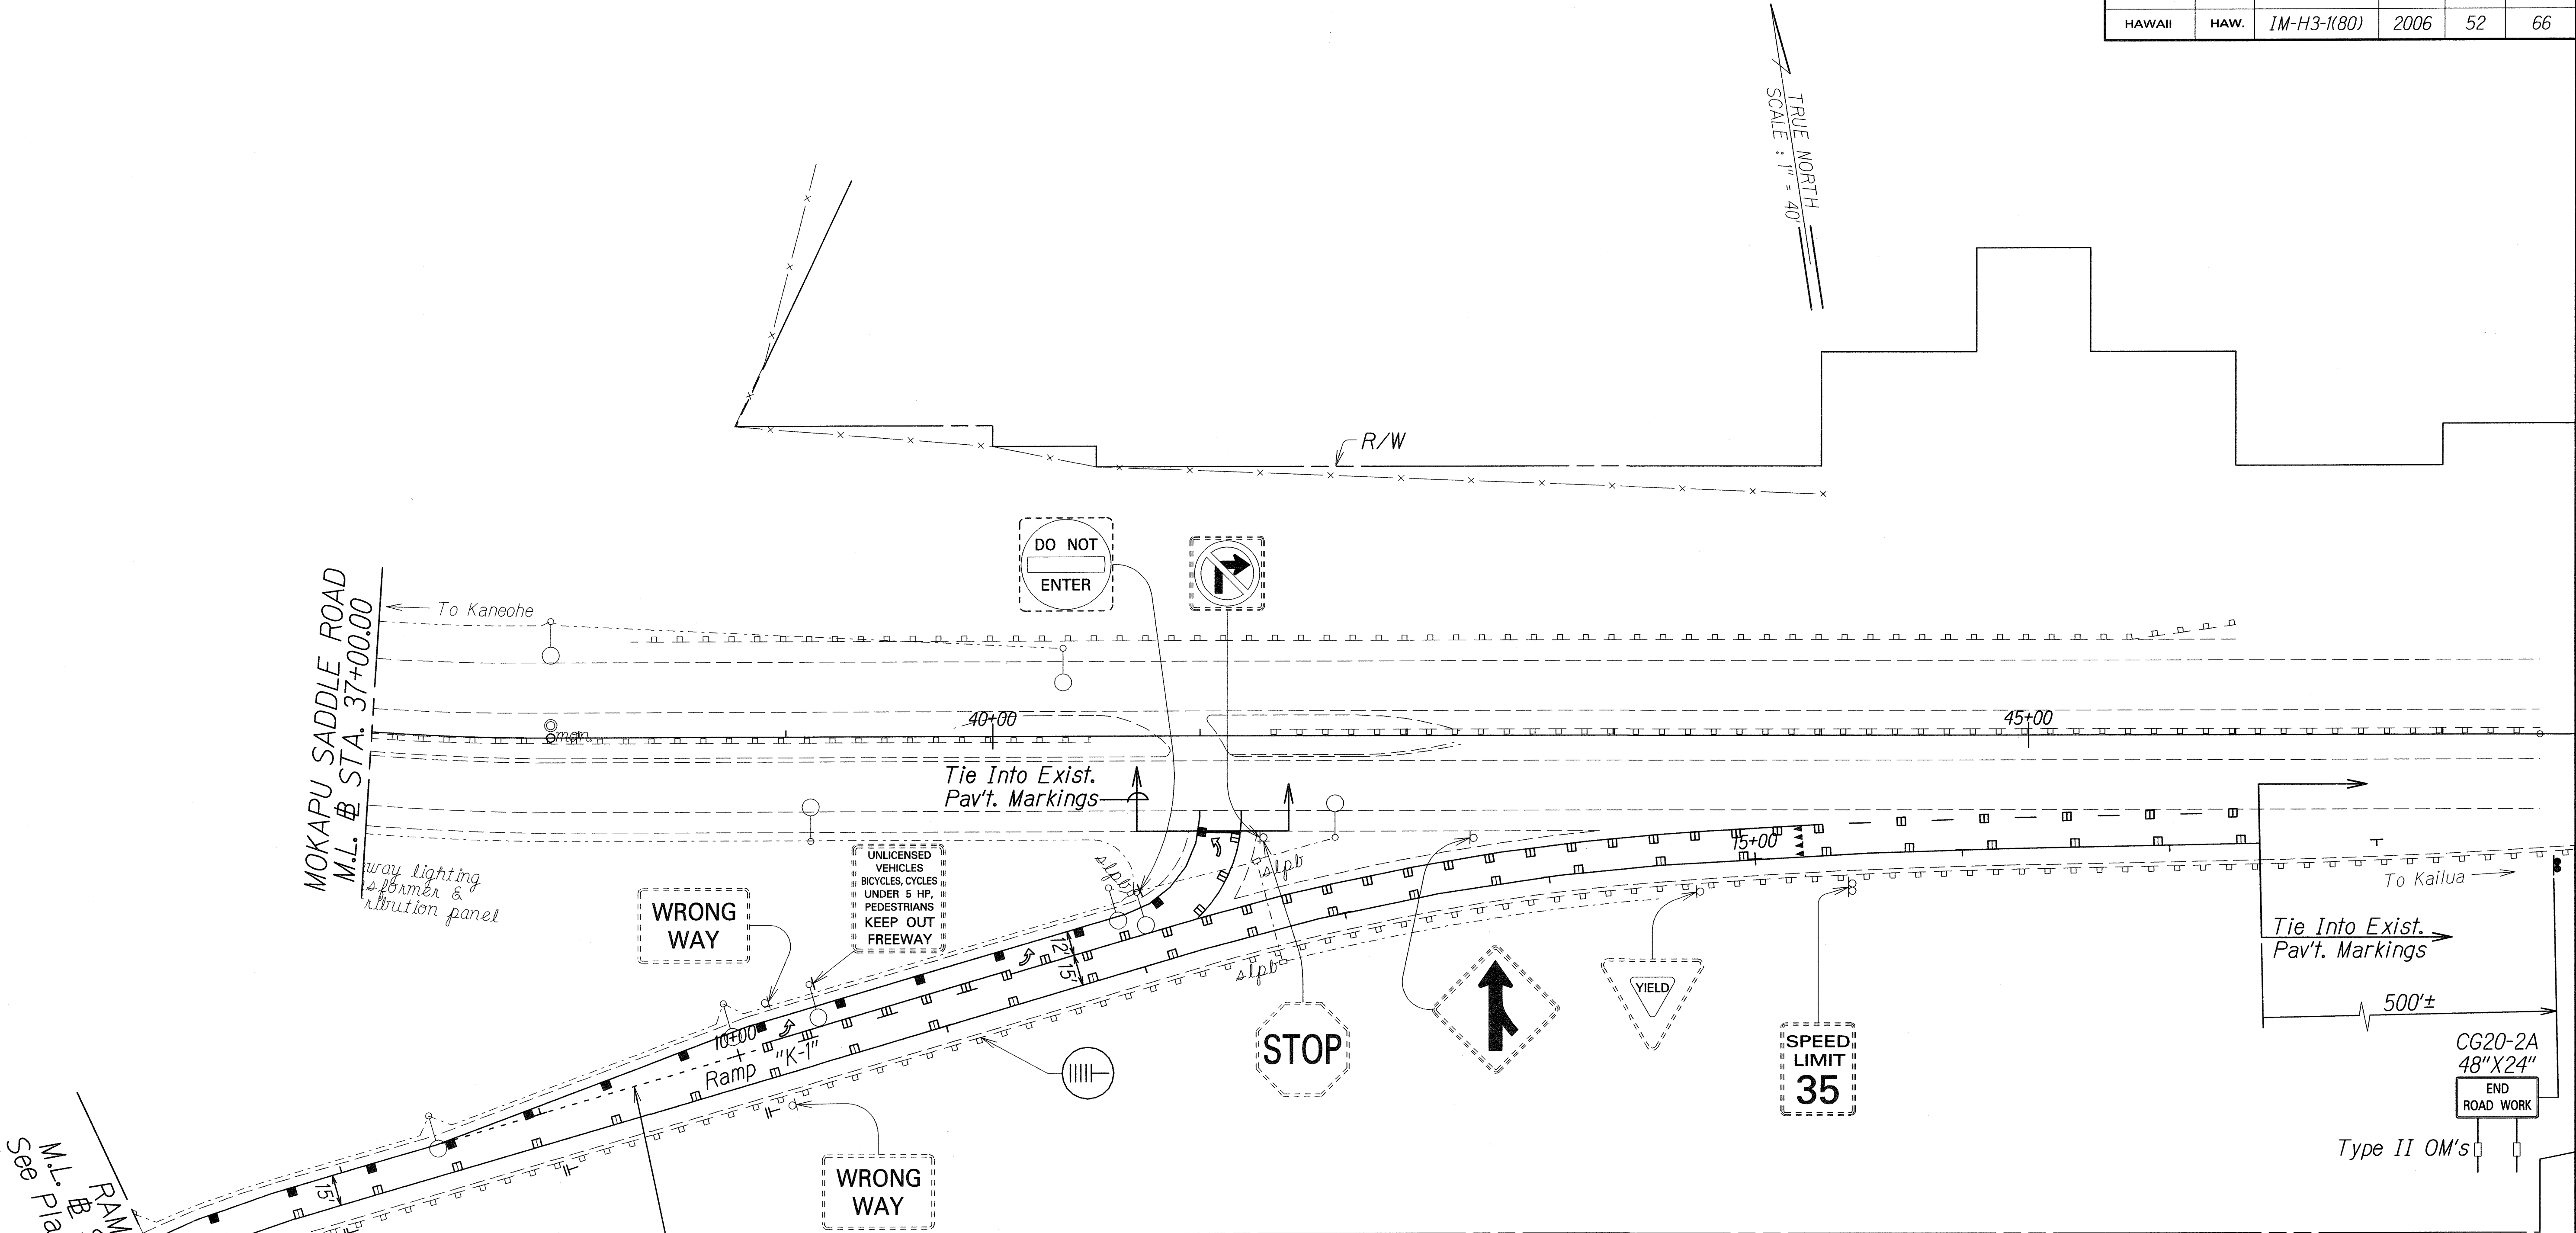

ORIGINAL PLAN	SURVEY PLOTTED BY	DATE
NOTE BOOK	DRAWN BY	
DESIGNED BY	TRACED BY	
CHECKED BY	CHECKED BY	
No. 4131106		

M.L. Plan Sheet No. 27
 STA. 7+00.00
 Ramp "K-1"

Reflector Markers (RM-5) shall be mounted every 25 feet on all existing metal guardrails except on terminal sections. For details, see Plan Sheet No. 35. The Contractor shall be responsible for mounting RM-5's on all existing metal guardrails even when not shown on plans.


LEGEND FOR AS-BUILT POSTINGS	
	Squiggly line for as-built deletion
	Double line for as-built deletion
Roadway	Text for as-built posting

STATE OF HAWAII
DEPARTMENT OF TRANSPORTATION
HIGHWAYS DIVISION

PAVEMENT MARKING PLAN
INTERSTATE ROUTE H-3 PAVEMENT
PREVENTIVE MAINTENANCE
Halekou Interchange to
Kaneohe Marine Corps Base Hawaii
Federal Aid Project No. IM-H3-1(80)
Scale: 1"=40'

Date: Aug. 2005
SHEET No. 718 OF 30 SHEETS

FED. ROAD DIST. NO.	STATE	FED. AID PROJ. NO.	FISCAL YEAR	SHEET NO.	TOTAL SHEETS
HAWAII	HAW.	IM-H3-1(80)	2006	53	66

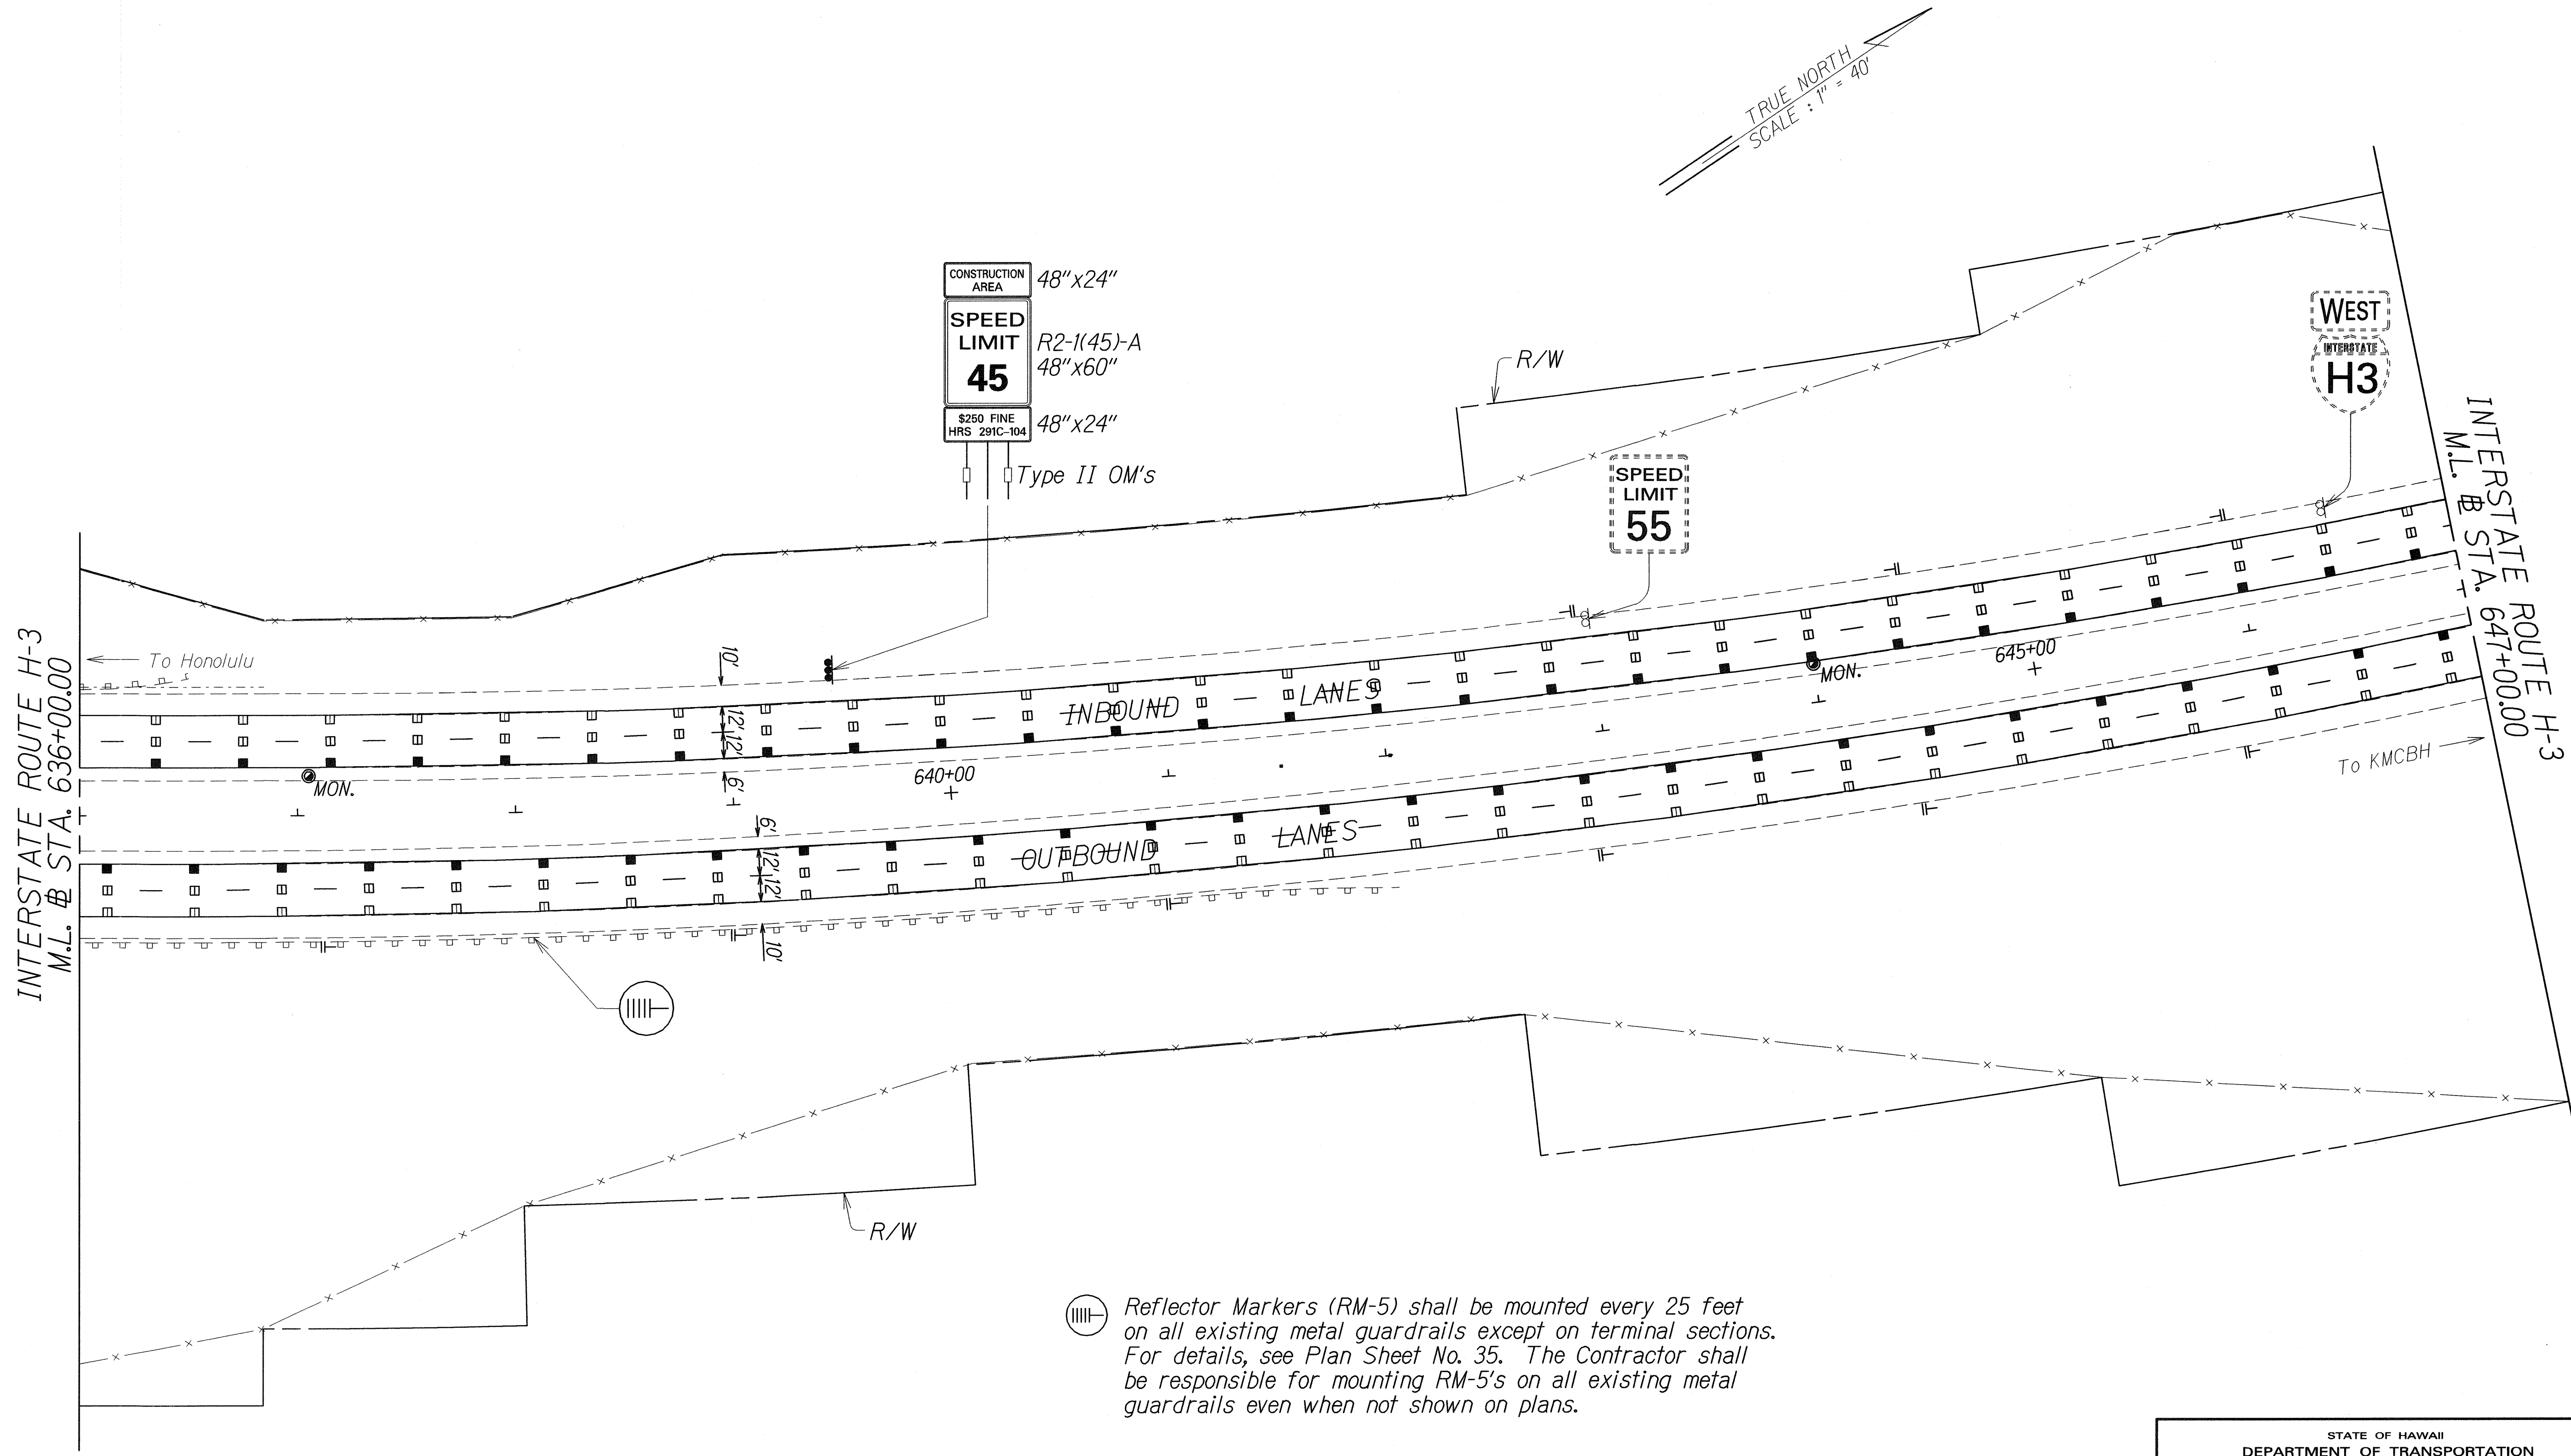

ORIGINAL PLAN	SURVEY PLOTTED BY	DATE
NOTE BOOK	DRAWN BY	
10/1/98	TRACED BY	
4/13/97	DESIGNED BY	
	CHECKED BY	

⊘ Reflector Markers (RM-5) shall be mounted every 25 feet on all existing metal guardrails except on terminal sections. For details, see Plan Sheet No. 35. The Contractor shall be responsible for mounting RM-5's on all existing metal guardrails even when not shown on plans.

LEGEND FOR AS-BUILT POSTINGS	
	Squiggly line for as-built deletion
	Double line for as-built deletion
Roadway	Text for as-built posting


STATE OF HAWAII
DEPARTMENT OF TRANSPORTATION
HIGHWAYS DIVISION

PAVEMENT MARKING PLAN
INTERSTATE ROUTE H-3 PAVEMENT
PREVENTIVE MAINTENANCE
Halekou Interchange to
Kaneohe Marine Corps Base Hawaii
Federal Aid Project No. IM-H3-1(80)
Scale: 1"=40' Date: Aug. 2005

FED. ROAD DIST. NO.	STATE	FED. AID PROJ. NO.	FISCAL YEAR	SHEET NO.	TOTAL SHEETS
HAWAII	HAW.	IM-H3-1(80)	2006	54	66

⦿ Reflector Markers (RM-5) shall be mounted every 25 feet on all existing metal guardrails except on terminal sections. For details, see Plan Sheet No. 35. The Contractor shall be responsible for mounting RM-5's on all existing metal guardrails even when not shown on plans.

TRUE NORTH
SCALE : 1" = 40'

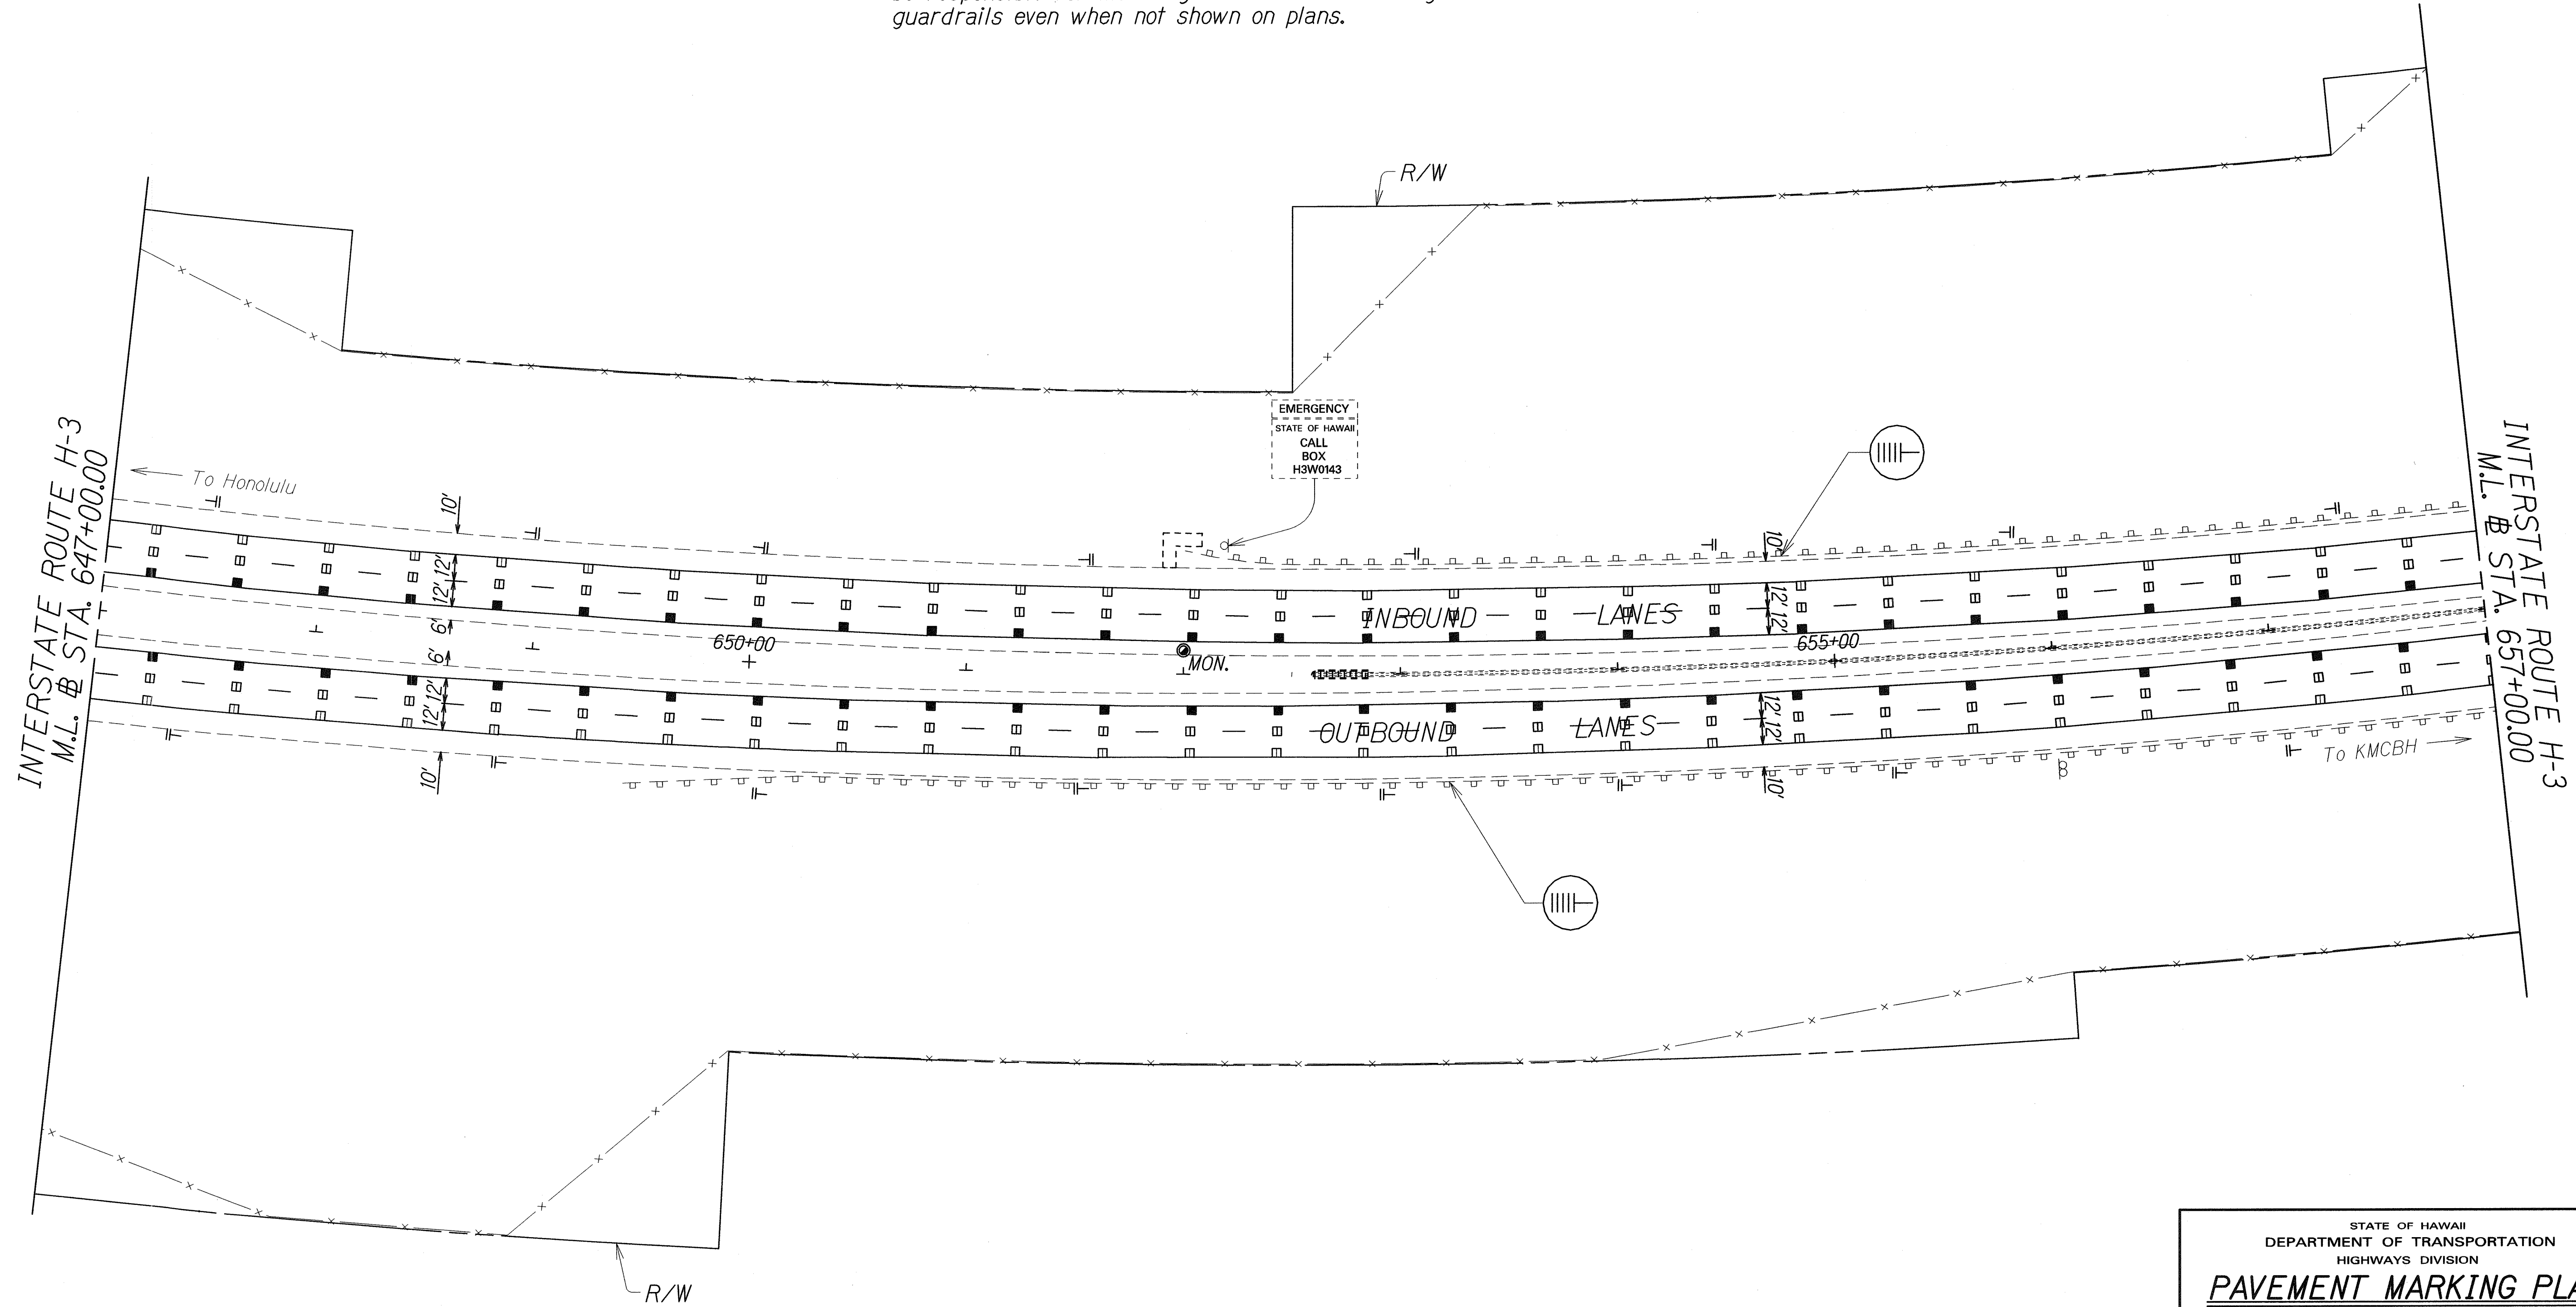

ORIGINAL PLAN	SURVEY PLOTTED BY	DATE
NOTED BOOK	DRAWN BY	
DESIGNED BY	TRACED BY	
CHECKED BY	CHECKED BY	

LEGEND FOR AS-BUILT POSTINGS	
	Squiggly line for as-built deletion
	Double line for as-built deletion
Roadway	Text for as-built posting

STATE OF HAWAII
DEPARTMENT OF TRANSPORTATION
HIGHWAYS DIVISION

PAVEMENT MARKING PLAN


INTERSTATE ROUTE H-3 PAVEMENT
PREVENTIVE MAINTENANCE
Halekou Interchange to
Kaneohe Marine Corps Base Hawaii
Federal Aid Project No. IM-H3-1(80)

Scale: 1"=40' Date: Aug. 2005

SHEET No. T20 OF 30 SHEETS

FED. ROAD DIST. NO.	STATE	FED. AID PROJ. NO.	FISCAL YEAR	SHEET NO.	TOTAL SHEETS
HAWAII	HAW.	IM-H3-1(80)	2006	55	66

TRUE NORTH
SCALE : 1" = 40'

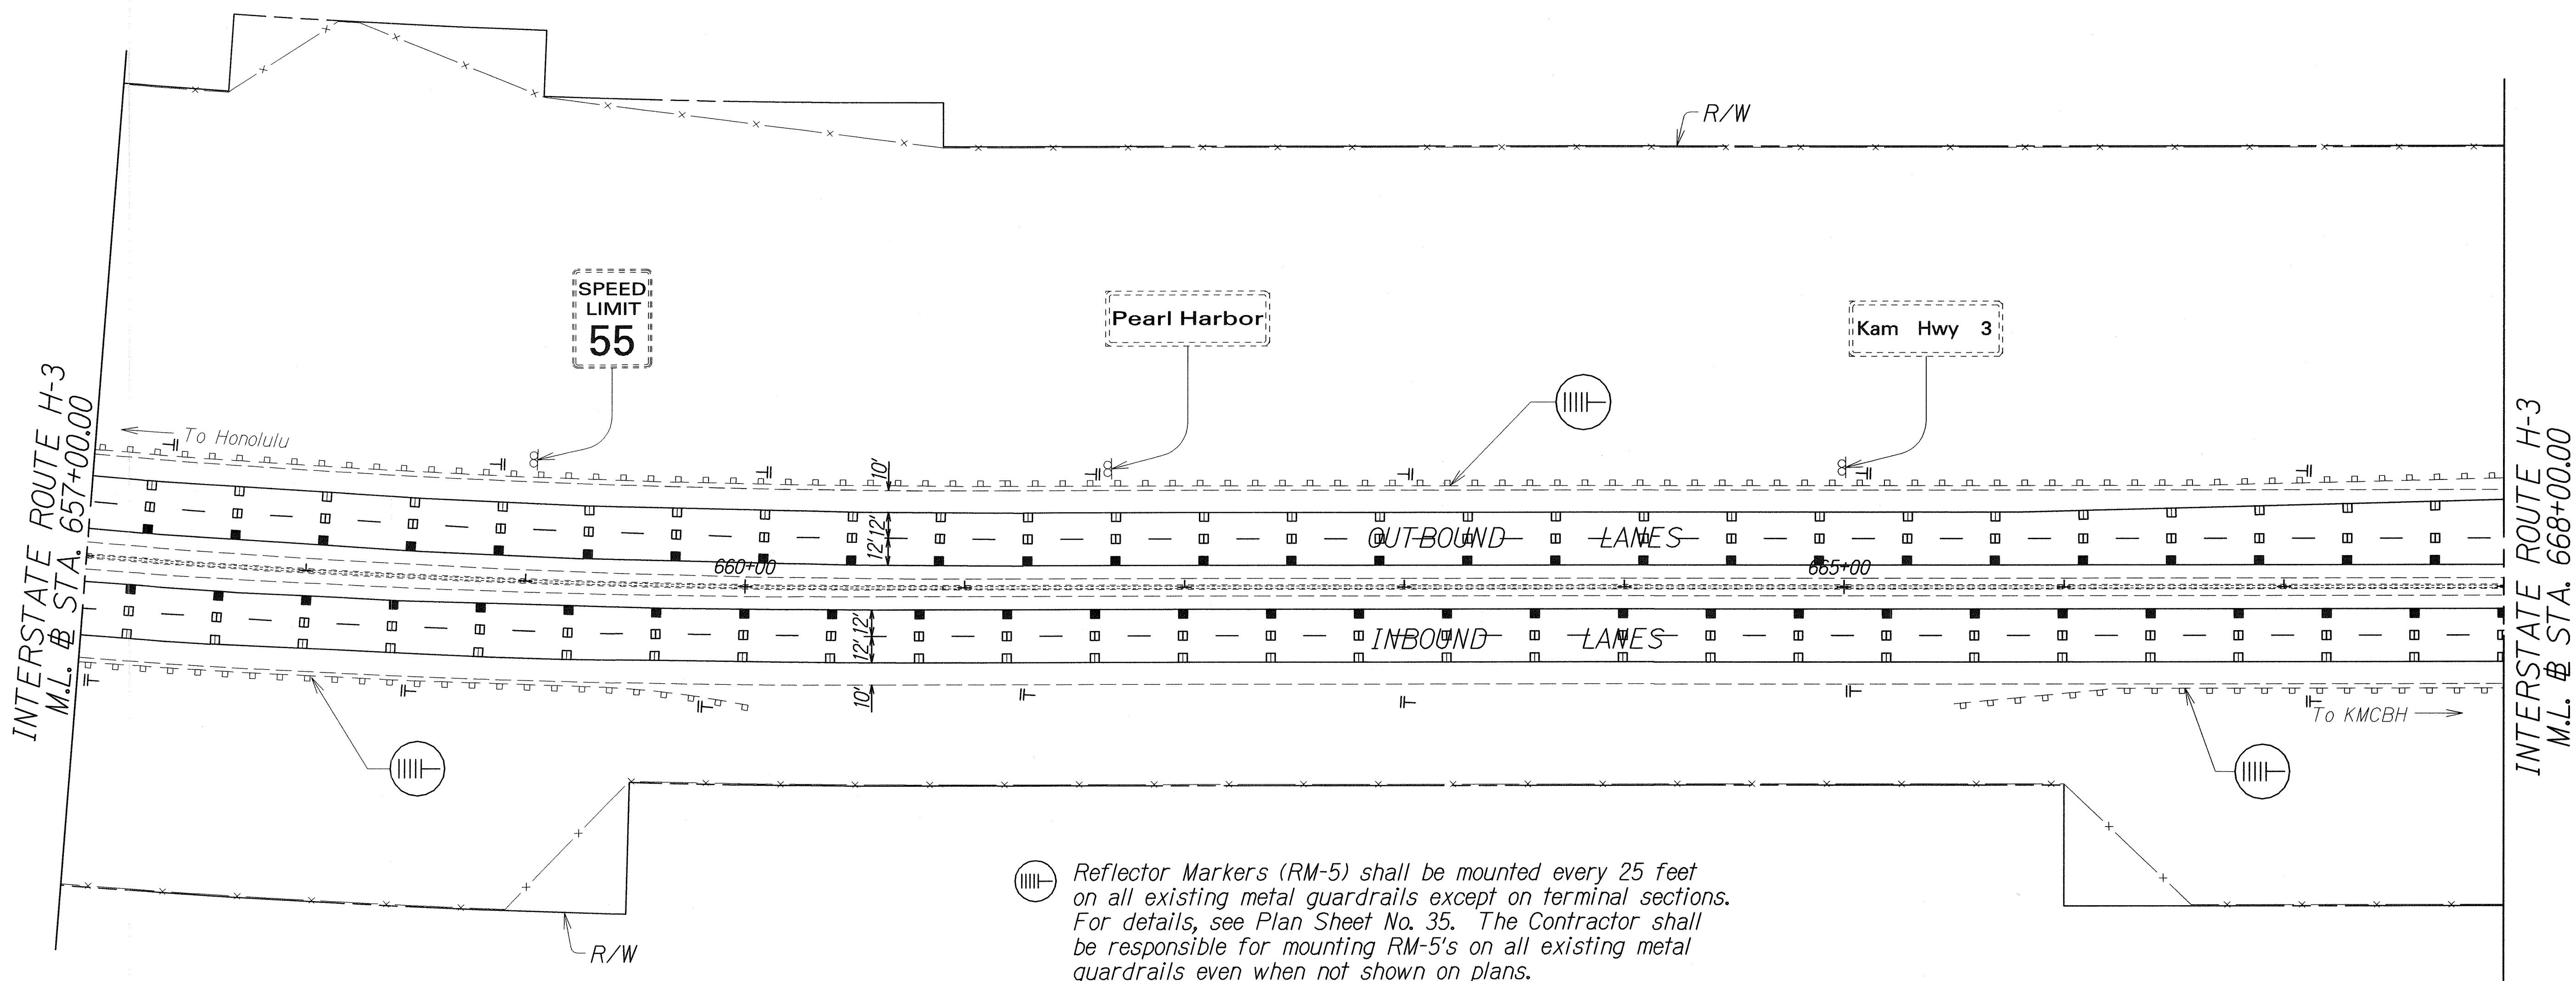

⊗ Reflector Markers (RM-5) shall be mounted every 25 feet on all existing metal guardrails except on terminal sections. For details, see Plan Sheet No. 35. The Contractor shall be responsible for mounting RM-5's on all existing metal guardrails even when not shown on plans.

ORIGINAL PLAN	SURVEY PLOTTED BY	DATE
NOTE BOOK	DRAWN BY	
10/1/06	TRACED BY	
4/13/09	DESIGNED BY	
	CHECKED BY	



LEGEND FOR AS-BUILT POSTINGS	
	Squiggly line for as-built deletion
	Double line for as-built deletion
Roadway	Text for as-built posting

STATE OF HAWAII
DEPARTMENT OF TRANSPORTATION
HIGHWAYS DIVISION

PAVEMENT MARKING PLAN
INTERSTATE ROUTE H-3 PAVEMENT
PREVENTIVE MAINTENANCE
Halekou Interchange to
Kaneohe Marine Corps Base Hawaii
Federal Aid Project No. IM-H3-1(80)
Scale: 1"=40'

Date: Aug. 2005
SHEET No. 721 OF 30 SHEETS

LEGEND FOR AS-BUILT POSTINGS

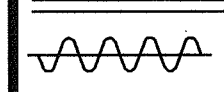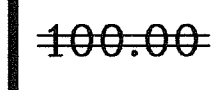
 Squiggly line for as-built deletion
 Double line for as-built deletion
 Roadway Text for as-built posting

 Reflector Markers (RM-5) shall be mounted every 25 feet on all existing metal guardrails except on terminal sections. For details, see Plan Sheet No. 35. The Contractor shall be responsible for mounting RM-5's on all existing metal guardrails even when not shown on plans.


TRUE NORTH
 SCALE : 1" = 40'

4" White Stripes (Tape, Type I or Thermoplastic Extrusion) for 60° Diagonal Parking of Seven Stalls spread out evenly with a minimum width of 8 feet; One Stall for the handicapped with an accessible aisle, both having a minimum width of 8 feet; Handicap Parking Stall, Logo, Sign and Post Details are shown on this Plan Sheet

INTERSTATE ROUTE H-3
 M.L. # STA. 668+00.00

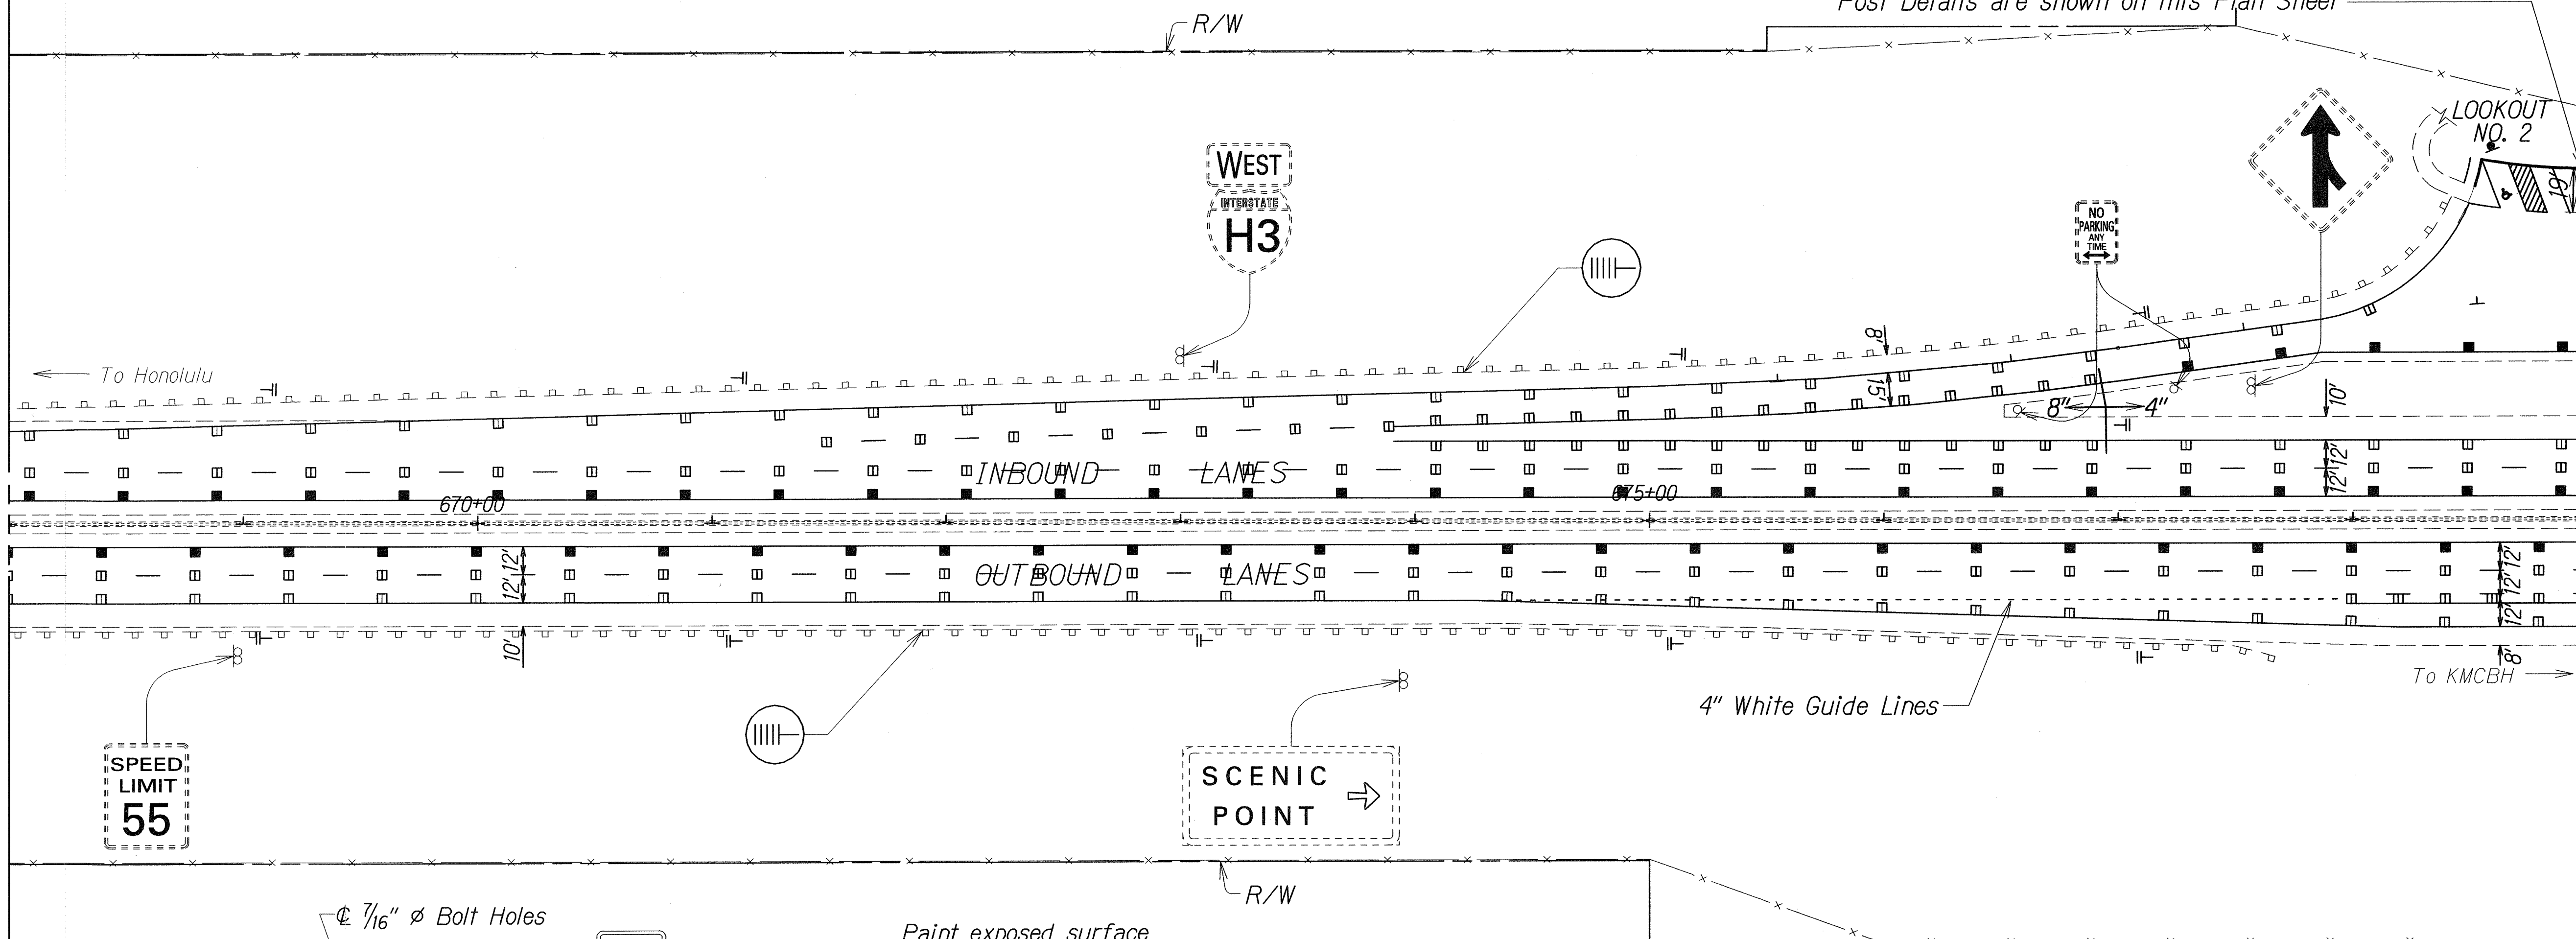


INTERSTATE ROUTE H-3
 M.L. # STA. 679+00.00

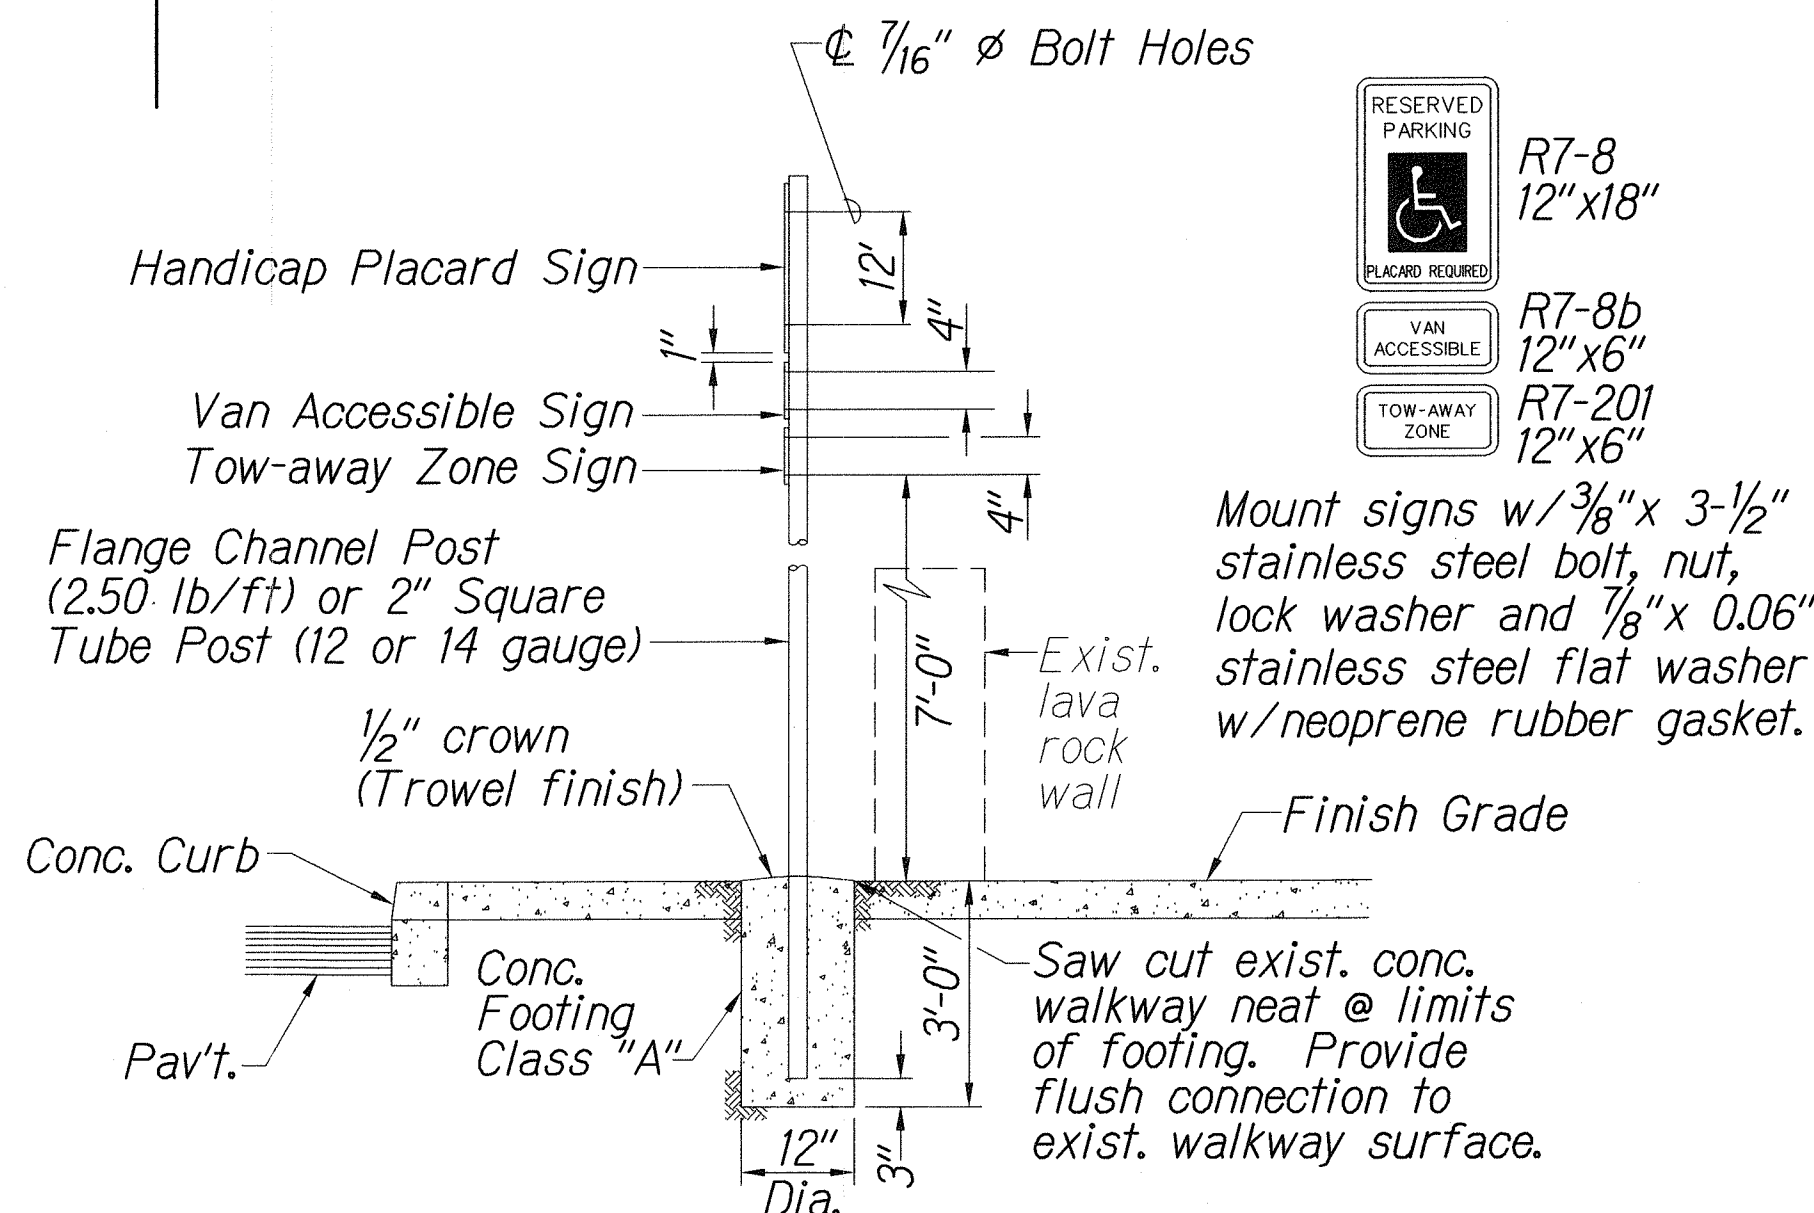

TYPICAL HANDICAP PARKING SIGN & POST DETAIL


Not to Scale

Note: Saw cutting existing concrete walkway, new sign concrete footing and removal & disposal of excavation work for concrete footing shall be considered incidental to Item No. 621B.5100, Regulatory Sign with Post.

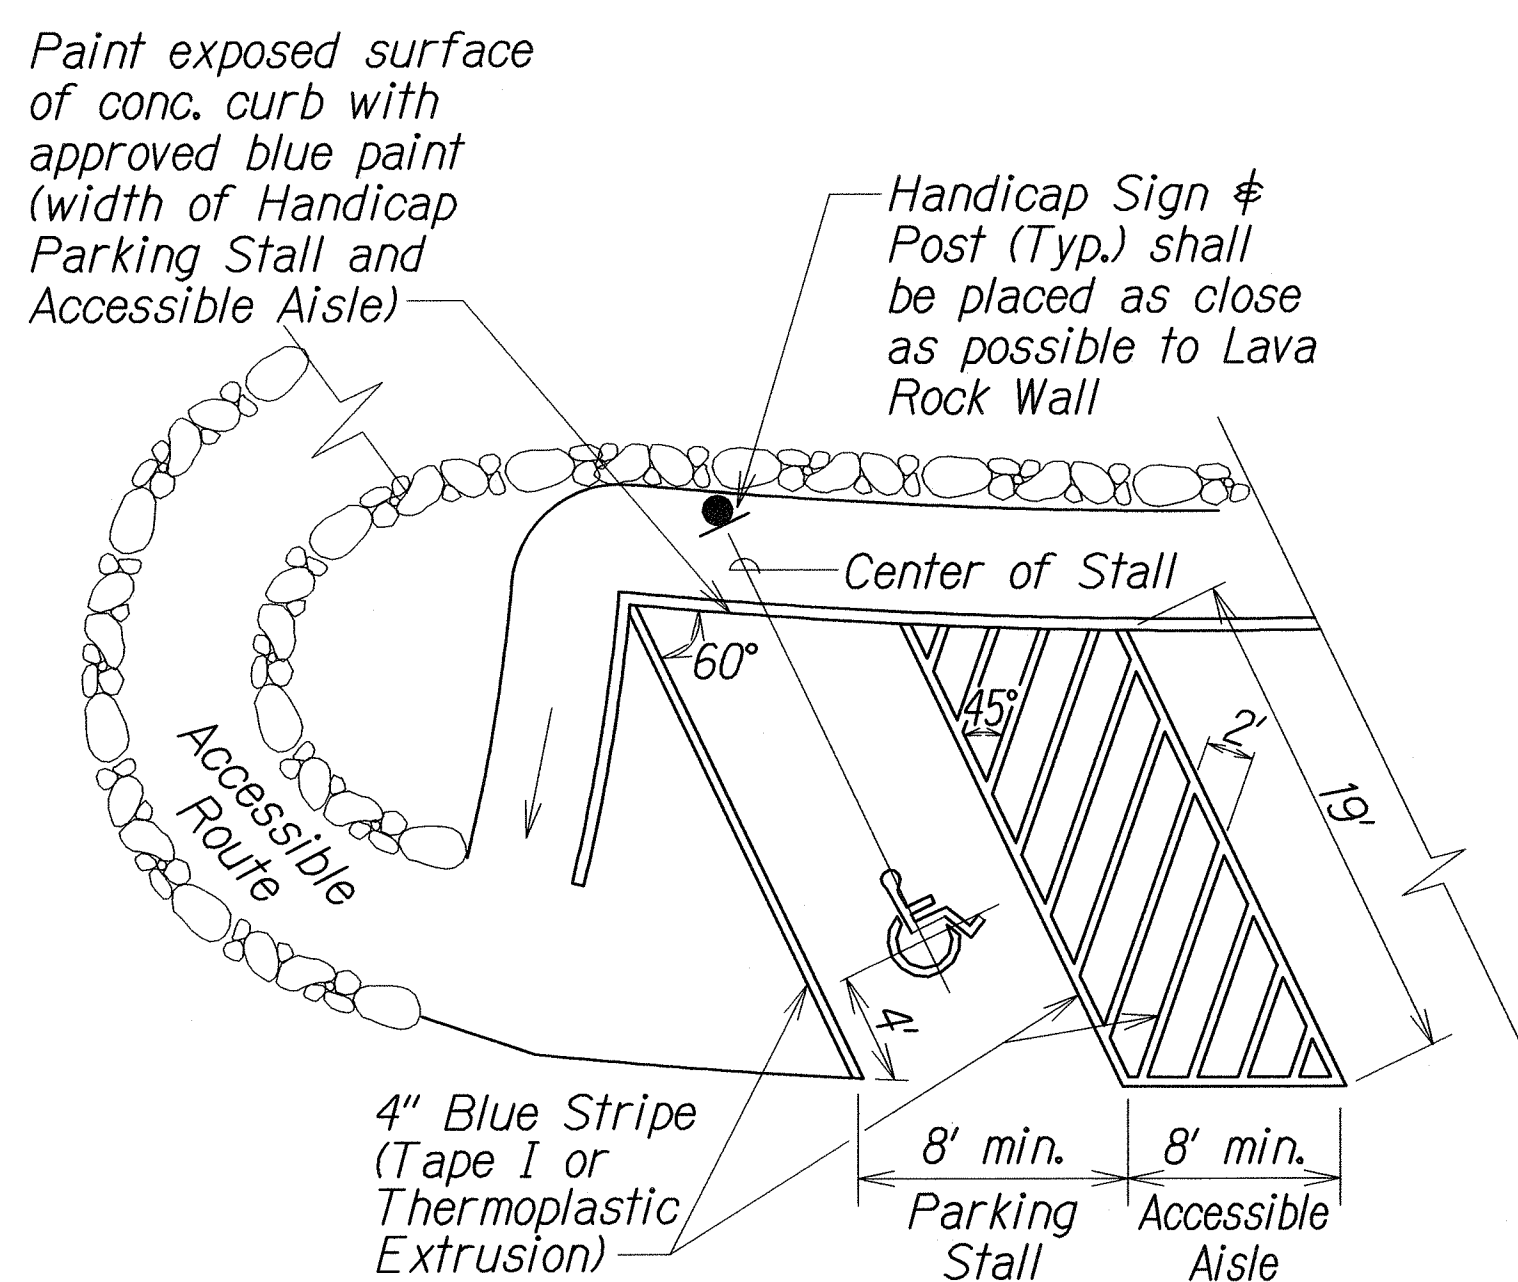

LOOKOUT NO. 2
HANDICAP STALL DETAIL

Not to Scale

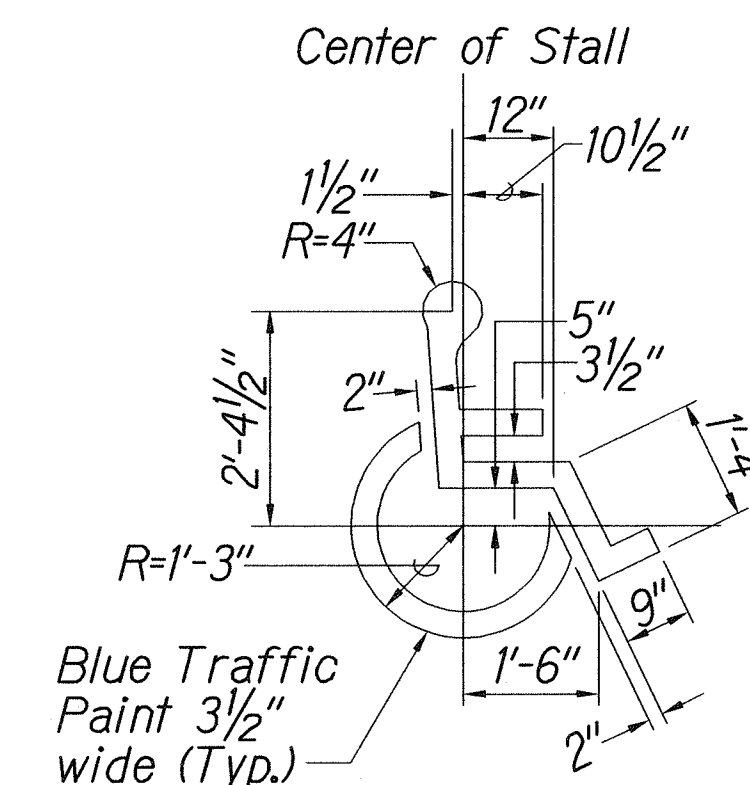

HANDICAP PARKING STALL
LOGO DETAIL

Not to Scale

FED. ROAD DIST. NO.	STATE	FED. AID PROJ. NO.	FISCAL YEAR	SHEET NO.	TOTAL SHEETS
HAWAII	HAW.	IM-H3-1(80)	2006	56	66

DATE	_____
SURVEY PLOTTED BY	_____
DRAWN BY	_____
DESIGNED BY	_____
CHECKED BY	_____
NOTED BY	_____
DATE	_____


STATE OF HAWAII DEPARTMENT OF TRANSPORTATION HIGHWAYS DIVISION
PAVEMENT MARKING PLAN
INTERSTATE ROUTE H-3 PAVEMENT PREVENTIVE MAINTENANCE
Halekou Interchange to Kaneohe Marine Corps Base Hawaii Federal Aid Project No. IM-H3-1(80)
Scale: 1"=40' Date: Aug. 2005
SHEET No. T22 OF 30 SHEETS

"AS-BUILT"



FED. ROAD DIST. NO.	STATE	FED. AID PROJ. NO.	FISCAL YEAR	SHEET NO.	TOTAL SHEETS
HAWAII	HAW.	IM-H3-1(80)	2006	58	66

 Reflector Markers (RM-5) shall be mounted every 25 feet on all existing metal guardrails except on terminal sections. For details, see Plan Sheet No. 35. The Contractor shall be responsible for mounting RM-5's on all existing metal guardrails even when not shown on plans.

TRUE NORTH
 SCALE : 1" = 40'

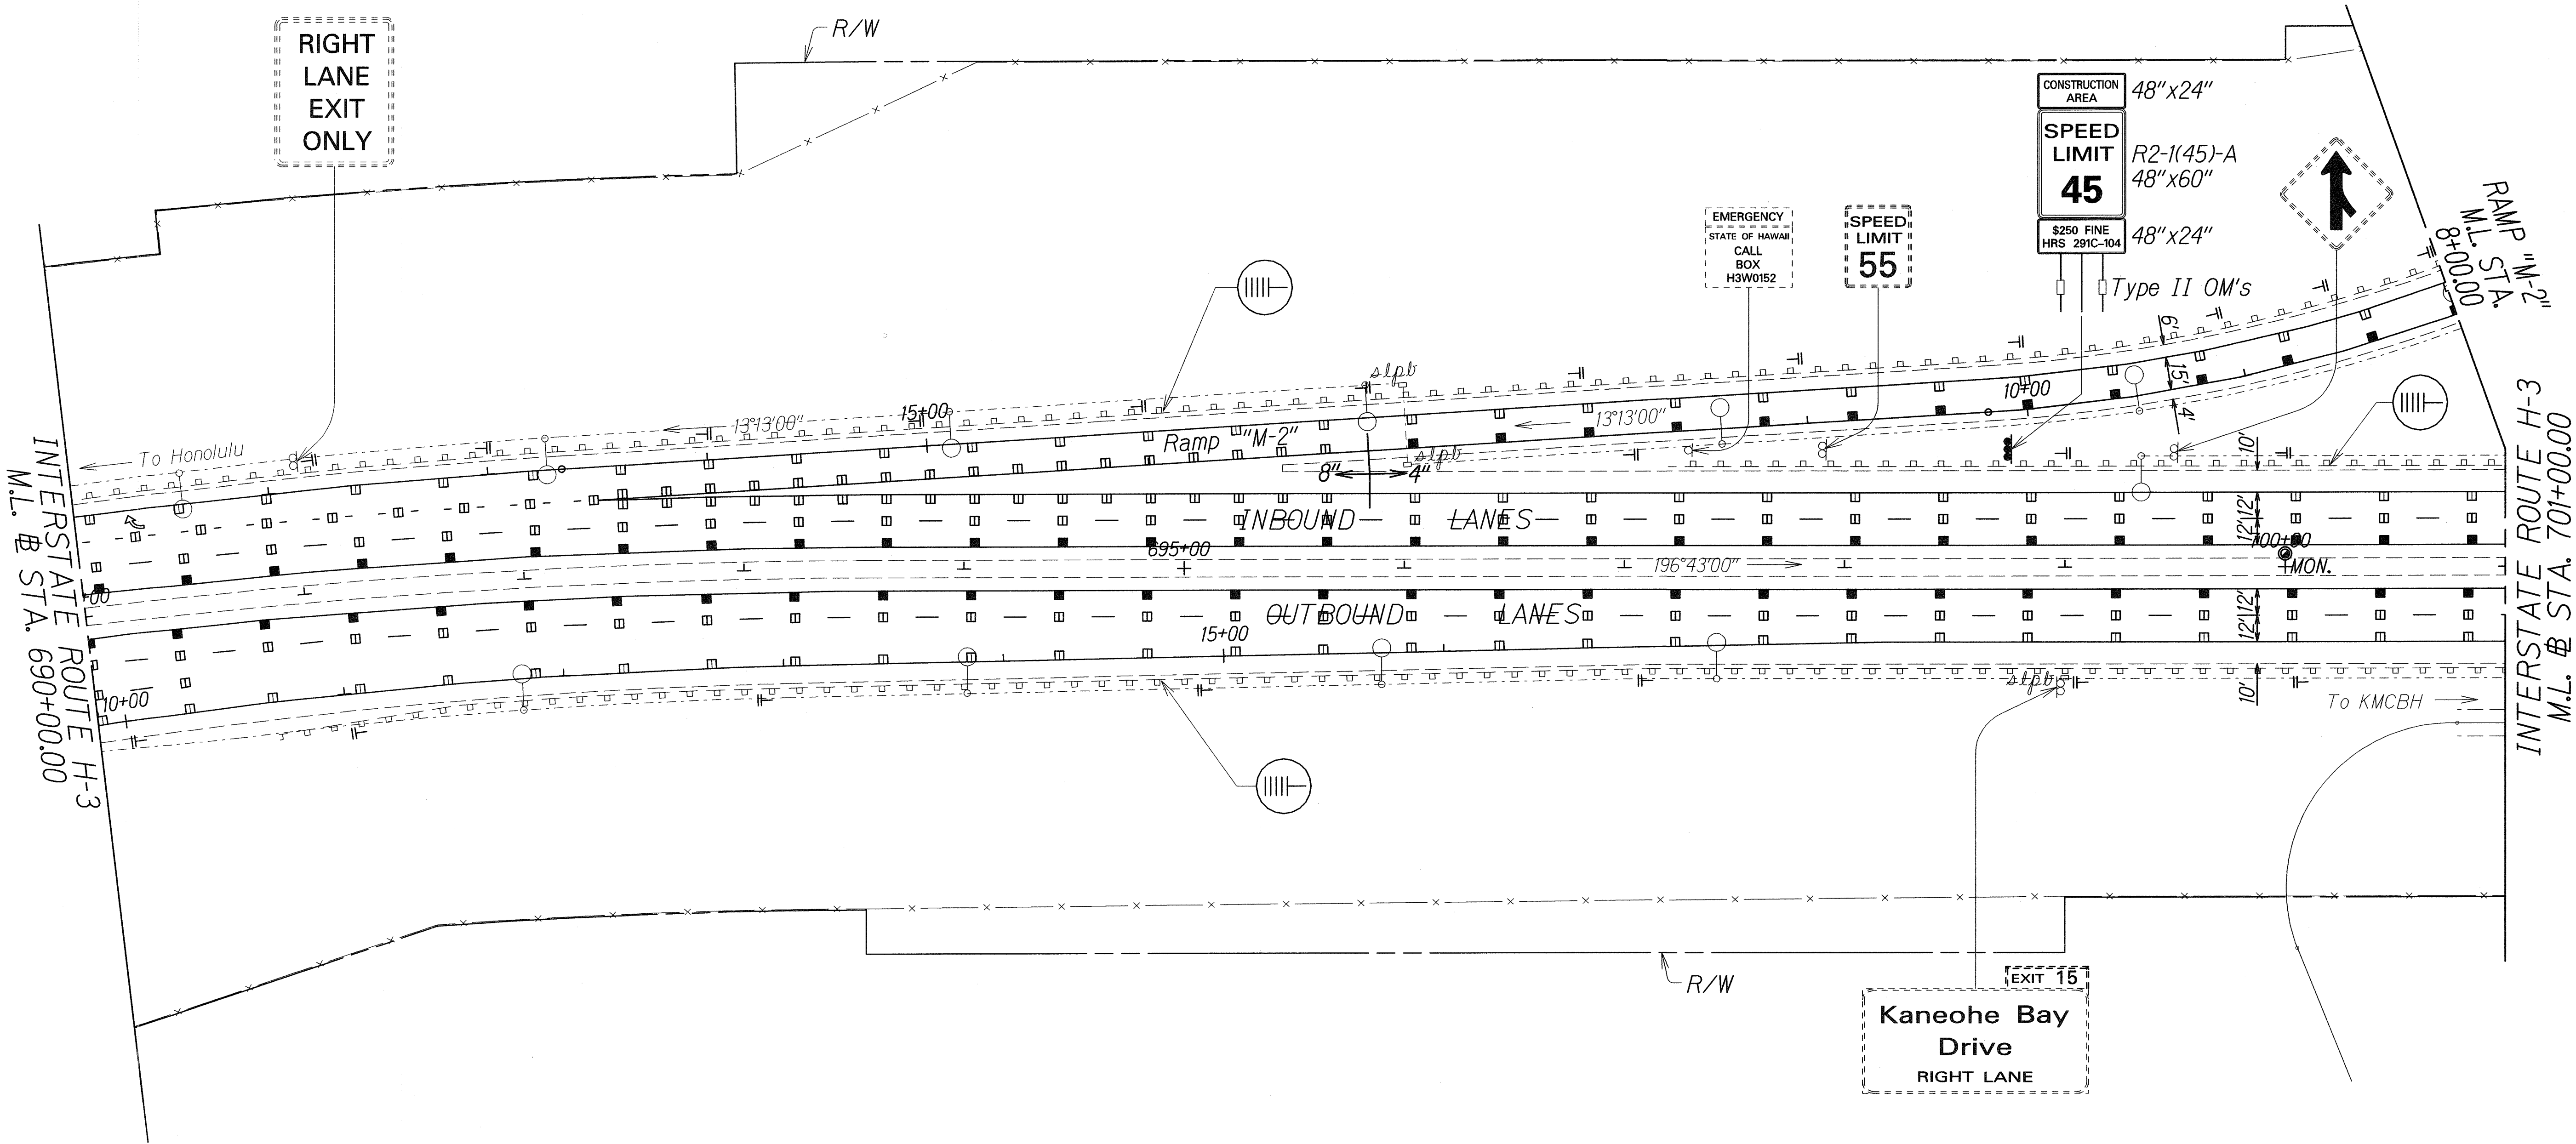

ORIGINAL PLAN	SURVEY PLOTTED BY	DATE
NOTED	DRAWN BY	
DESIGNED BY	TRACED BY	
CHECKED BY	CHECKED BY	
No. 4113122		

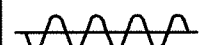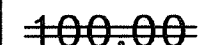
LEGEND FOR AS-BUILT POSTINGS	
	Squiggly line for as-built deletion
	Double line for as-built deletion
Roadway	Text for as-built posting

STATE OF HAWAII
 DEPARTMENT OF TRANSPORTATION
 HIGHWAYS DIVISION

PAVEMENT MARKING PLAN
 INTERSTATE ROUTE H-3 PAVEMENT
 PREVENTIVE MAINTENANCE
 Halekou Interchange to
 Kaneohe Marine Corps Base Hawaii
 F.A.I. Project No. IM-H3-1(80)
 Scale: 1"=40' Date: Aug. 2005

SHEET No. T24 OF 30 SHEETS

FED. ROAD DIST. NO.	STATE	FED. AID PROJ. NO.	FISCAL YEAR	SHEET NO.	TOTAL SHEETS
HAWAII	HAW.	IM-H3-1(80)	2006	59	66

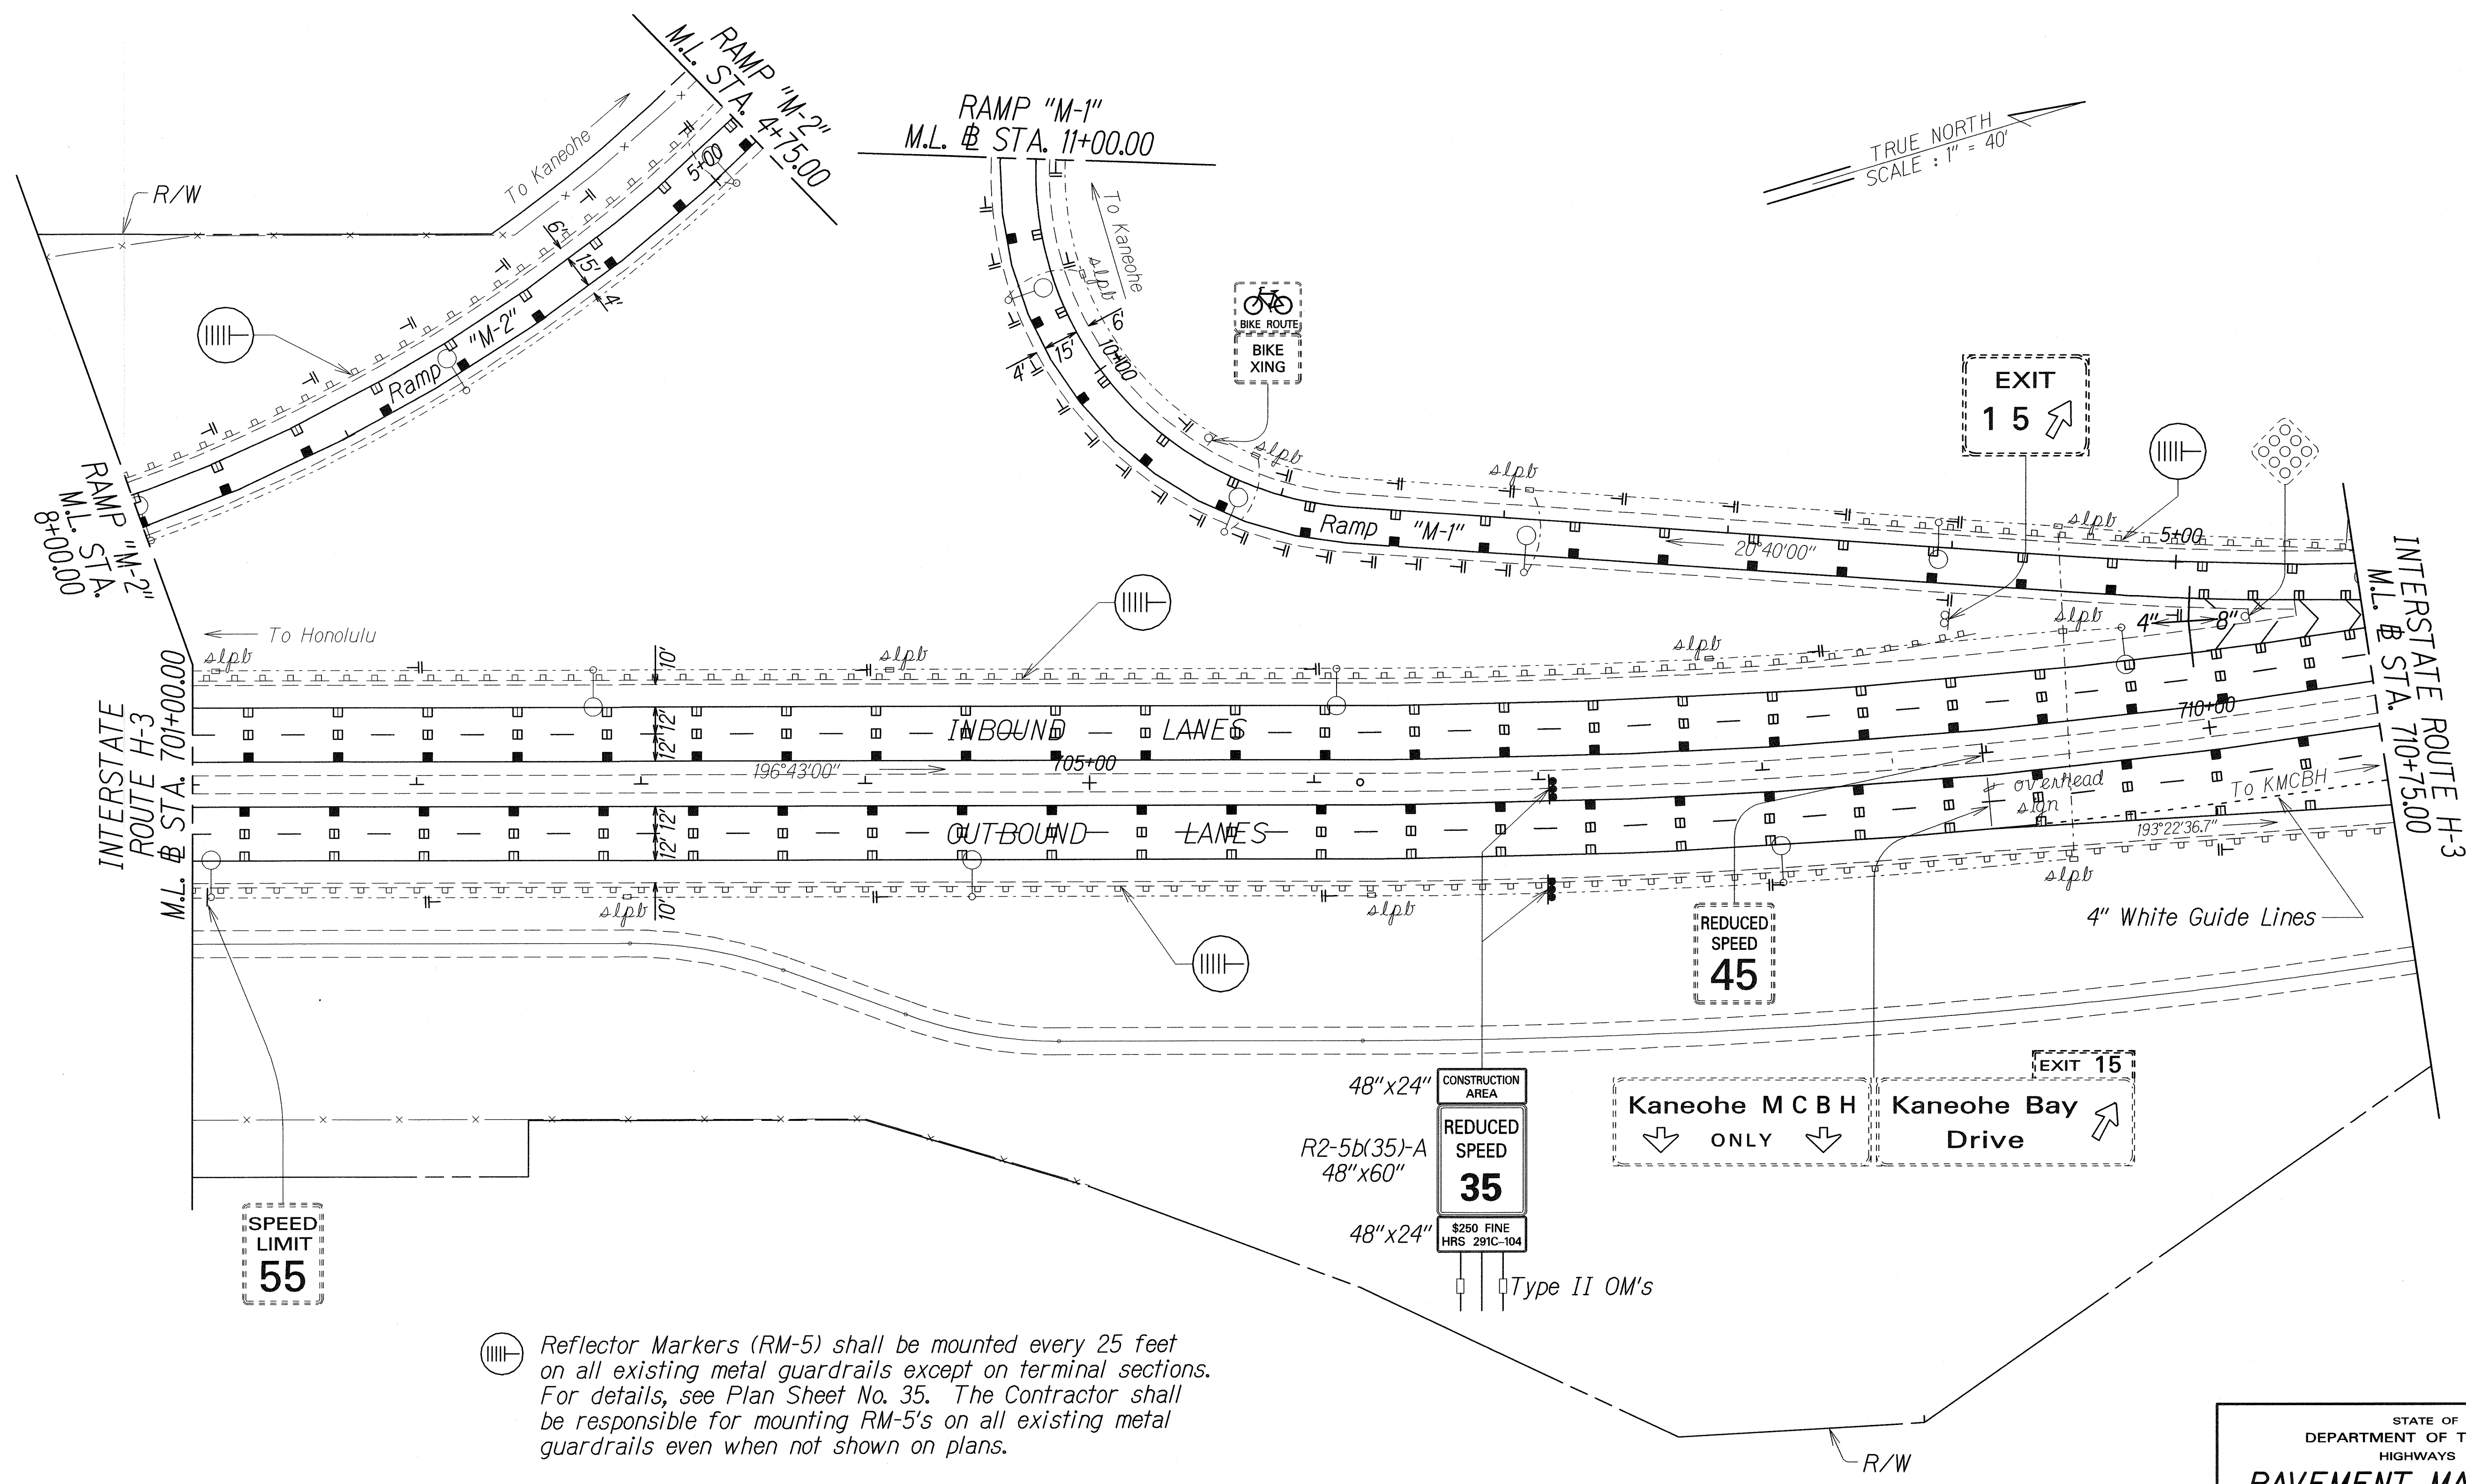

Reflector Markers (RM-5) shall be mounted every 25 feet on all existing metal guardrails except on terminal sections. For details, see Plan Sheet No. 35. The Contractor shall be responsible for mounting RM-5's on all existing metal guardrails even when not shown on plans.

ORIGINAL PLAN	SURVEY PLOTTED BY	DATE
NOTE BOOK	DRAWN BY	
10/1/05	DESIGNED BY	
4/13/02	CHECKED BY	


LEGEND FOR AS-BUILT POSTINGS	
	Squiggly line for as-built deletion
	Double line for as-built deletion
Roadway	Text for as-built posting

STATE OF HAWAII
 DEPARTMENT OF TRANSPORTATION
 HIGHWAYS DIVISION

PAVEMENT MARKING PLAN
 INTERSTATE ROUTE H-3 PAVEMENT
 PREVENTIVE MAINTENANCE
 Halekou Interchange to
 Kaneohe Marine Corps Base Hawaii
 Federal Aid Project No. IM-H3-1(80)
 Scale: 1"=40'

Date: Aug. 2005
 SHEET No. T25 OF 30 SHEETS

FED. ROAD DIST. NO.	STATE	FED. AID PROJ. NO.	FISCAL YEAR	SHEET NO.	TOTAL SHEETS
HAWAII	HAW.	IM-H3-1(80)	2006	60	66

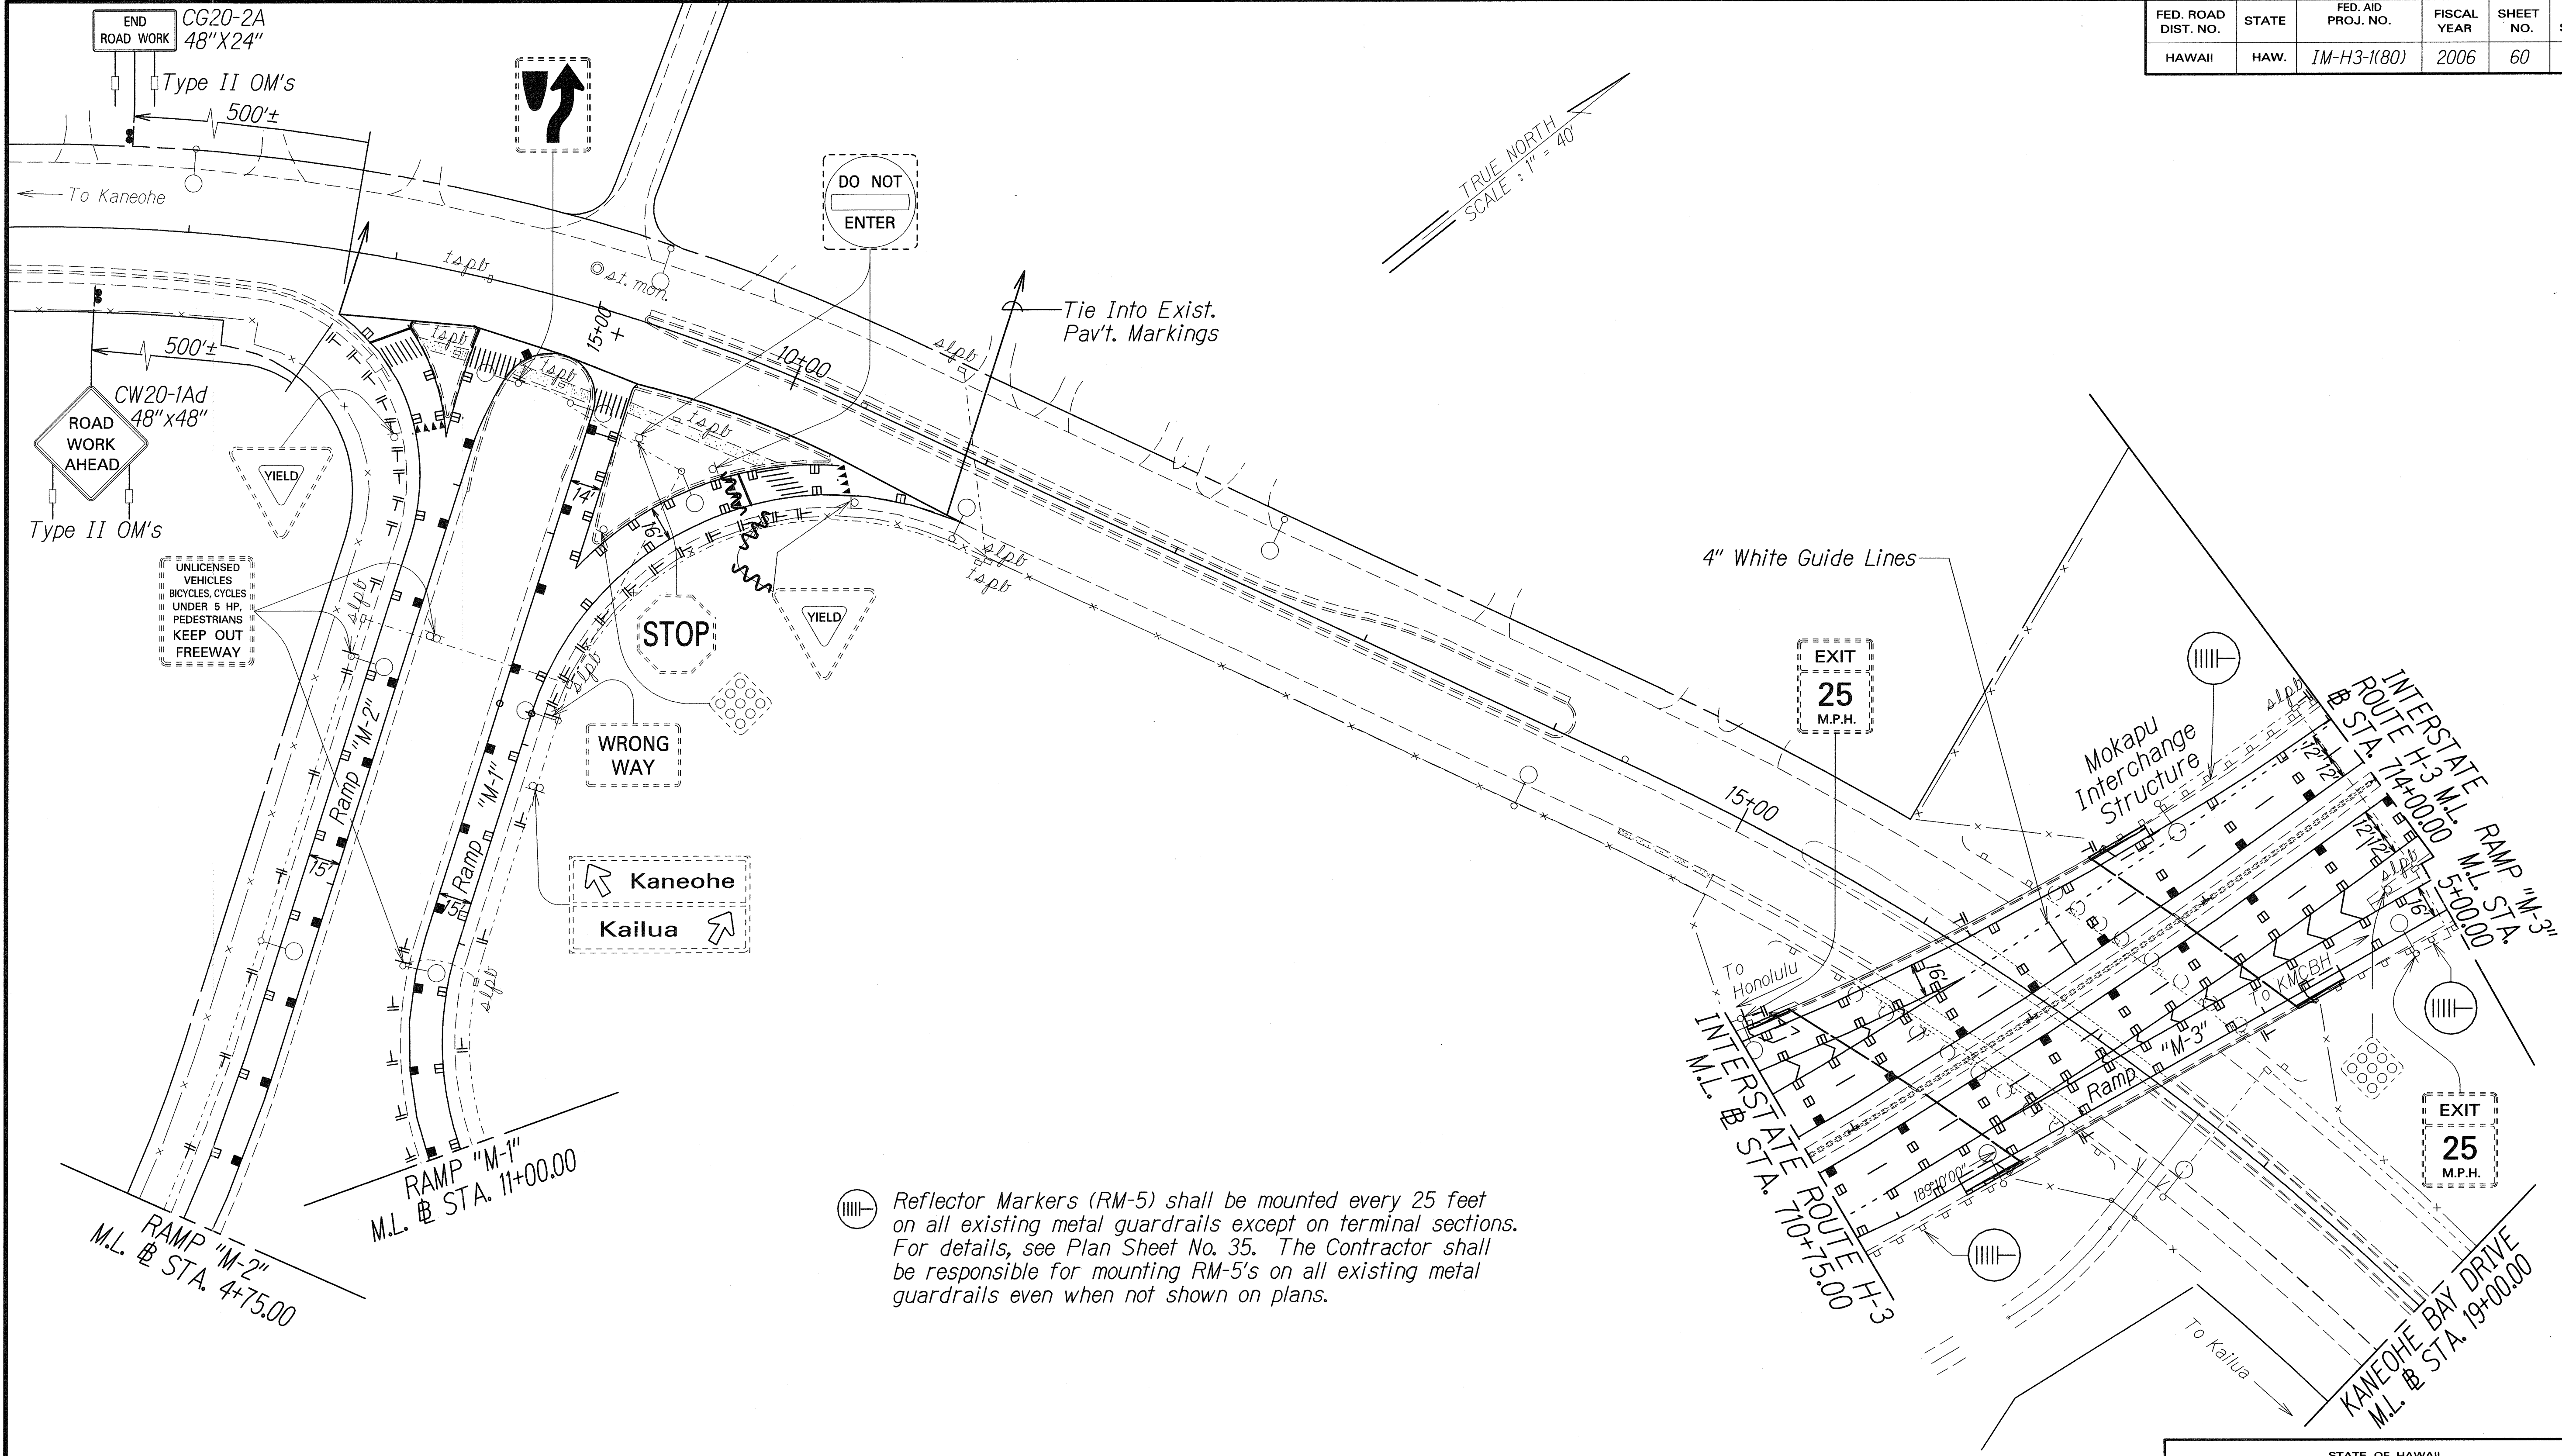

ORIGINAL PLAN	SURVEY PLOTTED BY	DATE
NOTE BOOK	DRAWN BY	
10/1/06	DESIGNED BY	
4/13/06	CHECKED BY	

Reflector Markers (RM-5) shall be mounted every 25 feet on all existing metal guardrails except on terminal sections. For details, see Plan Sheet No. 35. The Contractor shall be responsible for mounting RM-5's on all existing metal guardrails even when not shown on plans.

LEGEND FOR AS-BUILT POSTINGS	
	Squiggly line for as-built deletion
	Double line for as-built deletion
Roadway	Text for as-built posting


STATE OF HAWAII
DEPARTMENT OF TRANSPORTATION
HIGHWAYS DIVISION

PAVEMENT MARKING PLAN
INTERSTATE ROUTE H-3 PAVEMENT PREVENTIVE MAINTENANCE
Halekou Interchange to Kaneohe Marine Corps Base Hawaii
Federal Aid Project No. IM-H3-1(80)

Scale: 1"=40' Date: Aug. 2005

SHEET No. T26 OF 30 SHEETS

FED. ROAD DIST. NO.	STATE	FED. AID PROJ. NO.	FISCAL YEAR	SHEET NO.	TOTAL SHEETS
HAWAII	HAW.	1M-H3-1(80)	2006	61	66

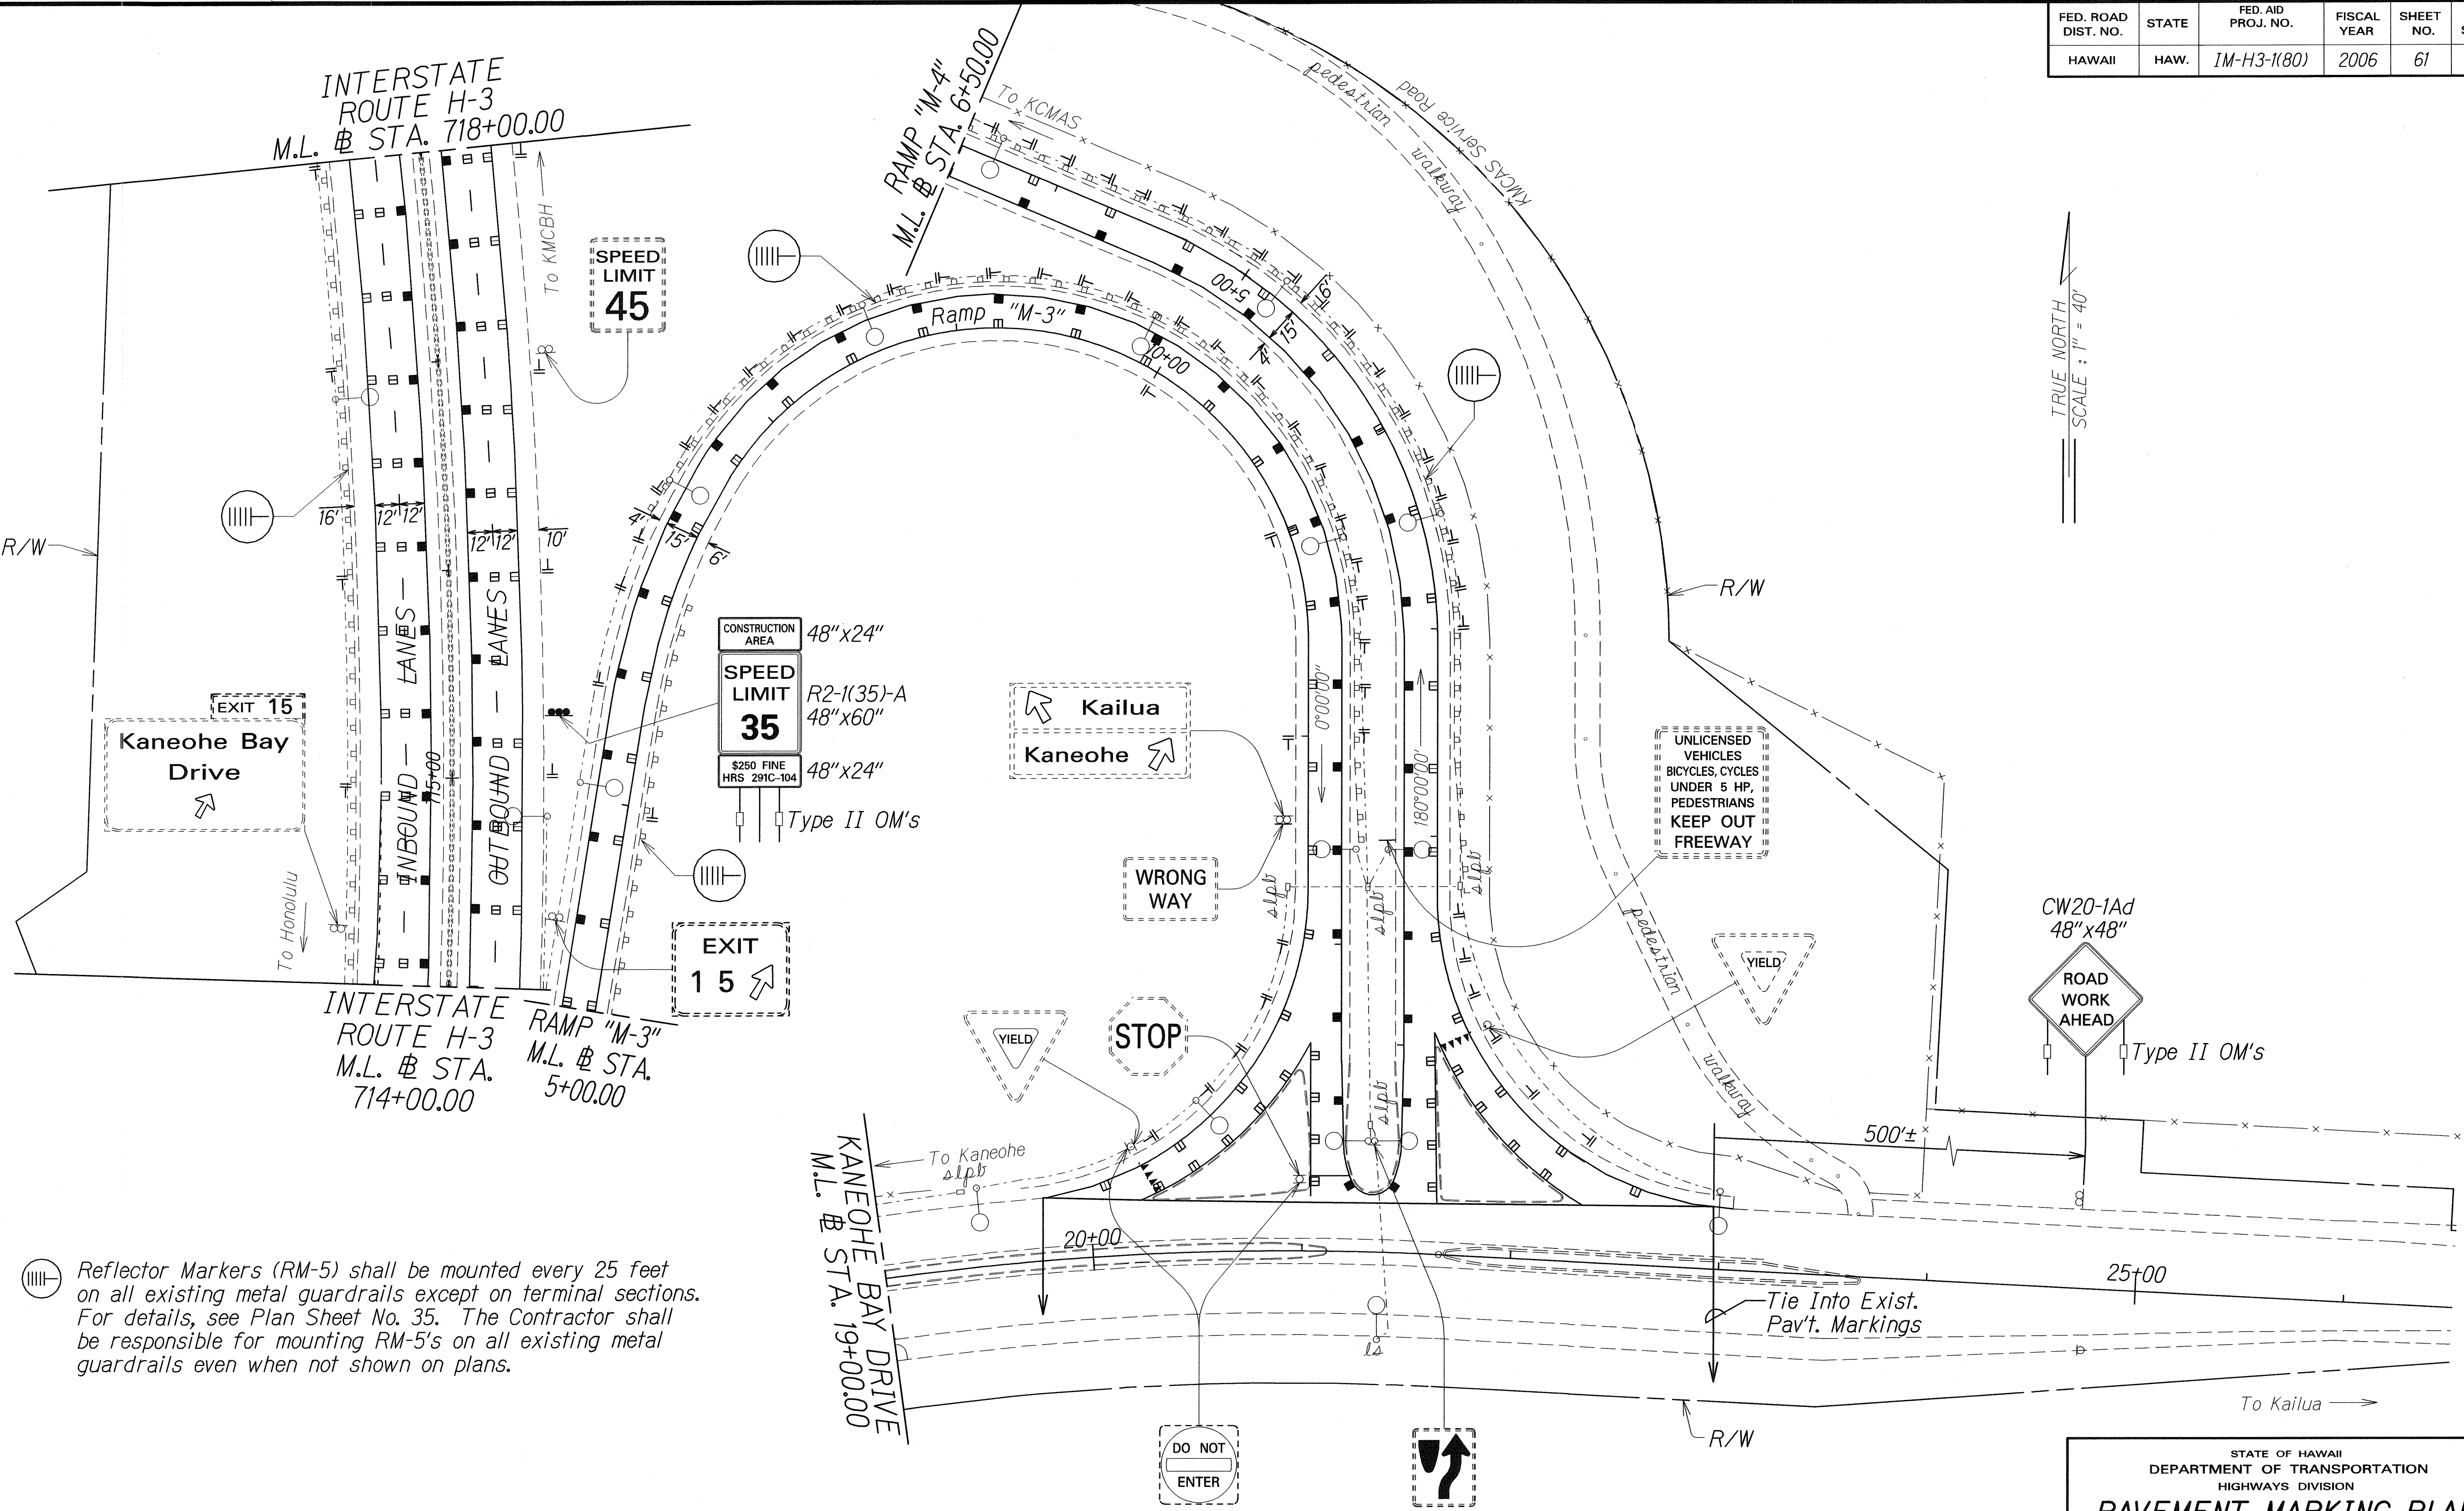

⦿ Reflector Markers (RM-5) shall be mounted every 25 feet on all existing metal guardrails except on terminal sections. For details, see Plan Sheet No. 35. The Contractor shall be responsible for mounting RM-5's on all existing metal guardrails even when not shown on plans.

ORIGINAL PLAN	SURVEY PLOTTED BY	DATE
NOTE BOOK	DRAWN BY	
10/1/06	DESIGNED BY	
10/1/06	CHECKED BY	

LEGEND FOR AS-BUILT POSTINGS	
	Squiggly line for as-built deletion
	Double line for as-built deletion
Roadway	Text for as-built posting

STATE OF HAWAII
DEPARTMENT OF TRANSPORTATION
HIGHWAYS DIVISION


PAVEMENT MARKING PLAN
INTERSTATE ROUTE H-3 PAVEMENT
PREVENTIVE MAINTENANCE
Halekou Interchange to
Kaneohe Marine Corps Base Hawaii
Federal Aid Project No. 1M-H3-1(80)
Scale: 1"=40' Date: Aug. 2005

SHEET No. 727 OF 30 SHEETS

FED. ROAD DIST. NO.	STATE	FED. AID PROJ. NO.	FISCAL YEAR	SHEET NO.	TOTAL SHEETS
HAWAII	HAW.	IM-H3-1(80)	2006	62	66

Reflector Markers (RM-5) shall be mounted every 25 feet on all existing metal guardrails except on terminal sections. For details, see Plan Sheet No. 35. The Contractor shall be responsible for mounting RM-5's on all existing metal guardrails even when not shown on plans.

TRUE NORTH
SCALE: 1" = 40'

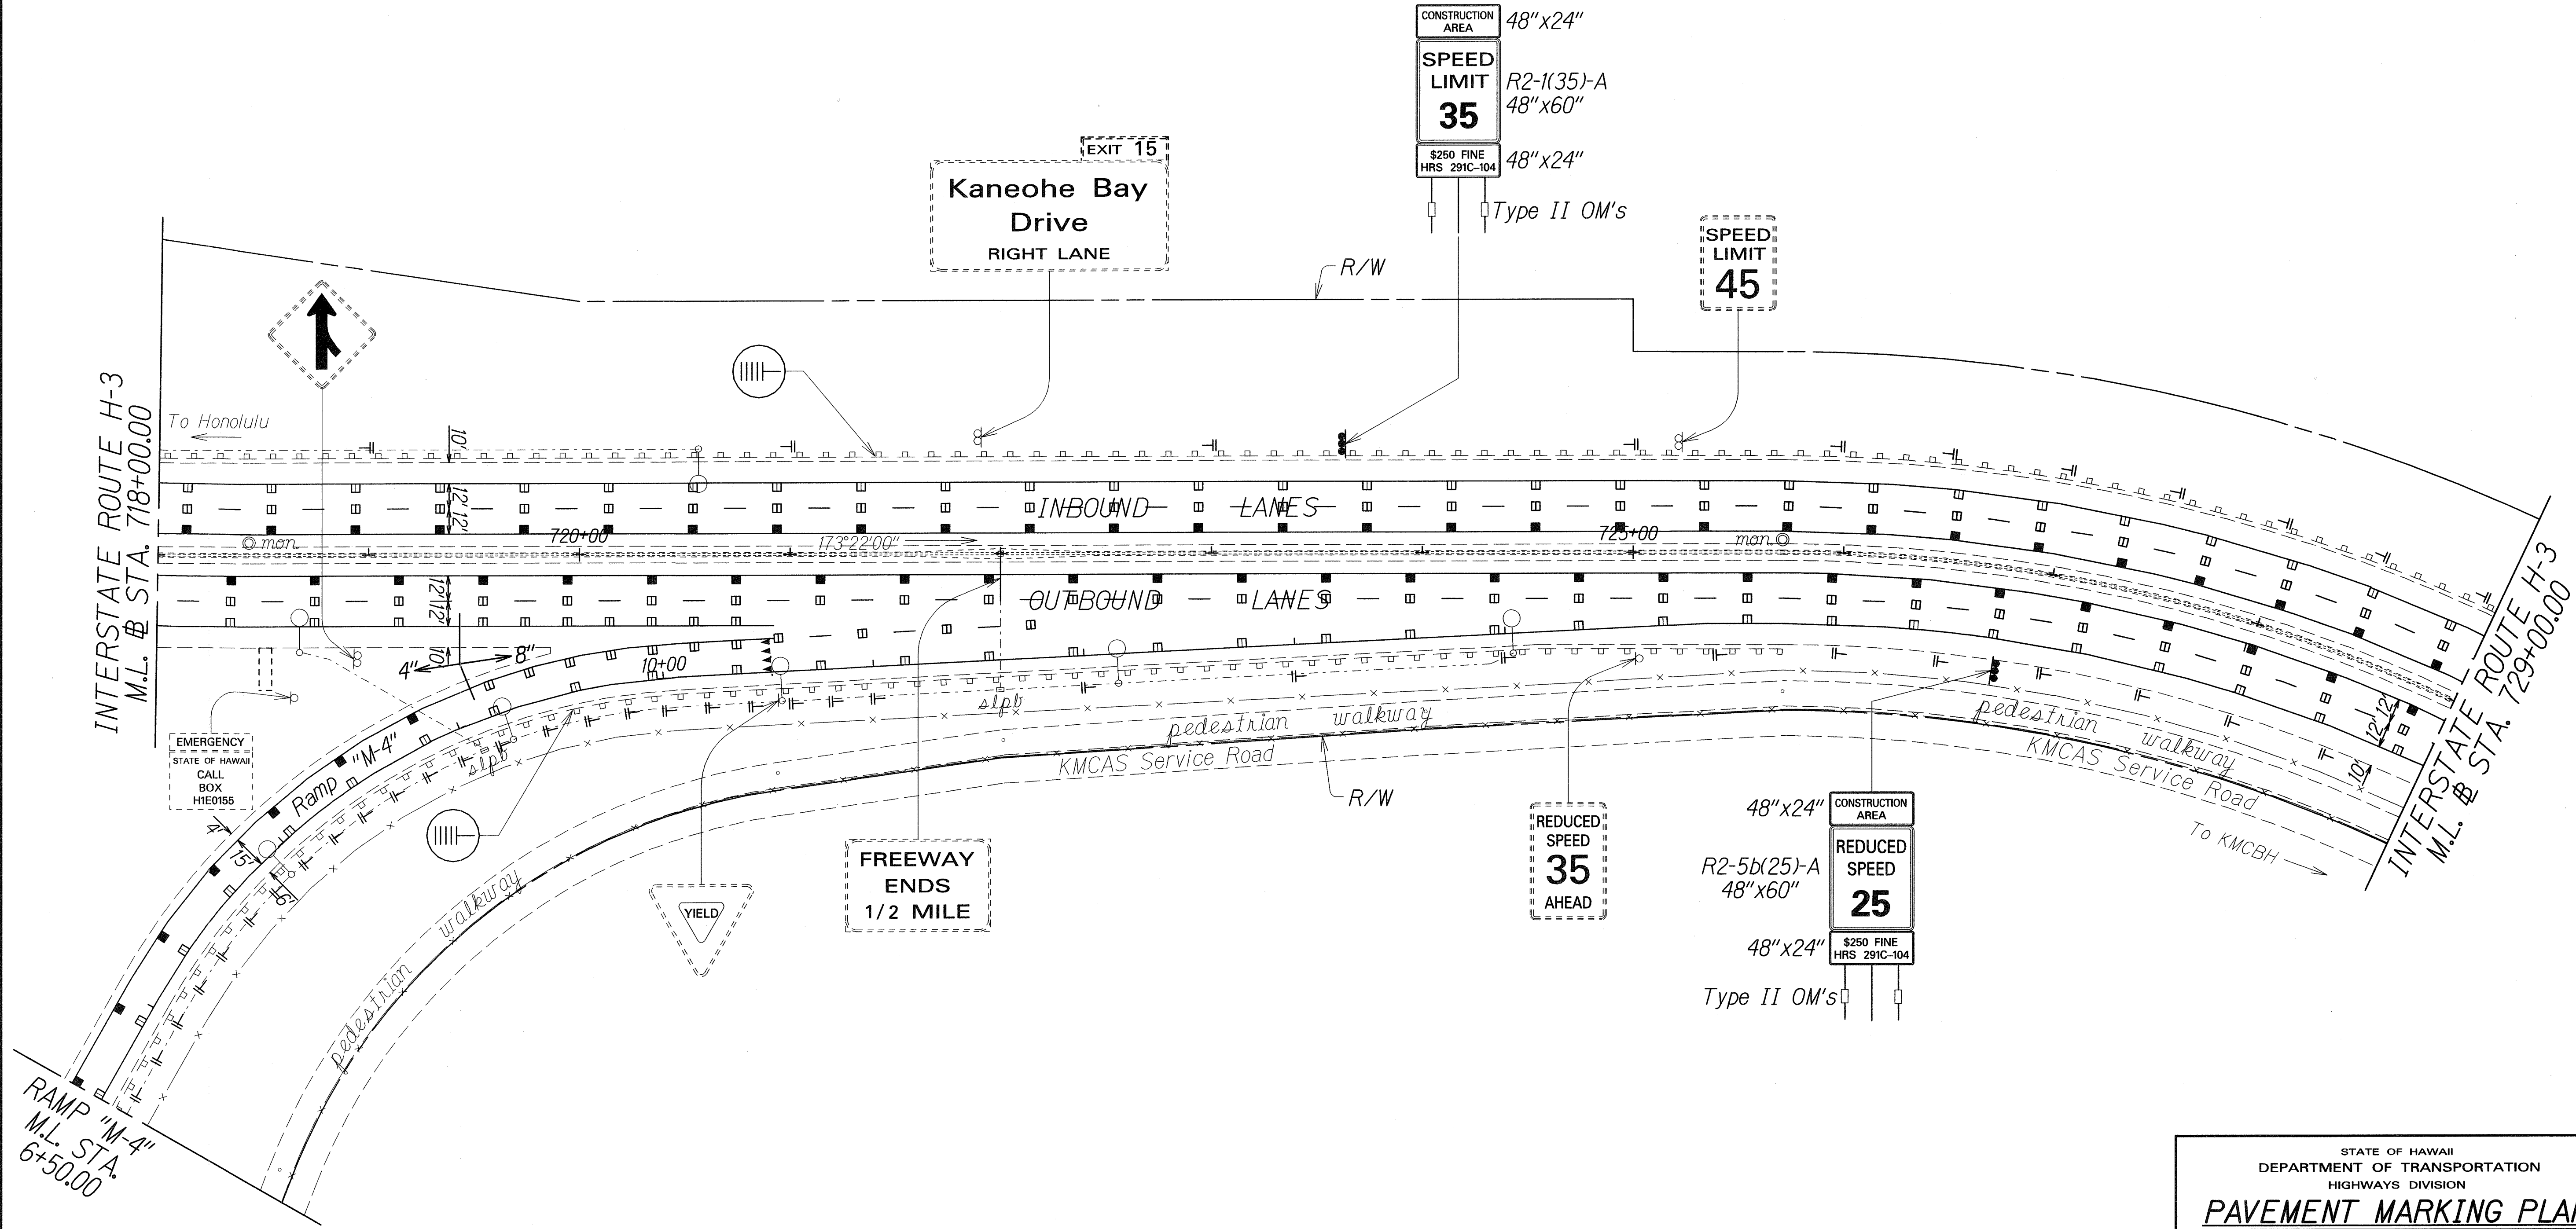

ORIGINAL PLAN	SURVEY PLOTTED BY	DATE
NOTE BOOK	DRAWN BY	
DESIGNED BY		
CHECKED BY		

LEGEND FOR AS-BUILT POSTINGS	
	Squiggly line for as-built deletion
	Double line for as-built deletion
Roadway	Text for as-built posting

STATE OF HAWAII
DEPARTMENT OF TRANSPORTATION
HIGHWAYS DIVISION

PAVEMENT MARKING PLAN
INTERSTATE ROUTE H-3 PAVEMENT PREVENTIVE MAINTENANCE
Halekou Interchange to Kaneohe Marine Corps Base Hawaii
Federal Aid Project No. IM-H3-1(80)

Scale: 1"=40' Date: Aug. 2005



SHEET No. 728 OF 30 SHEETS

FED. ROAD DIST. NO.	STATE	FED. AID PROJ. NO.	FISCAL YEAR	SHEET NO.	TOTAL SHEETS
HAWAII	HAW.	IM-H3-1(80)	2006	63	66

Reflector Markers (RM-5) shall be mounted every 25 feet on all existing metal guardrails except on terminal sections. For details, see Plan Sheet No. 35. The Contractor shall be responsible for mounting RM-5's on all existing metal guardrails even when not shown on plans.

LEGEND FOR AS-BUILT POSTINGS

Squiggly line for as-built deletion
 Double line for as-built deletion
 Roadway Text for as-built posting

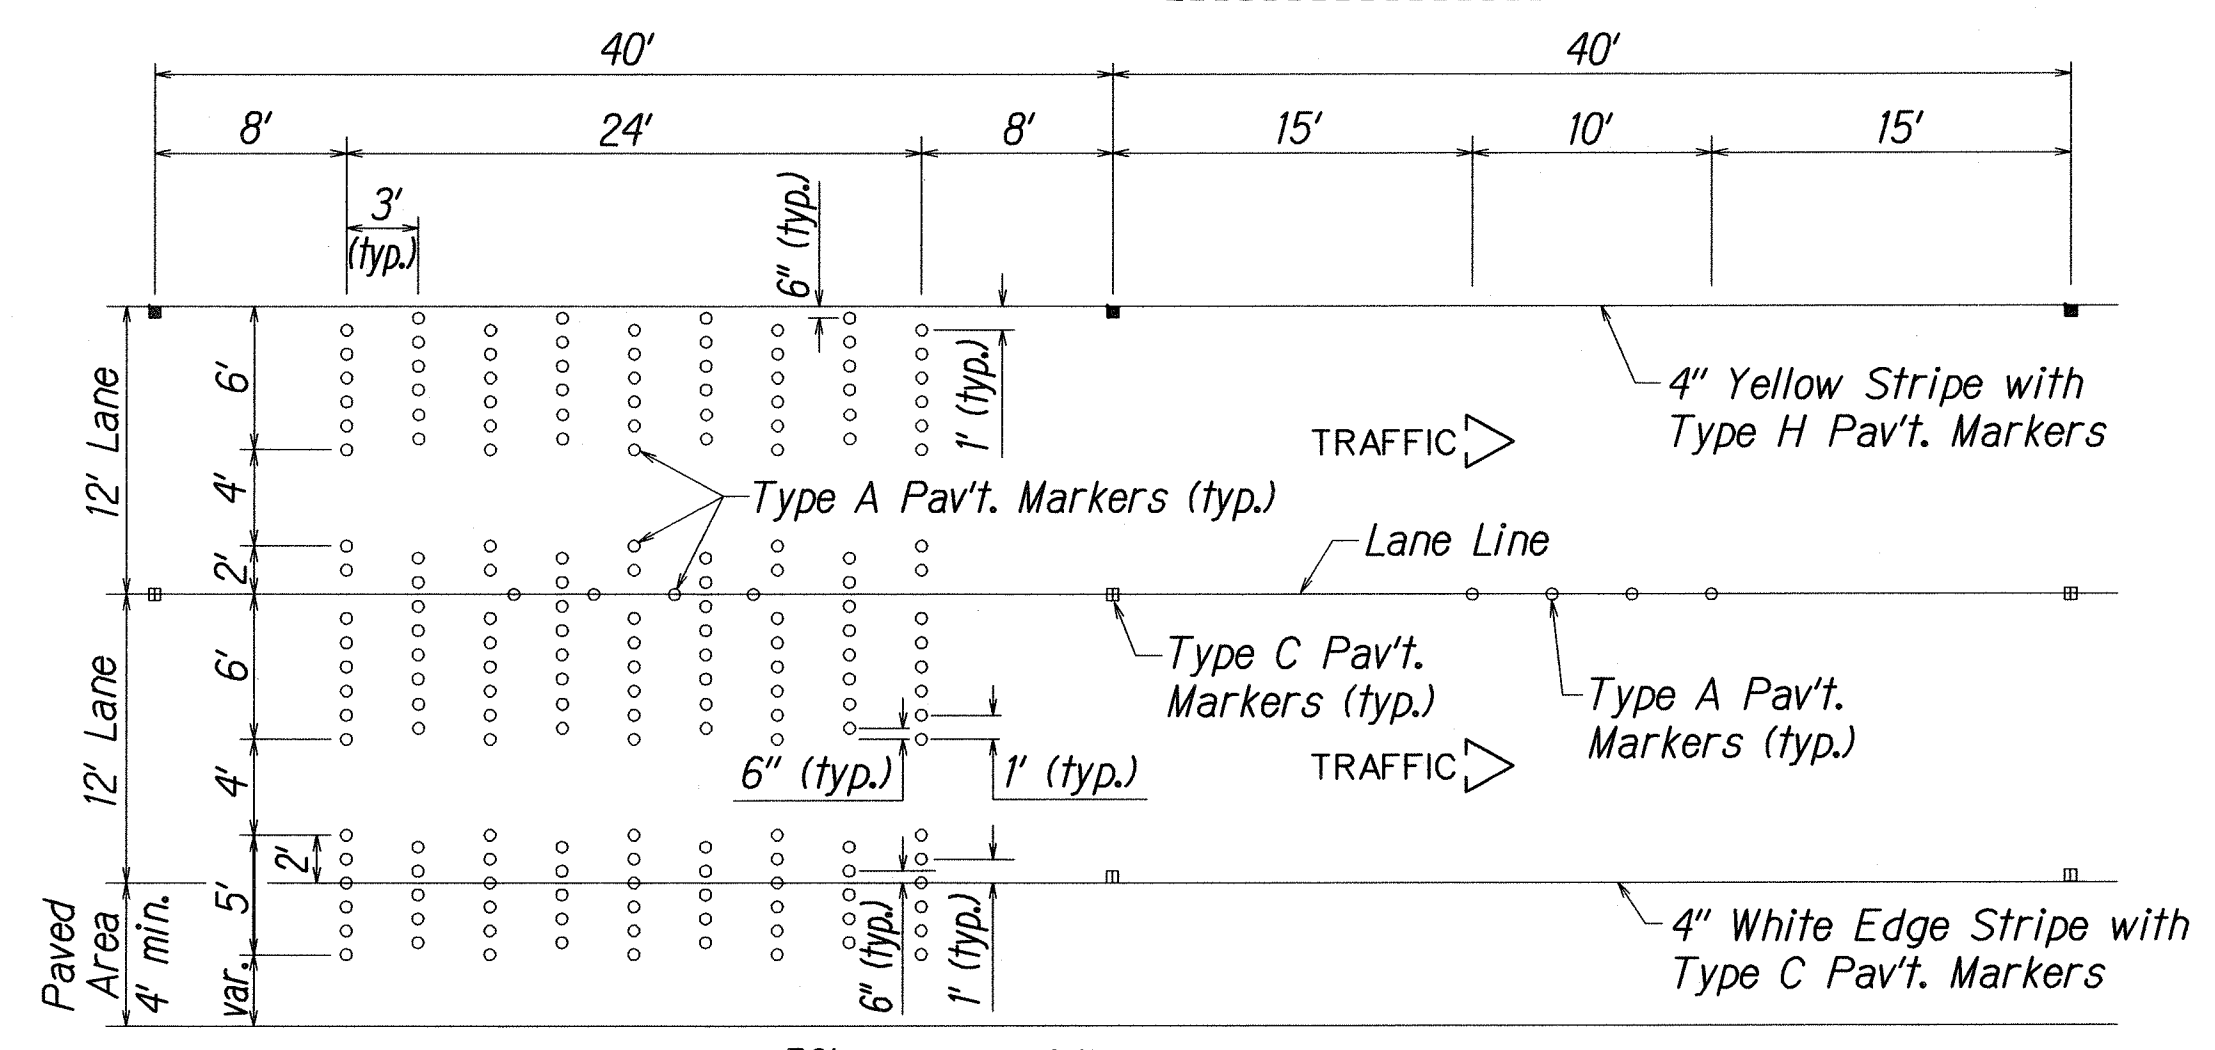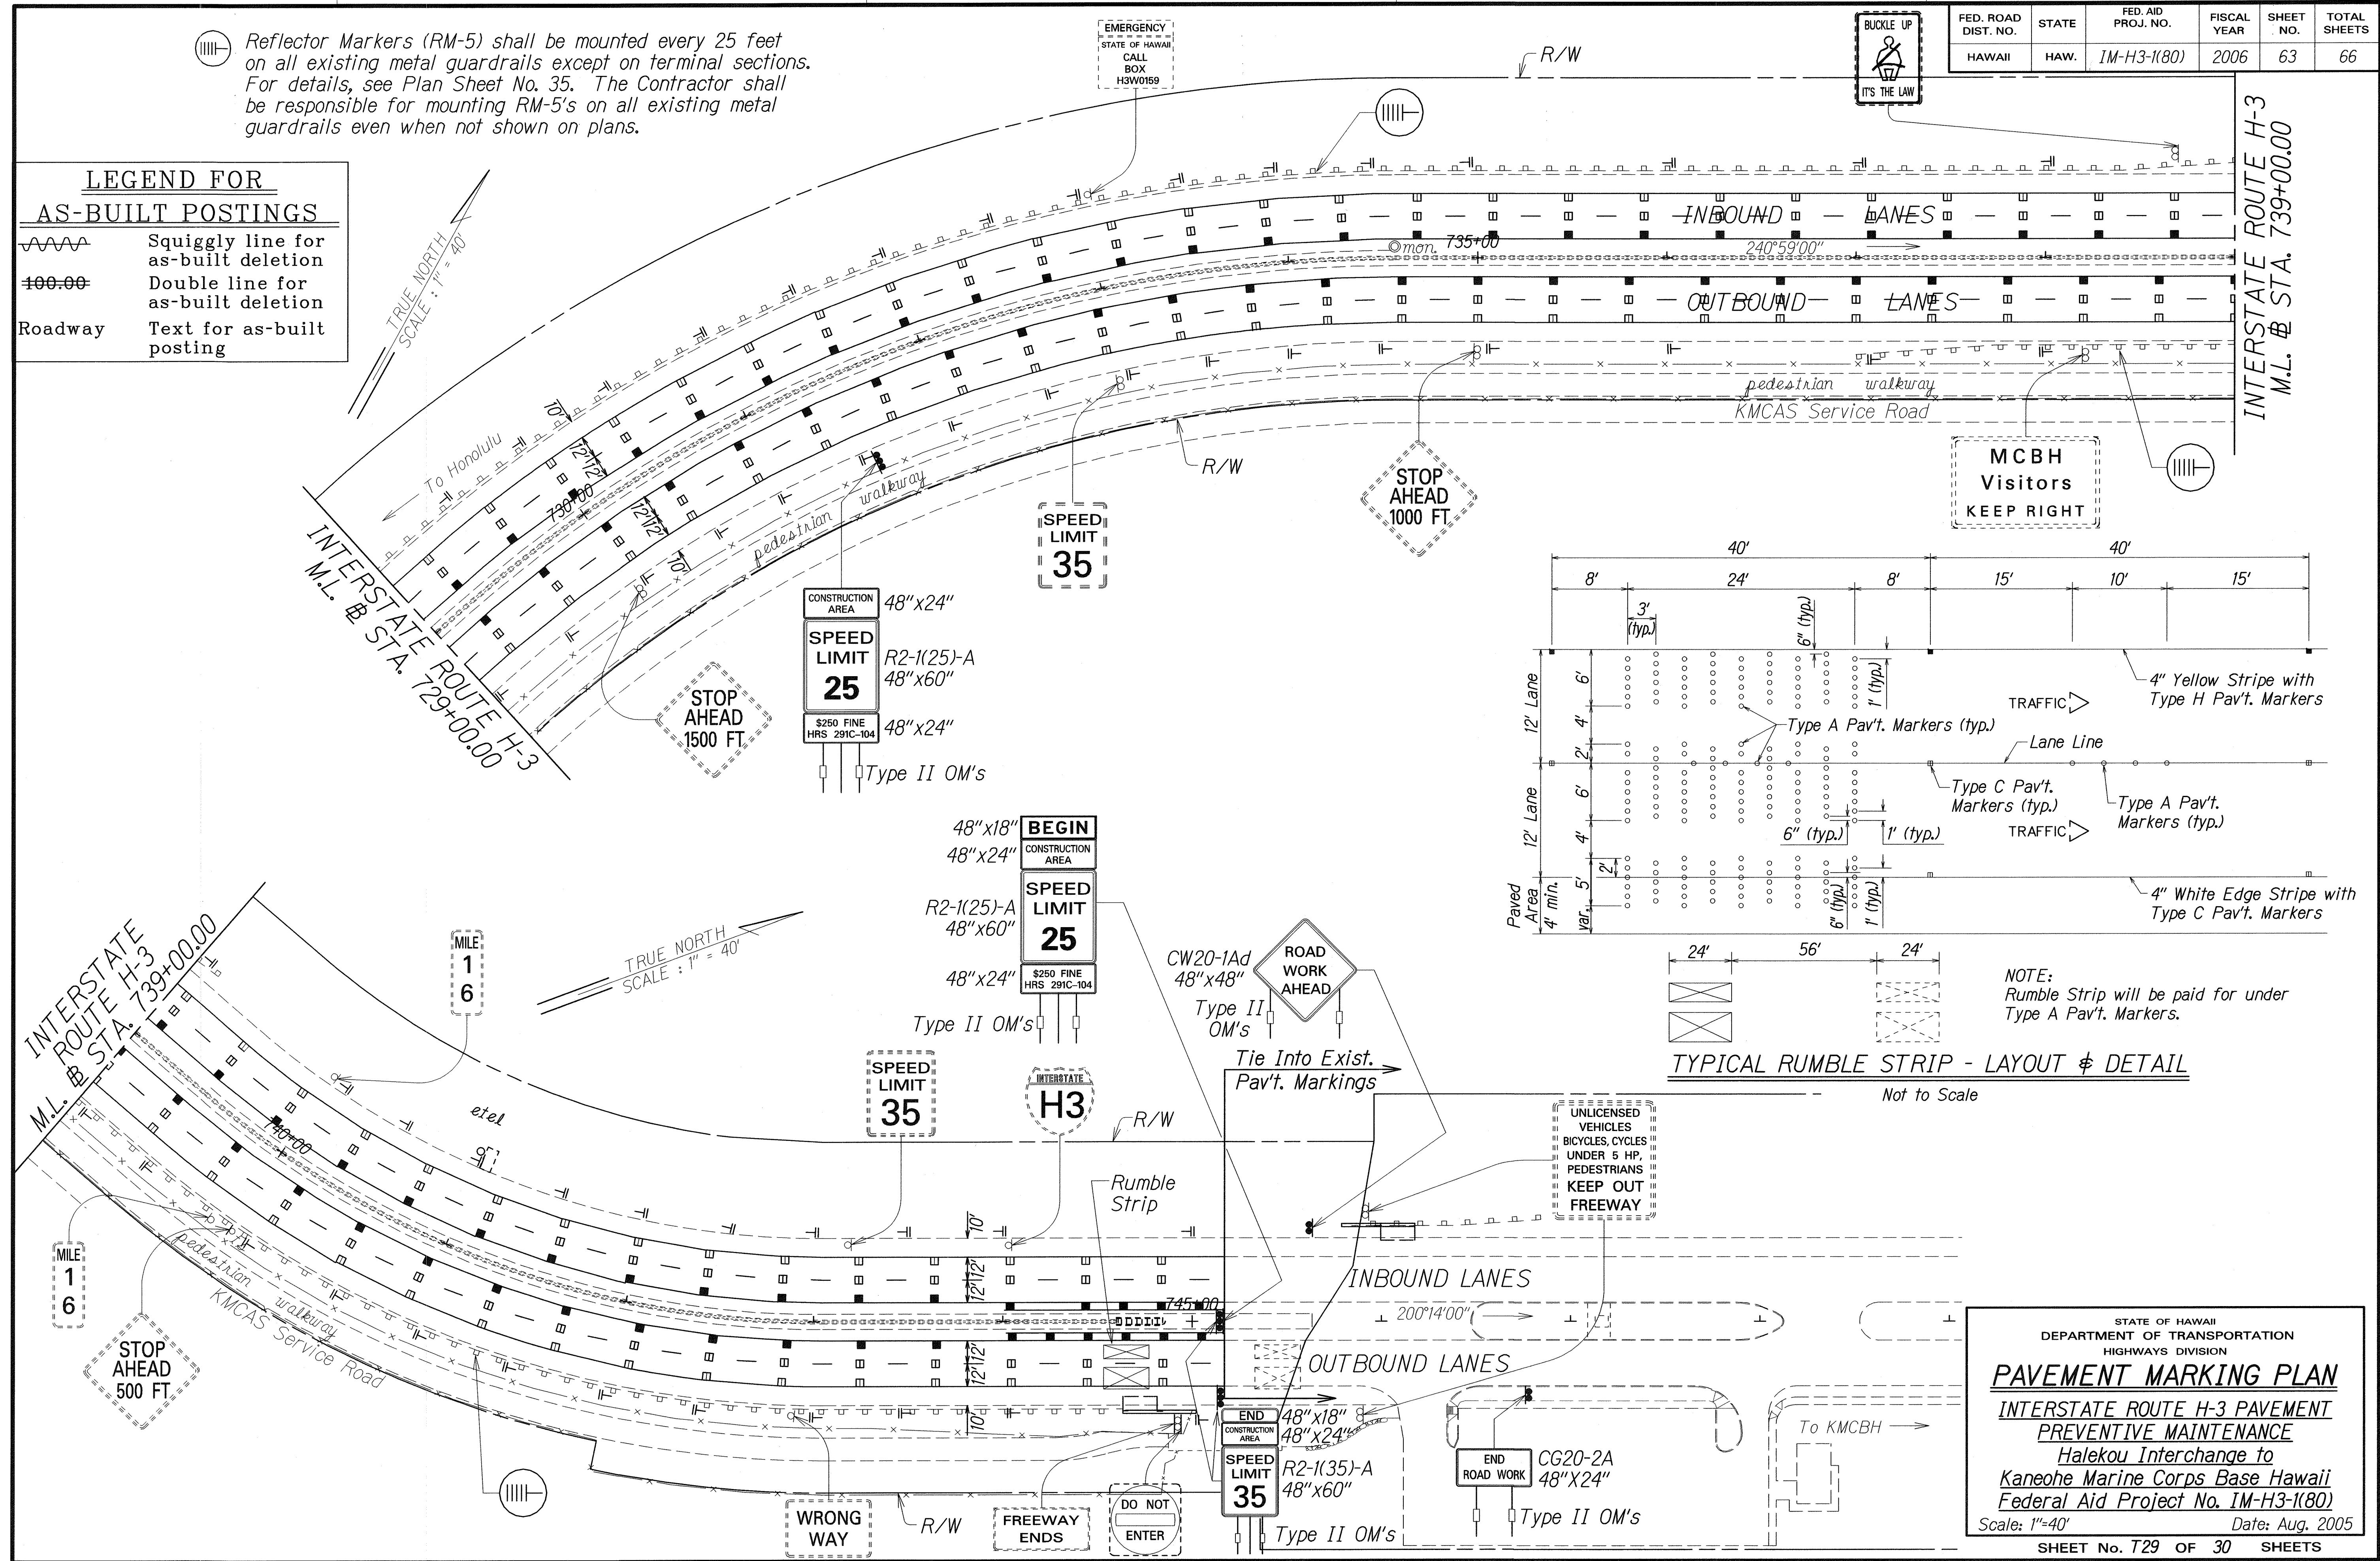

NOTE:
 Rumble Strip will be paid for under Type A Pav't. Markers.

TYPICAL RUMBLE STRIP - LAYOUT & DETAIL
Not to Scale

ORIGINAL PLAN	SURVEY PLOTTED BY	DATE
NOTED WORK	DRAWN BY	
DESIGNED BY	TRACED BY	
CHECKED BY	DESIGNED BY	

STATE OF HAWAII
 DEPARTMENT OF TRANSPORTATION
 HIGHWAYS DIVISION
PAVEMENT MARKING PLAN
 INTERSTATE ROUTE H-3 PAVEMENT PREVENTIVE MAINTENANCE
 Halekou Interchange to Kaneohe Marine Corps Base Hawaii
 Federal Aid Project No. IM-H3-1(80)
 Scale: 1"=40' Date: Aug. 2005
 SHEET No. T29 OF 30 SHEETS

"AS-BUILT"