


CURVE DATA						
	H1	A1	A2	B	F2	H
Δ	42°16'00"	23°33'14"	57°23'16"	28°02'40"	184°42'32"	120°59'30"
R	2,000.00'	1,300.00'	112.00'	225.00'	230.00'	230.00'
T	773.07'	271.04'	61.30'	56.19'		406.45'
C	1,442.16'	530.66'	107.55'	109.03'	459.61'	400.35'
Lc	1,475.39'	534.42'	112.18'	110.13'	741.47'	485.69'

FED. ROAD DIST. NO.	STATE	FED. AID PROJ. NO.	FISCAL YEAR	SHEET NO.	TOTAL SHEETS
HAWAII	HAW.	IM-H3-1(80)	2006	ADD.9	66

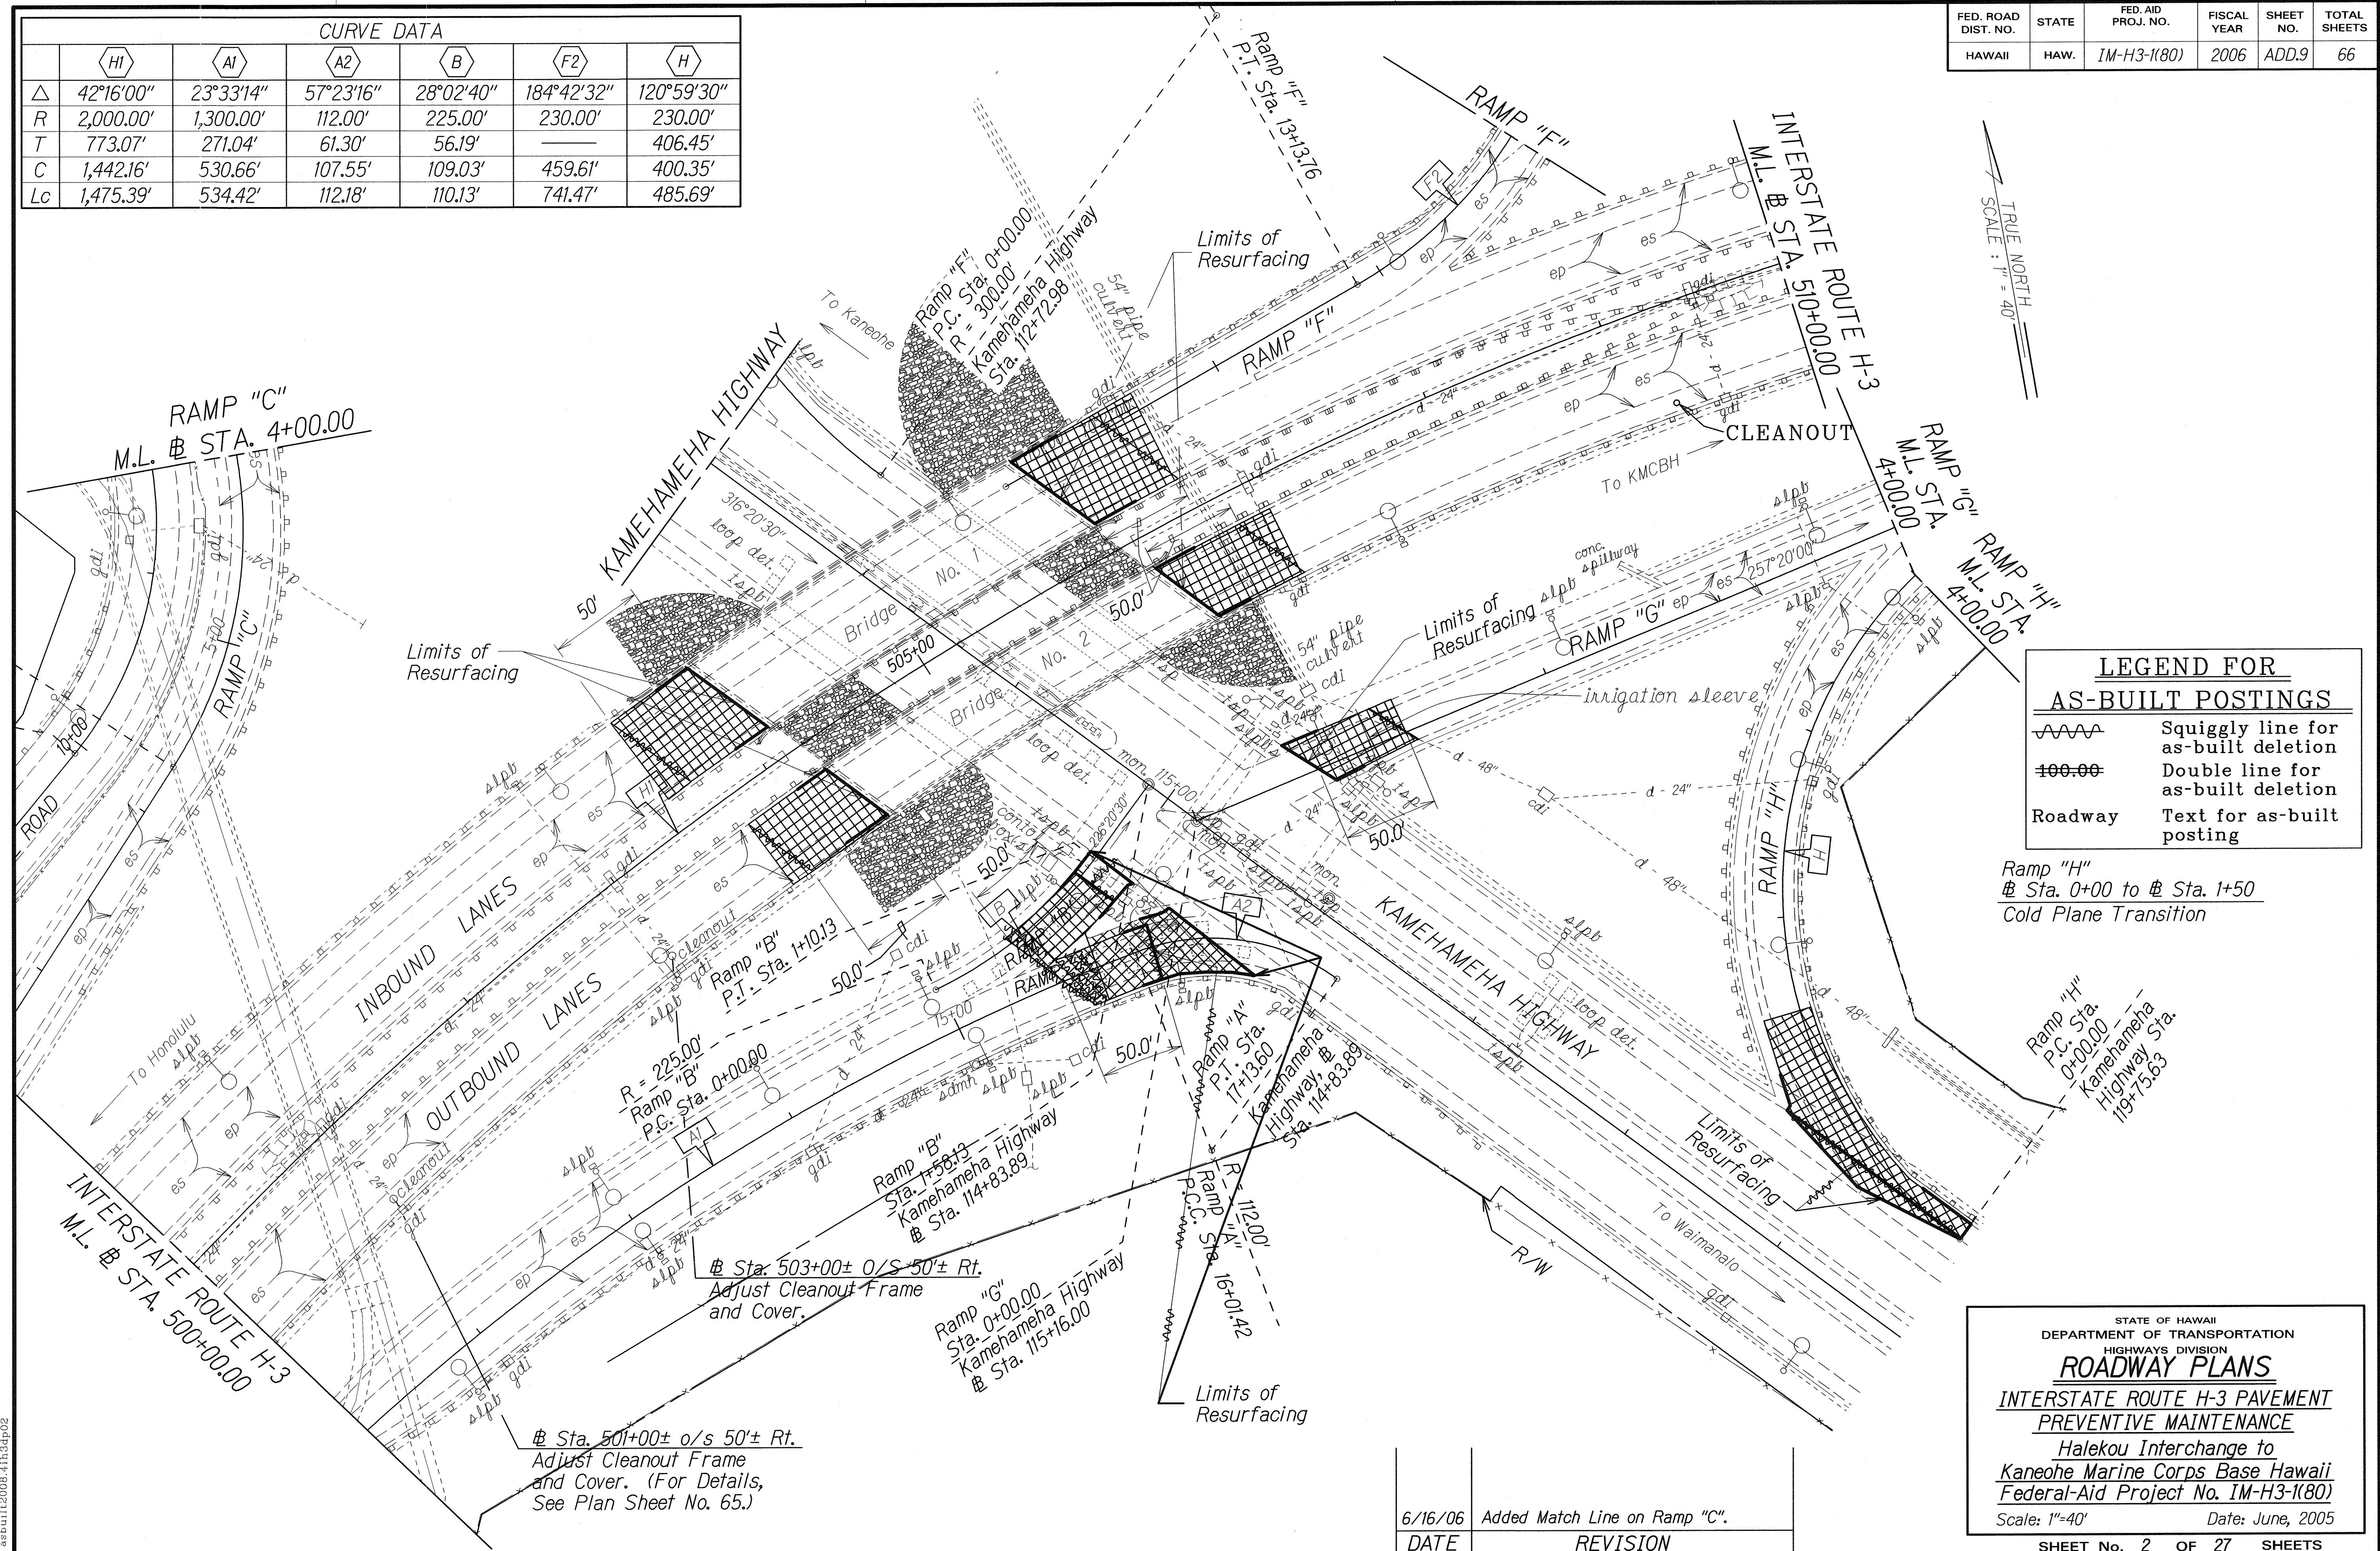

SURVEY PLOTTED BY	DATE
DRAWN BY	
DESIGNED BY	
CHECKED BY	
NOTE BOOK	
DATE	

asbuilt2008.4th3dp02


6/16/06	Added Match Line on Ramp "C".
DATE	REVISION

STATE OF HAWAII
DEPARTMENT OF TRANSPORTATION
HIGHWAYS DIVISION
ROADWAY PLANS
INTERSTATE ROUTE H-3 PAVEMENT PREVENTIVE MAINTENANCE
Halekou Interchange to
Kaneohe Marine Corps Base Hawaii
Federal-Aid Project No. IM-H3-1(80)
Scale: 1"=40' Date: June, 2005
SHEET No. 2 OF 27 SHEETS

FED. ROAD DIST. NO.	STATE	FED. AID PROJ. NO.	FISCAL YEAR	SHEET NO.	TOTAL SHEETS
HAWAII	HAW.	IM-H3-1(80)	2006	ADD. 10	66

	CURVE DATA				
	H1	H	D1	G1	G2
Δ	42°16'00"	120°59'30"	28°31'08"	10°10'00"	5°23'00"
R	2,000.00'	230.00'	1,000.00'	2,000.00'	950.00'
T	773.07'	406.45'	254.14'	177.91'	44.66'
C	1,442.16'	400.35'	492.63'	354.42'	89.23'
Lc	1,475.39'	485.69'	497.75'	354.88'	89.26'

TRUE NORTH
SCALE: 1"=40'

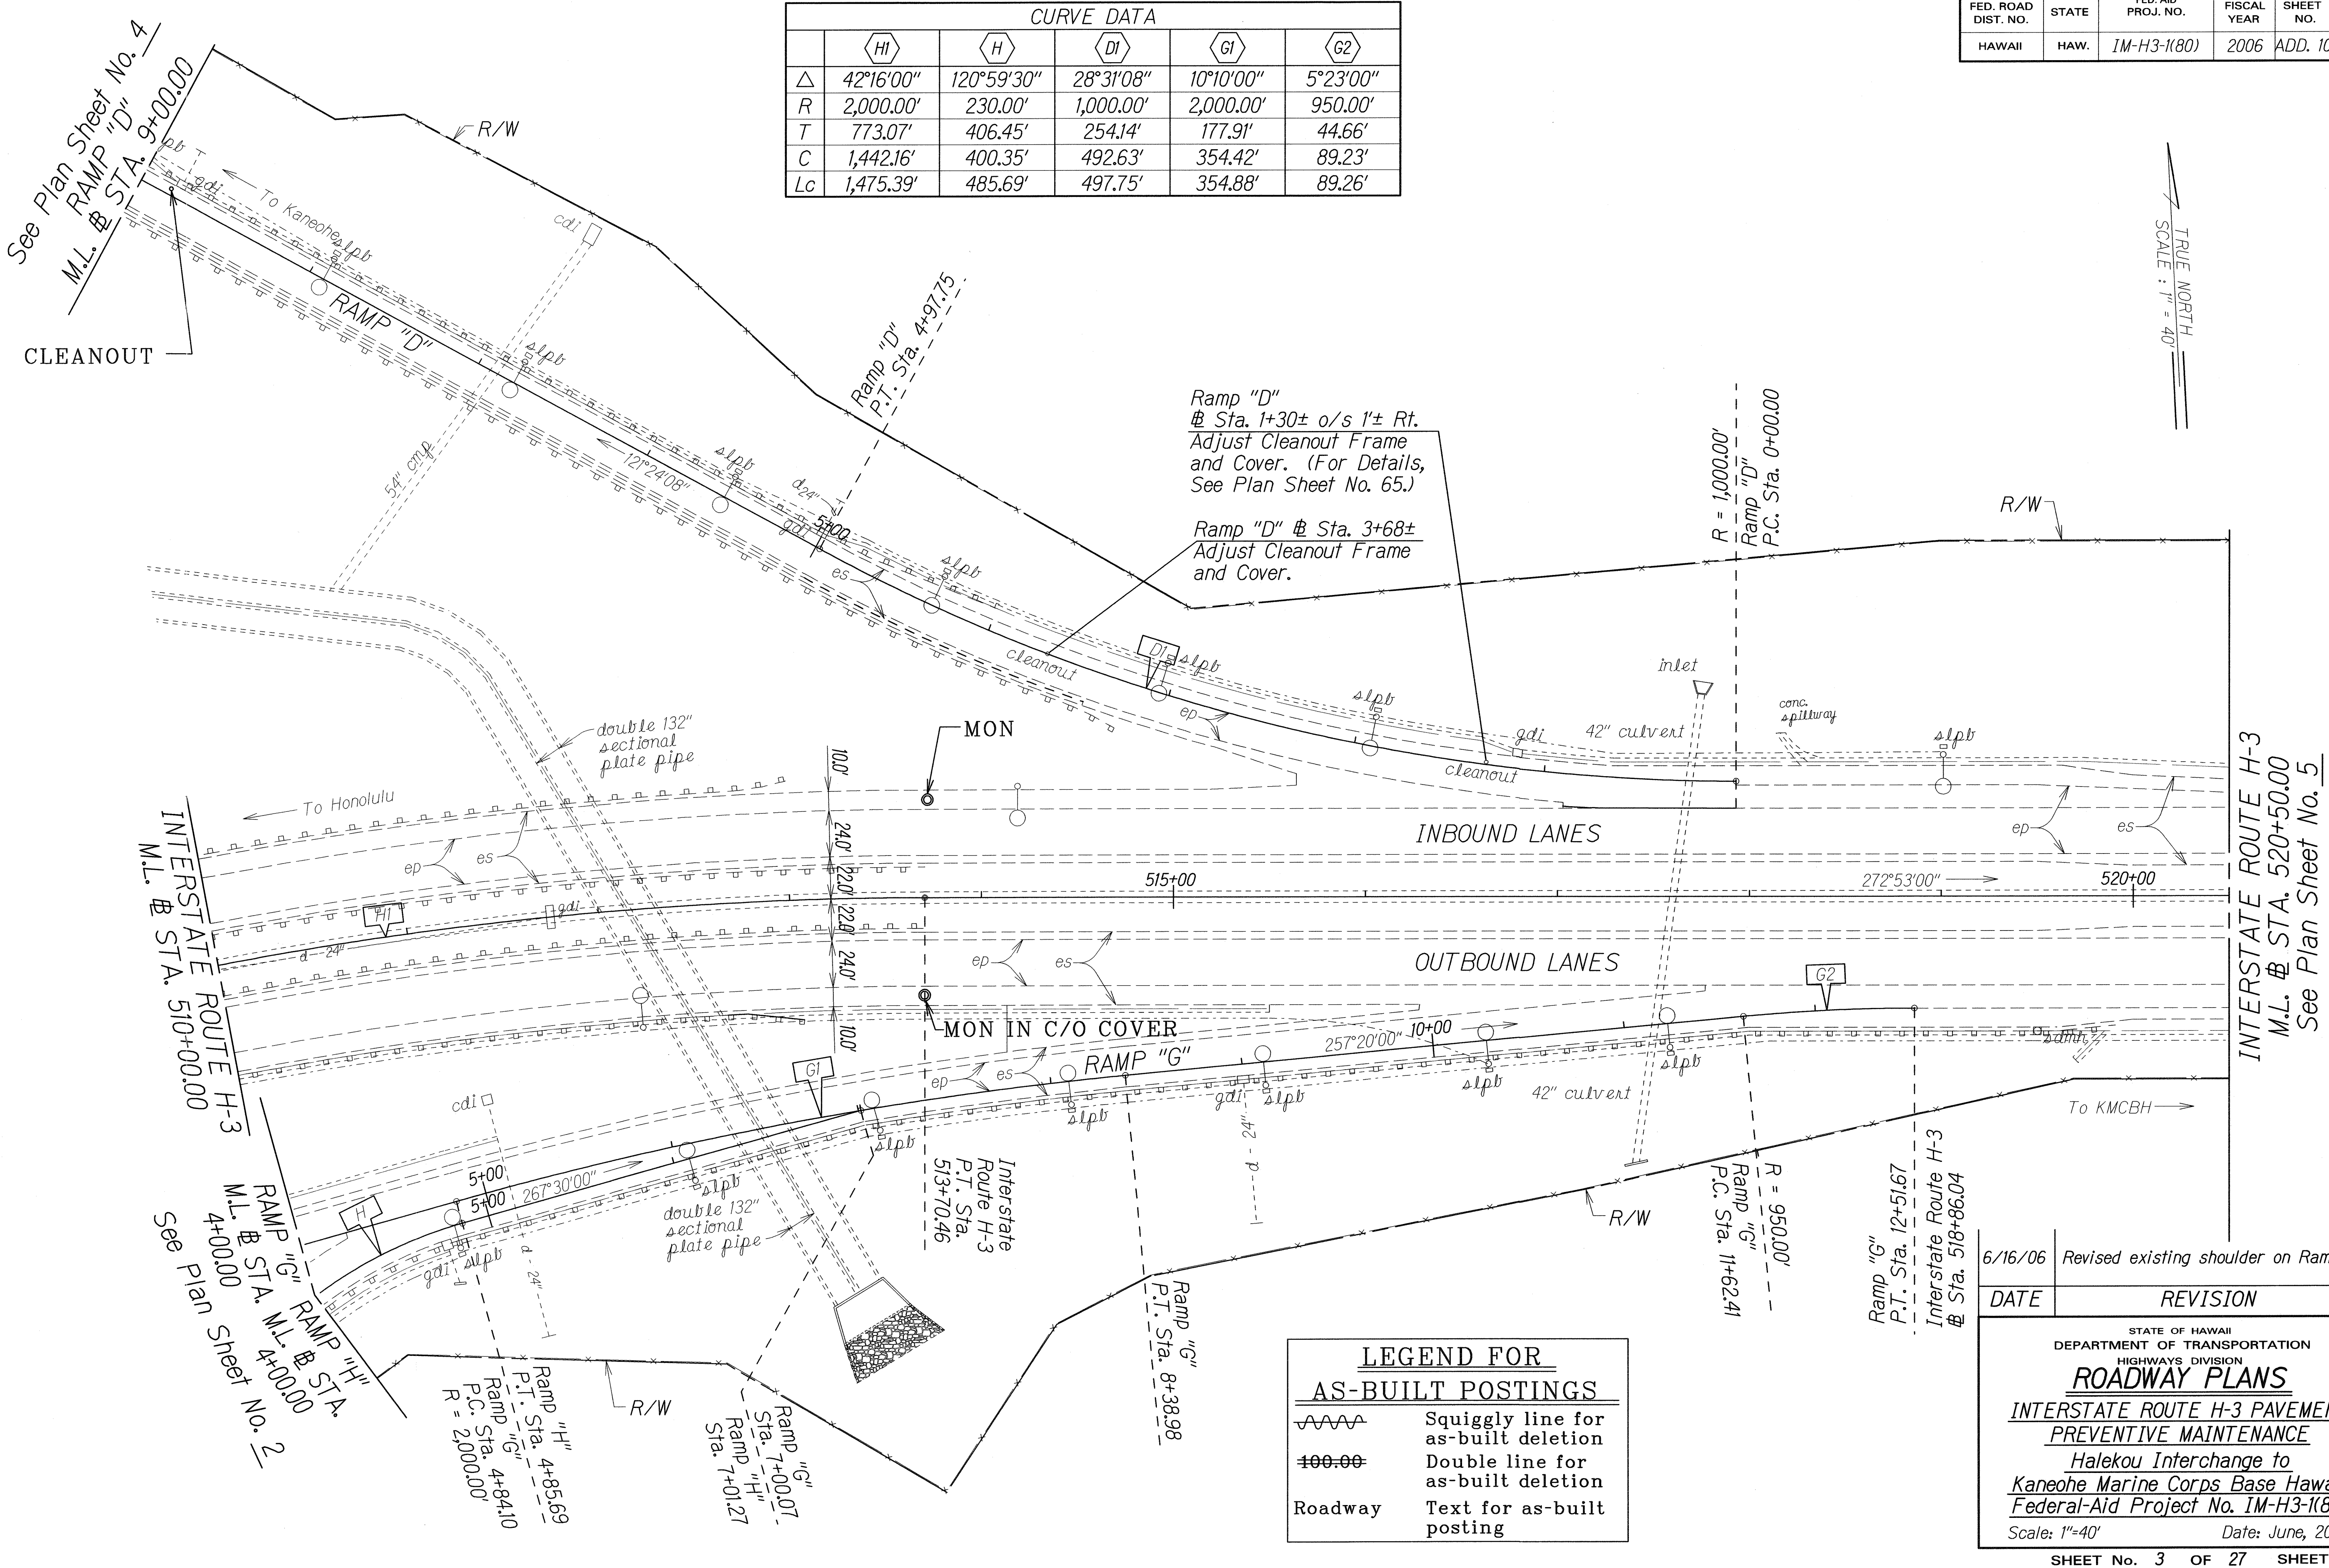

DATE	
SURVEY PLOTTED BY	
DRAWN BY	
TRACED BY	
DESIGNED BY	
CHECKED BY	
ORIGINAL PLAN	
NOTE BOOK	
NO. 1	
NO. 2	
NO. 3	
NO. 100	

LEGEND FOR AS-BUILT POSTINGS	
	Squiggly line for as-built deletion
	Double line for as-built deletion
Roadway	Text for as-built posting

6/16/06	Revised existing shoulder on Ramp "D".
DATE	REVISION
STATE OF HAWAII DEPARTMENT OF TRANSPORTATION HIGHWAYS DIVISION ROADWAY PLANS INTERSTATE ROUTE H-3 PAVEMENT PREVENTIVE MAINTENANCE Halekou Interchange to Kaneohe Marine Corps Base Hawaii Federal-Aid Project No. IM-H3-1(80) Scale: 1"=40' Date: June, 2005	
SHEET No. 3 OF 27 SHEETS	

FED. ROAD DIST. NO.	STATE	FED. AID PROJ. NO.	FISCAL YEAR	SHEET NO.	TOTAL SHEETS
HAWAII	HAW.	IM-H3-1(80)	2006	12	66

CURVE DATA	
	H2
Δ	37°33'00"
R	3,000.00'
T	1,019.82'
C	1,931.11'
Lc	1,966.11'

TRUE NORTH
SCALE: 1" = 40'

Sta. 531+09± o/s 56'±Lt.
Adjust Cleanout Frame
and Cover.

527+10±
Sta. 526+84± o/s 57'±Lt.
Adjust Cleanout Frame
and Cover. (For Details,
See Plan Sheet No. 65.)

524+05±
Sta. 523+34± o/s 57'±Lt.
Adjust Cleanout Frame
and Cover.

Sta. 530+76± o/s 47'± Rt.
Adjust Cleanout Frame and
Cover.

527+00±
Sta. 526+20± o/s 59'± Rt.
Adjust Cleanout Frame and
Cover.

Sta. 524+80± o/s 53'± Rt.
Adjust Cleanout Frame and
Cover.

523+00±
Sta. 522+68± o/s 54'± Rt.
Adjust Cleanout Frame and
Cover.

Sta. 521+50± o/s 52'±Lt.
Adjust Cleanout Frame
and Cover.

Interstate Route H-3
P.C. # Sta. 522+00.00
R = 3,000.00'

INTERSTATE ROUTE H-3
M.L. # STA. 520+50.00

INTERSTATE ROUTE H-3
M.L. # STA. 532+00.00

LEGEND FOR AS-BUILT POSTINGS	
	Squiggly line for as-built deletion
	Double line for as-built deletion
Roadway	Text for as-built posting

STATE OF HAWAII
DEPARTMENT OF TRANSPORTATION
HIGHWAYS DIVISION



ROADWAY PLANS
INTERSTATE ROUTE H-3 PAVEMENT
PREVENTIVE MAINTENANCE
Halekou Interchange to
Kaneohe Marine Corps Base Hawaii
Federal-Aid Project No. IM-H3-1(80)
Scale: 1"=40' Date: June, 2005

ORIGINAL PLAN	DATE
DESIGNED BY	
NOTED BY	
CHECKED BY	
DATE	

asbu112006.kh3ap01

FED. ROAD DIST. NO.	STATE	FED. AID PROJ. NO.	FISCAL YEAR	SHEET NO.	TOTAL SHEETS
HAWAII	HAW.	IM-H3-1(80)	2006	13	66

CURVE DATA	
	H2
Δ	37°33'00"
R	3,000.00'
T	1,019.82'
C	1,931.11'
Lc	1,966.11'

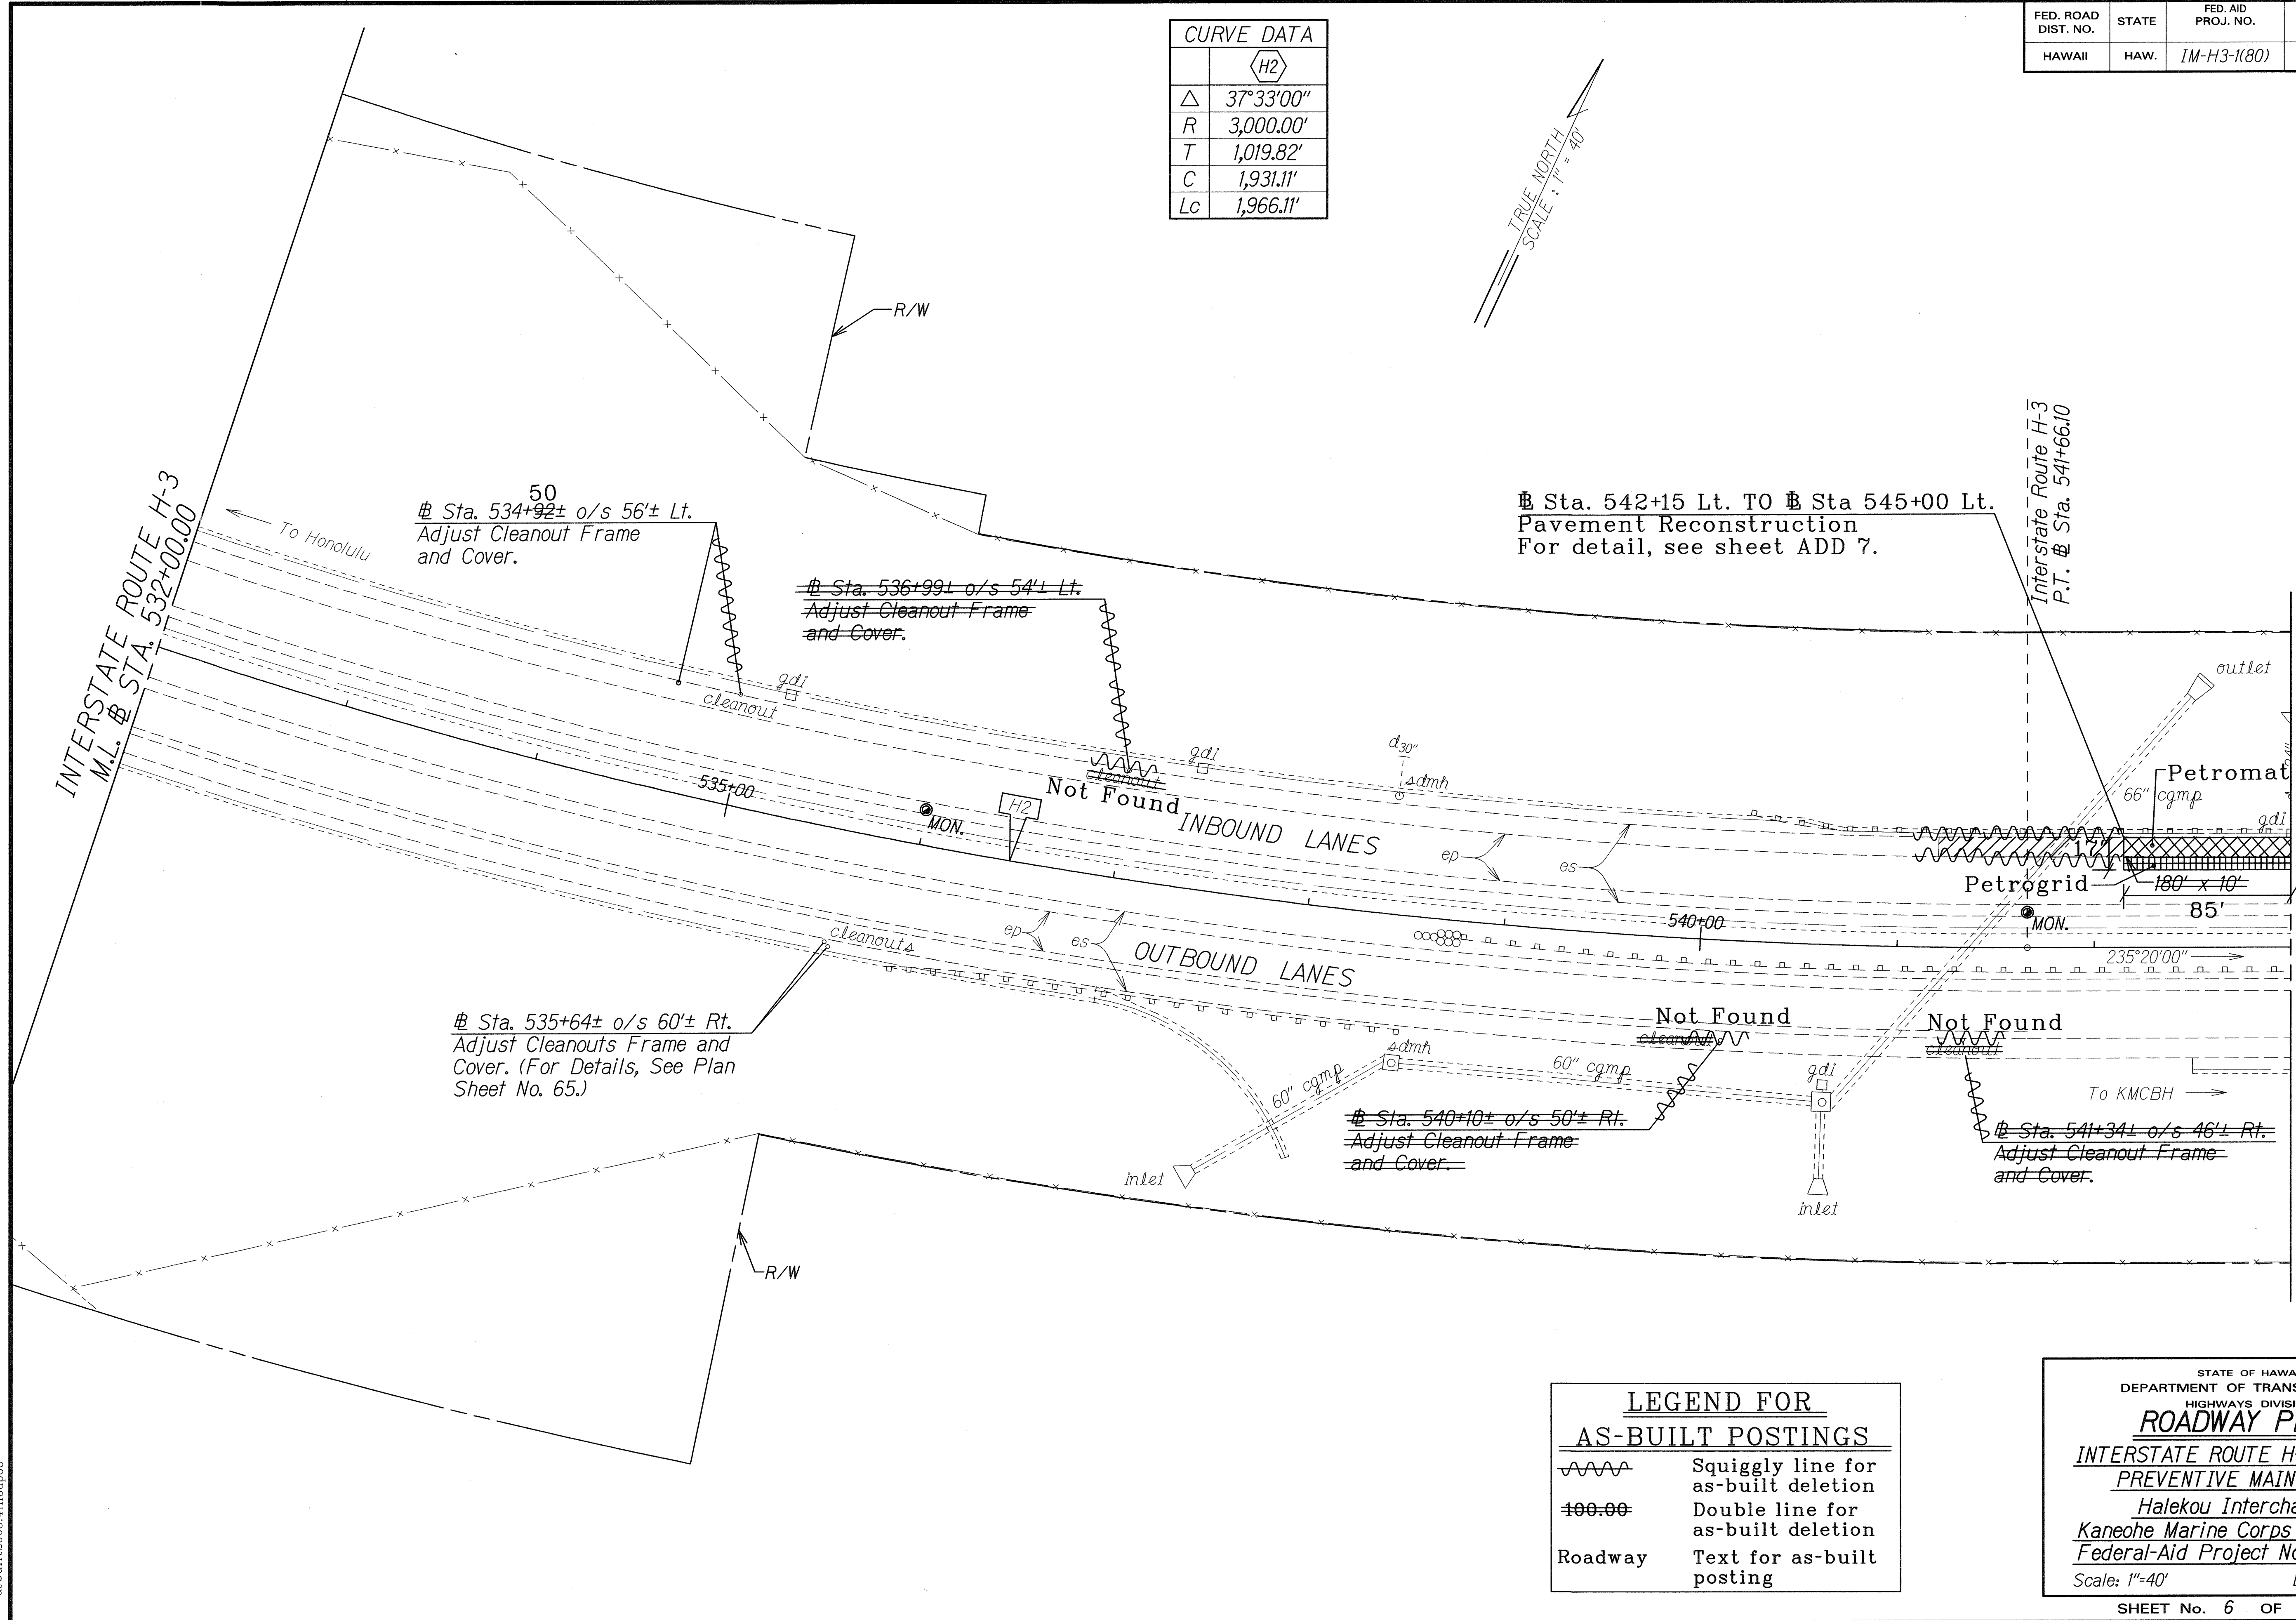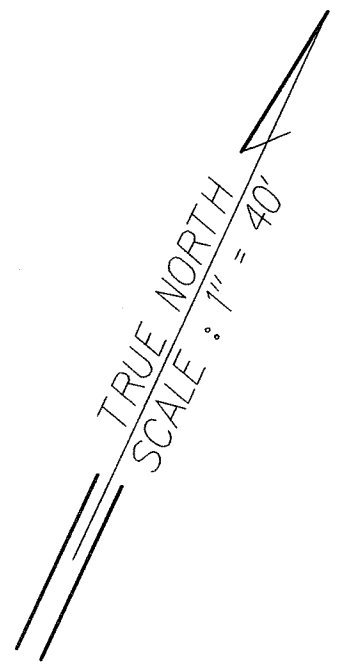


SURVEY PLOTTED BY	DATE
DESIGNED BY	
TRACED BY	
NOTE BOOK	
DESIGNED BY	
QUANTITIES BY	
CHECKED BY	

asbuill2008 4th3dp06

LEGEND FOR AS-BUILT POSTINGS	
	Squiggly line for as-built deletion
	Double line for as-built deletion
Roadway	Text for as-built posting

STATE OF HAWAII
DEPARTMENT OF TRANSPORTATION
HIGHWAYS DIVISION
ROADWAY PLANS
INTERSTATE ROUTE H-3 PAVEMENT PREVENTIVE MAINTENANCE
Halekou Interchange to Kaneohe Marine Corps Base Hawaii
Federal Aid Project No. IM-H3-1(80)
Scale: 1"=40' Date: June, 2005

FED. ROAD DIST. NO.	STATE	FED. AID PROJ. NO.	FISCAL YEAR	SHEET NO.	TOTAL SHEETS
HAWAII	HAW.	IM-H3-1(80)	2006	14	66

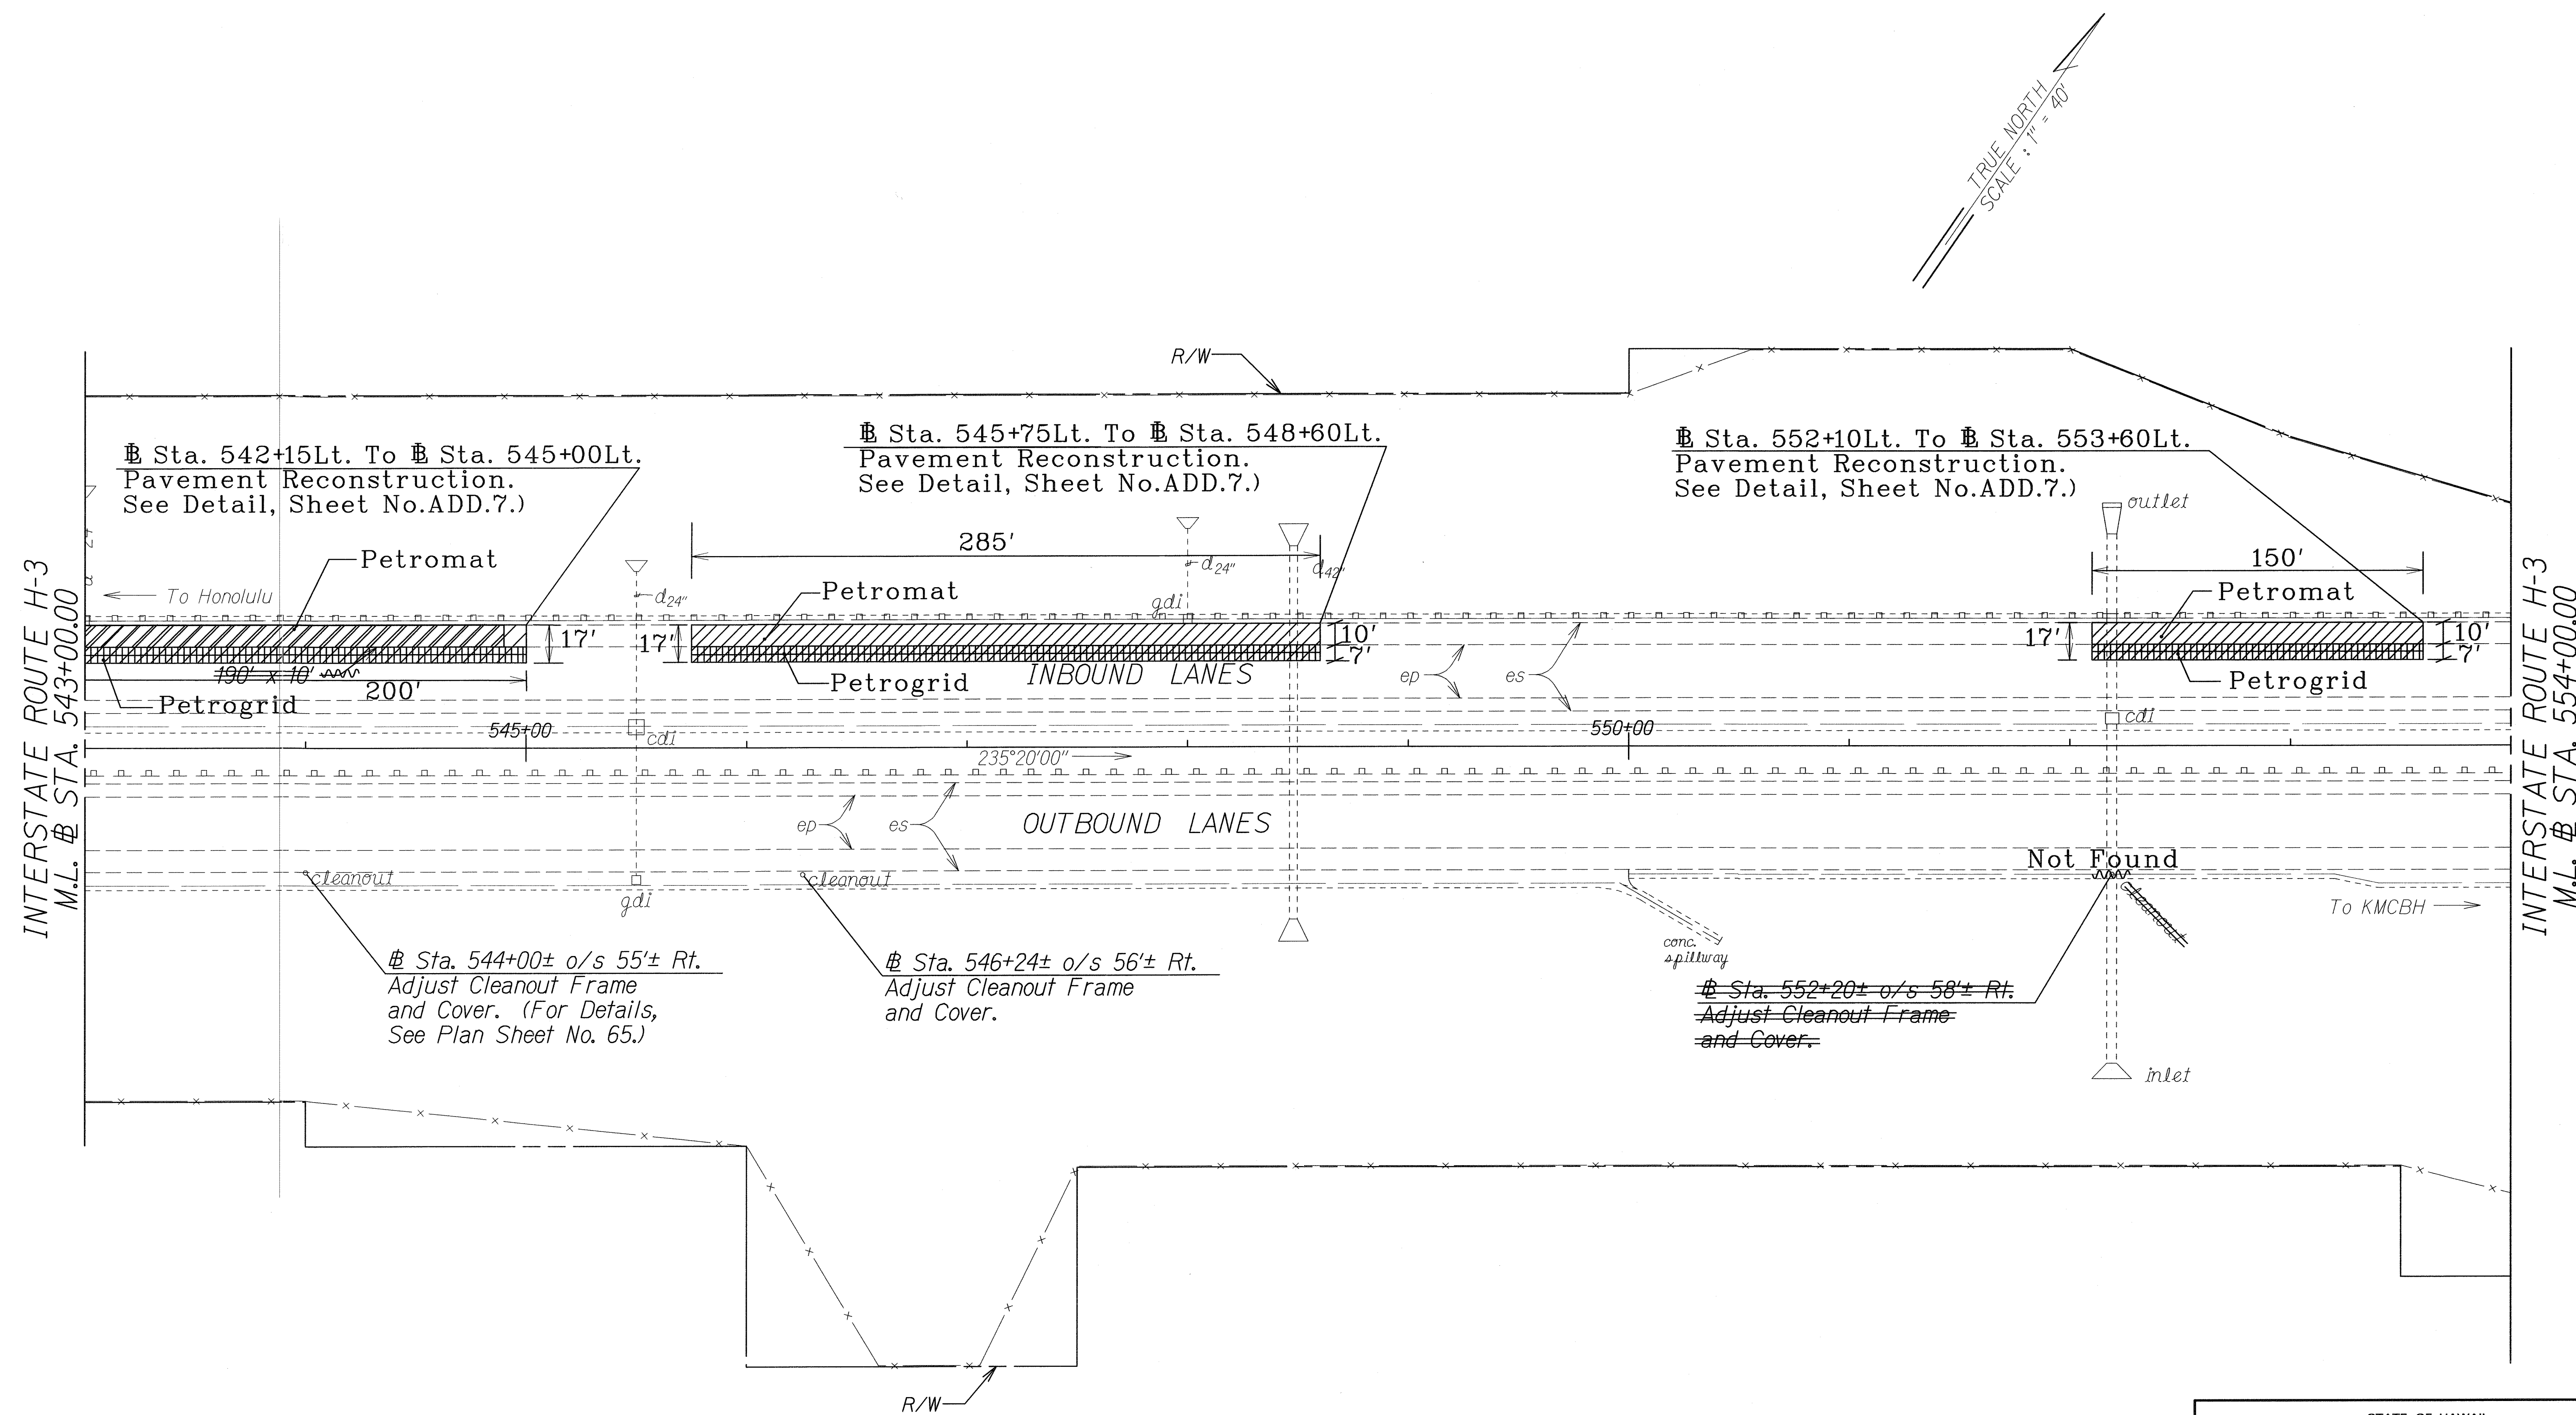


ORIGINAL PLAN	SURVEY PLOTTED BY	DATE
NOTE BOOK	DRAWN BY	
N. 21034007	DESIGNED BY	
	QUANTITIES BY	
	CHECKED BY	

LEGEND FOR AS-BUILT POSTINGS	
	Squiggly line for as-built deletion
	Double line for as-built deletion
Roadway	Text for as-built posting


STATE OF HAWAII
DEPARTMENT OF TRANSPORTATION
HIGHWAYS DIVISION
ROADWAY PLANS
INTERSTATE ROUTE H-3 PAVEMENT PREVENTIVE MAINTENANCE
Halekou Interchange to Kaneohe Marine Corps Base Hawaii
Federal-Aid Project No. IM-H3-1(80)
Scale: 1"=40' Date: June, 2005

FED. ROAD DIST. NO.	STATE	FED. AID PROJ. NO.	FISCAL YEAR	SHEET NO.	TOTAL SHEETS
HAWAII	HAW.	IM-H3-1(80)	2006	15	66

CURVE DATA	
Δ	43°53'10"
R	3,000.00'
T	1,208.61'
C	2,242.11'
Lc	2,297.87'

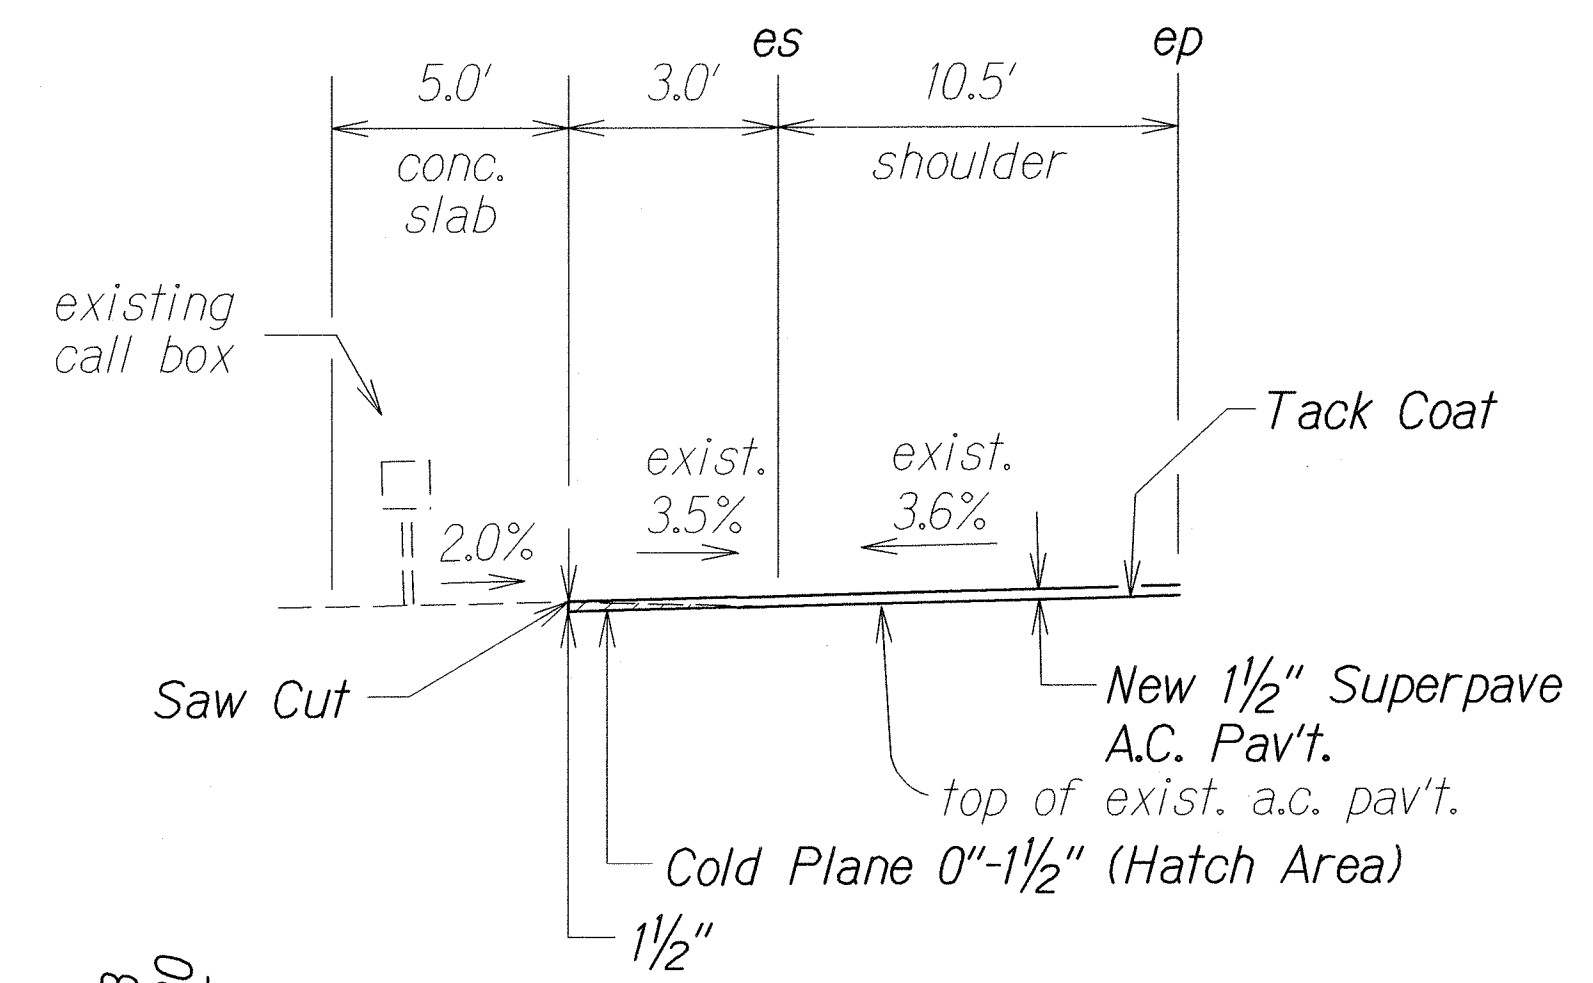

**PARTIAL TYPICAL SECTION AT
EXISTING CALL BOX H3W0126**
Not to Scale

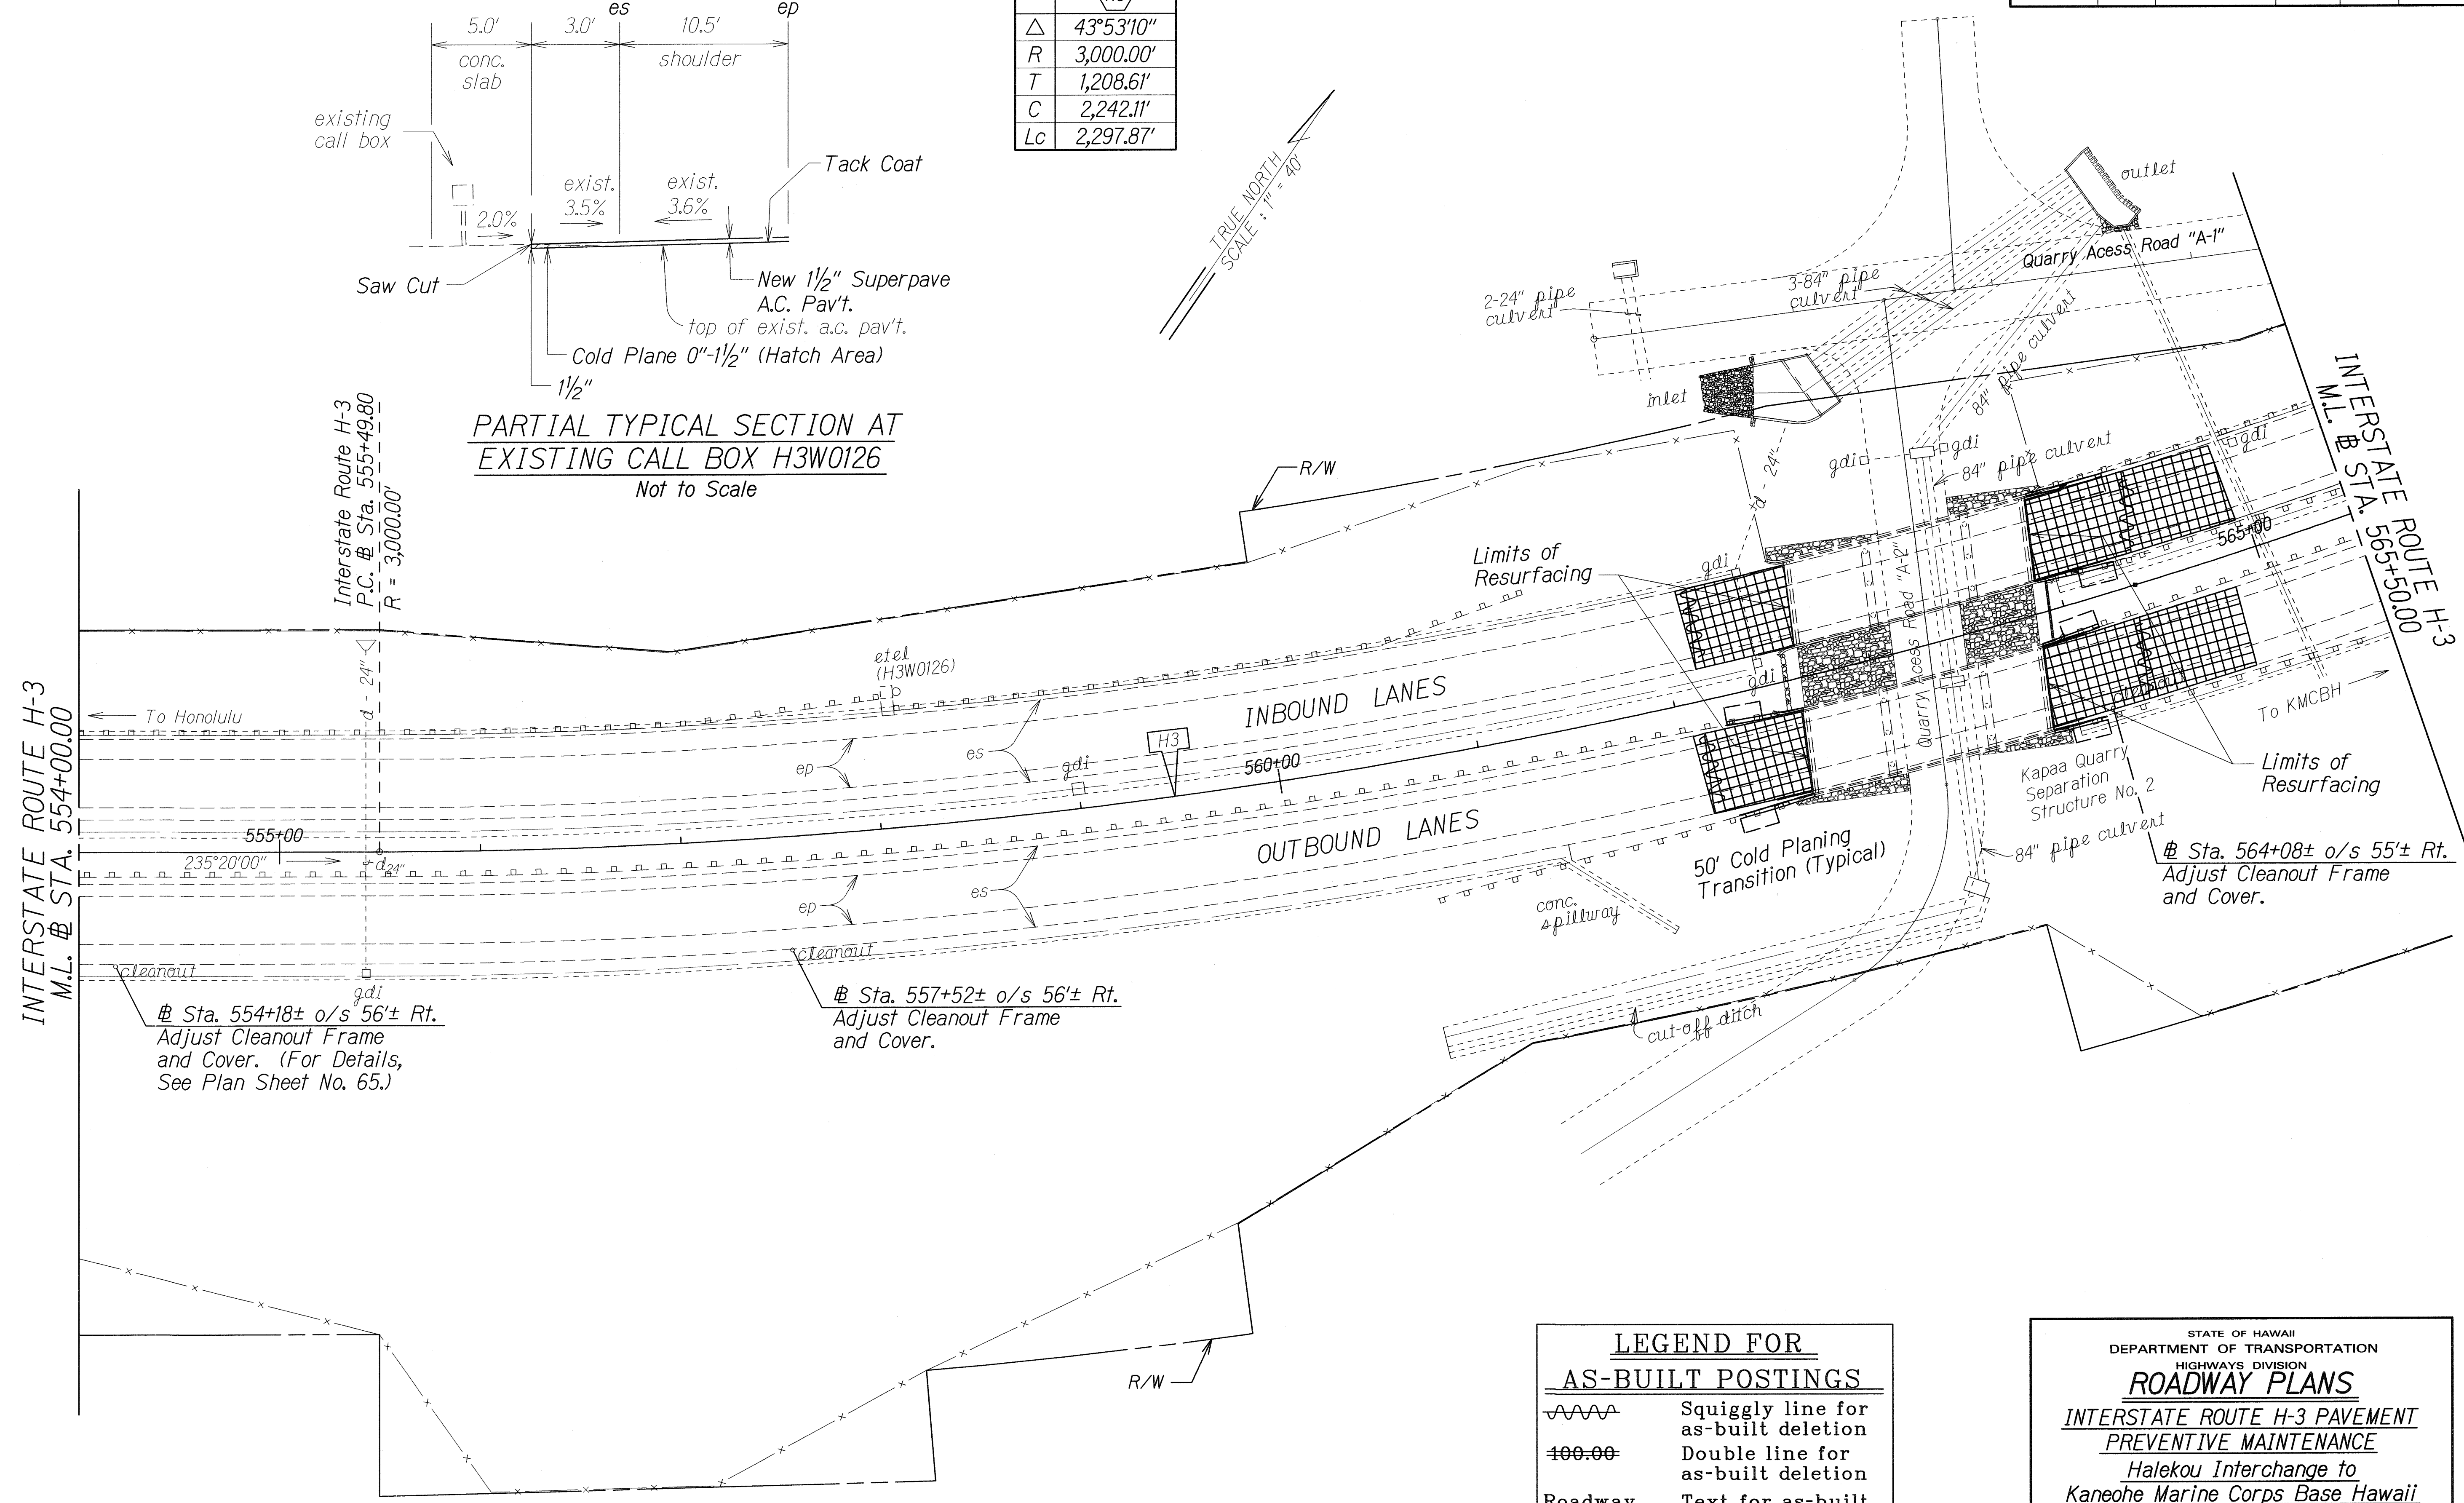

LEGEND FOR AS-BUILT POSTINGS	
	Squiggly line for as-built deletion
	Double line for as-built deletion
Roadway	Text for as-built posting

STATE OF HAWAII
DEPARTMENT OF TRANSPORTATION
HIGHWAYS DIVISION

ROADWAY PLANS

**INTERSTATE ROUTE H-3 PAVEMENT
PREVENTIVE MAINTENANCE**

*Halekou Interchange to
Kaneohe Marine Corps Base Hawaii
Federal-Aid Project No. IM-H3-1(80)*

Scale: 1"=40' Date: June, 2005

SHEET No. 8 OF 27 SHEETS


DESIGNED BY	DATE
DRAWN BY	
CHECKED BY	
NOTED BY	
APPROVED BY	

asbuilt2006.41h3dp08

"AS-BUILT"

CURVE DATA	
	H3
Δ	43°53'10"
R	3,000.00'
T	1,208.61'
C	2,242.11'
Lc	2,297.87'

FED. ROAD DIST. NO.	STATE	FED. AID PROJ. NO.	FISCAL YEAR	SHEET NO.	TOTAL SHEETS
HAWAII	HAW.	IM-H3-1(80)	2006	16	66

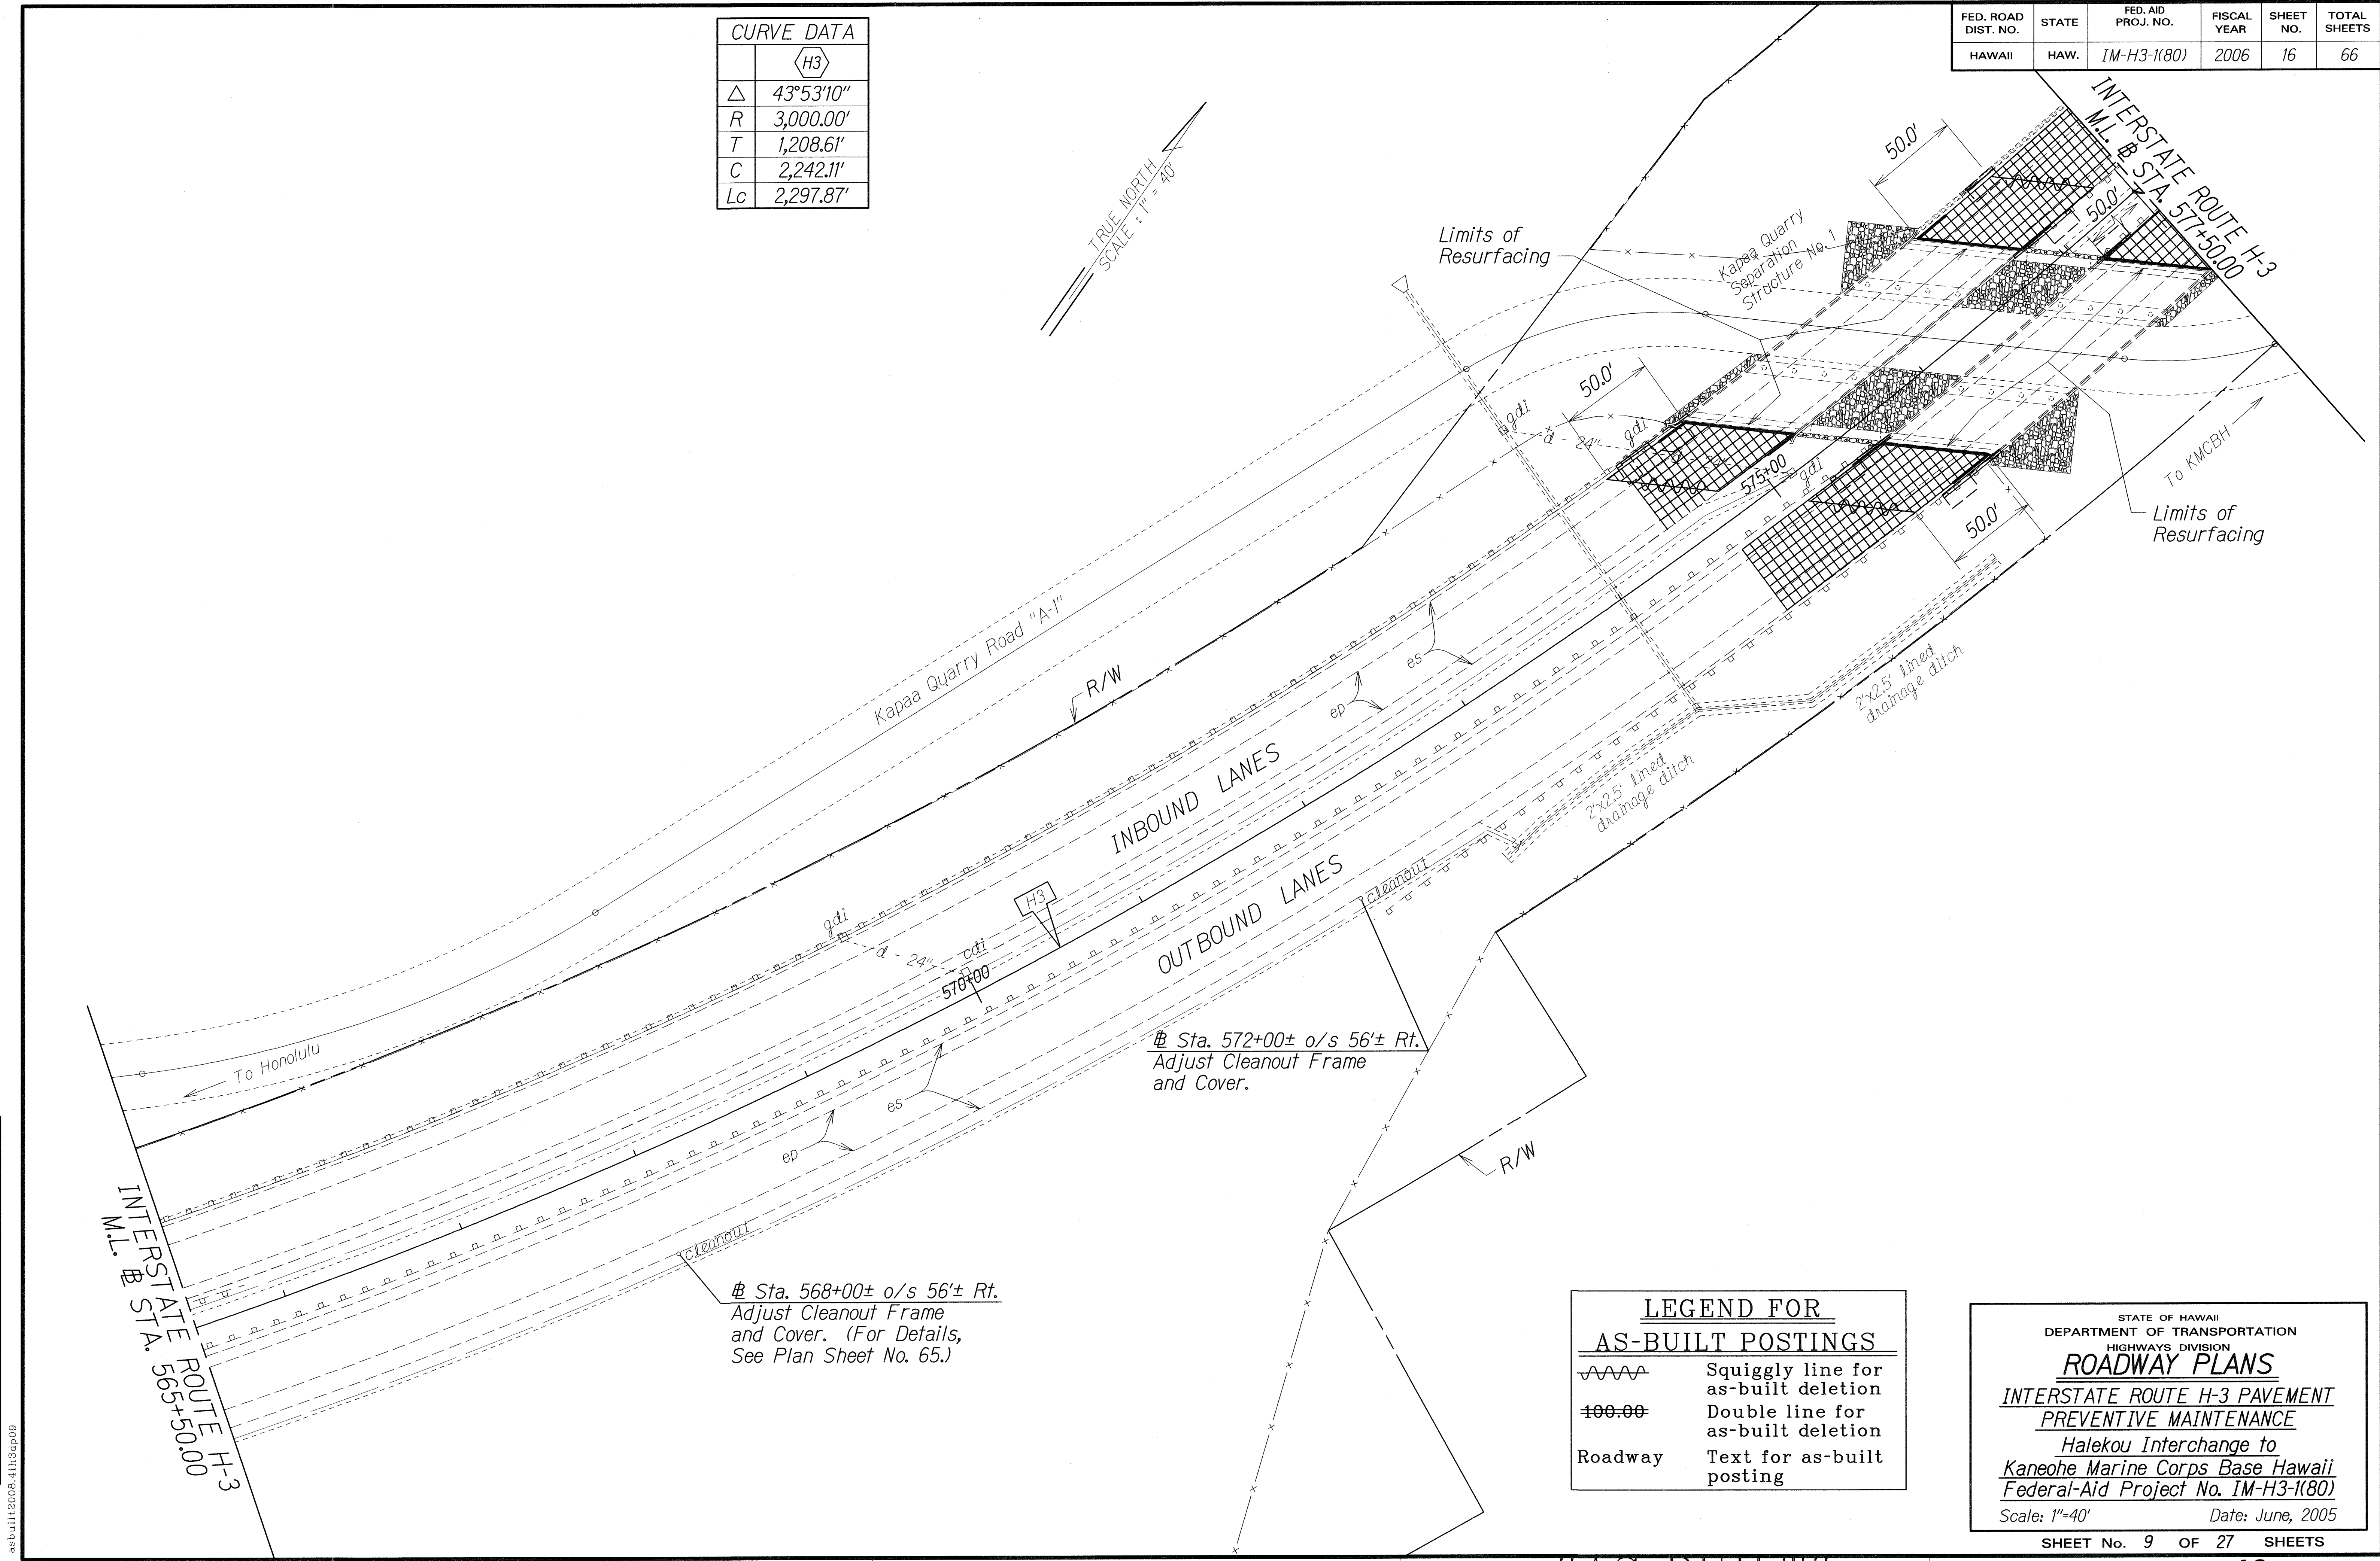

SURVEY PLOTTED BY	DATE
DRAWN BY	
DESIGNED BY	
CHECKED BY	
ORIGINAL PLAN	
NOTE BOOK	
4	
NO. 30003	

LEGEND FOR AS-BUILT POSTINGS	
	Squiggly line for as-built deletion
	Double line for as-built deletion
Roadway	Text for as-built posting

STATE OF HAWAII
DEPARTMENT OF TRANSPORTATION
HIGHWAYS DIVISION

ROADWAY PLANS

INTERSTATE ROUTE H-3 PAVEMENT PREVENTIVE MAINTENANCE

Halekou Interchange to Kaneohe Marine Corps Base Hawaii
Federal-Aid Project No. IM-H3-1(80)

Scale: 1"=40' Date: June, 2005


SHEET No. 9 OF 27 SHEETS

asbuilt2006.41h3qp08

"AS-BUILT"

FED. ROAD DIST. NO.	STATE	FED. AID PROJ. NO.	FISCAL YEAR	SHEET NO.	TOTAL SHEETS
HAWAII	HAW.	1M-H3-1(80)	2006	18	66

CURVE DATA	
Δ	22°33'00"
R	3,000.00'
T	598.17'
C	1,173.25'
Lc	1,180.86'

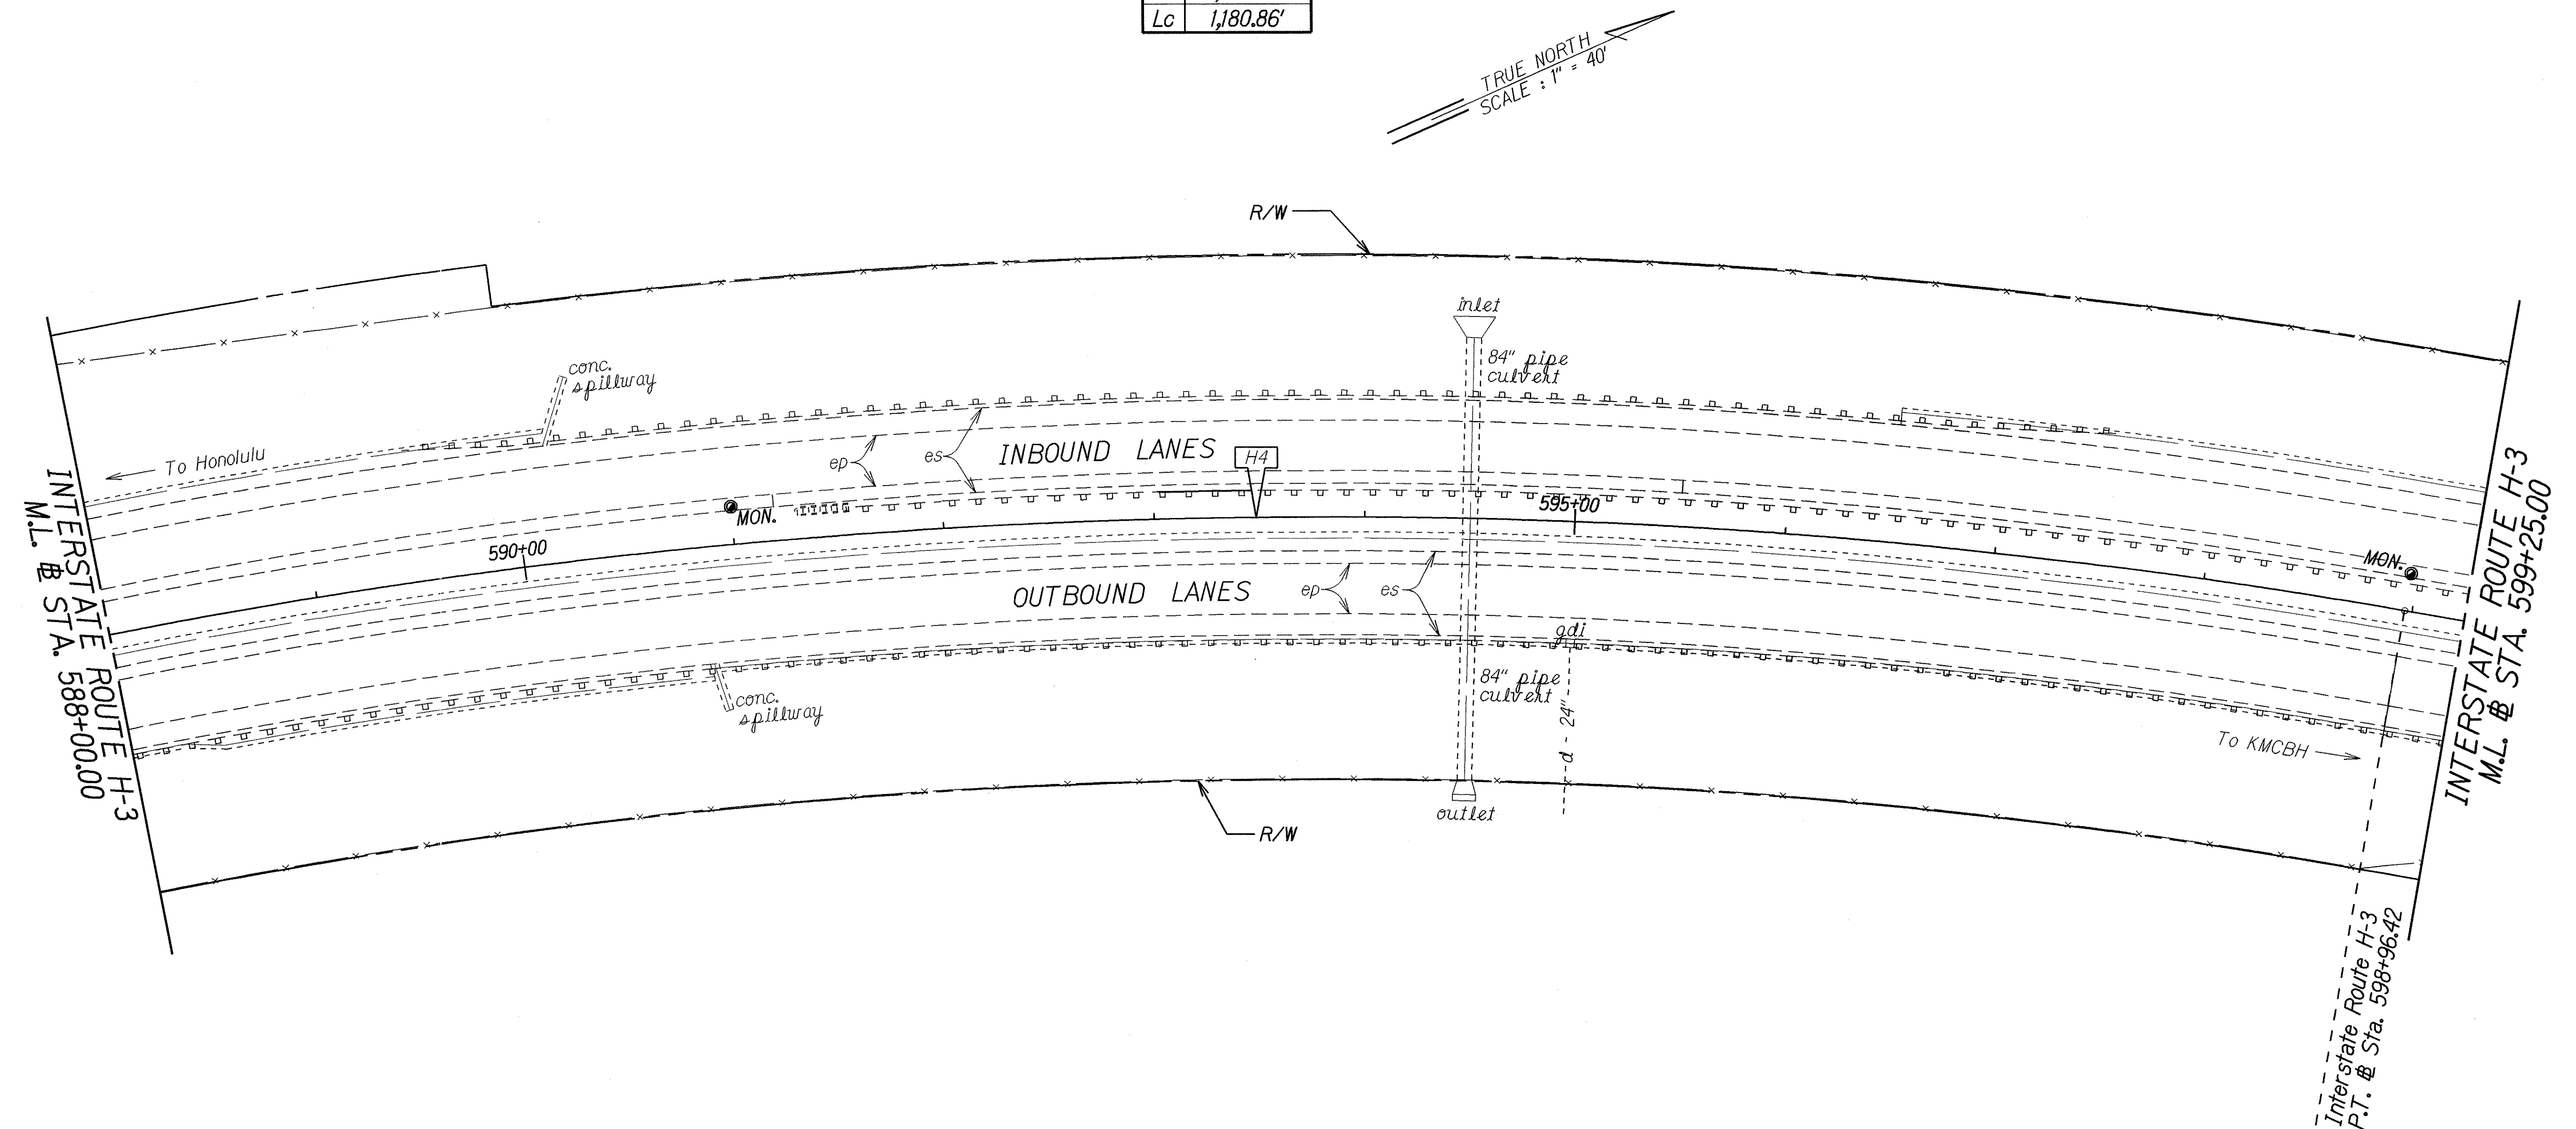

SURVEY PLOTTED BY	DATE
DRAWN BY	
CHECKED BY	
NOTE BOOK	
QUANTITIES BY	
CHECKED BY	

STATE OF HAWAII
DEPARTMENT OF TRANSPORTATION
HIGHWAYS DIVISION

ROADWAY PLANS

INTERSTATE ROUTE H-3 PAVEMENT PREVENTIVE MAINTENANCE


Halekou Interchange to Kaneohe Marine Corps Base Hawaii

Federal-Aid Project No. 1M-H3-1(80)

Scale: 1"=40' Date: June, 2005

FED. ROAD DIST. NO.	STATE	FED. AID PROJ. NO.	FISCAL YEAR	SHEET NO.	TOTAL SHEETS
HAWAII	HAW.	IM-H3-1(80)	2006	ADD. 19	66

Sta. 602+04 to # Sta. 602+34 o/s Lt.
Pavement Reconstruction (For Details,
See Plan Sheet No. Add. 65.).

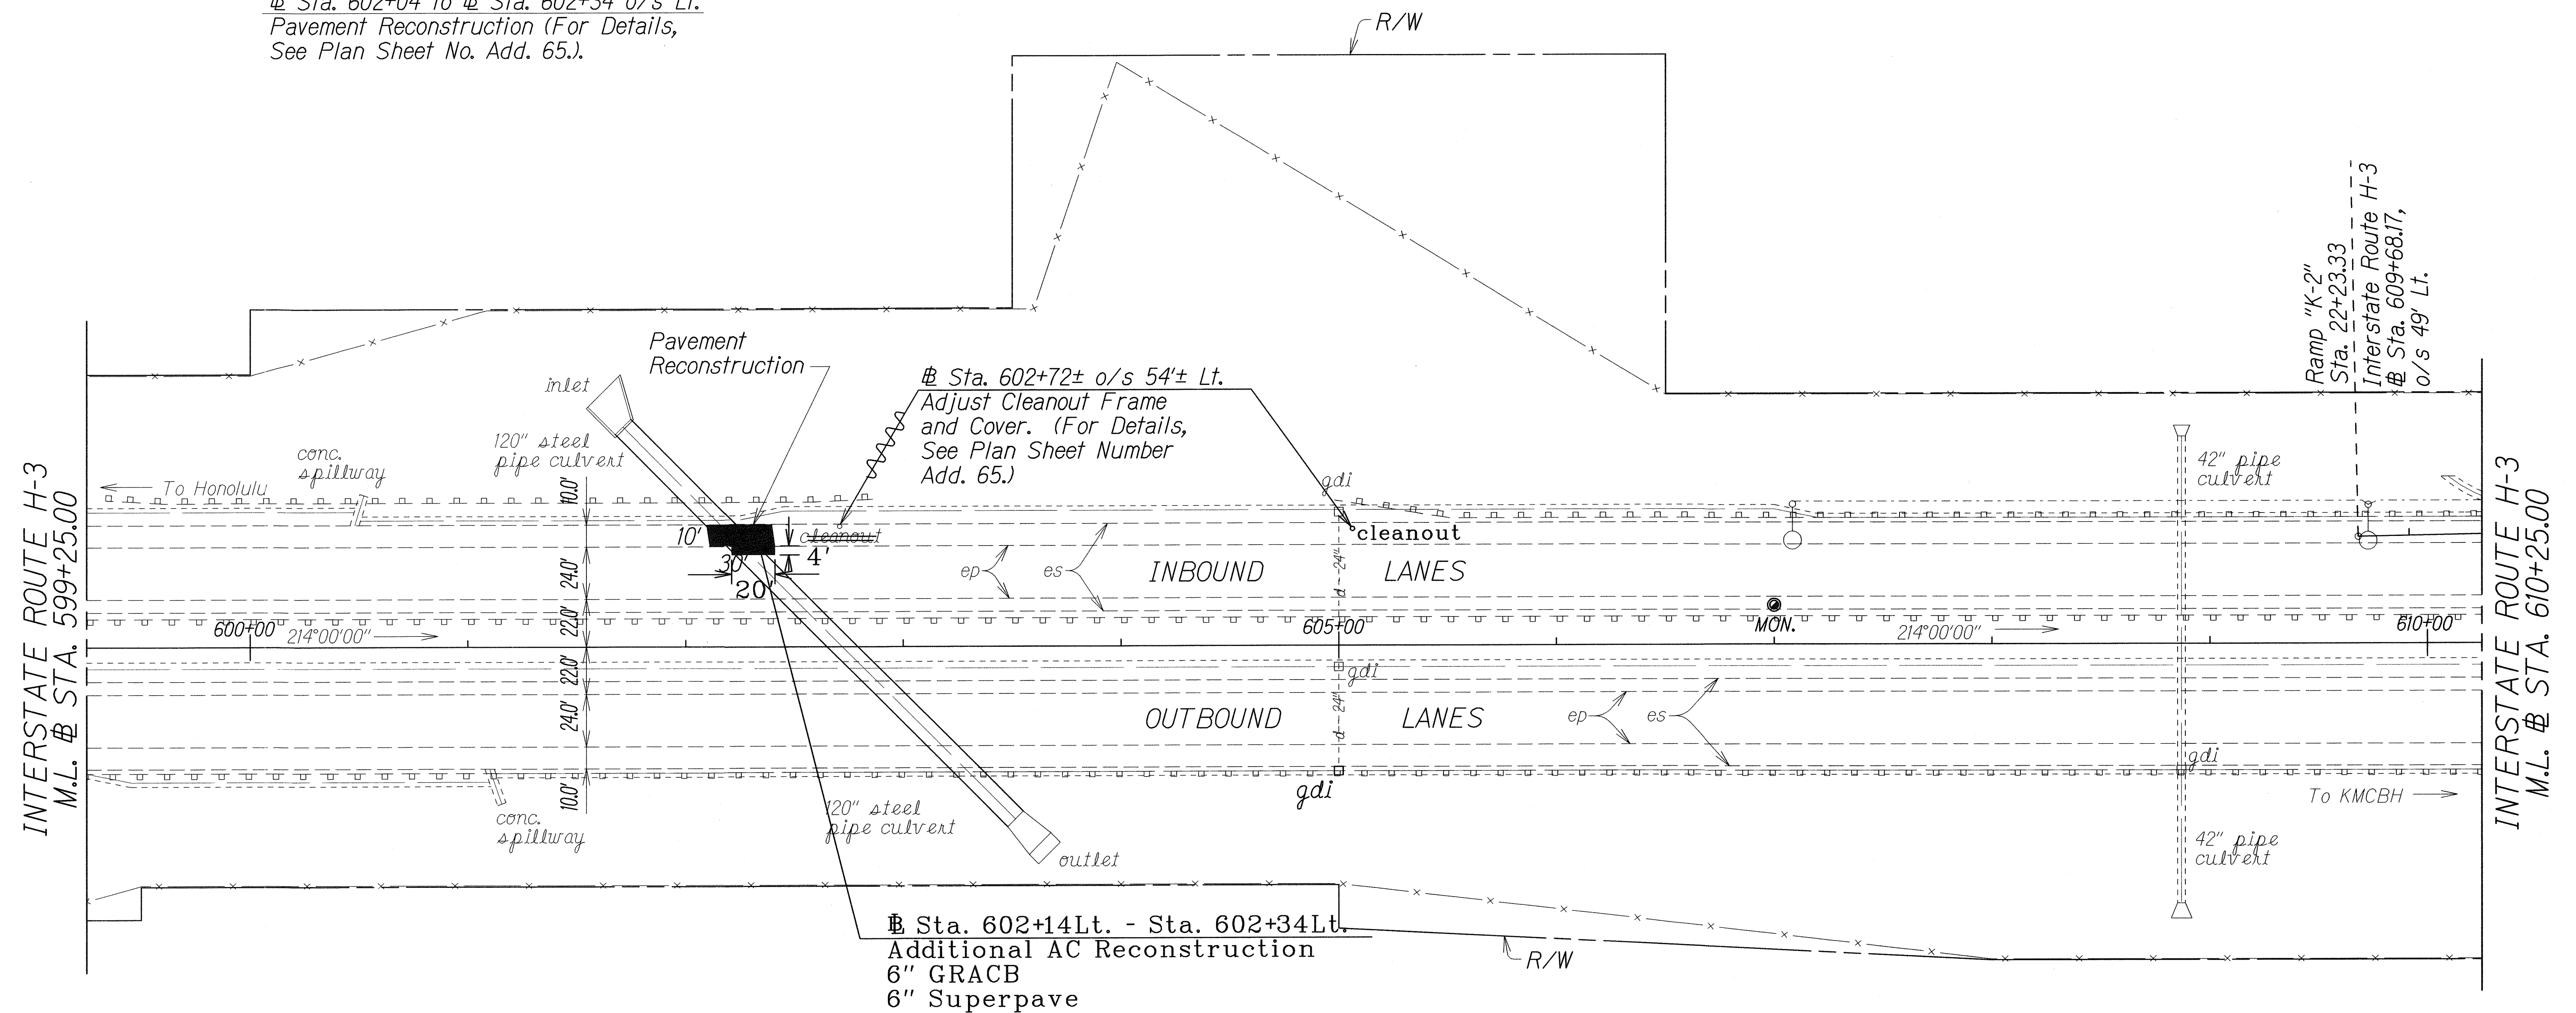

ORIGINAL PLAN	SURVEY PLOTTED BY _____	DATE _____
NOTE BOOK	DRAWN BY _____	_____
	TRACED BY _____	_____
	DESIGNED BY _____	_____
	QUANTITIES BY _____	_____
	CHECKED BY _____	_____

asbuilt2008.4ih3dp12.dgn

6/16/06	£ Sta. 602+04 to £ Sta. 602+34, Added Note and Pavement Reconstruction.
---------	---

DATE	REVISION
------	----------


LEGEND FOR AS-BUILT POSTINGS

	Squiggly line for as-built deletion
100.00	Double line for as-built deletion
Roadway	Text for as-built posting

STATE OF HAWAII
DEPARTMENT OF TRANSPORTATION
HIGHWAYS DIVISION
ROADWAY PLANS
INTERSTATE ROUTE H-3 PAVEMENT
PREVENTIVE MAINTENANCE
Halekou Interchange to
Kaneohe Marine Corps Base Hawaii
Federal-Aid Project No. 1M-H3-1(80)
Scale: 1"=40' Date: June, 2005

FED. ROAD DIST. NO.	STATE	FED. AID PROJ. NO.	FISCAL YEAR	SHEET NO.	TOTAL SHEETS
HAWAII	HAW.	IM-H3-1(80)	2006	20	66

CURVE DATA	
	K3-2
Δ	00°55'15"
R	10,000.00'
T	80.36'
C	160.71'
Lc	160.72'

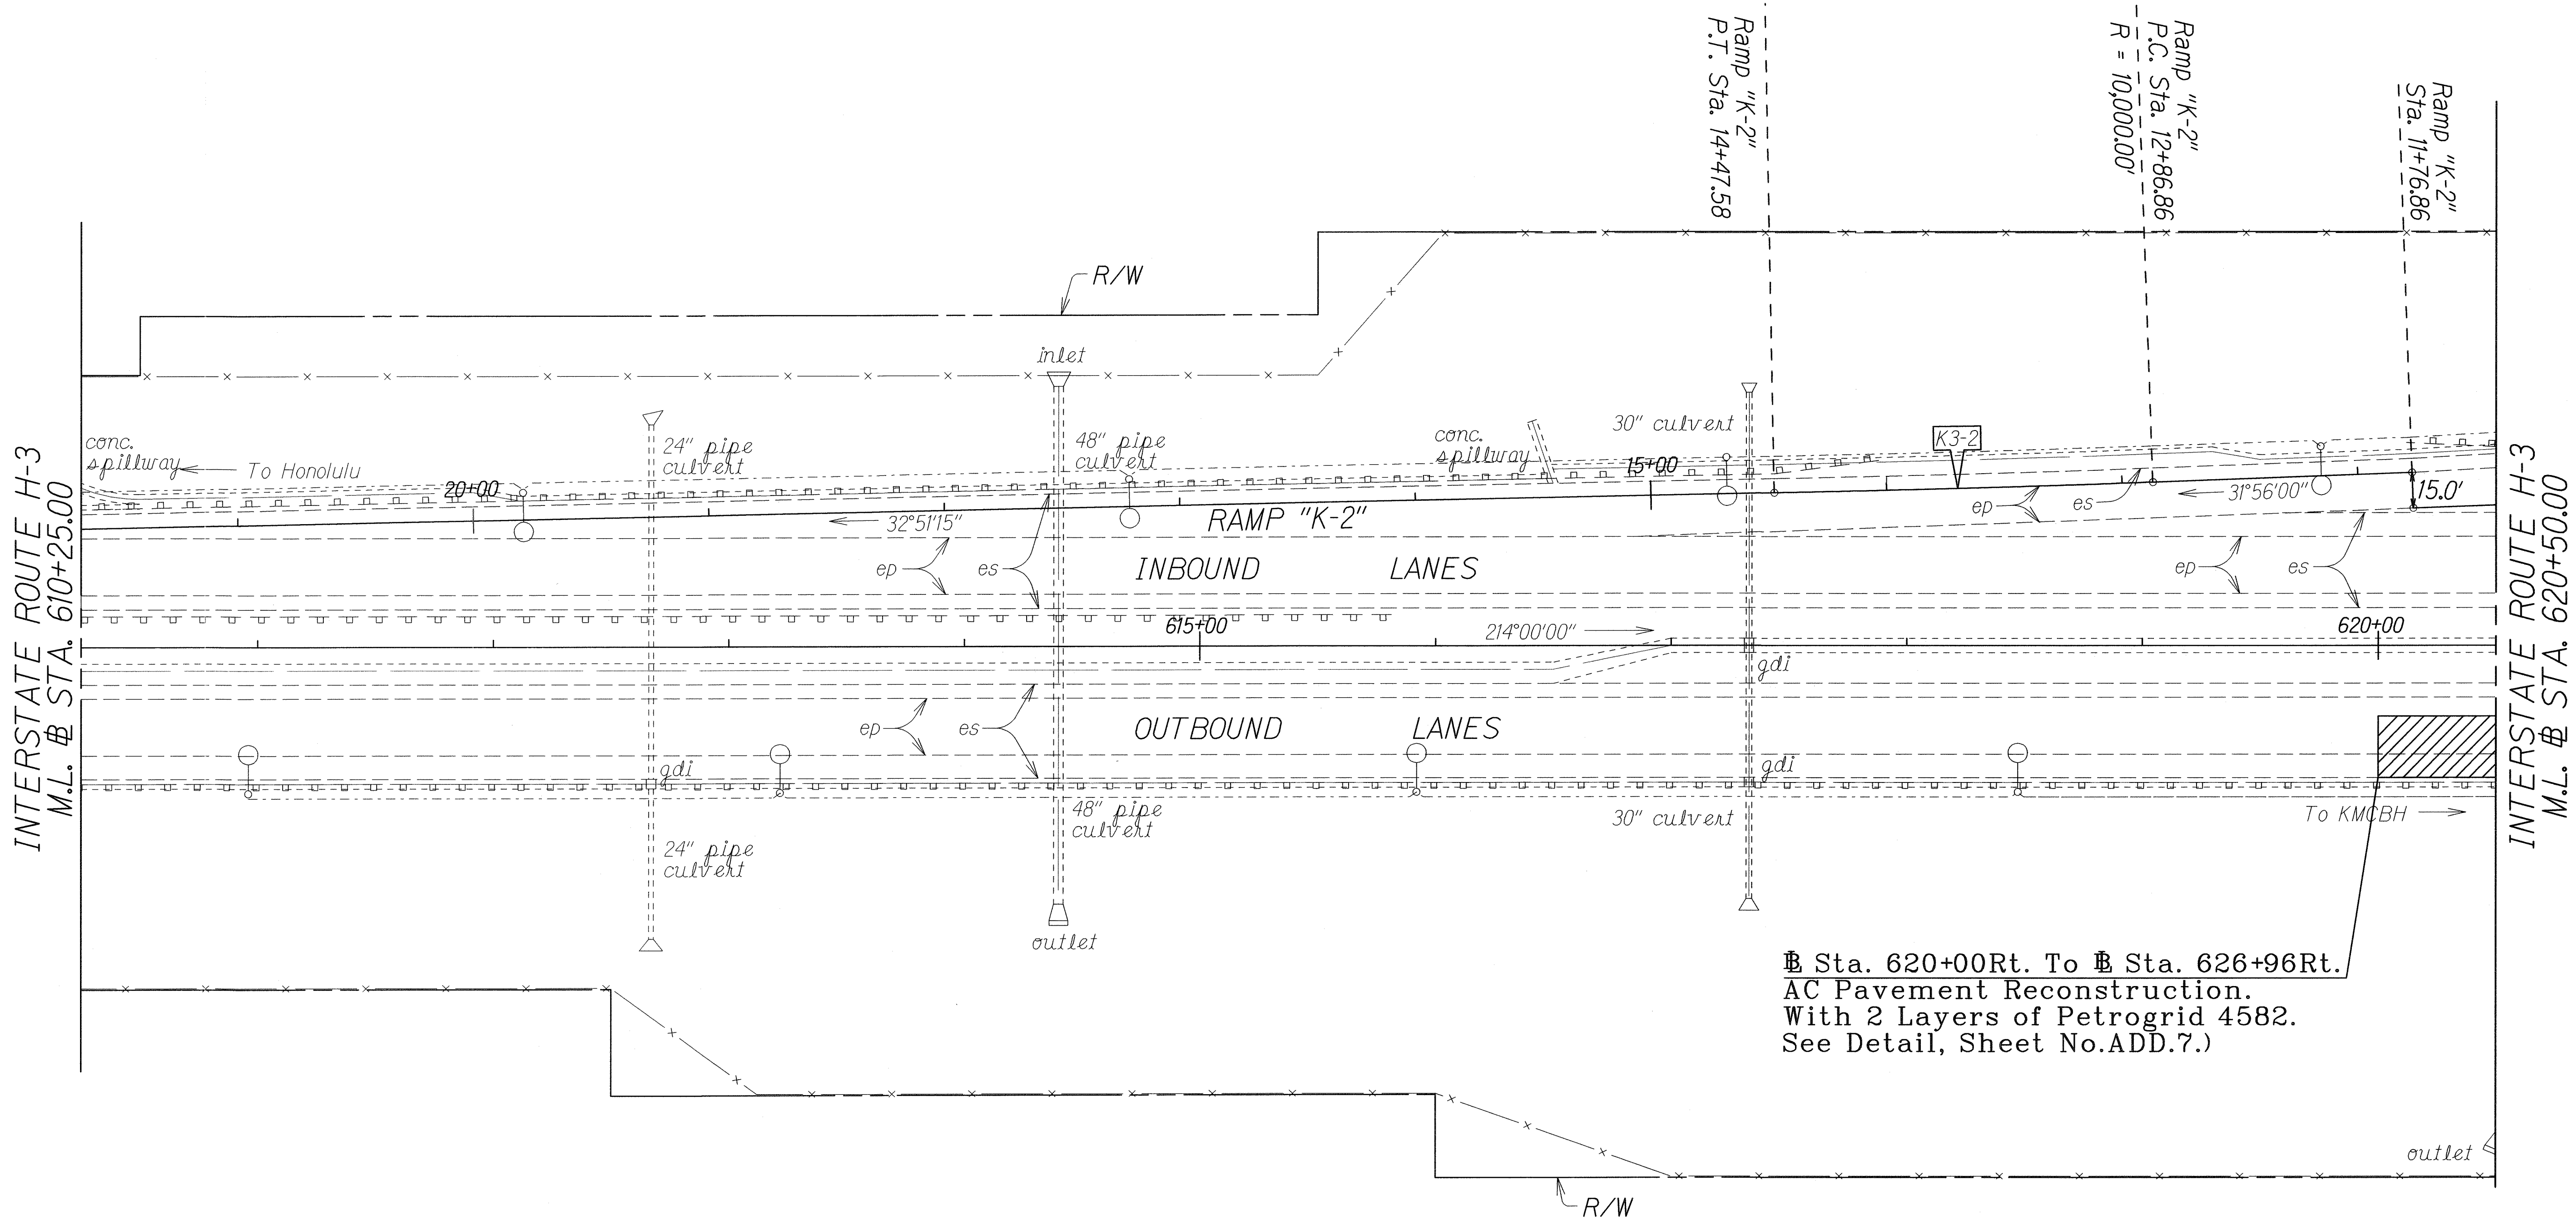

ORIGINAL PLAN	SURVEY PLOTTED BY	DATE
NOTE BOOK	DRAWN BY	
N. 2103dpl3	TRACED BY	
	QUANTITIES BY	
	CHECKED BY	

LEGEND FOR AS-BUILT POSTINGS	
	Squiggly line for as-built deletion
	Double line for as-built deletion
Roadway	Text for as-built posting

STATE OF HAWAII
DEPARTMENT OF TRANSPORTATION
HIGHWAYS DIVISION


ROADWAY PLANS
INTERSTATE ROUTE H-3 PAVEMENT
PREVENTIVE MAINTENANCE
Halekou Interchange to
Kaneohe Marine Corps Base Hawaii
Federal-Aid Project No. IM-H3-1(80)
Scale: 1"=40'

Date: June, 2005

SHEET No. 13 OF 27 SHEETS

"AS-BUILT"

FED. ROAD DIST. NO.	STATE	FED. AID PROJ. NO.	FISCAL YEAR	SHEET NO.	TOTAL SHEETS
HAWAII	HAW.	IM-H3-1(80)	2006	22	66

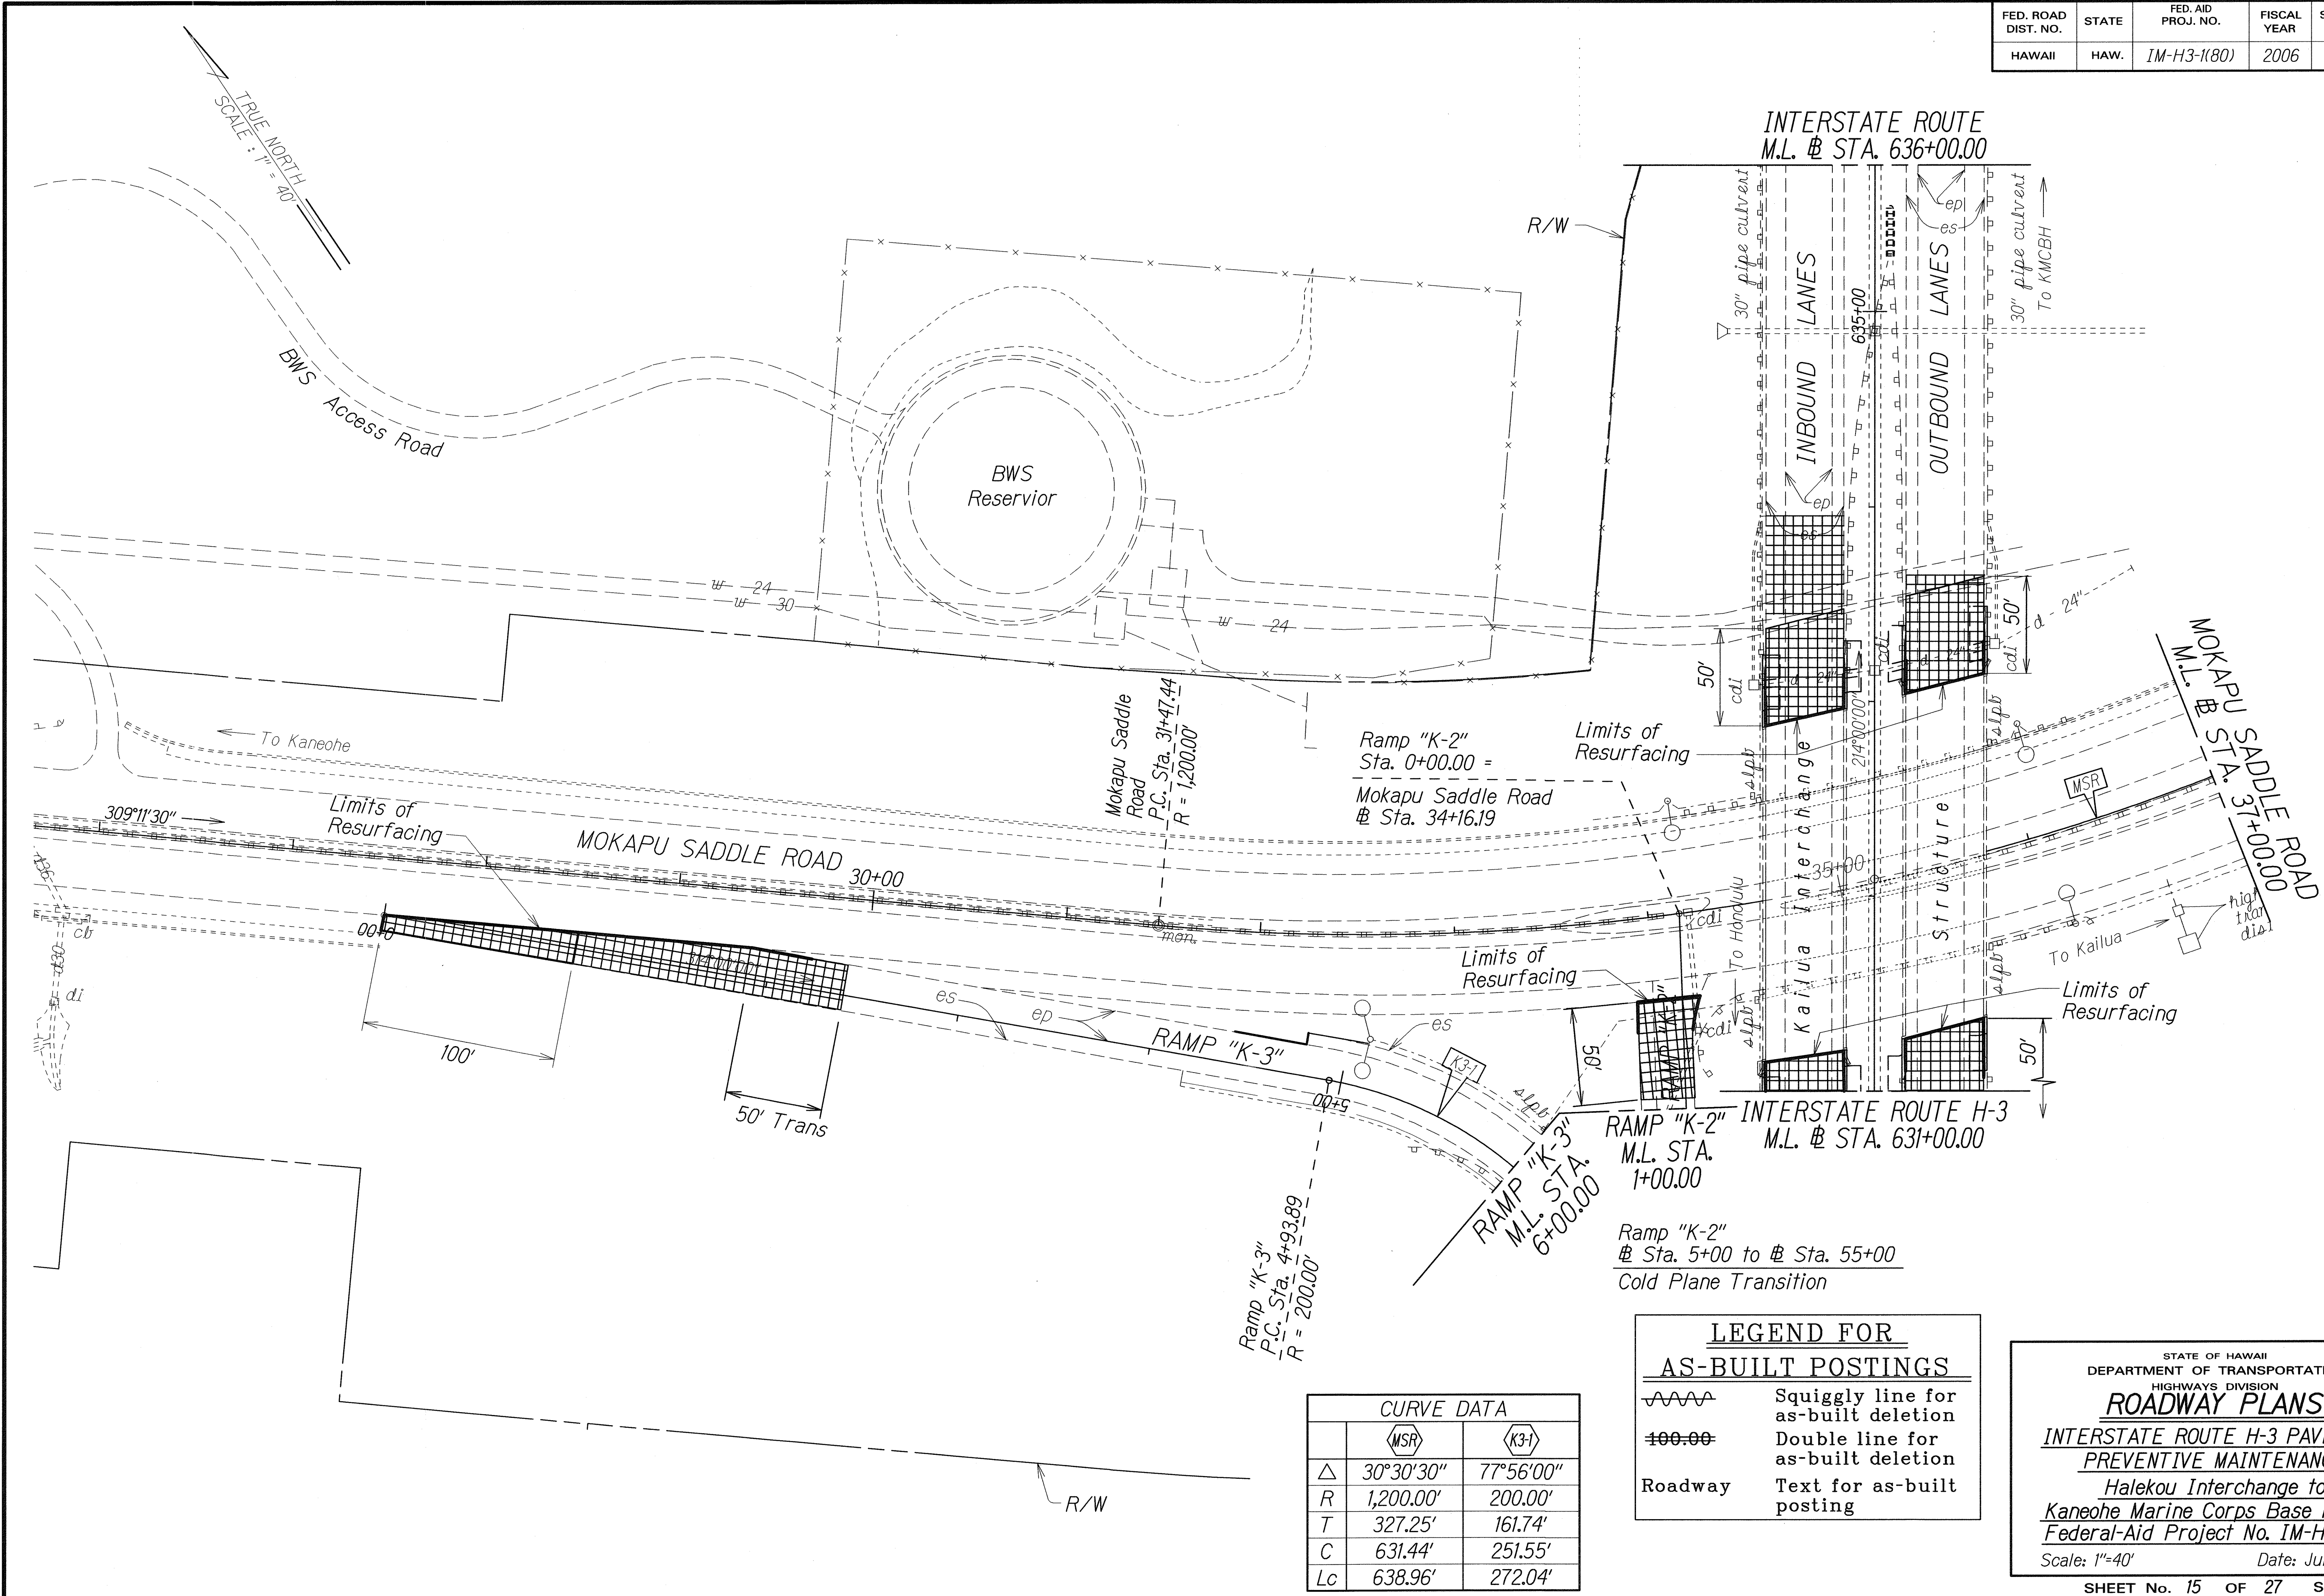

ORIGINAL PLAN	SURVEY PLOTTED BY	DATE
NOTE BOOK	DESIGNED BY	
QUANTITIES BY	CHECKED BY	
2/13/05		

asbuil12008.41h3ap15.dgn

CURVE DATA		
	MSR	K3-1
Δ	30°30'30"	77°56'00"
R	1,200.00'	200.00'
T	327.25'	161.74'
C	631.44'	251.55'
Lc	638.96'	272.04'

LEGEND FOR AS-BUILT POSTINGS	
	Squiggly line for as-built deletion
	Double line for as-built deletion
Roadway	Text for as-built posting

STATE OF HAWAII
DEPARTMENT OF TRANSPORTATION
HIGHWAYS DIVISION

ROADWAY PLANS

INTERSTATE ROUTE H-3 PAVEMENT PREVENTIVE MAINTENANCE


Halekou Interchange to Kaneohe Marine Corps Base Hawaii

Federal-Aid Project No. IM-H3-1(80)

Scale: 1"=40' Date: June, 2005

SHEET No. 15 OF 27 SHEETS

FED. ROAD DIST. NO.	STATE	FED. AID PROJ. NO.	FISCAL YEAR	SHEET NO.	TOTAL SHEETS
HAWAII	HAW.	IM-H3-1(80)	2006	23	66

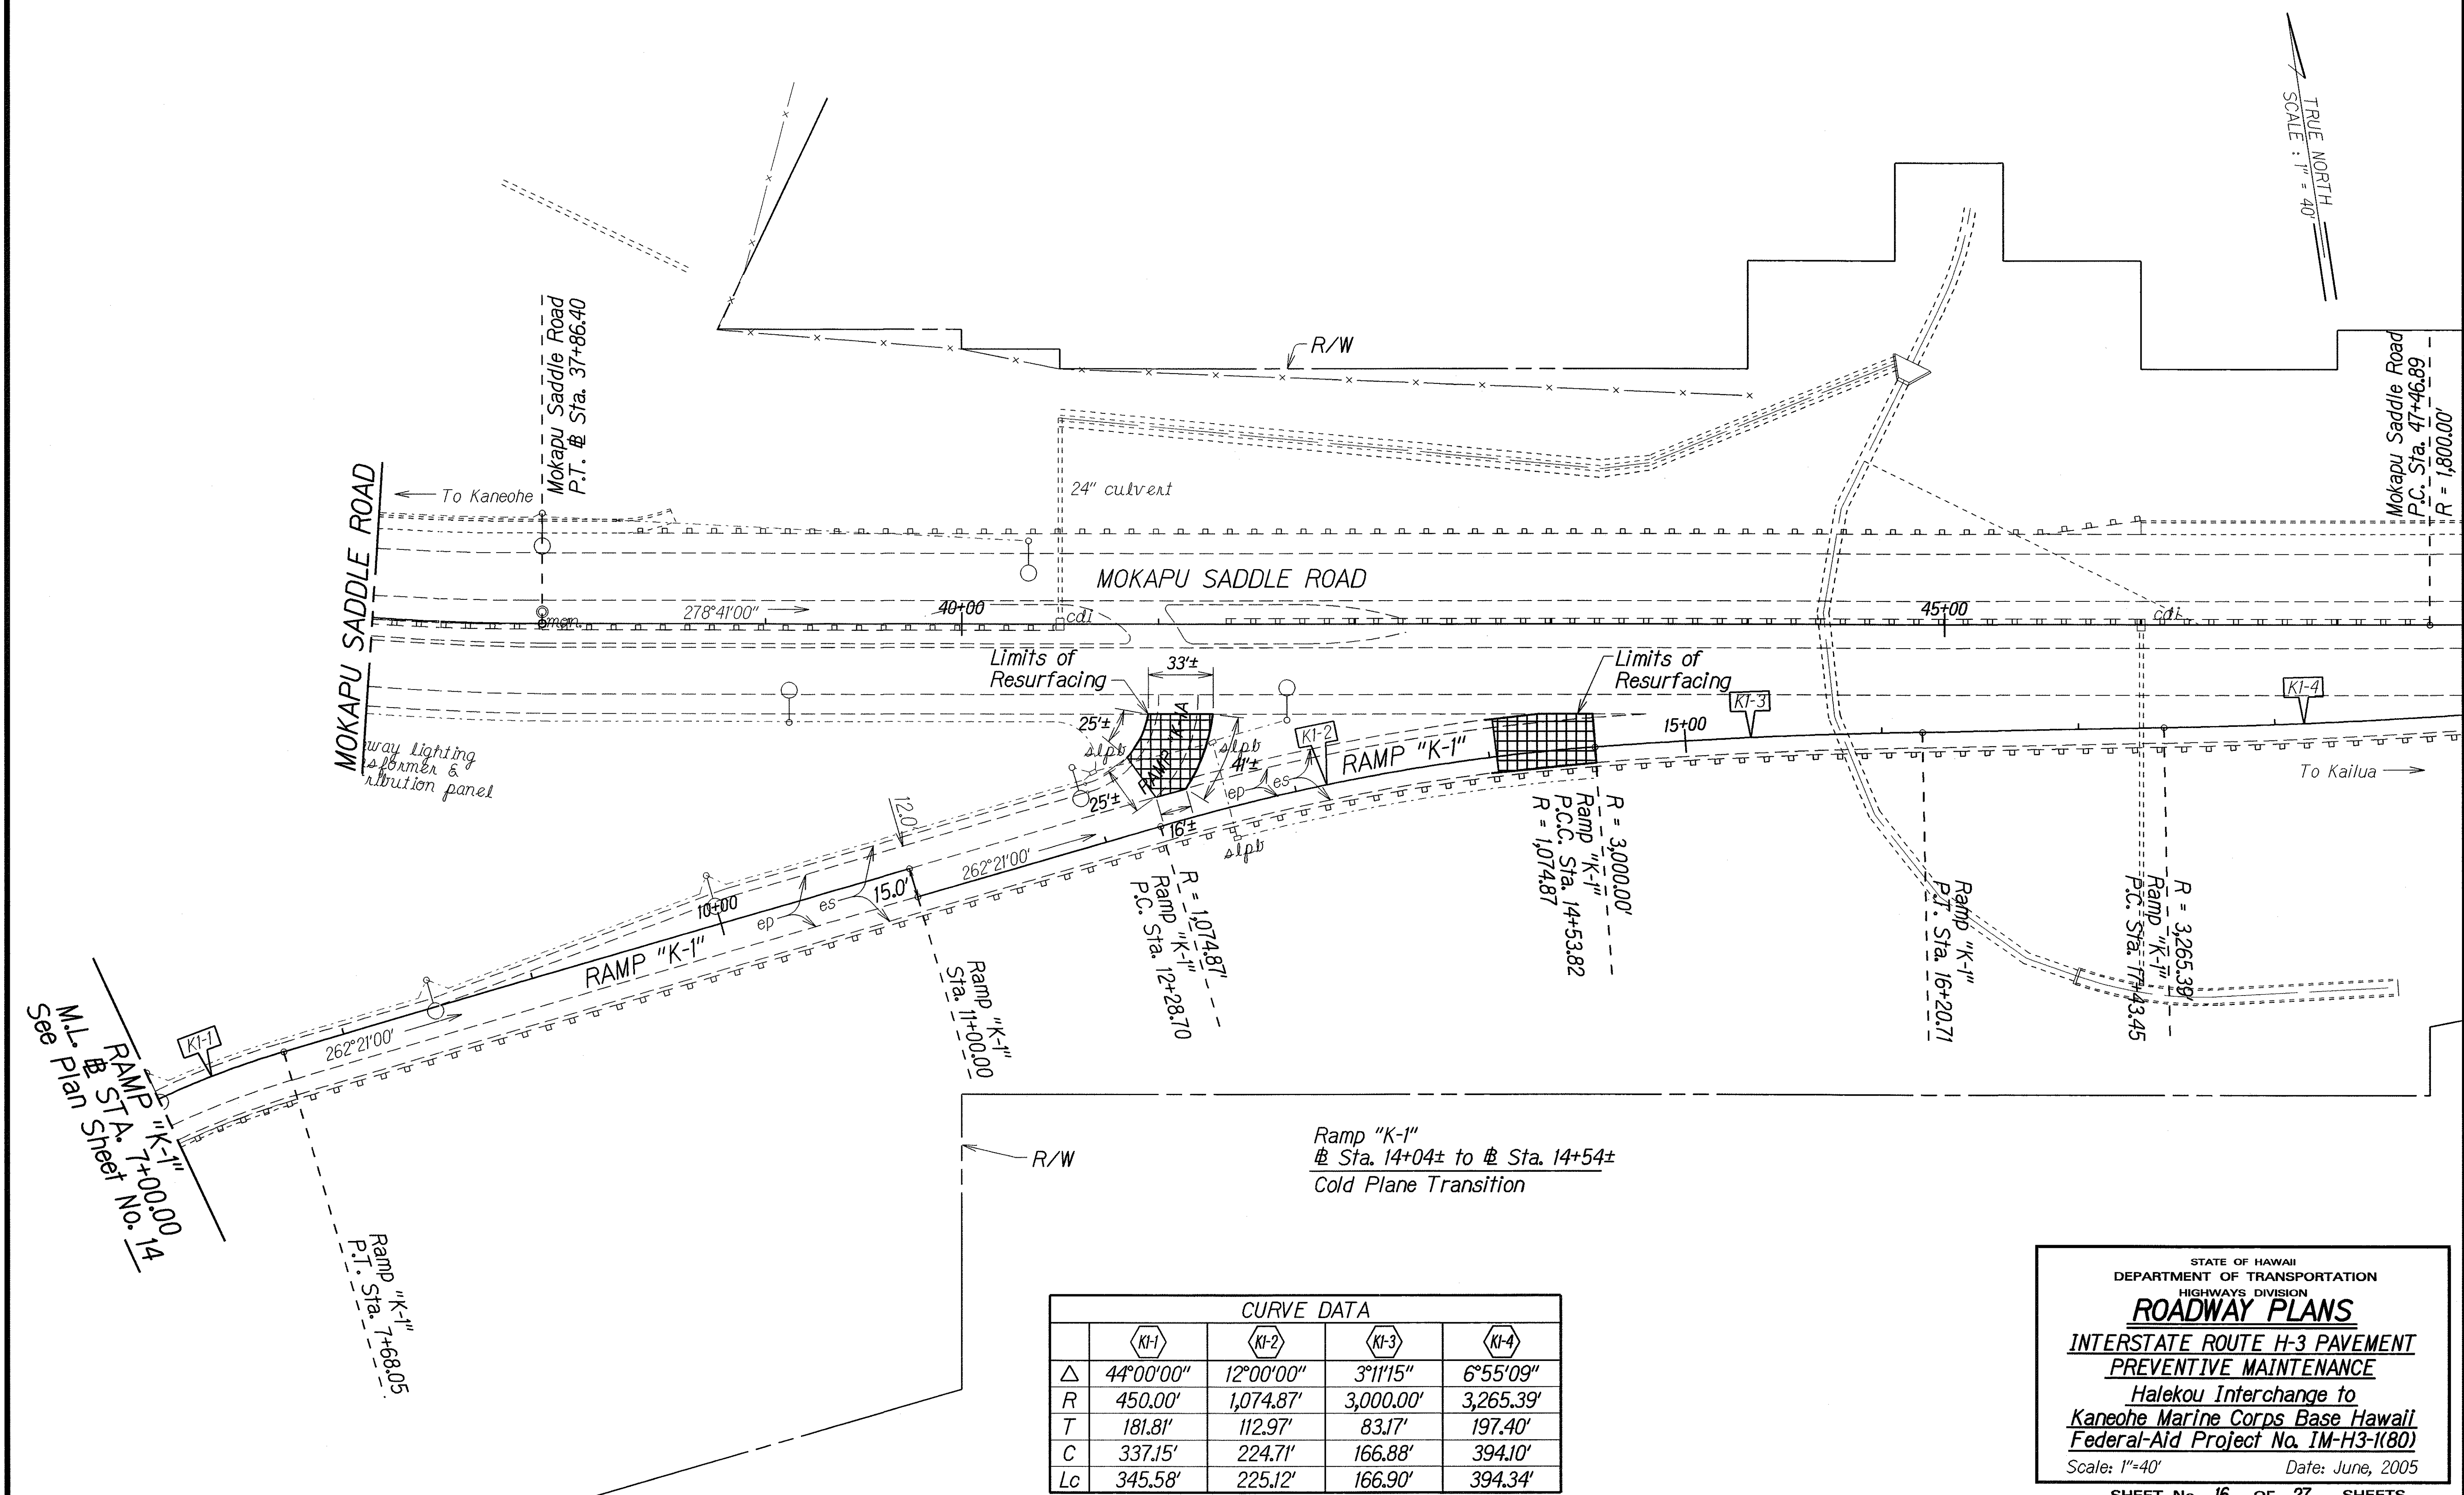

SURVEY PLOTTED BY	DATE
DRAWN BY	
DESIGNED BY	
QUANTITIES BY	
CHECKED BY	
ORIGINAL PLAN	No. 2/13/06

	K1-1	K1-2	K1-3	K1-4
Δ	44°00'00"	12°00'00"	3°11'15"	6°55'09"
R	450.00'	1,074.87'	3,000.00'	3,265.39'
T	181.81'	112.97'	83.17'	197.40'
C	337.15'	224.71'	166.88'	394.10'
Lc	345.58'	225.12'	166.90'	394.34'

STATE OF HAWAII
DEPARTMENT OF TRANSPORTATION
HIGHWAYS DIVISION

ROADWAY PLANS

INTERSTATE ROUTE H-3 PAVEMENT
PREVENTIVE MAINTENANCE


Halekou Interchange to
Kaneohe Marine Corps Base Hawaii
Federal-Aid Project No. IM-H3-1(80)

Scale: 1"=40' Date: June, 2005

SHEET No. 16 OF 27 SHEETS

CURVE DATA			
	H5	H5A	H5B
Δ	27°34'00"	27°34'00"	27°34'00"
R	5,000.00'	5,000.00'	5,000.00'
T	1226.58'	1226.58'	1226.58'
C	2'382.51'	2'382.51'	2'382.51'
Lc	2405.65'	2405.65'	2405.65'

TRUE NORTH
SCALE: 1" = 40'



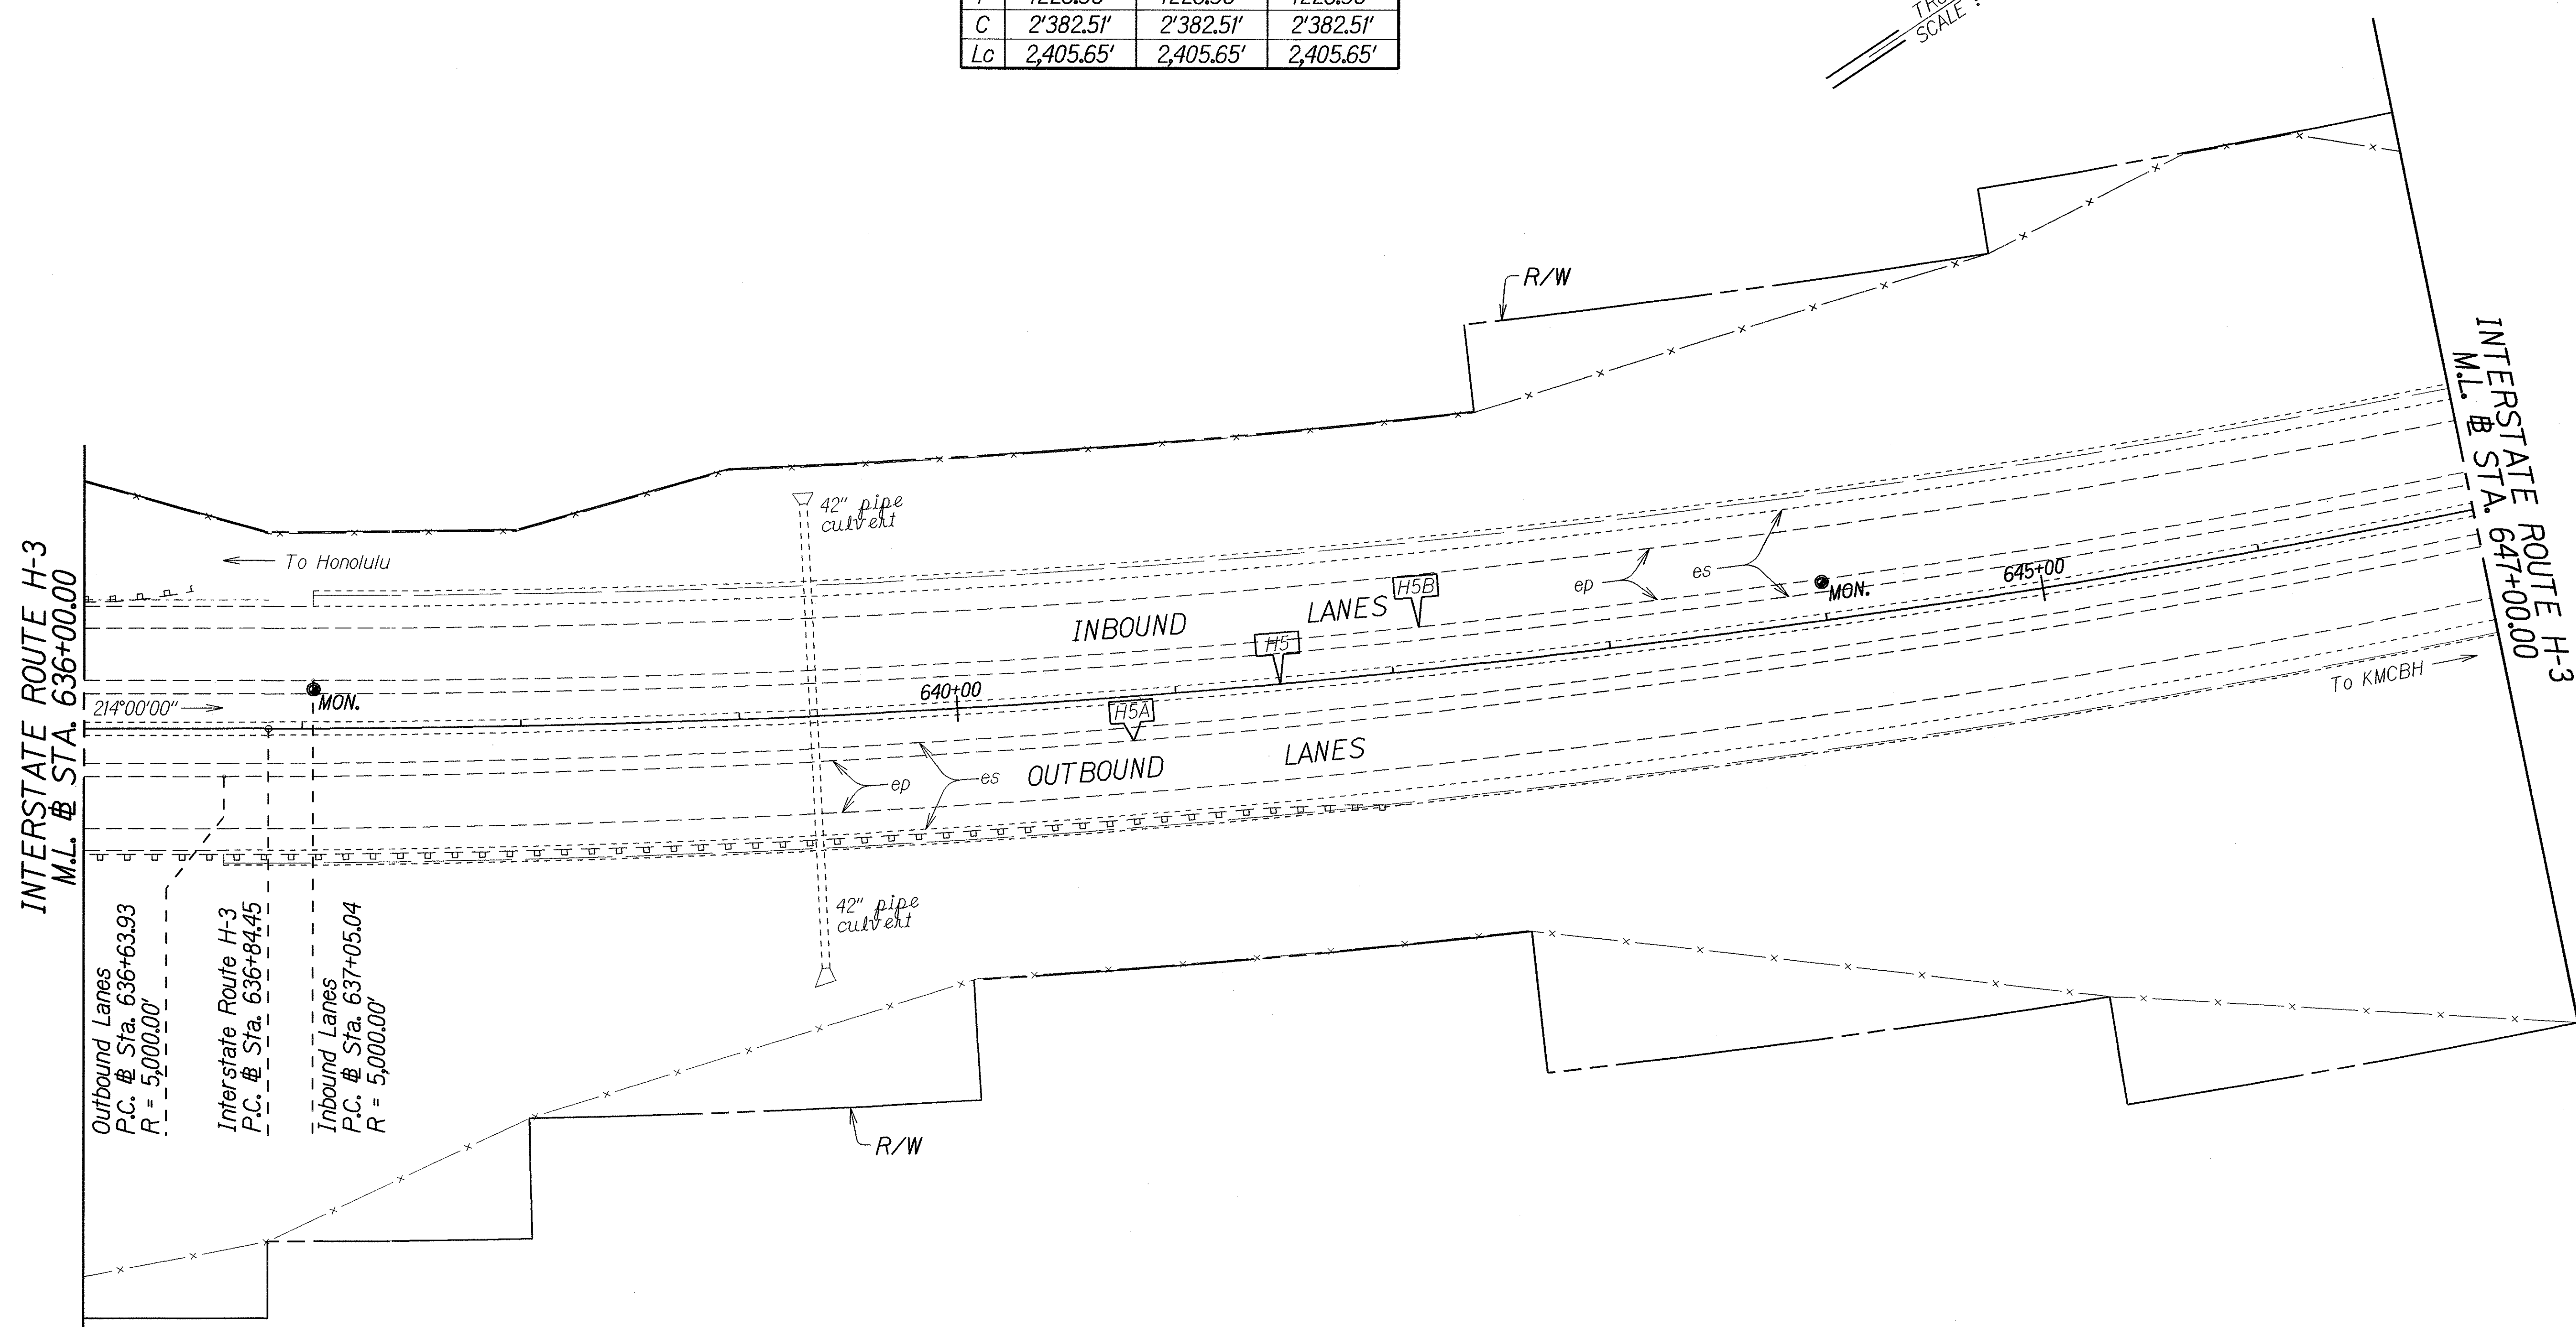


ORIGINAL PLAN	SURVEY PLOTTED BY _____ DATE _____
NOTE BOOK	DRAWN BY _____
	TRACED BY _____
	DESIGNED BY _____
	QUANTITIES BY _____
	CHECKED BY _____

STATE OF HAWAII
DEPARTMENT OF TRANSPORTATION
HIGHWAYS DIVISION
ROADWAY PLANS
INTERSTATE ROUTE H-3 PAVEMENT
PREVENTIVE MAINTENANCE
Halekou Interchange to
Kaneohe Marine Corps Base Hawaii
Federal-Aid Project No. IM-H3-(80)
Scale: 1"=40' Date: June, 2005
SHEET NO. 17 OF 37 SHEETS

FED. ROAD DIST. NO.	STATE	FED. AID PROJ. NO.	FISCAL YEAR	SHEET NO.	TOTAL SHEETS
HAWAII	HAW.	IM-H3-1(80)	2006	25	66

CURVE DATA			
	H5	H5A	H5B
Δ	27°34'00"	27°34'00"	27°34'00"
R	5,000.00'	5,000.00'	5,000.00'
T	1226.58'	1226.58'	1226.58'
C	2'382.51'	2'382.51'	2'382.51'
Lc	2,405.65'	2,405.65'	2,405.65'

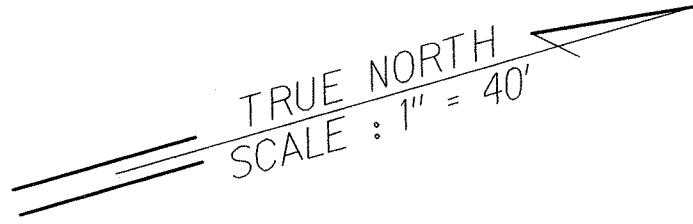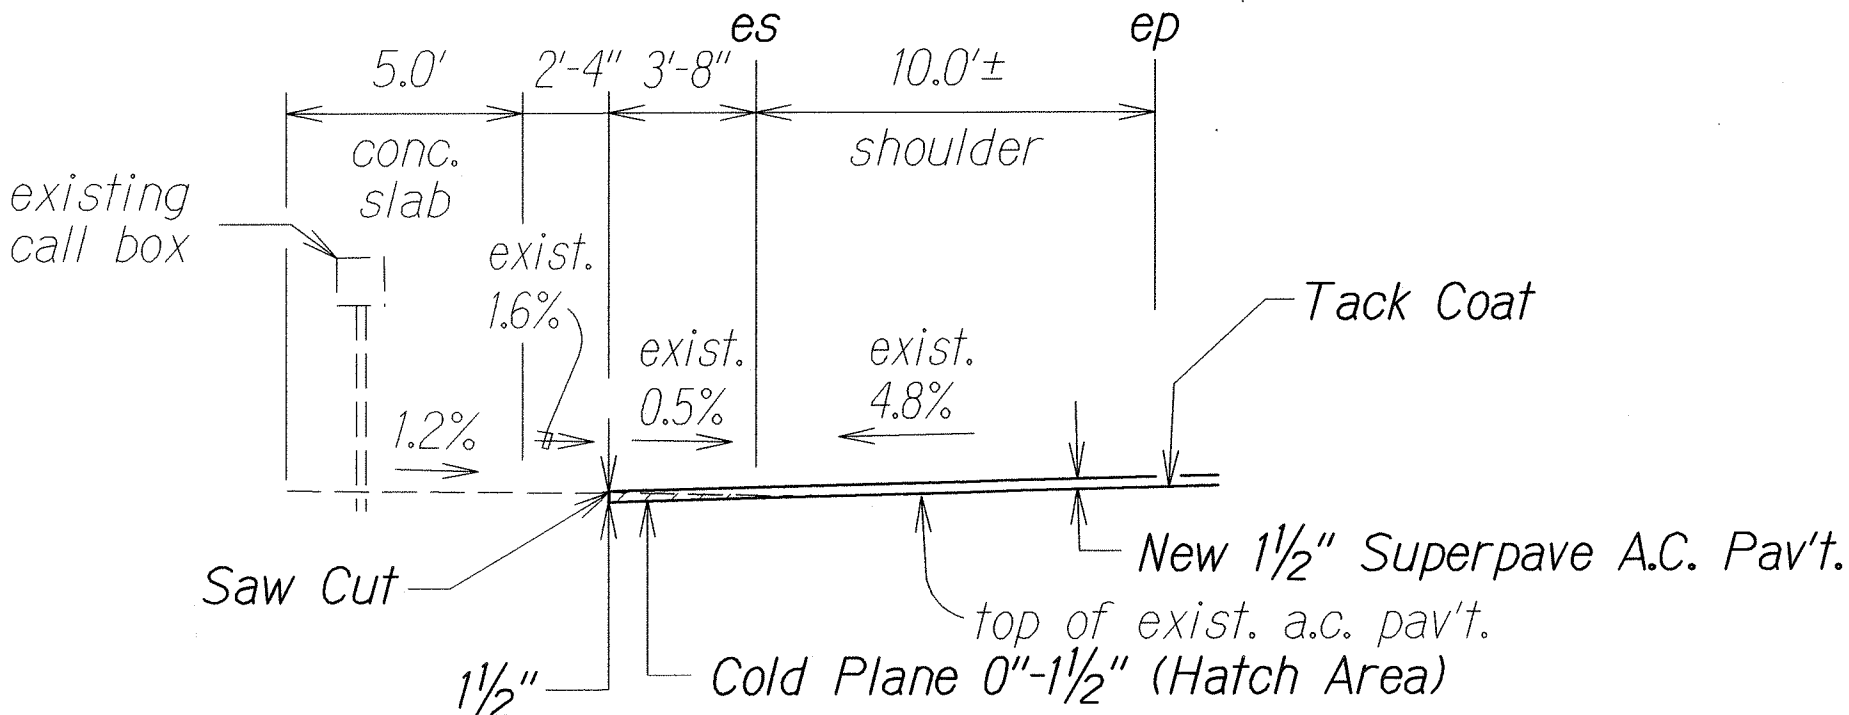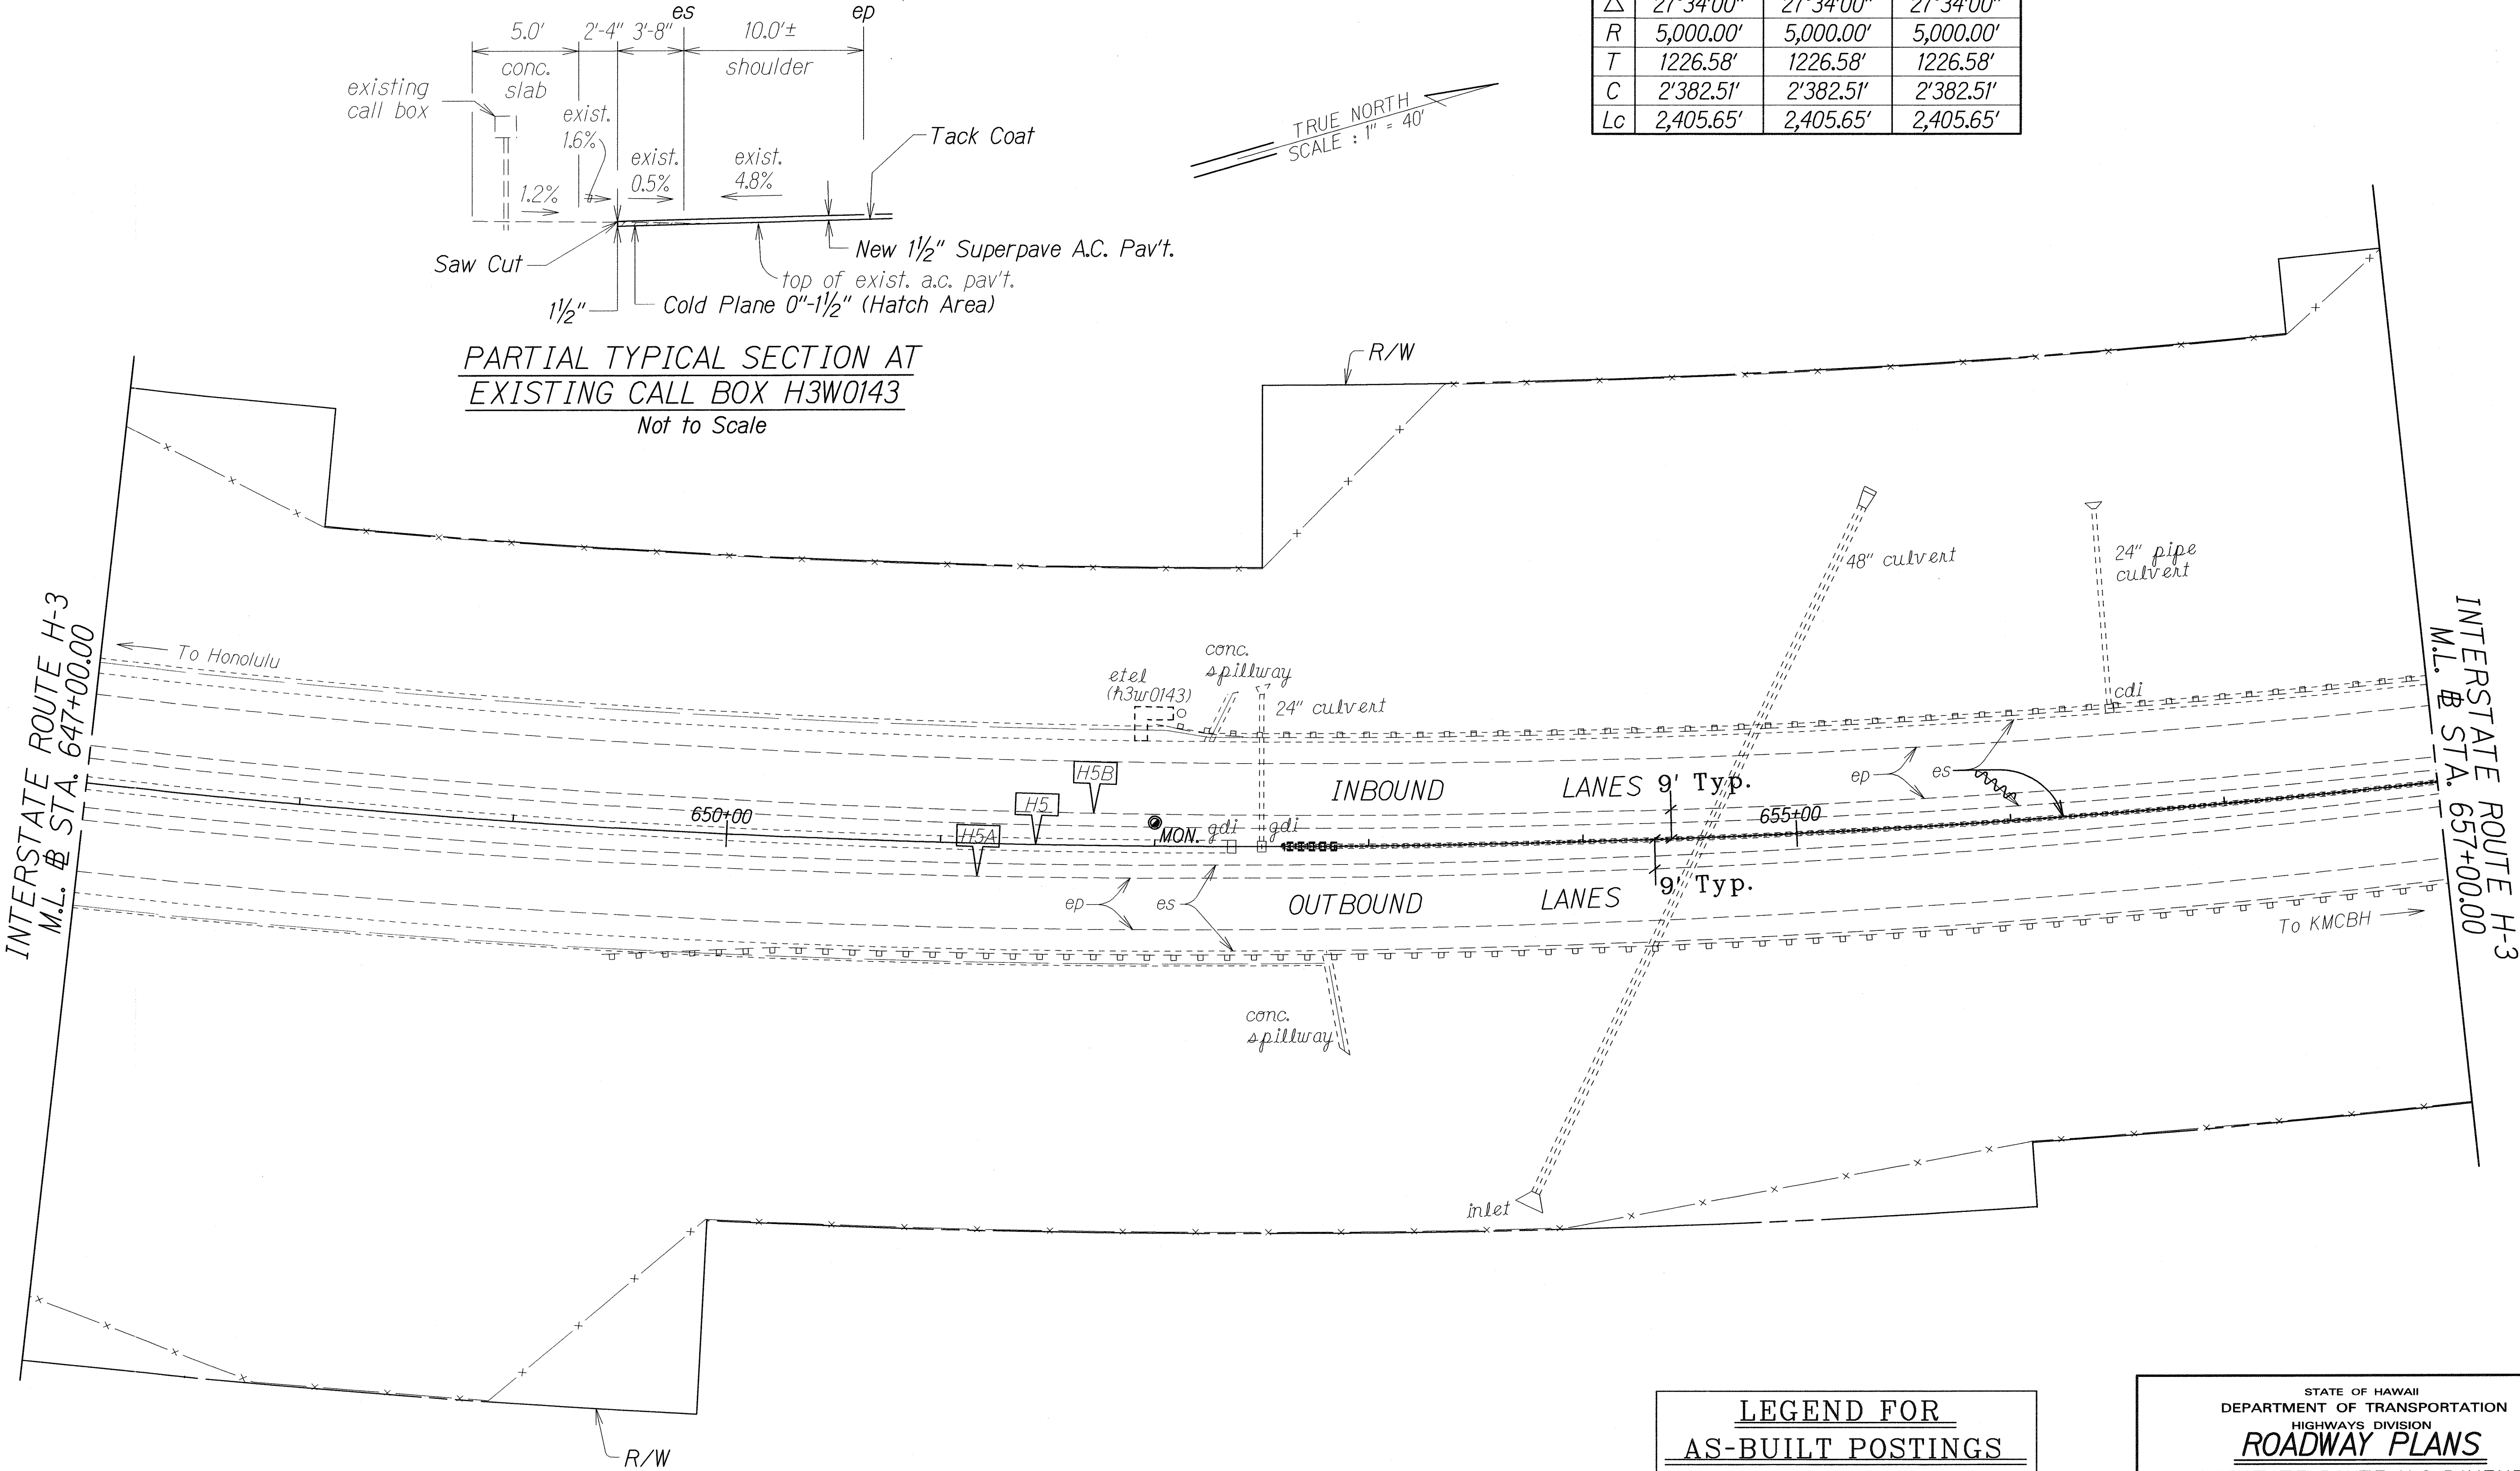

ORIGINAL	DATE
DESIGNED BY	
TRACED BY	
NOTED BY	
DESIGNED BY	
QUANTITIES BY	
CHECKED BY	

asbuilt2008.4th3ap18.dgn

LEGEND FOR AS-BUILT POSTINGS	
	Squiggly line for as-built deletion
	Double line for as-built deletion
Roadway	Text for as-built posting

STATE OF HAWAII
DEPARTMENT OF TRANSPORTATION
HIGHWAYS DIVISION


ROADWAY PLANS
INTERSTATE ROUTE H-3 PAVEMENT
PREVENTIVE MAINTENANCE
Halekou Interchange to
Kaneohe Marine Corps Base Hawaii
Federal-Aid Project No. IM-H3-1(80)
Scale: 1"=40'

Date: June, 2005

CURVE DATA			
	H5	H5A	H5B
Δ	27°34'00"	27°34'00"	27°34'00"
R	5,000.00'	5,000.00'	5,000.00'
T	1226.58'	1226.58'	1226.58'
C	2'382.51'	2'382.51'	2'382.51'
Lc	2,405.65'	2,405.65'	2,405.65'

FED. ROAD DIST. NO.	STATE	FED. AID PROJ. NO.	FISCAL YEAR	SHEET NO.	TOTAL SHEETS
HAWAII	HAW.	IM-H3-1(80)	2006	26	66

TRUE NORTH
SCALE : 1" = 40'

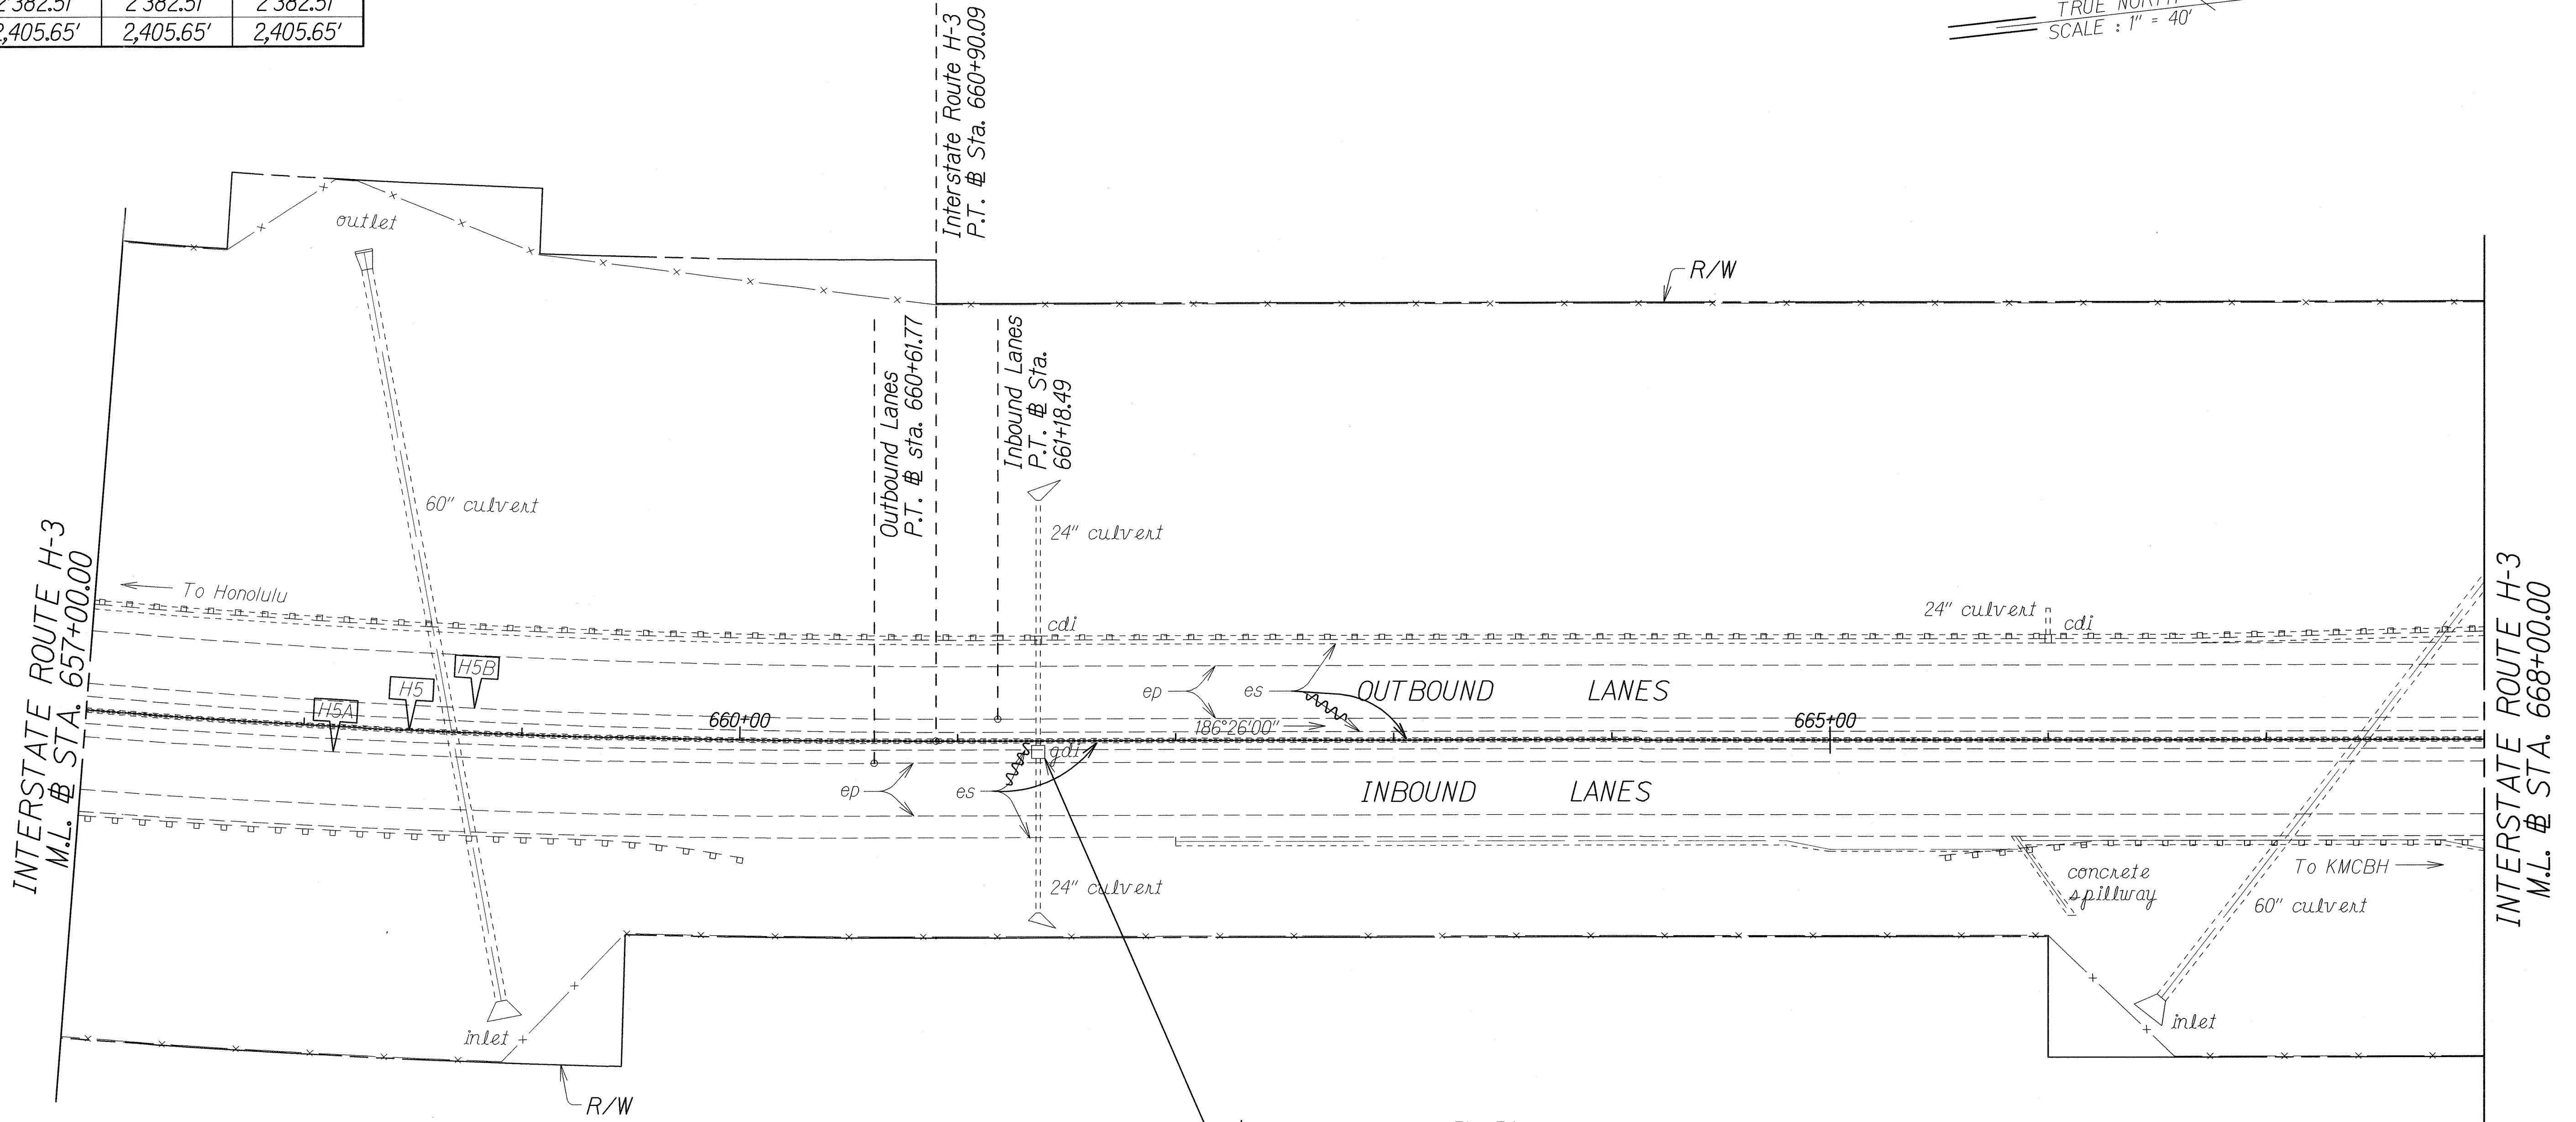

ORIGINAL PLAN	SURVEY PLOTTED BY	DATE
NOTE BOOK	DESIGNED BY	
QUANTITIES BY	CHECKED BY	
No. 21/3/09		

asbuilt2008.4th3dp19.dgn

LEGEND FOR AS-BUILT POSTINGS	
	Squiggly line for as-built deletion
	Double line for as-built deletion
Roadway	Text for as-built posting

STATE OF HAWAII
DEPARTMENT OF TRANSPORTATION
HIGHWAYS DIVISION
ROADWAY PLANS
INTERSTATE ROUTE H-3 PAVEMENT PREVENTIVE MAINTENANCE
Halekou Interchange to Kaneohe Marine Corps Base Hawaii
Federal-Aid Project No. IM-H3-1(80)
Scale: 1"=40' Date: June, 2005


SHEET No. 19 OF 27 SHEETS

"AS-BUILT"

FED. ROAD DIST. NO.	STATE	FED. AID PROJ. NO.	FISCAL YEAR	SHEET NO.	TOTAL SHEETS
HAWAII	HAW.	1M-H3-1(80)	2006	27	66

CURVE DATA		
	L7	L8
Δ	6°27'04"	15°46'00"
R	1,781.35'	841.95'
T	100.39'	116.58'
C	200.46'	230.96'
Lc	200.57'	231.69'

TRUE NORTH
SCALE : 1" = 40'

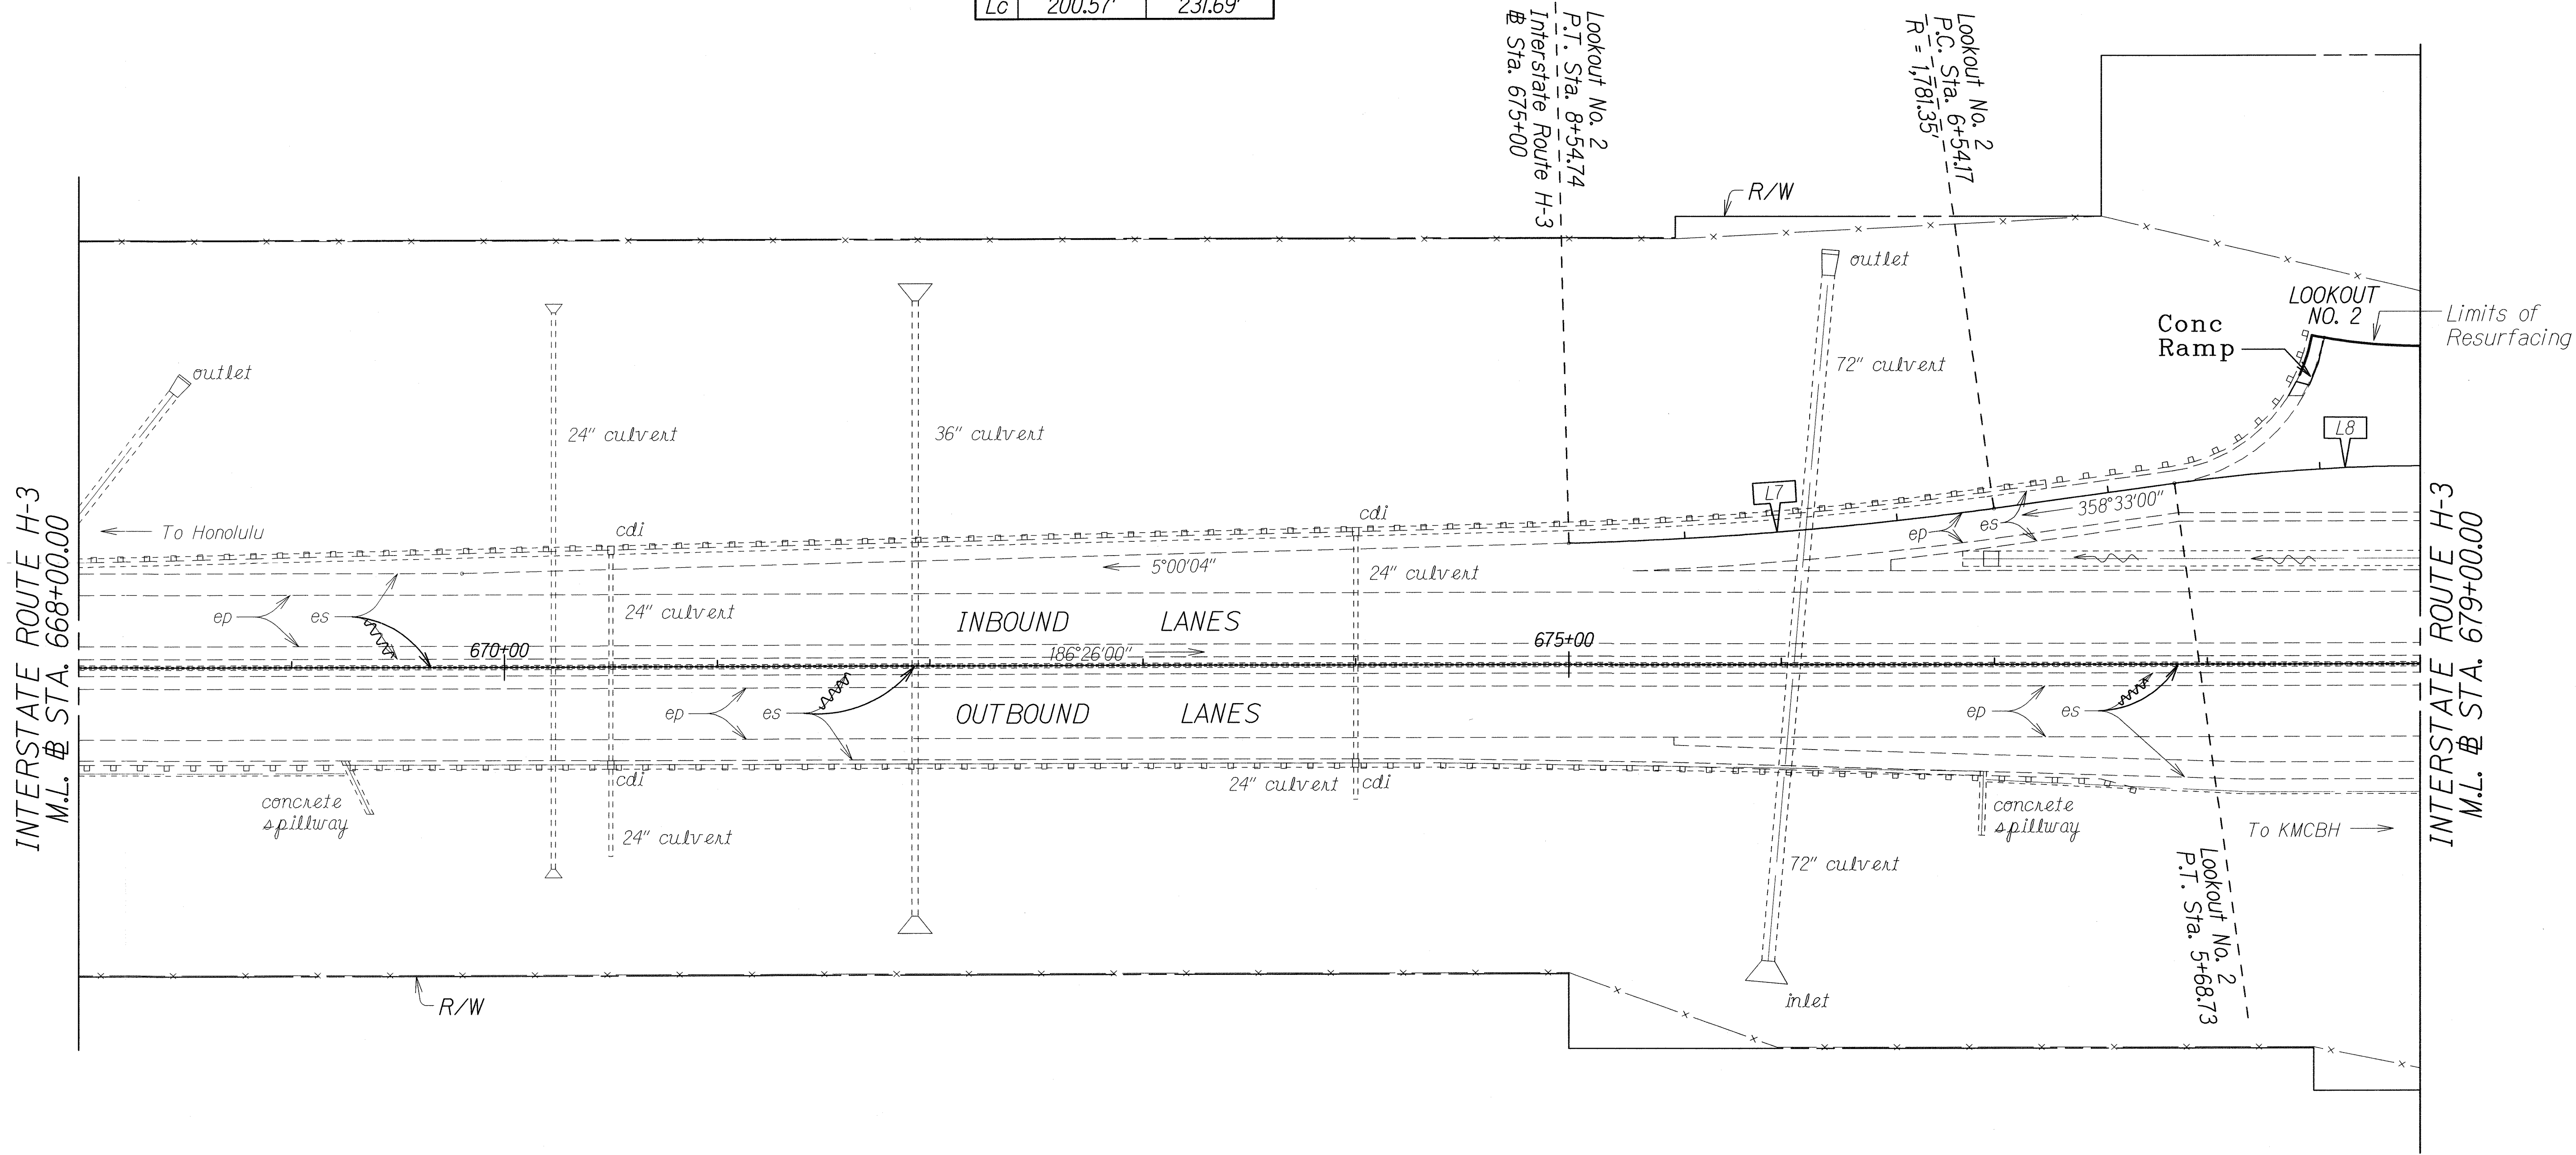

ORIGINAL PLAN	DATE
NOTED BY	DESIGNED BY
QUANTITIES BY	CHECKED BY
2/13/2020	

asbuilt2008 41h3dp20.dgn

LEGEND FOR AS-BUILT POSTINGS	
	Squiggly line for as-built deletion
	Double line for as-built deletion
Roadway	Text for as-built posting


STATE OF HAWAII
DEPARTMENT OF TRANSPORTATION
HIGHWAYS DIVISION
ROADWAY PLANS
INTERSTATE ROUTE H-3 PAVEMENT PREVENTIVE MAINTENANCE
Halekou Interchange to Kaneohe Marine Corps Base Hawaii
Federal-Aid Project No. 1M-H3-1(80)
Scale: 1"=40' Date: June, 2005
SHEET No. 20 OF 27 SHEETS

"AS-BUILT"

FED. ROAD DIST. NO.	STATE	FED. AID PROJ. NO.	FISCAL YEAR	SHEET NO.	TOTAL SHEETS
HAWAII	HAW.	1M-H3-1(80)	2006	29	66

CURVE DATA		
	H6	M3
Δ	10°17'00"	47°05'00"
R	3,000.00'	764.00'
T	269.94'	332.86'
C	537.71'	610.30'
Lc	538.43'	627.82'

TRUE NORTH
SCALE : 1" = 40'

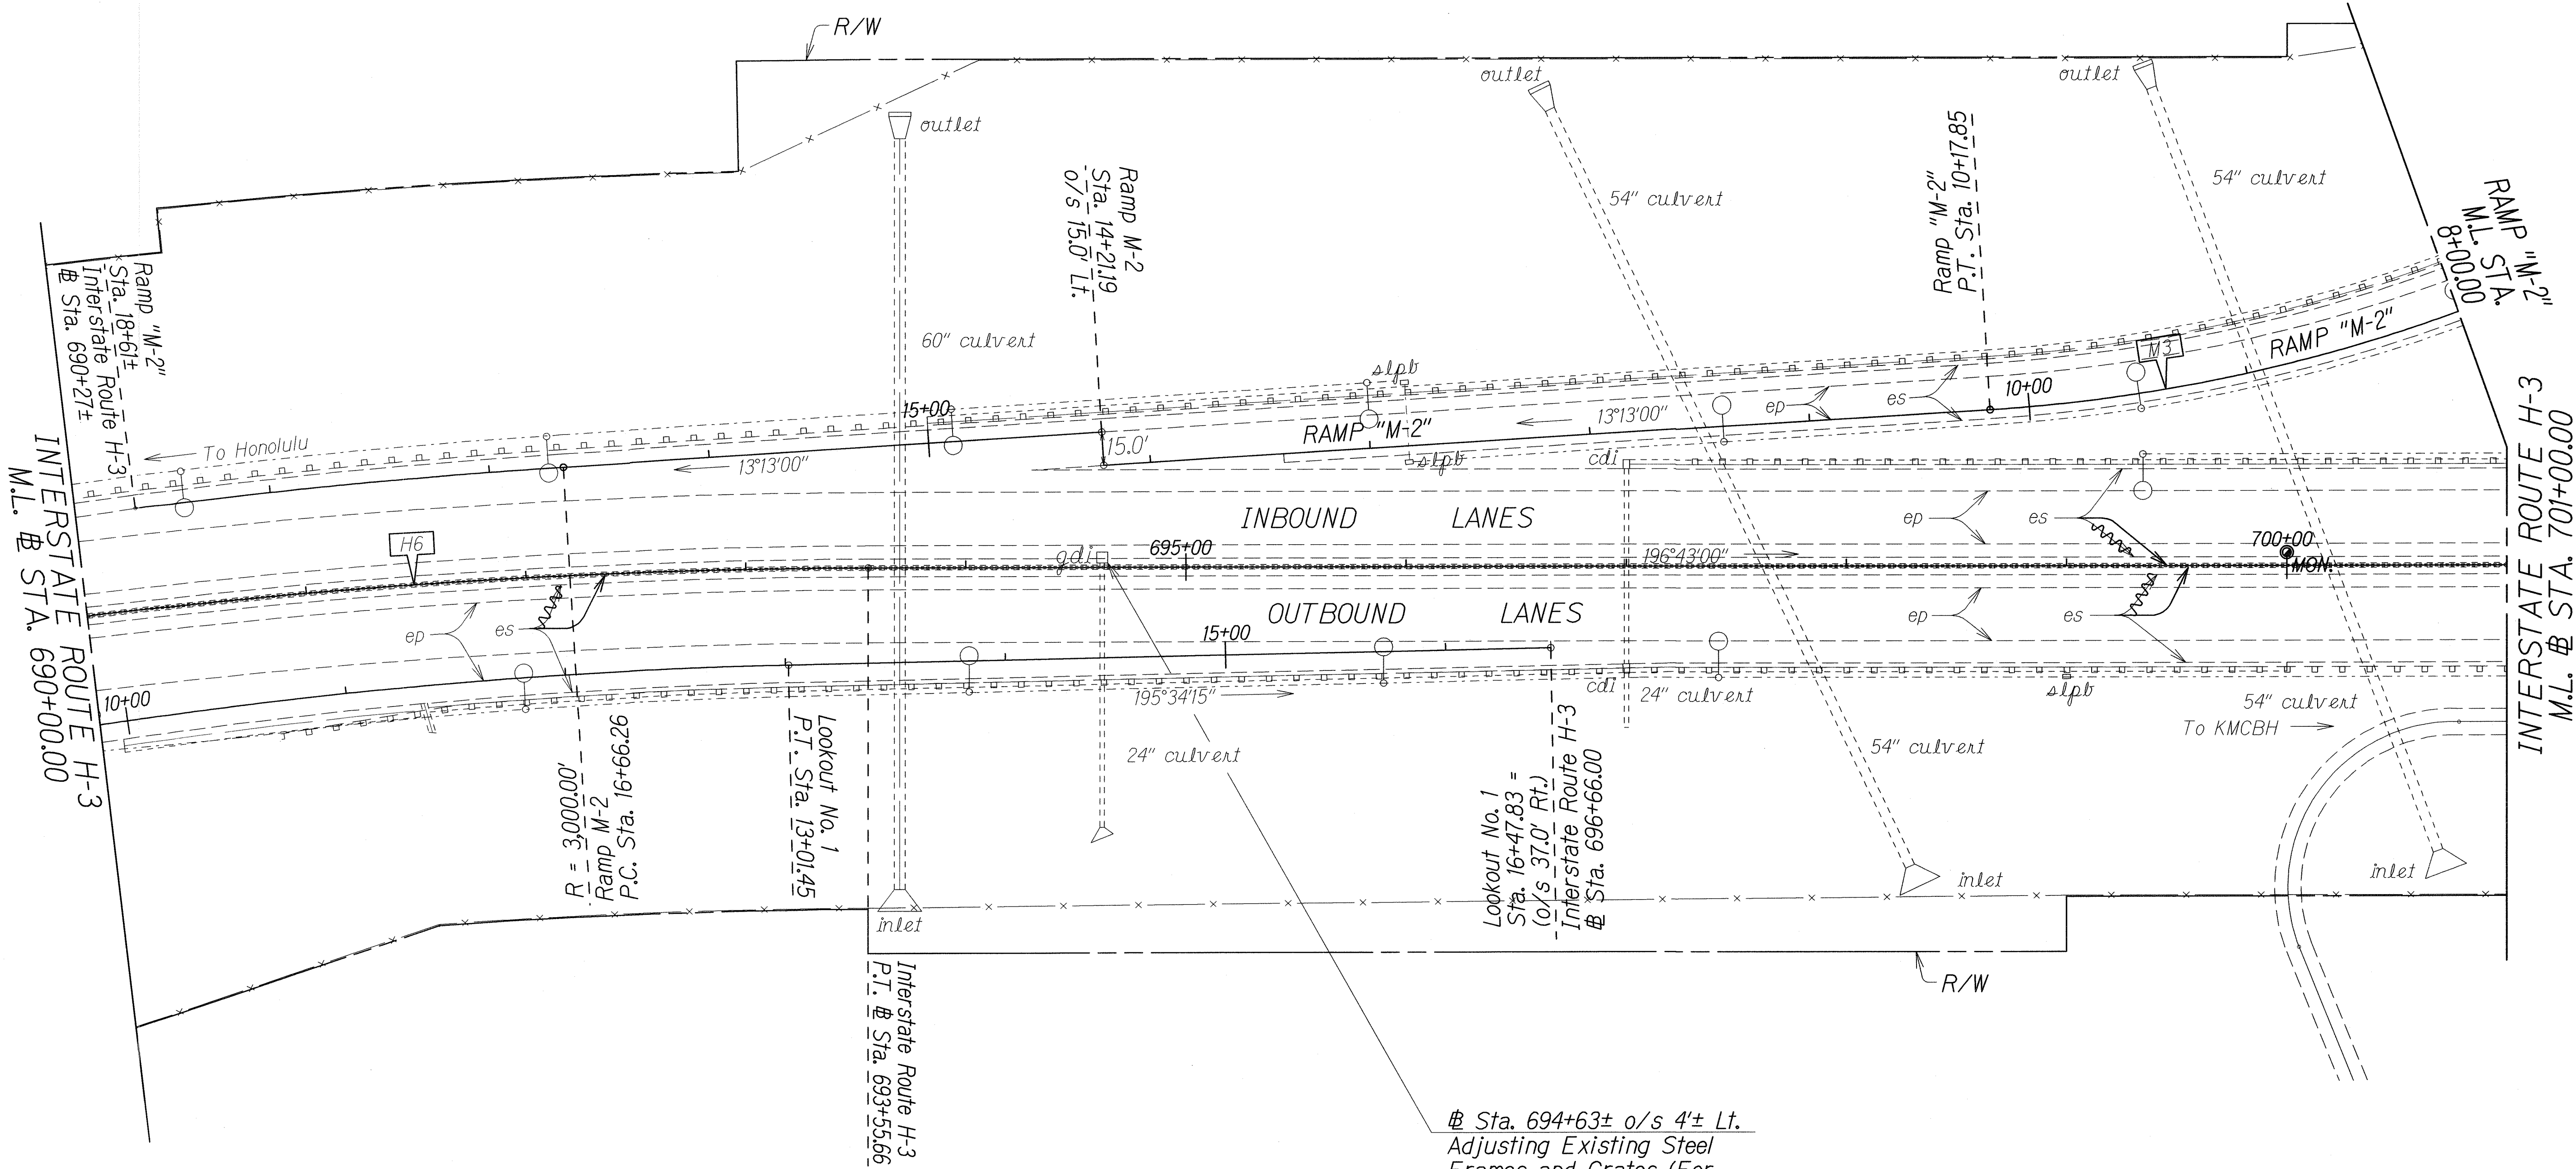

Sta. 694+63± o/s 4'± Lt.
Adjusting Existing Steel
Frames and Grates (For
Details, See Plan Sheet
No. 66).

LEGEND FOR AS-BUILT POSTINGS	
	Squiggly line for as-built deletion
	Double line for as-built deletion
Roadway	Text for as-built posting

STATE OF HAWAII
DEPARTMENT OF TRANSPORTATION
HIGHWAYS DIVISION


ROADWAY PLANS
INTERSTATE ROUTE H-3 PAVEMENT
PREVENTIVE MAINTENANCE
Halekou Interchange to
Kaneohe Marine Corps Base Hawaii
Federal-Aid Project No. 1M-H3-1(80)
Scale: 1"=40' Date: June, 2005

SHEET No. 22 OF 27 SHEETS

ORIGINAL PLAN	DATE
DESIGNED BY	
TRACED BY	
QUANTITIES BY	
CHECKED BY	

asbuilt2008.41h3p22.dgn

FED. ROAD DIST. NO.	STATE	FED. AID PROJ. NO.	FISCAL YEAR	SHEET NO.	TOTAL SHEETS
HAWAII	HAW.	IM-H3-1(80)	2006	30	66

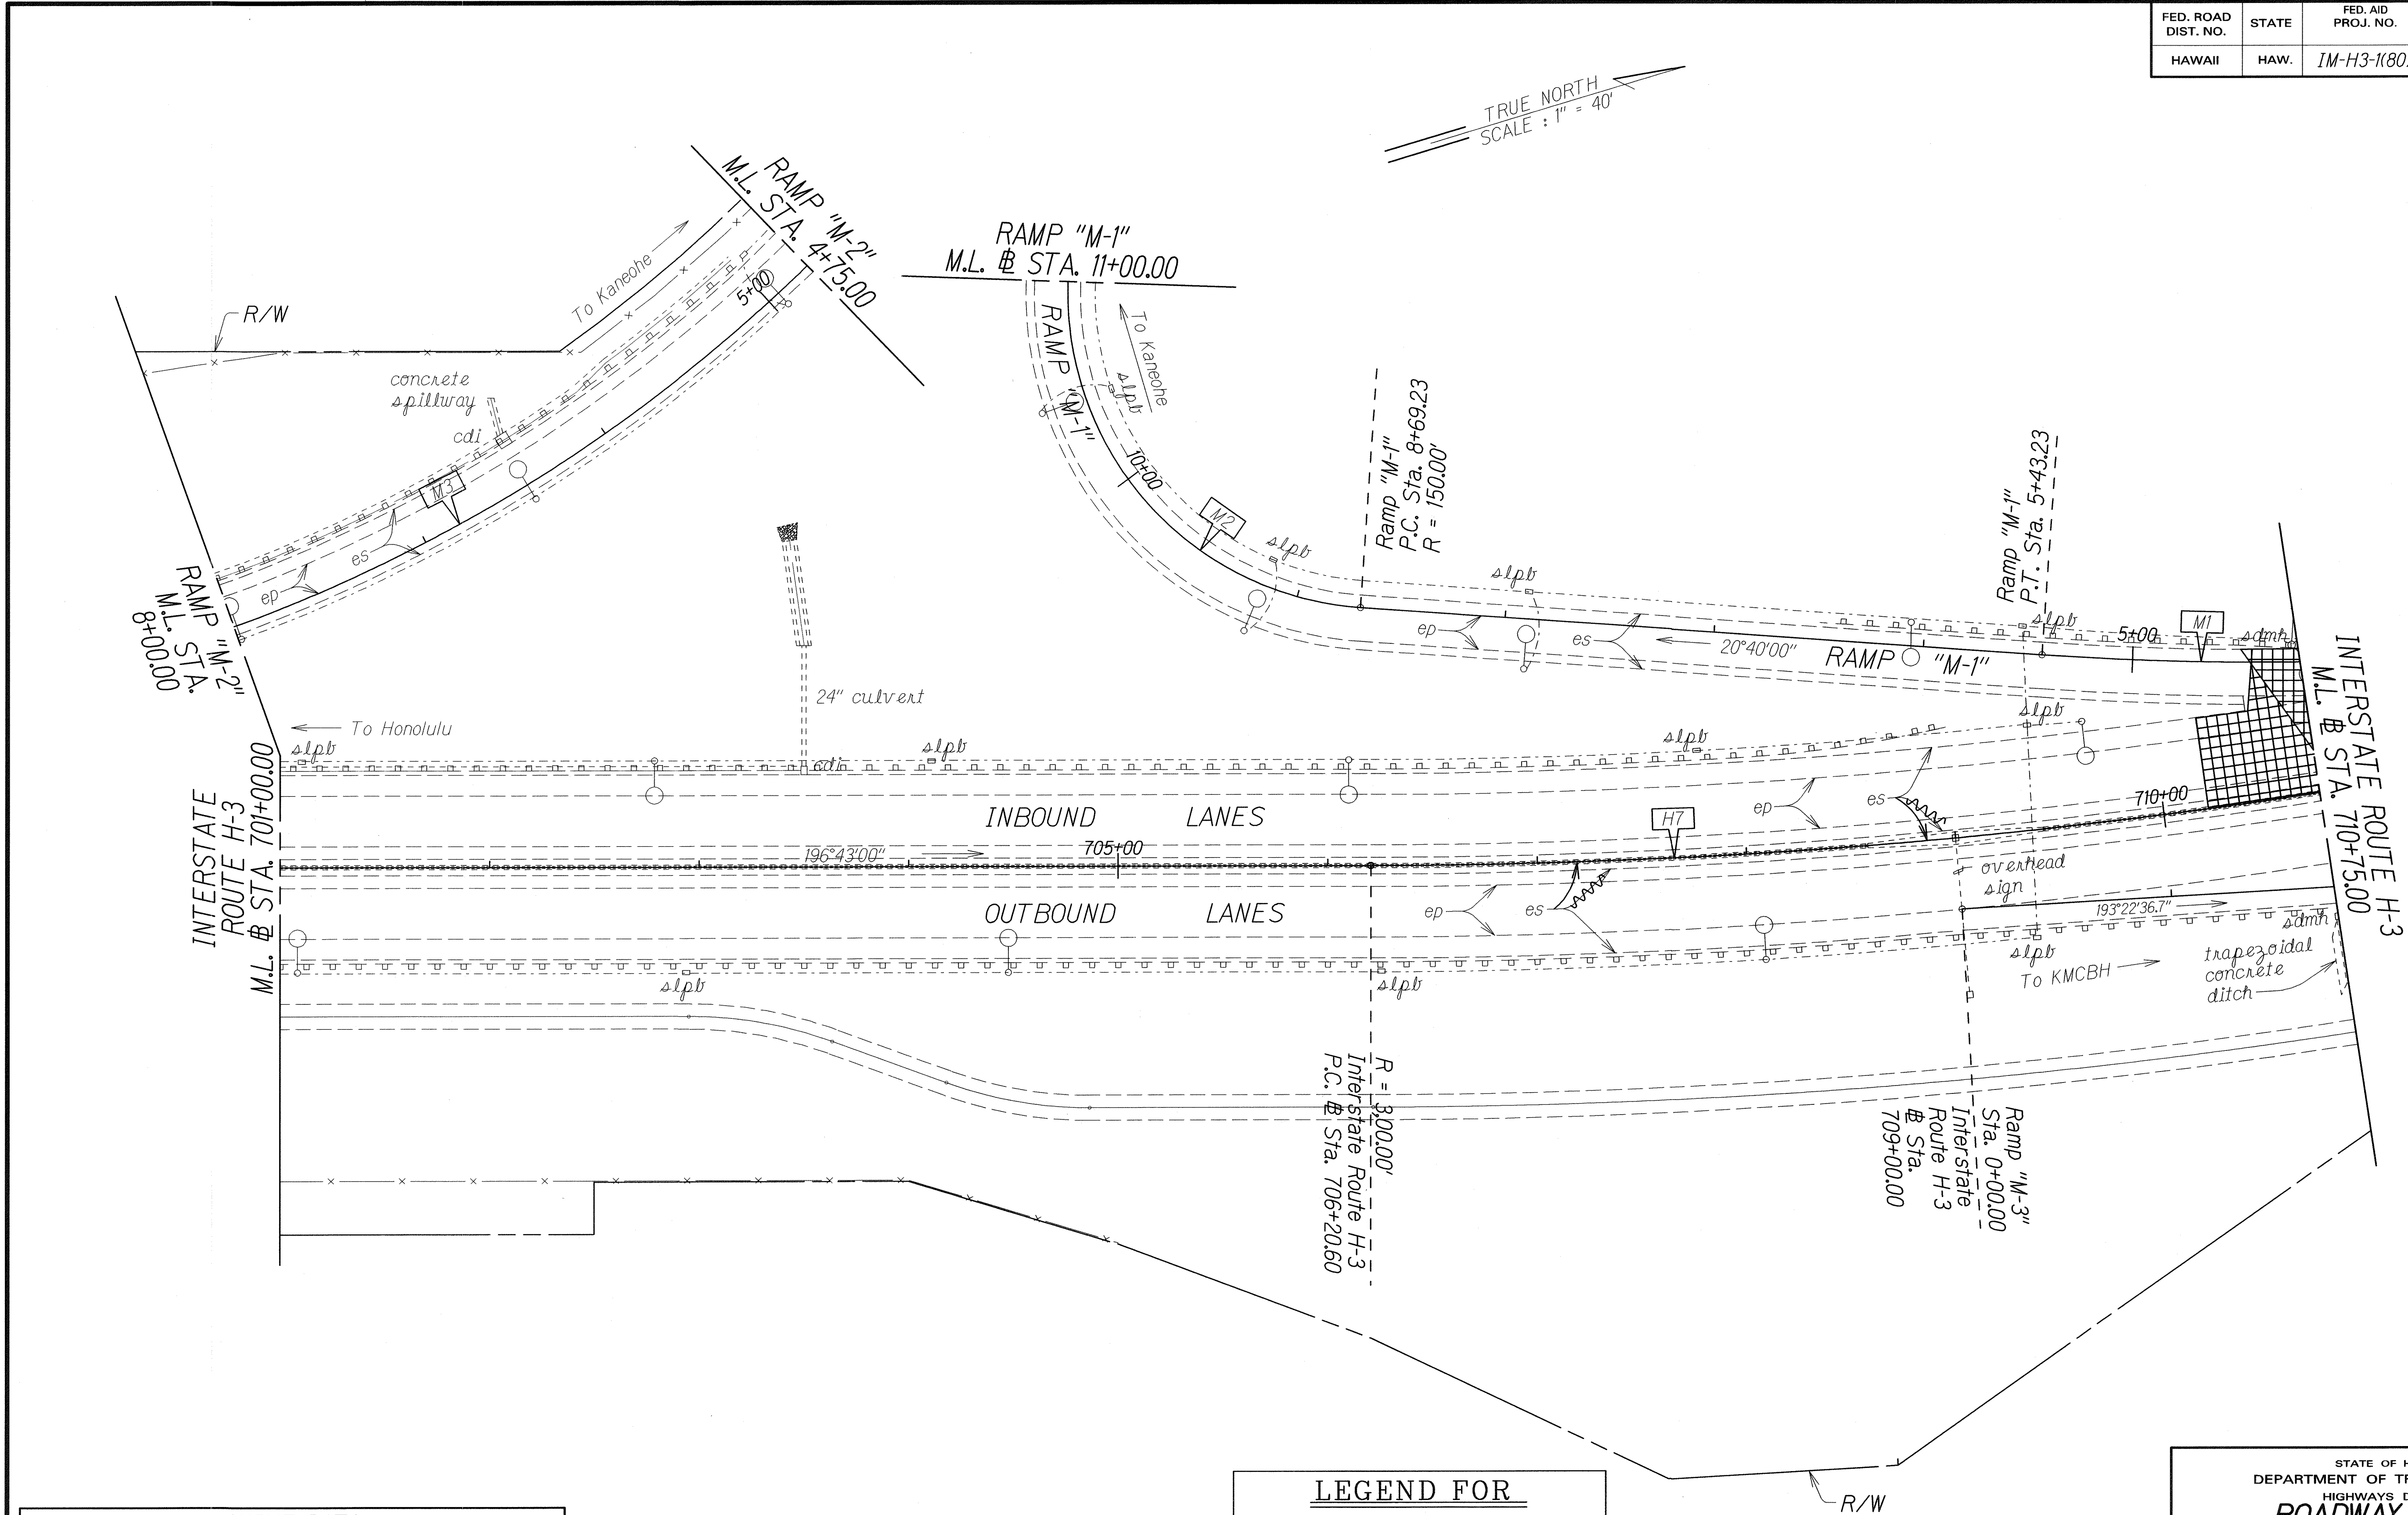

CURVE DATA				
	H7	M1	M2	M3
Δ	23°21'00"	20°45'00"	125°28'00"	47°05'00"
R	3,000.00'	1,500.00'	150.00'	764.00'
T	619.91'	274.63'	291.03'	332.86'
C	1,214.16'	540.26'	266.66'	610.30'
Lc	1,222.60'	543.23'	328.47'	627.82'

LEGEND FOR AS-BUILT POSTINGS	
	Squiggly line for as-built deletion
	Double line for as-built deletion
Roadway	Text for as-built posting

STATE OF HAWAII
DEPARTMENT OF TRANSPORTATION
HIGHWAYS DIVISION

ROADWAY PLANS

INTERSTATE ROUTE H-3 PAVEMENT PREVENTIVE MAINTENANCE

Halekou Interchange to Kaneohe Marine Corps Base Hawaii

Federal-Aid Project No. IM-H3-1(80)

Scale: 1"=40' Date: June, 2005


SHEET No. 23 OF 27 SHEETS

ORIGINAL PLAN	SURVEY PLOTTED BY	DATE
NOTE BOOK	DESIGNED BY	
QUANTITIES BY	CHECKED BY	
2/10/30/23		

asbuilt2008.41h3dp23.dgn

"AS-BUILT"

FED. ROAD DIST. NO.	STATE	FED. AID PROJ. NO.	FISCAL YEAR	SHEET NO.	TOTAL SHEETS
HAWAII	HAW.	IM-H3-1(80)	2006	31	66

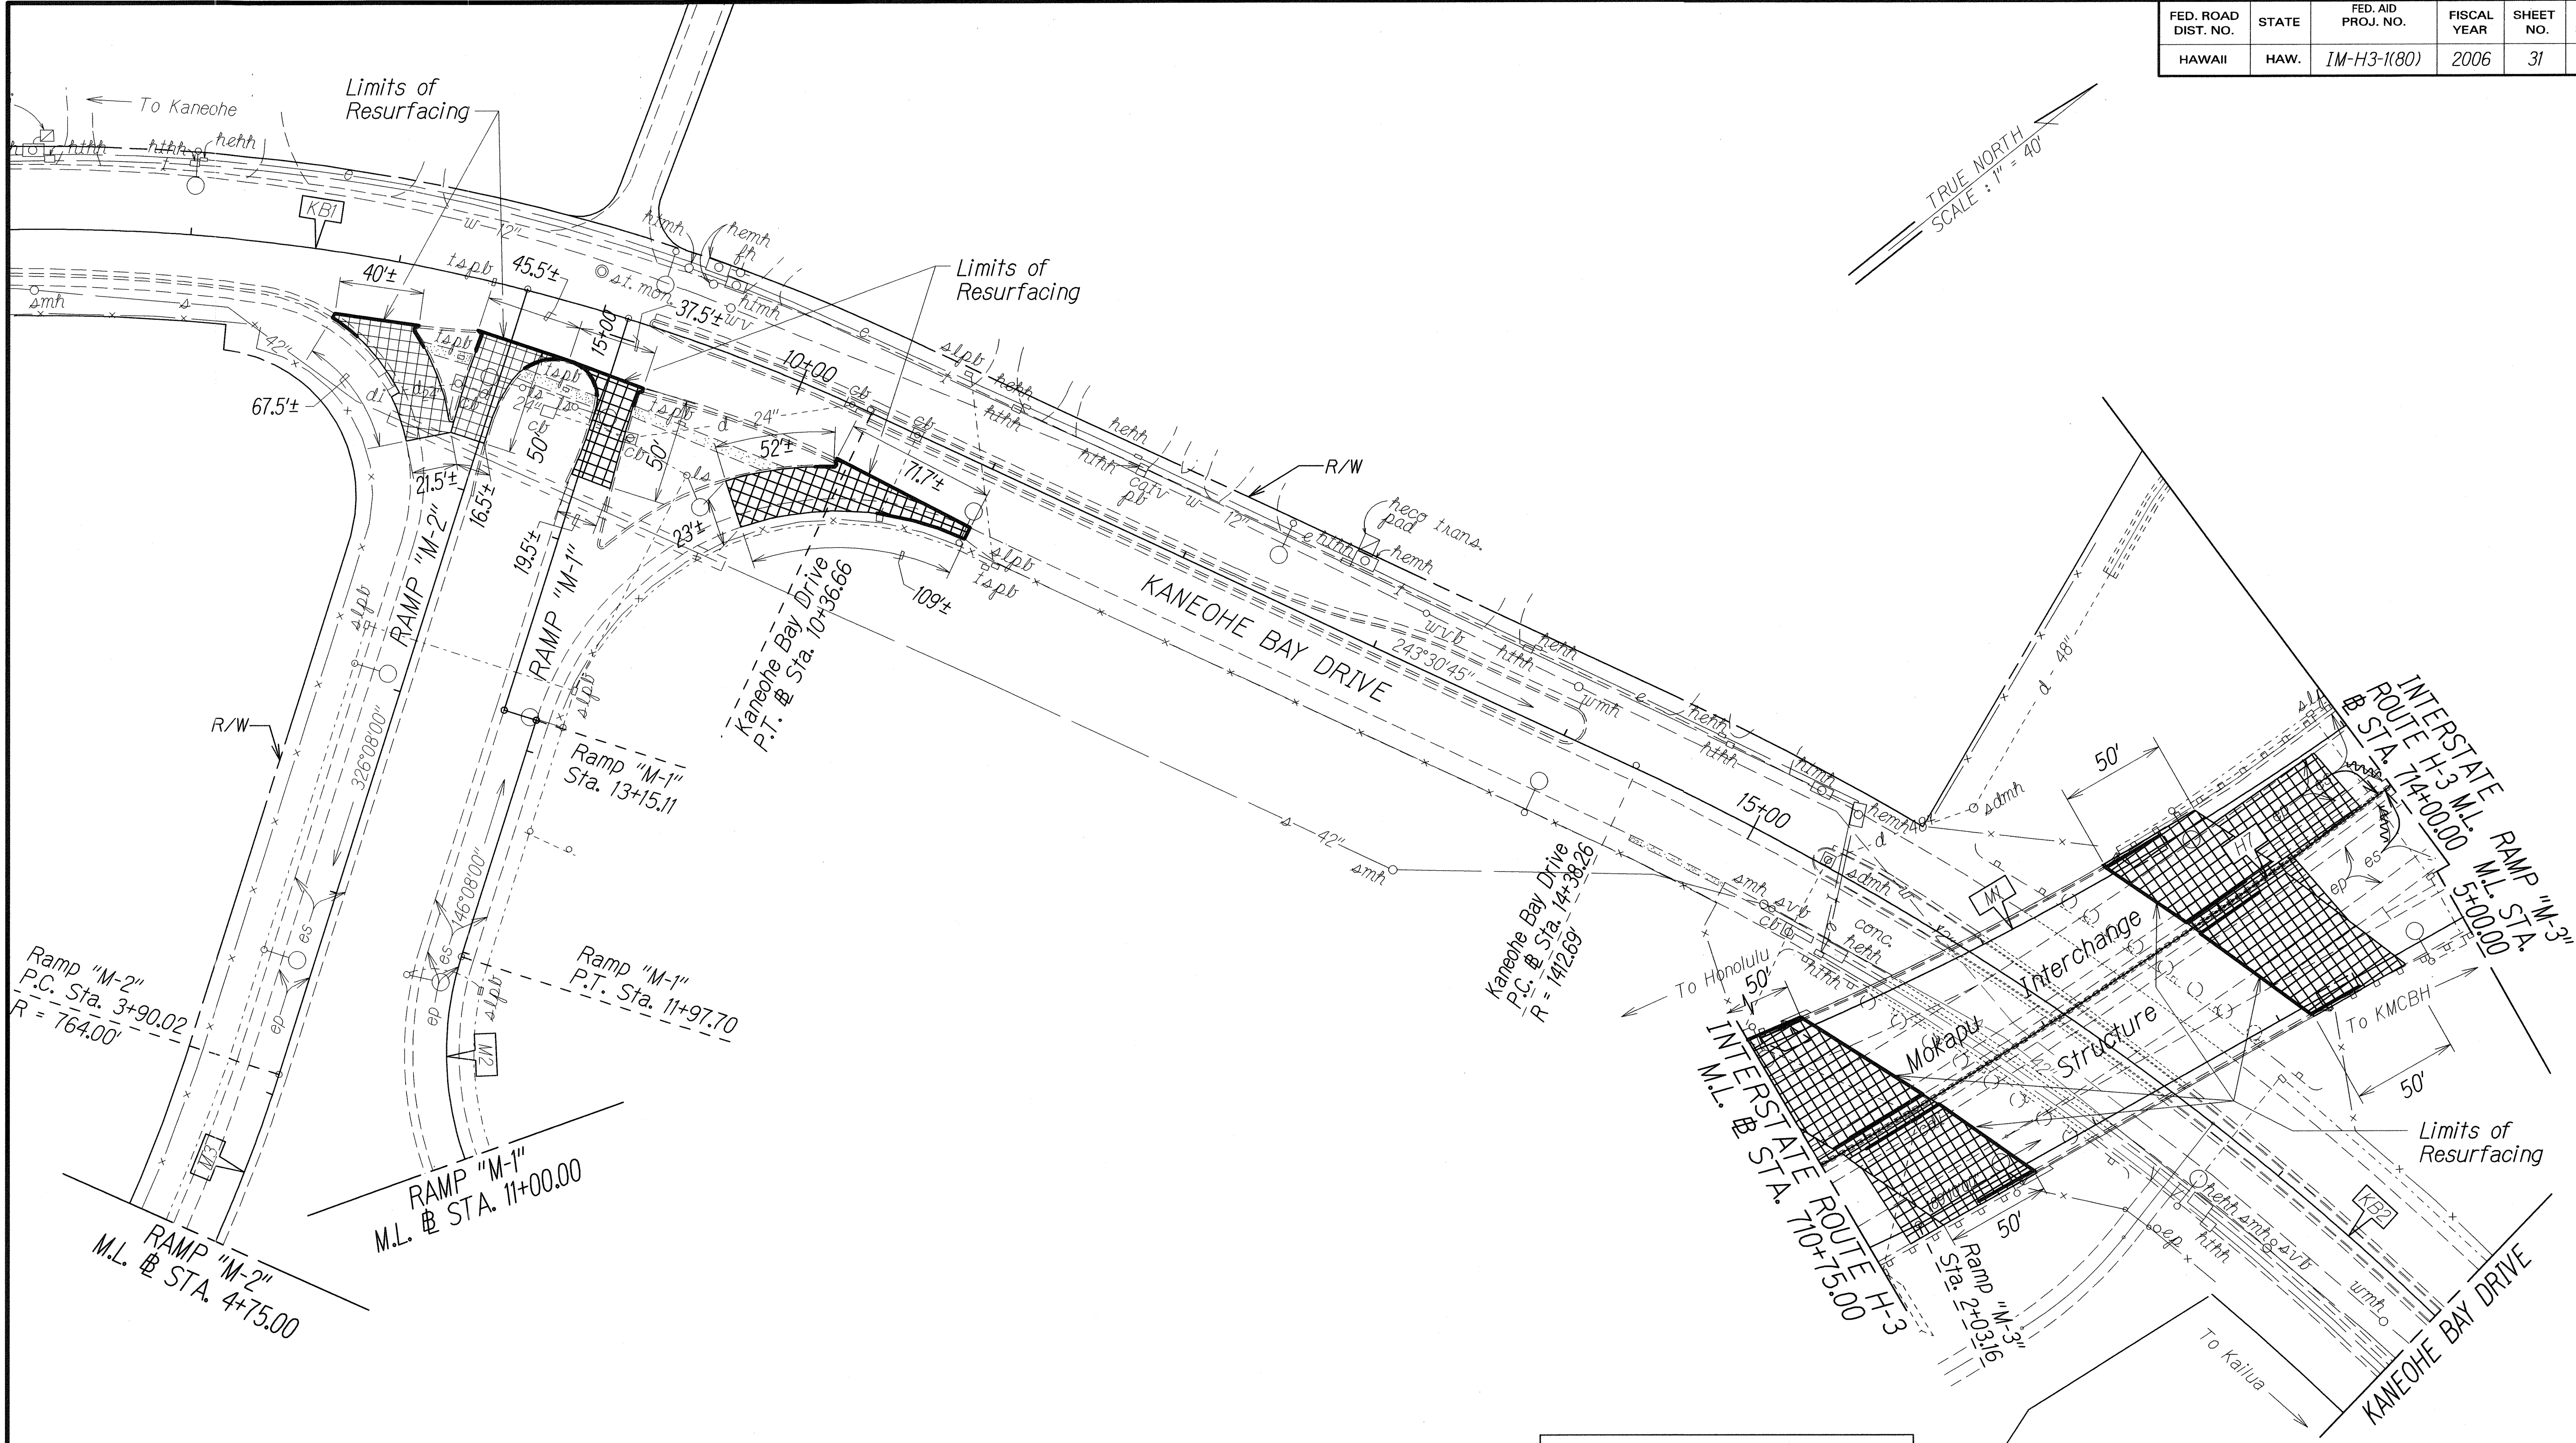

ORIGINAL PLAN	DATE
DESIGNED BY	
CHECKED BY	
DATE	

	H7	M1	M2	M3	KB1	KB2
Δ	23°21'00"	20°45'00"	125°28'00"	47°05'00"	63°30'00"	29°30'00"
R	3,000.00'	1,500.00'	150.00'	764.00'	935.37'	1,412.69'
T	619.91'	274.63'	291.03'	332.86'	578.83'	371.93'
C	1,214.16'	540.26'	266.66'	610.30'	984.41'	719.35'
Lc	1,222.60'	543.23'	328.47'	627.82'	1,036.66'	727.36'


LEGEND FOR AS-BUILT POSTINGS	
	Squiggly line for as-built deletion
	Double line for as-built deletion
Roadway	Text for as-built posting

STATE OF HAWAII
DEPARTMENT OF TRANSPORTATION
HIGHWAYS DIVISION

ROADWAY PLANS
INTERSTATE ROUTE H-3 PAVEMENT
PREVENTIVE MAINTENANCE
Halekou Interchange to
Kanoehe Marine Corps Base Hawaii
Federal-Aid Project No. IM-H3-1(80)
Scale: 1"=40' Date: June, 2005

SHEET No. 24 OF 27 SHEETS

FED. ROAD DIST. NO.	STATE	FED. AID PROJ. NO.	FISCAL YEAR	SHEET NO.	TOTAL SHEETS
HAWAII	HAW.	IM-H3-1(80)	2006	32	66

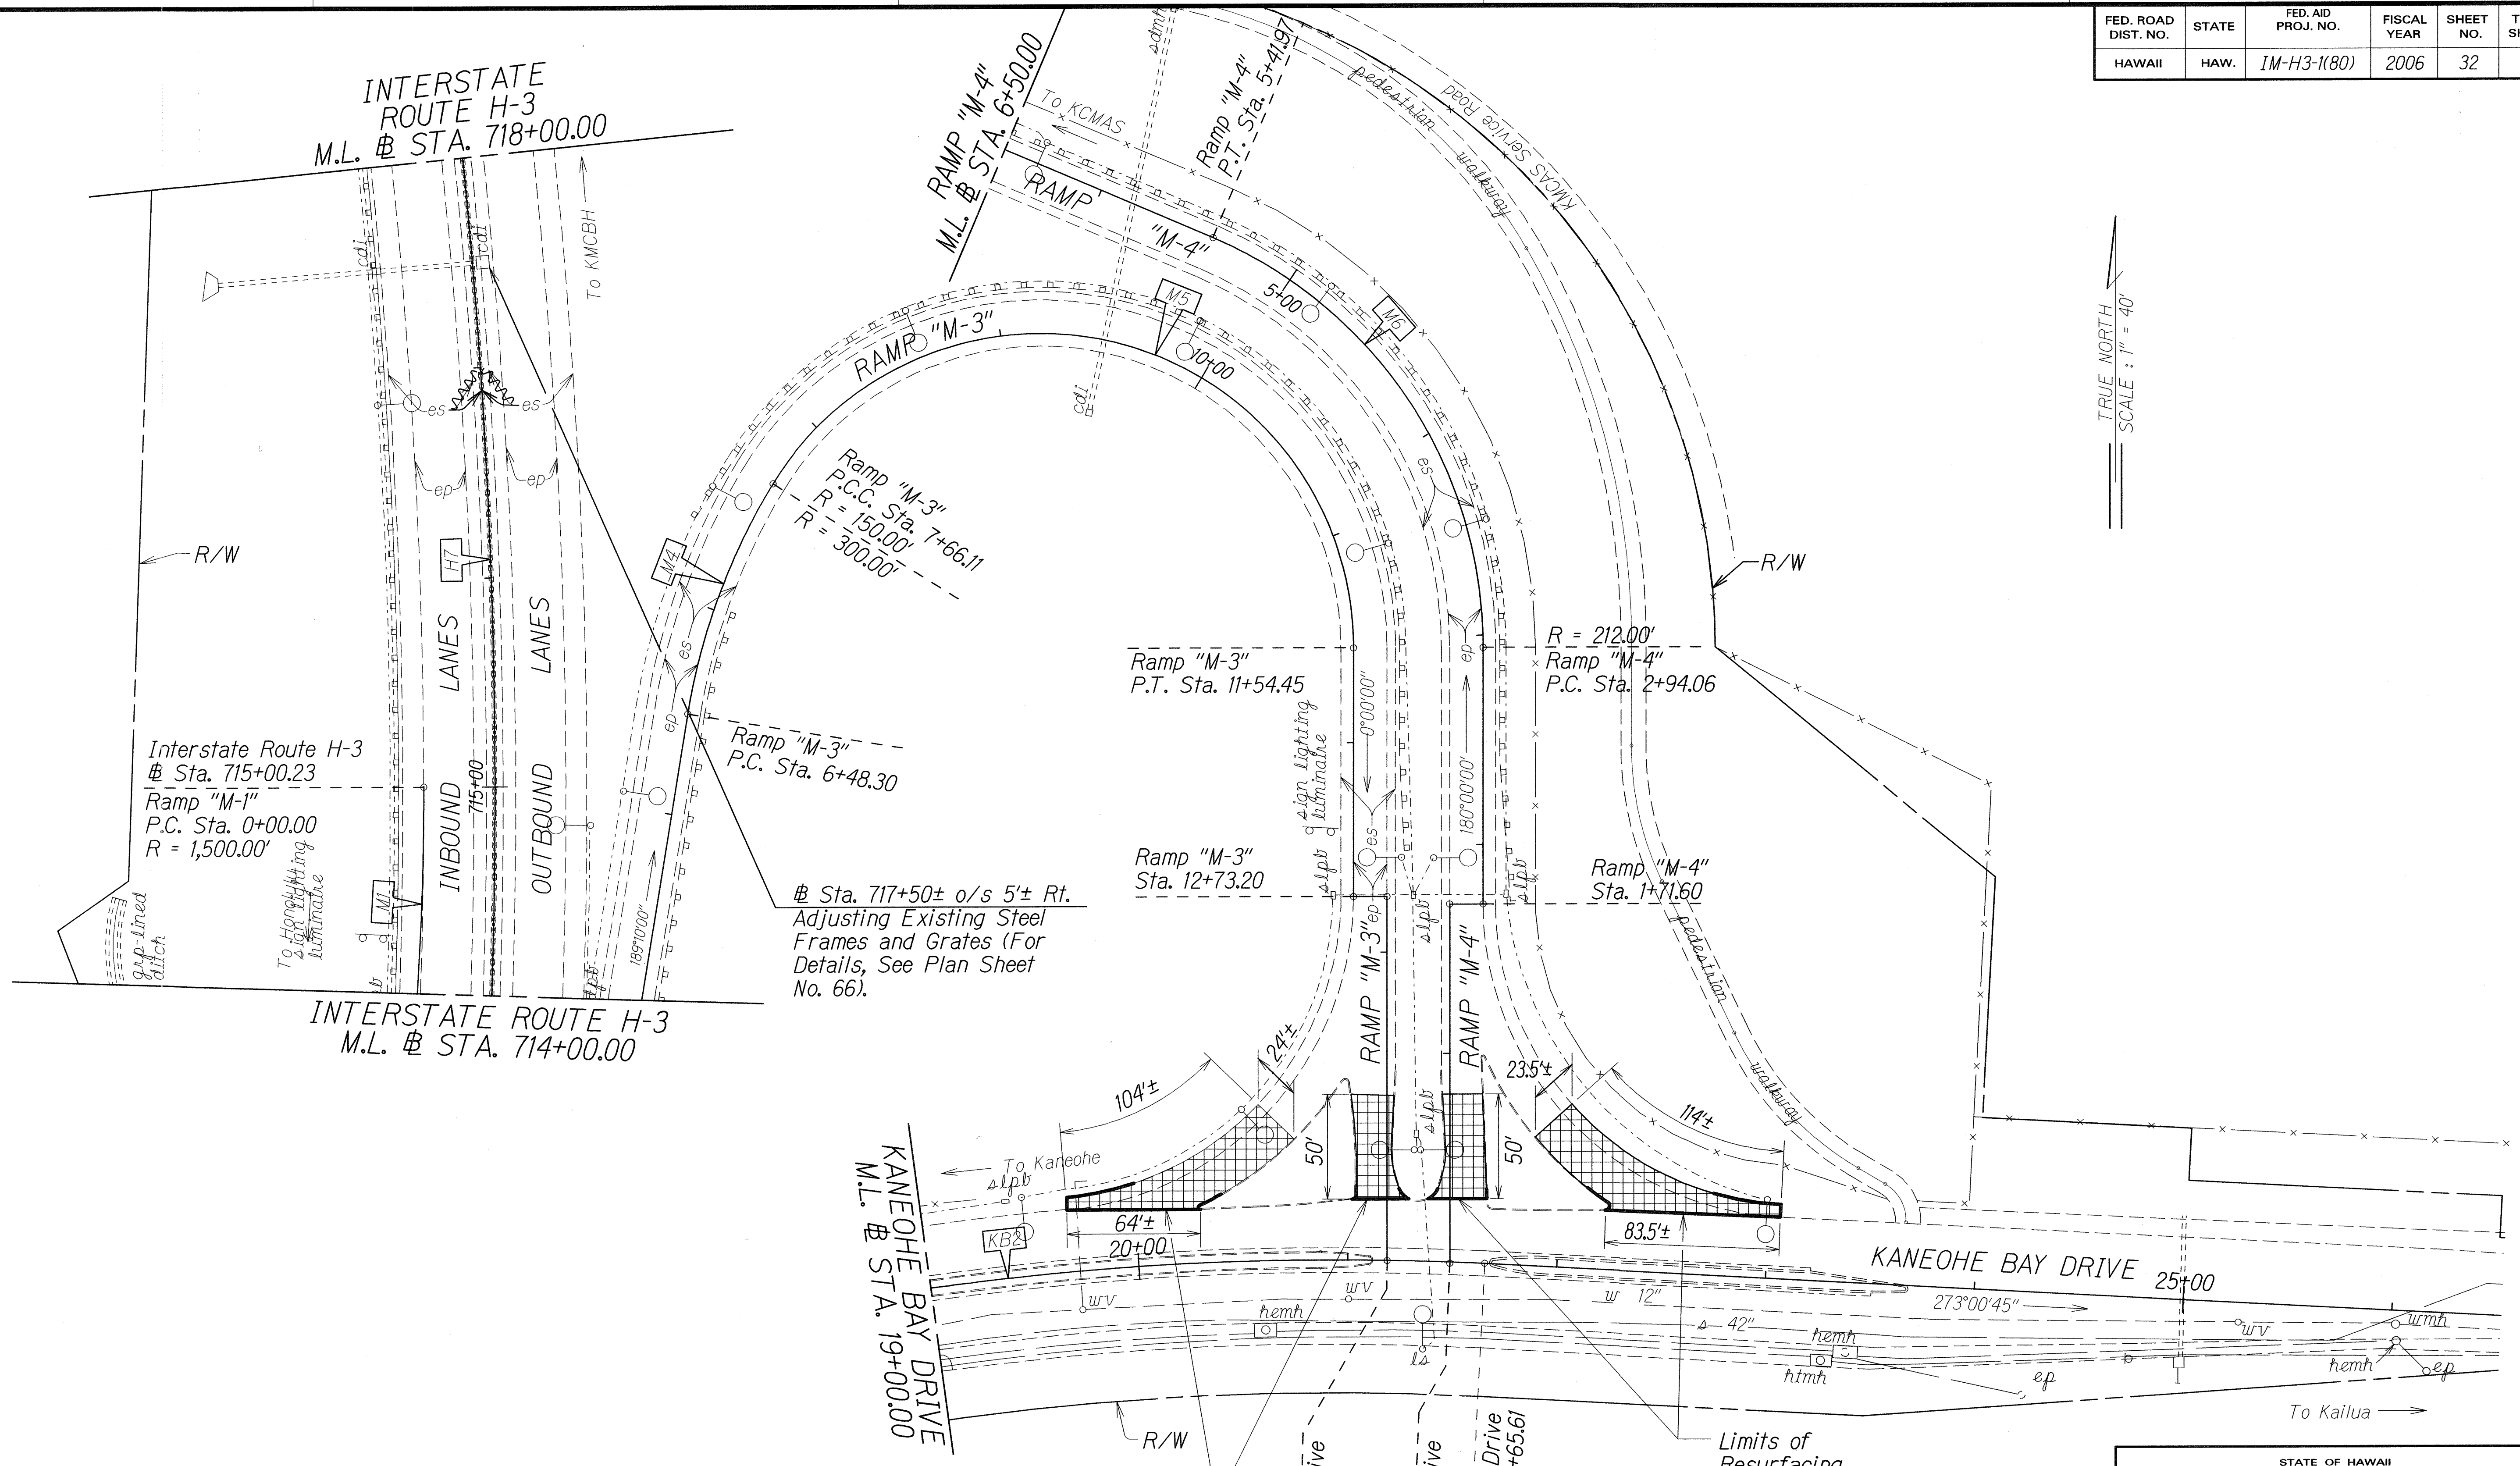

CURVE DATA

	H7	M1	M4	M5	M6	KB2
Δ	23°21'00"	20°45'00"	22°30'00"	148°20'00"	67°00'00"	29°30'00"
R	3,000.00'	1,500.00'	300.00'	150.00'	212.00'	1,412.69'
T	619.91'	274.63'	59.67'	528.91'	140.32'	371.93'
C	1,214.16'	540.26'	117.05'	288.62'	234.02'	719.35'
Lc	1,222.60'	543.23'	117.81'	388.34'	247.91'	727.36'

LEGEND FOR AS-BUILT POSTINGS

Squiggly line for as-built deletion

Double line for as-built deletion

Roadway Text for as-built posting

STATE OF HAWAII
DEPARTMENT OF TRANSPORTATION
HIGHWAYS DIVISION

ROADWAY PLANS

INTERSTATE ROUTE H-3 PAVEMENT
PREVENTIVE MAINTENANCE
Halekou Interchange to
Kaneohe Marine Corps Base Hawaii
Federal-Aid Project No. IM-H3-1(80)


Scale: 1"=40' Date: June, 2005

SHEET No. 25 OF 27 SHEETS

"AS-BUILT"

CURVE DATA		
	H8	H9
Δ	67°37'00"	40°45'00"
R	750.00'	500.00'
T	502.24'	185.70'
C	834.62'	348.16'
Lc	885.10'	355.61'

FED. ROAD DIST. NO.	STATE	FED. AID PROJ. NO.	FISCAL YEAR	SHEET NO.	TOTAL SHEETS
HAWAII	HAW.	IM-H3-1(80)	2006	34	66

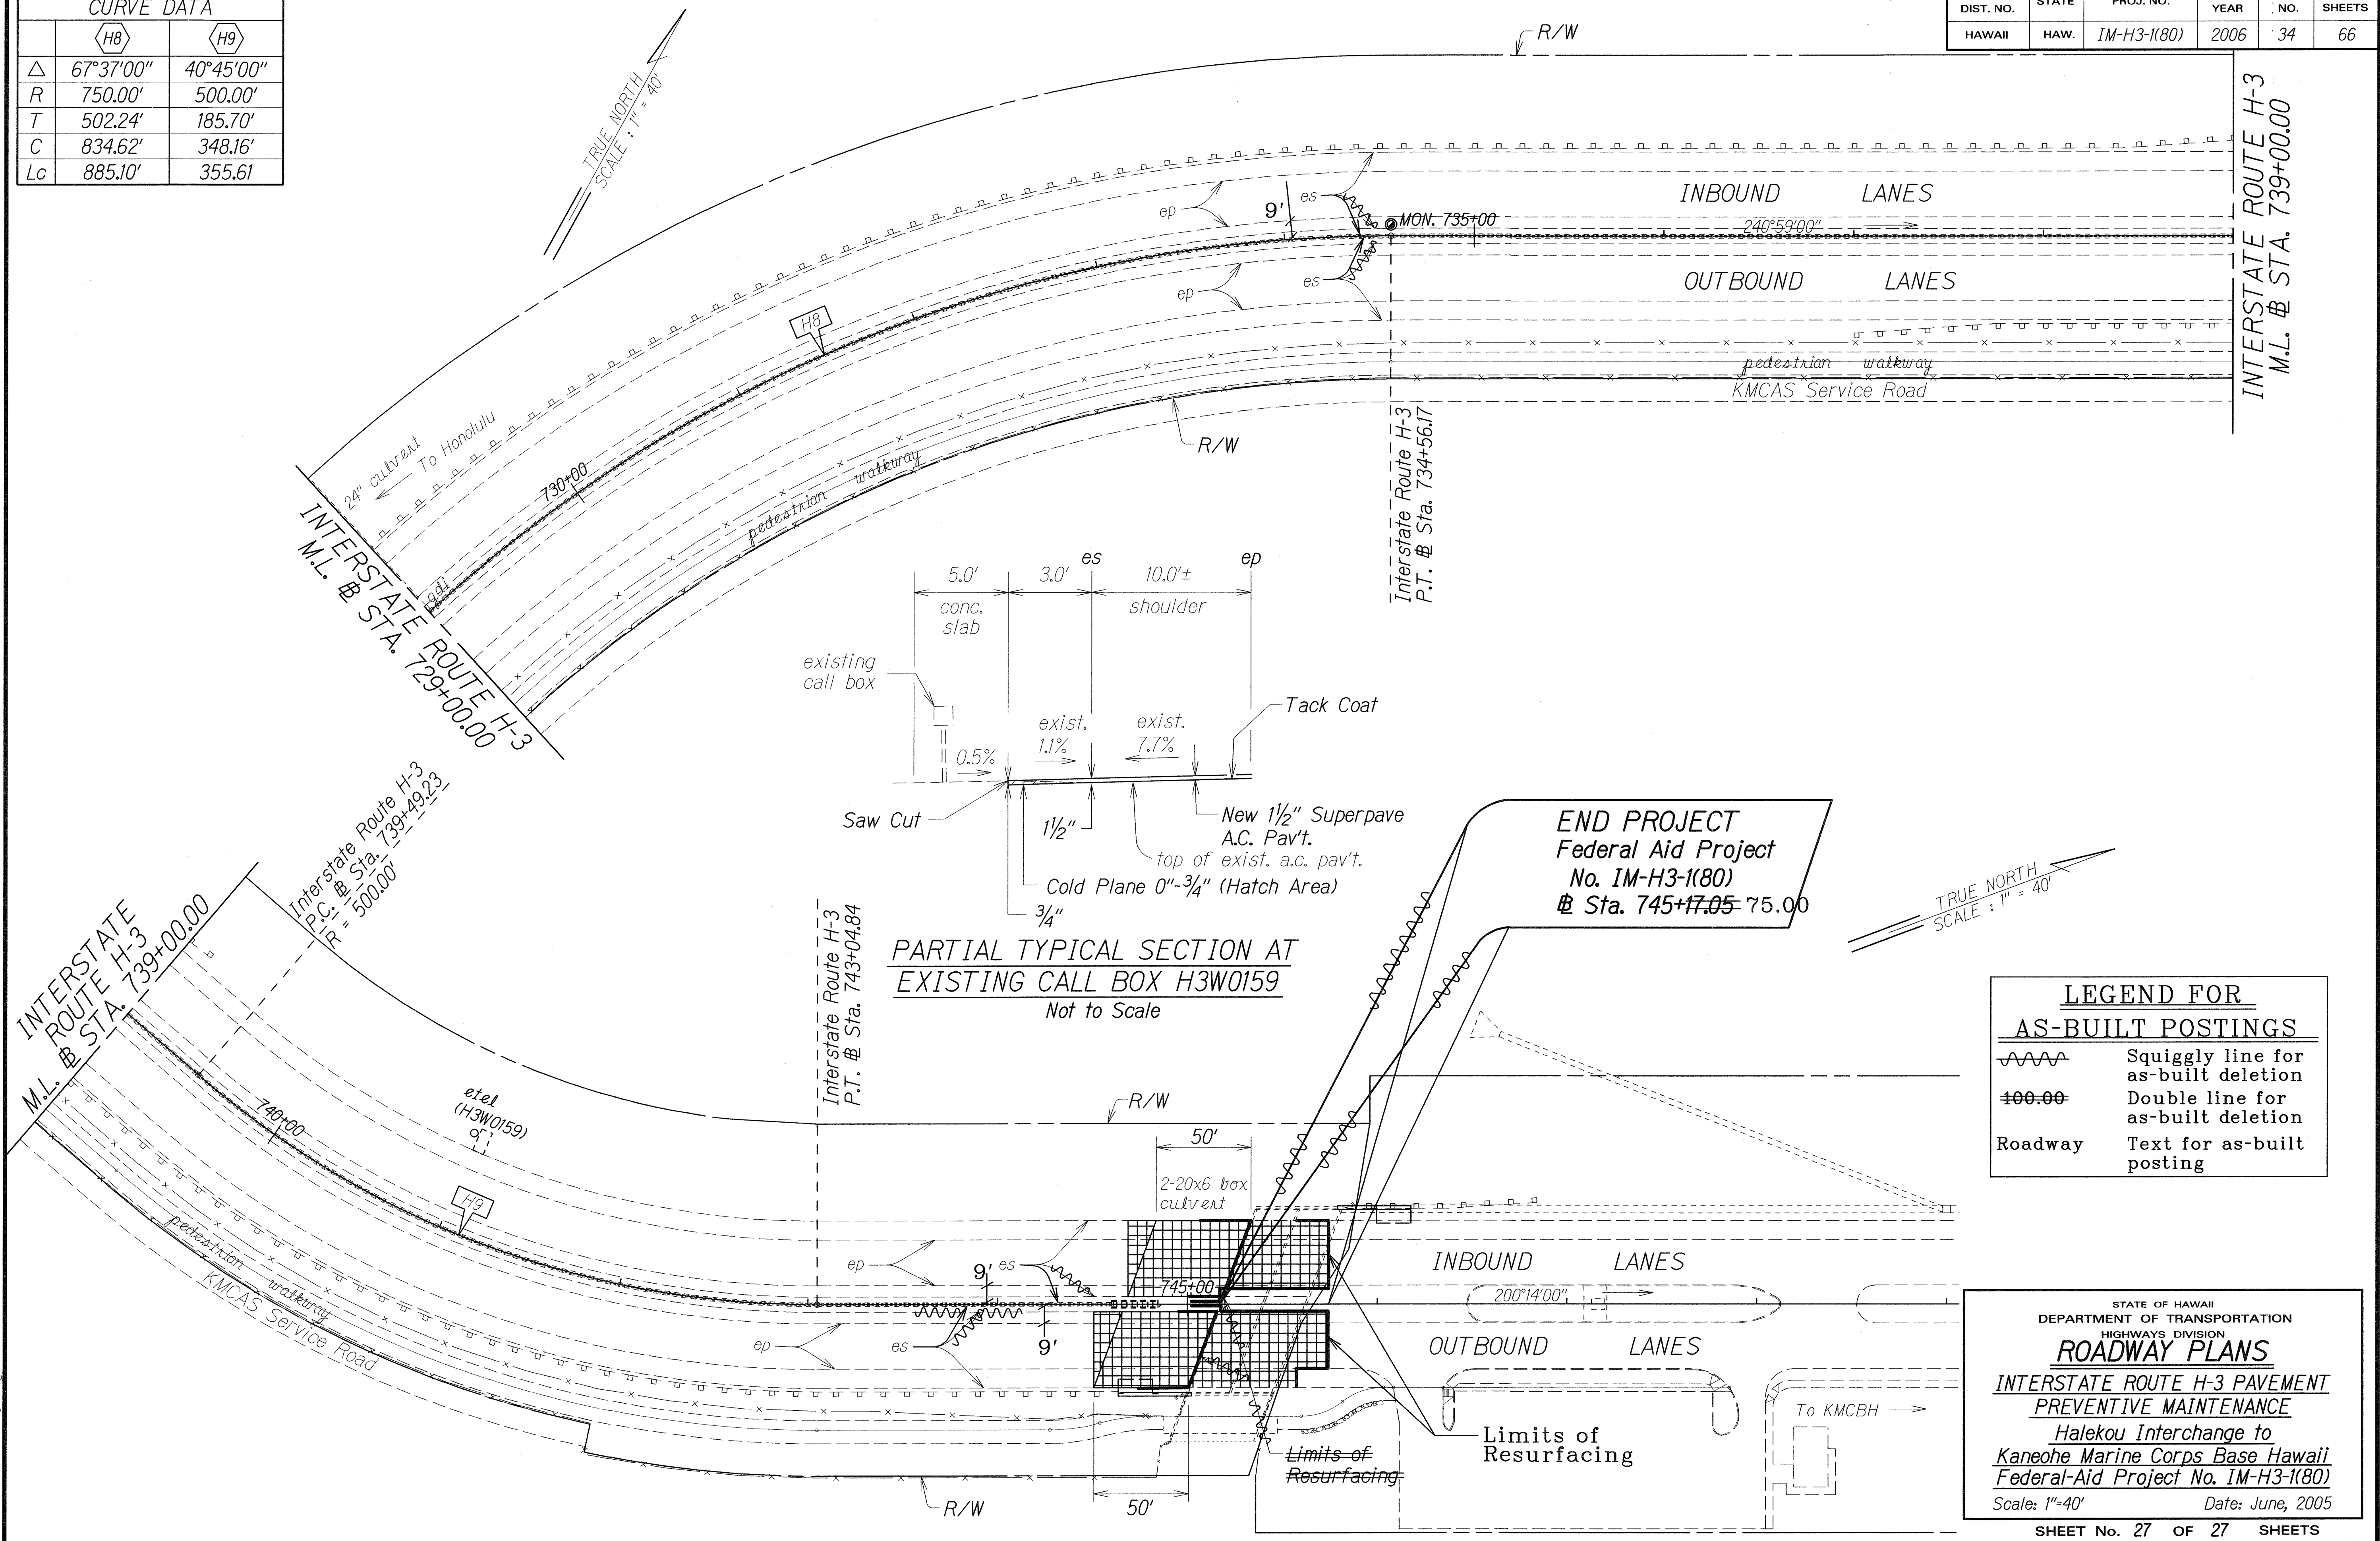

ORIGINAL PLAN	DATE
DESIGNED BY	
TRACED BY	
NOTED BY	
CHECKED BY	
QUANTITIES BY	
2/10/2007	

"AS-BUILT"