
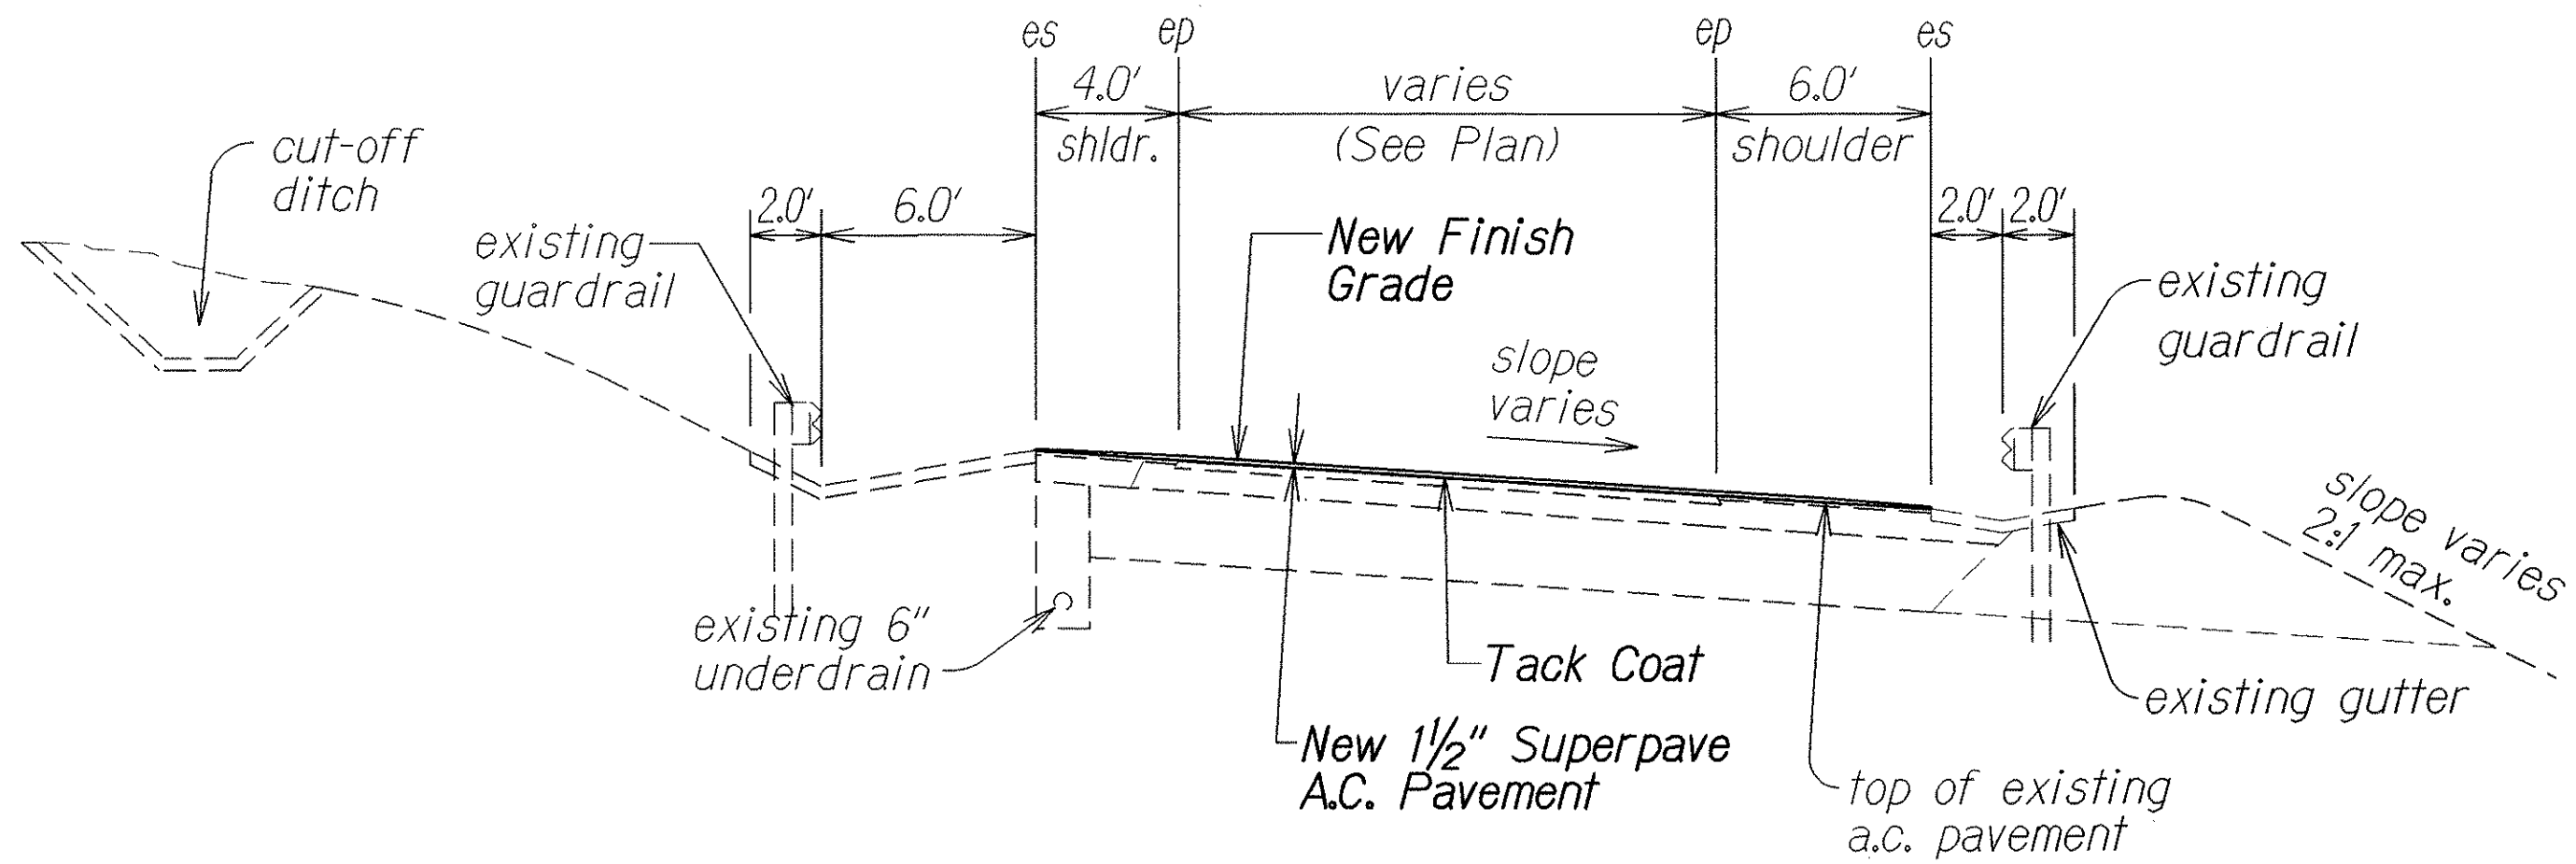
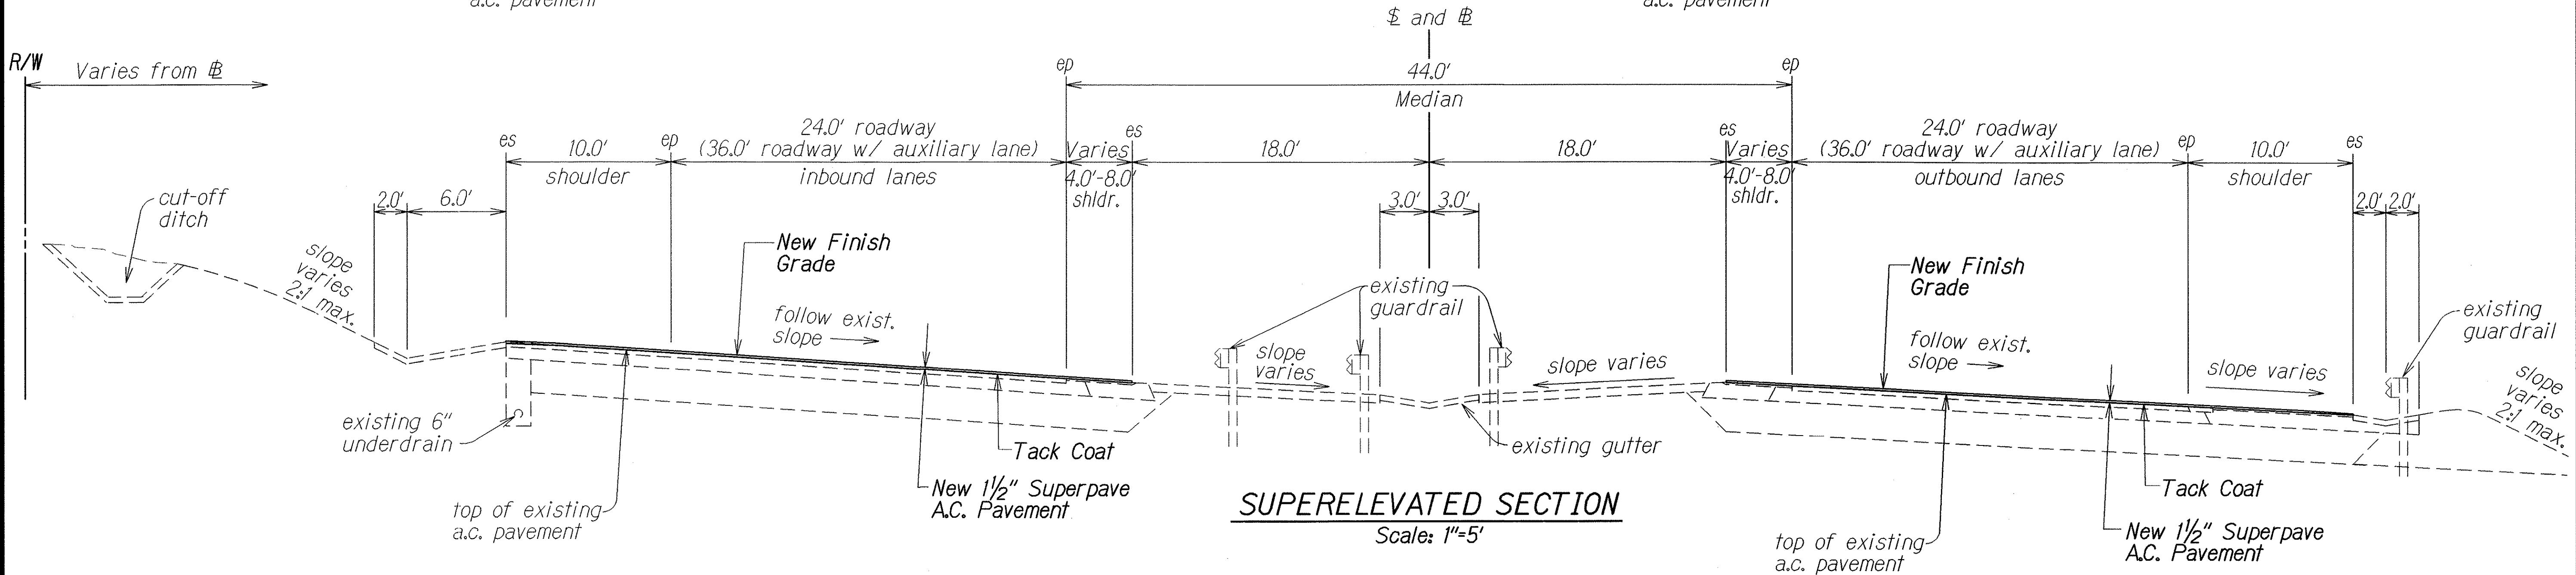



FED. ROAD DIST. NO.	STATE	FED. AID PROJ. NO.	FISCAL YEAR	SHEET NO.	TOTAL SHEETS
HAWAII	HAW.	IM-H3-1(80)	2006	ADD. 6	66

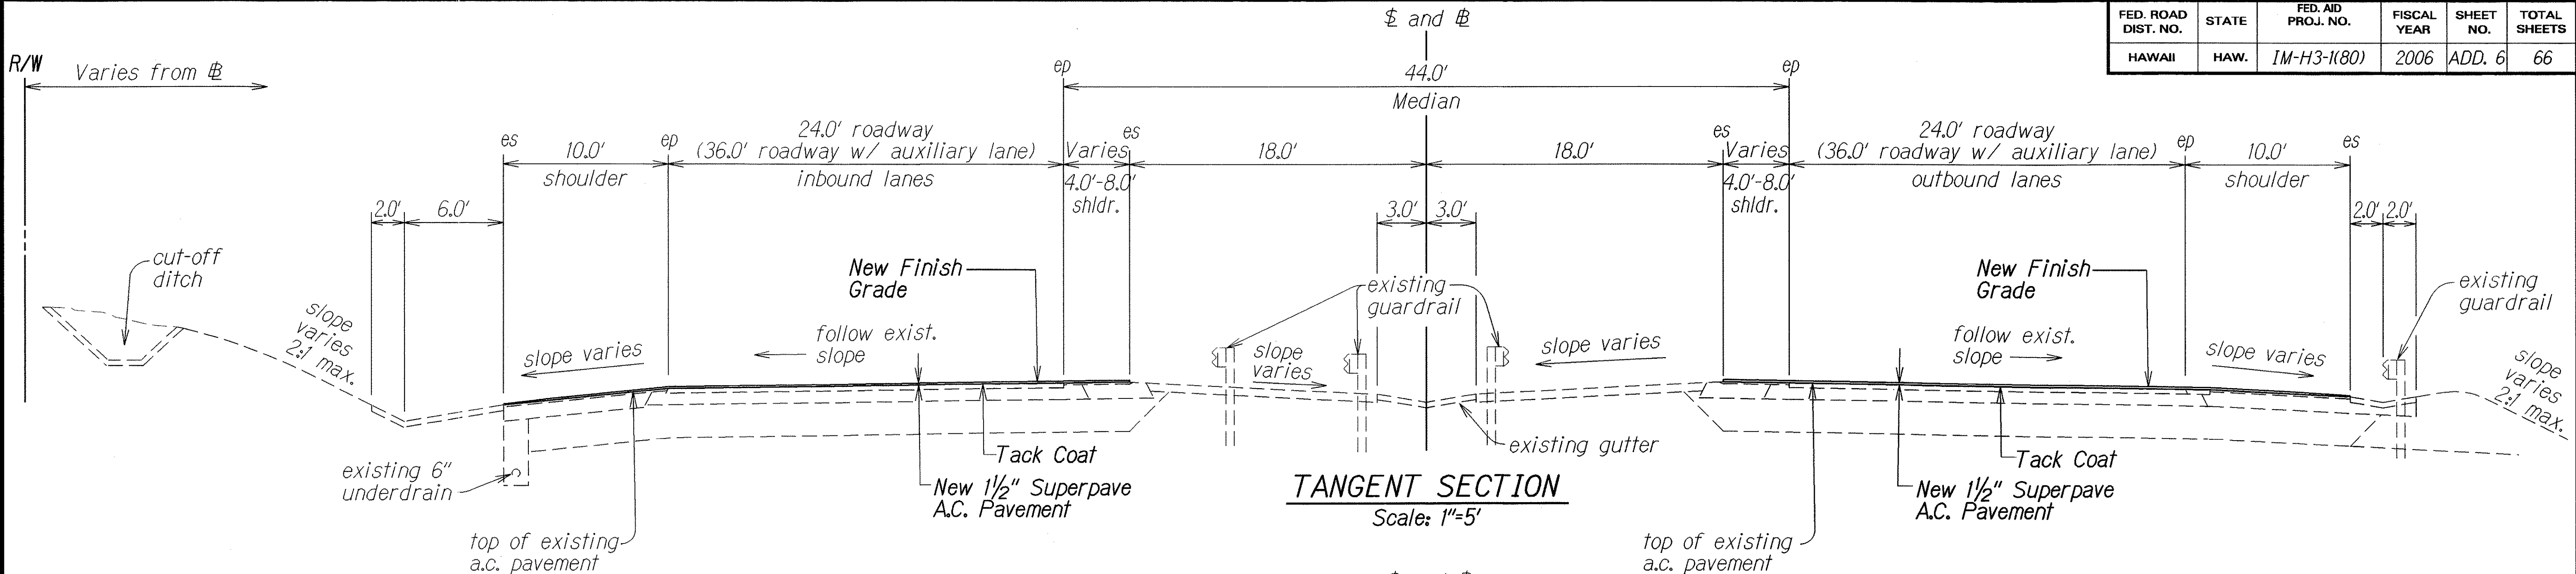

6/16/06	Revised Tangent & Superelevation Sections
DATE	REVISION
STATE OF HAWAII DEPARTMENT OF TRANSPORTATION HIGHWAYS DIVISION TYPICAL SECTIONS INTERSTATE ROUTE H-3 PAVEMENT PREVENTIVE MAINTENANCE Halekou Interchange to Kaneohe Marine Corps Base Hawaii Federal-Aid Project No. IM-H3-1(80) Scale: As Shown Date: June, 2005	
SHEET No. 1 OF 2 SHEETS	


SURVEY PLOTTED BY	DATE
DESIGNED BY	
TRACED BY	
NOTED BY	
CHECKED BY	
ORIGINAL PLAN	
NOTE BOOK	
2/13/05	

FED. ROAD DIST. NO.	STATE	FED. AID PROJ. NO.	FISCAL YEAR	SHEET NO.	TOTAL SHEETS
HAWAII	HAW.	IM-H3-1(80)	2006	ADD. 7	66

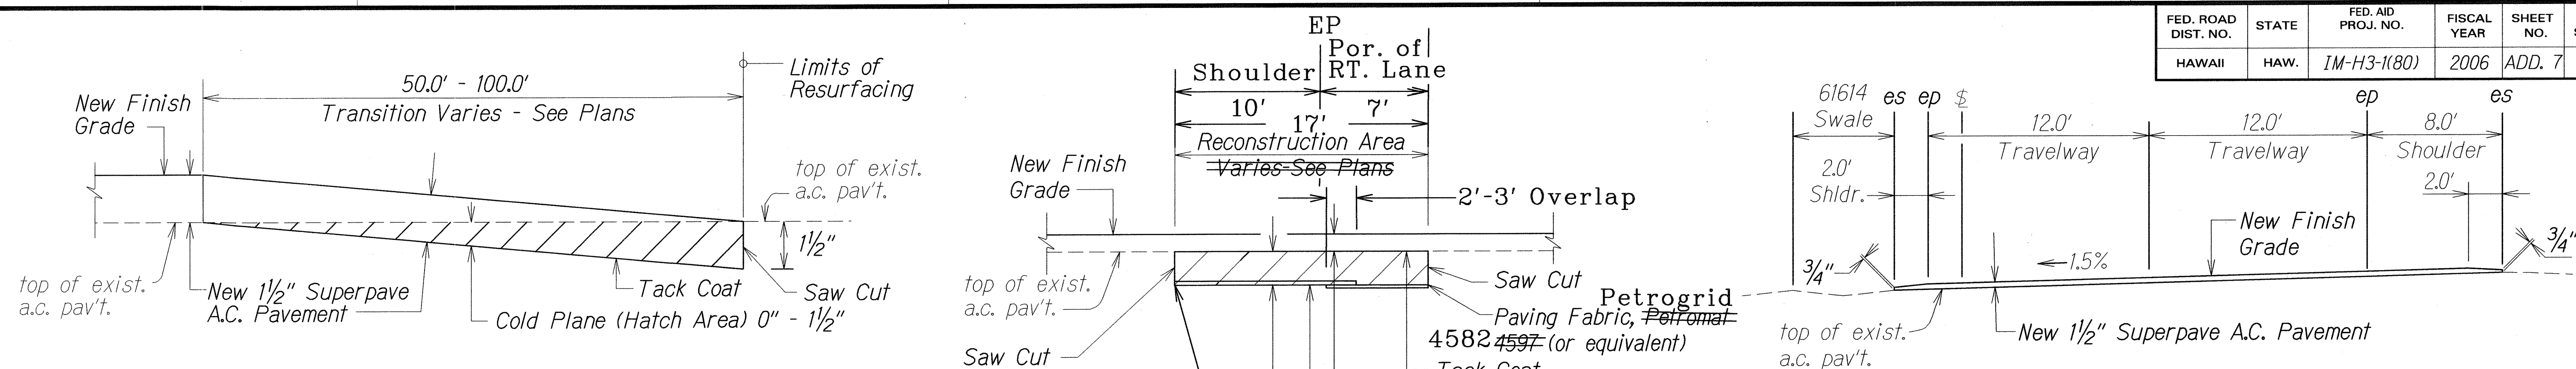


**COLD PLANED TRANSITION TO EXISTING A.C. PAVEMENT
BEGINNING AND END OF PROJECT
AND RAMP RESURFACING LIMITS**


Not to Scale

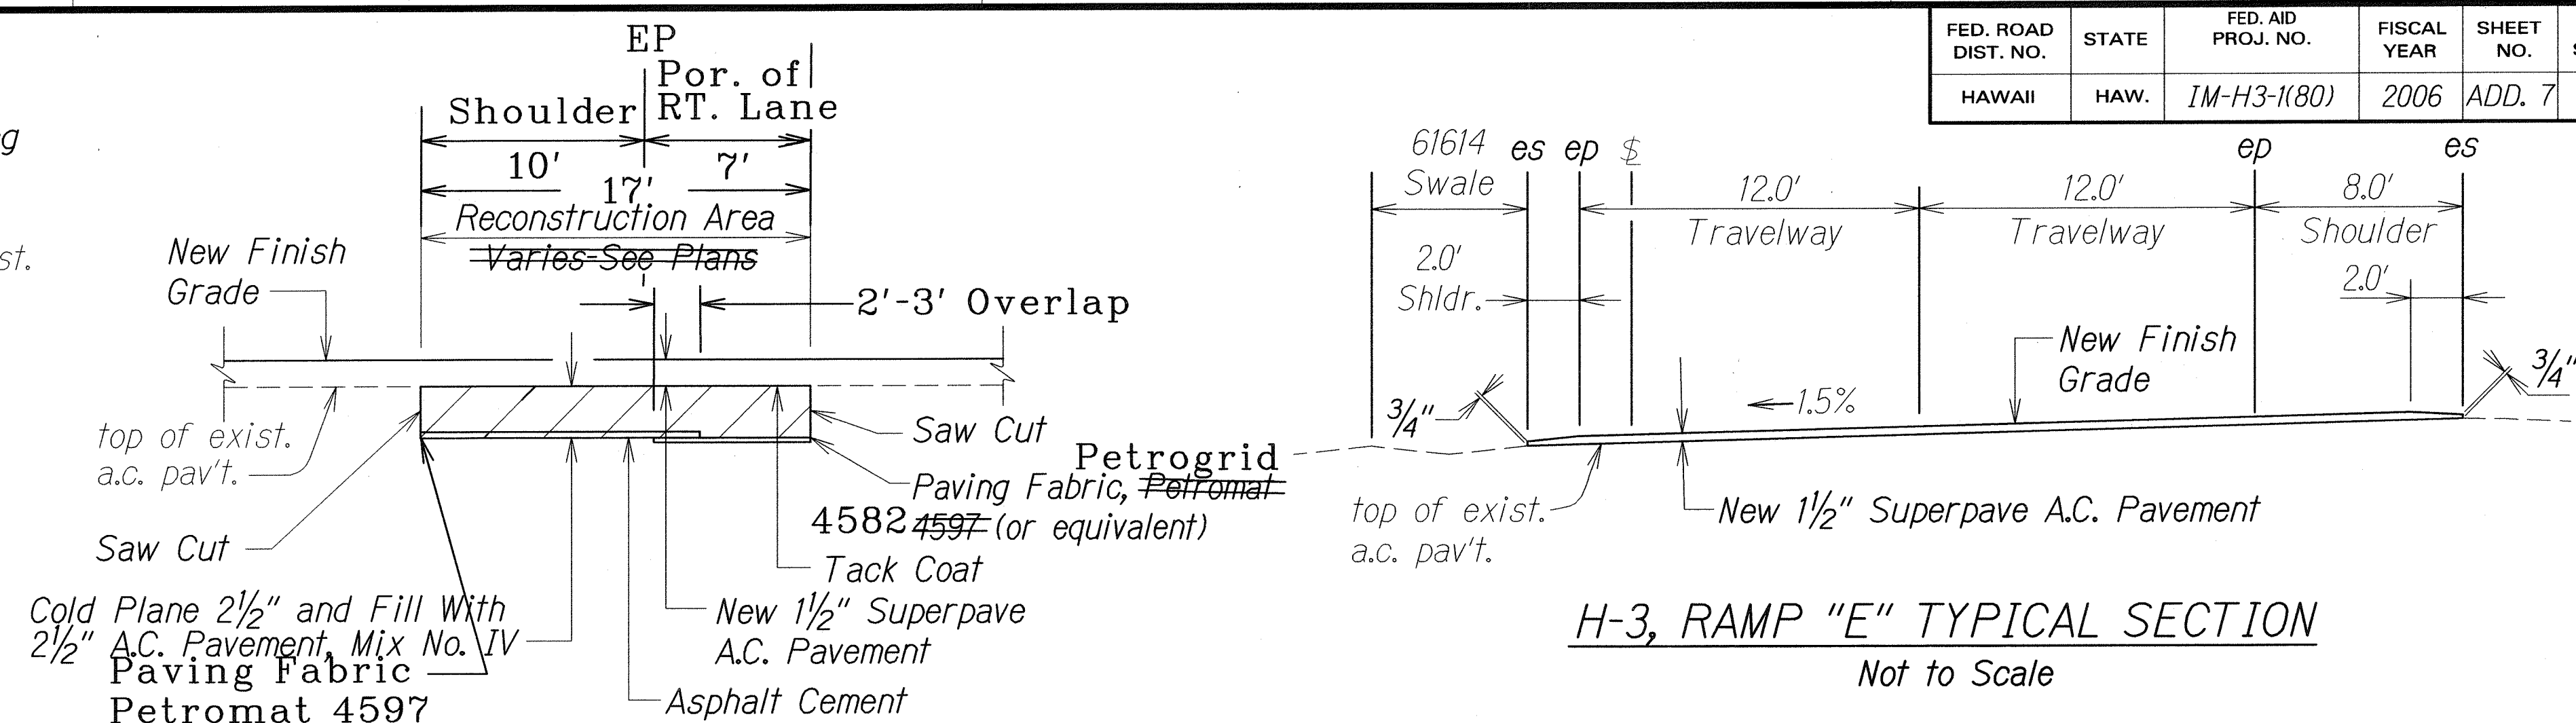


A.C. PAVEMENT RECONSTRUCTION DETAIL B
~~# STA. 541+20.00~~ LT. TO ~~# STA. 544+90.00~~ LT. 553+60.00
 542+15.00 Not to Scale

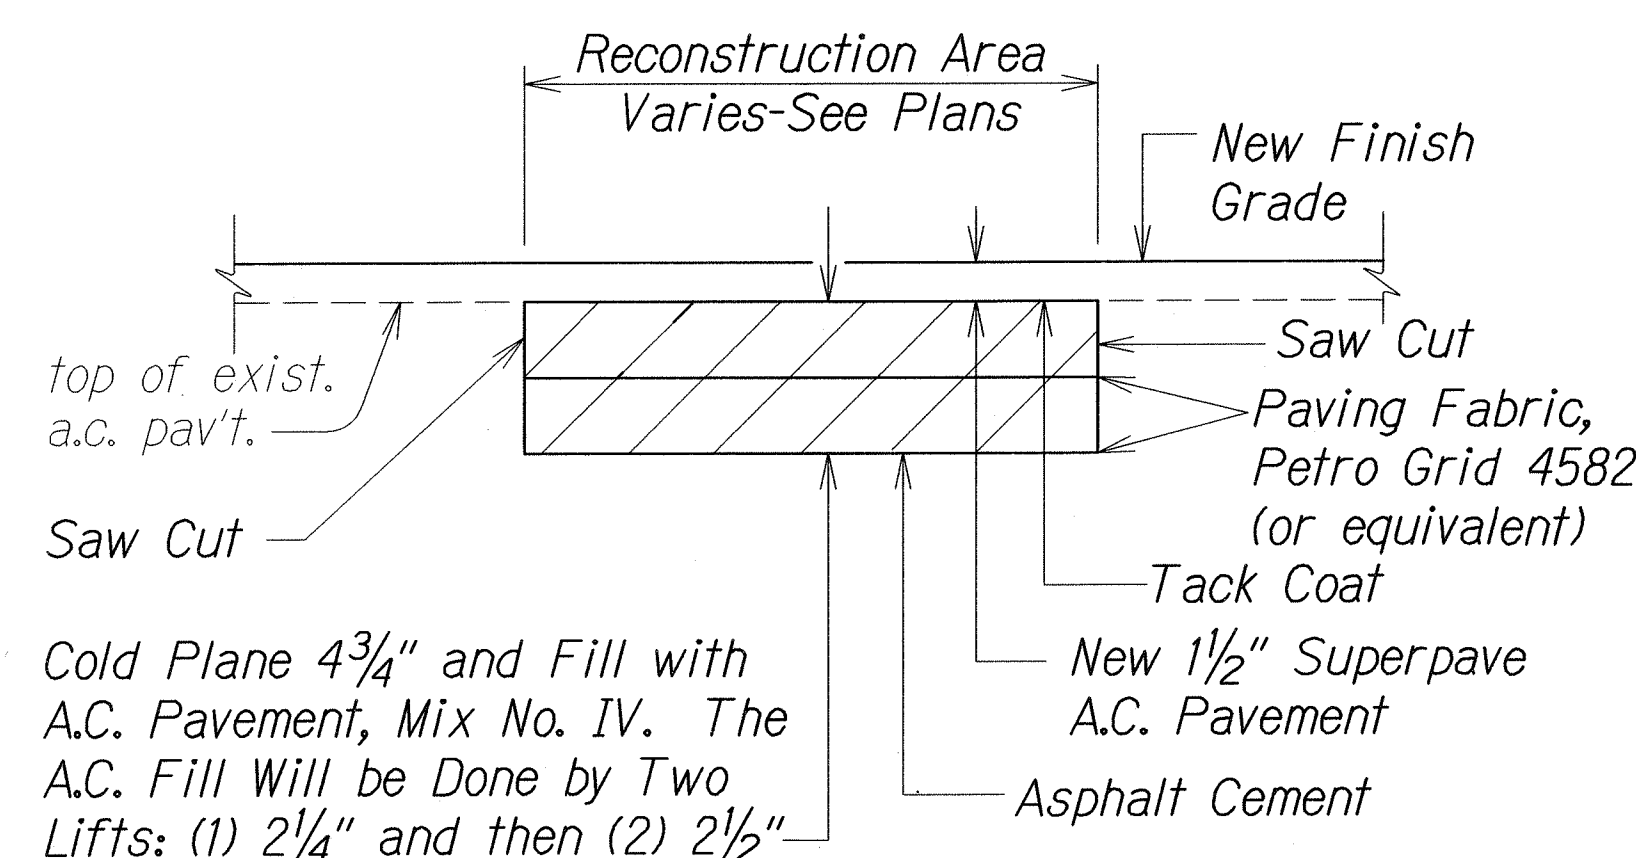

A.C. PAVEMENT RECONSTRUCTION DETAIL A
~~# STA. 620+50 RT. TO # STA. 627+20 RT.~~
 Not to Scale 626+96

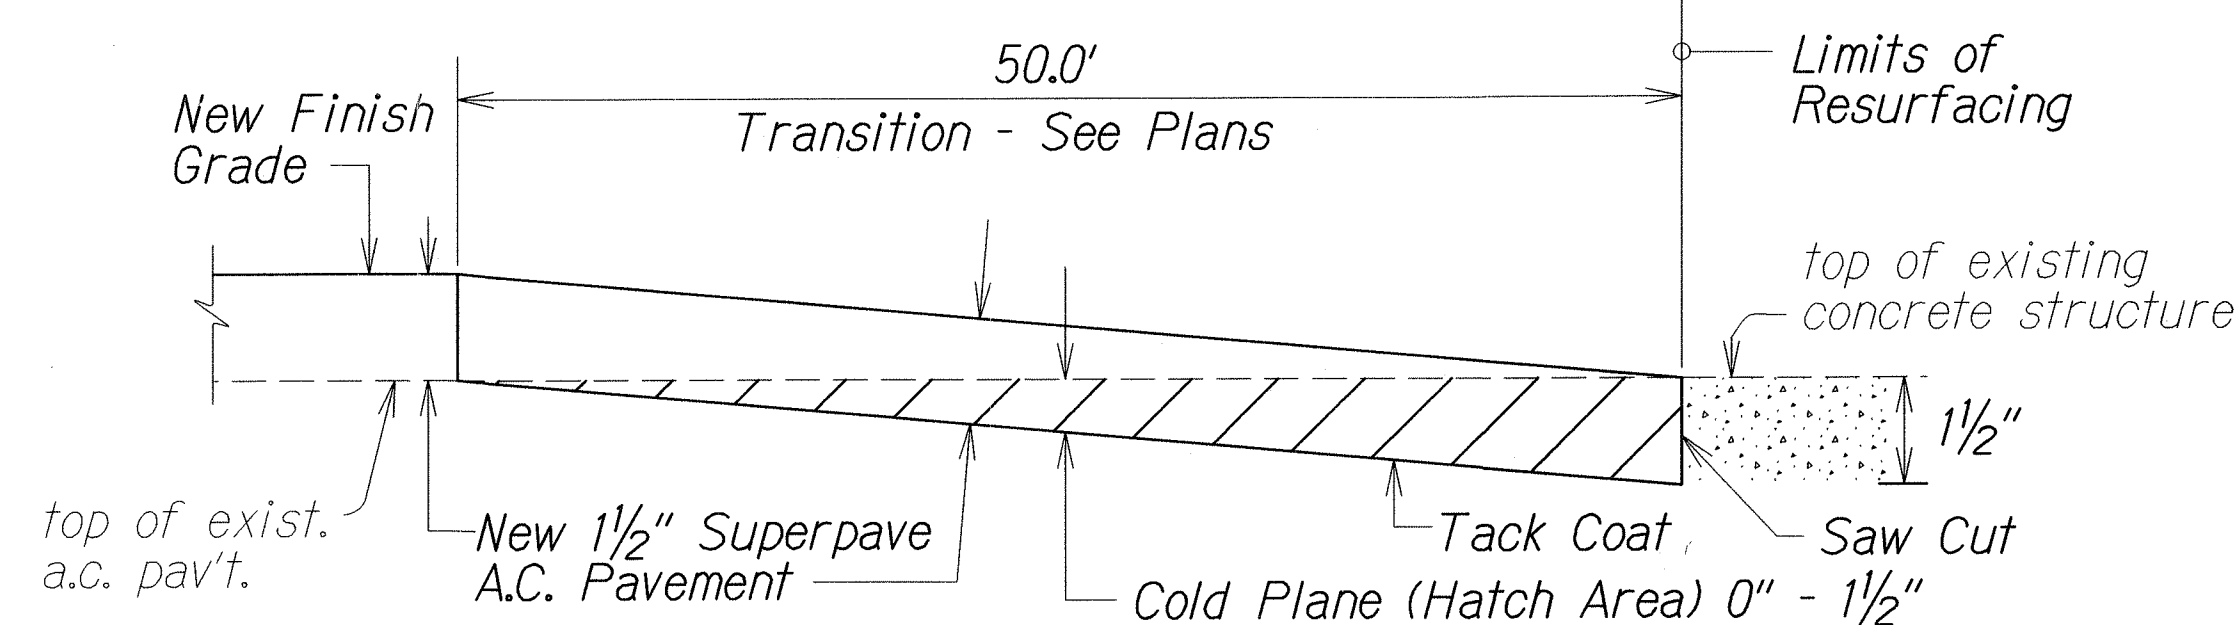


COLD PLANED AT STRUCTURE
Not to Scale

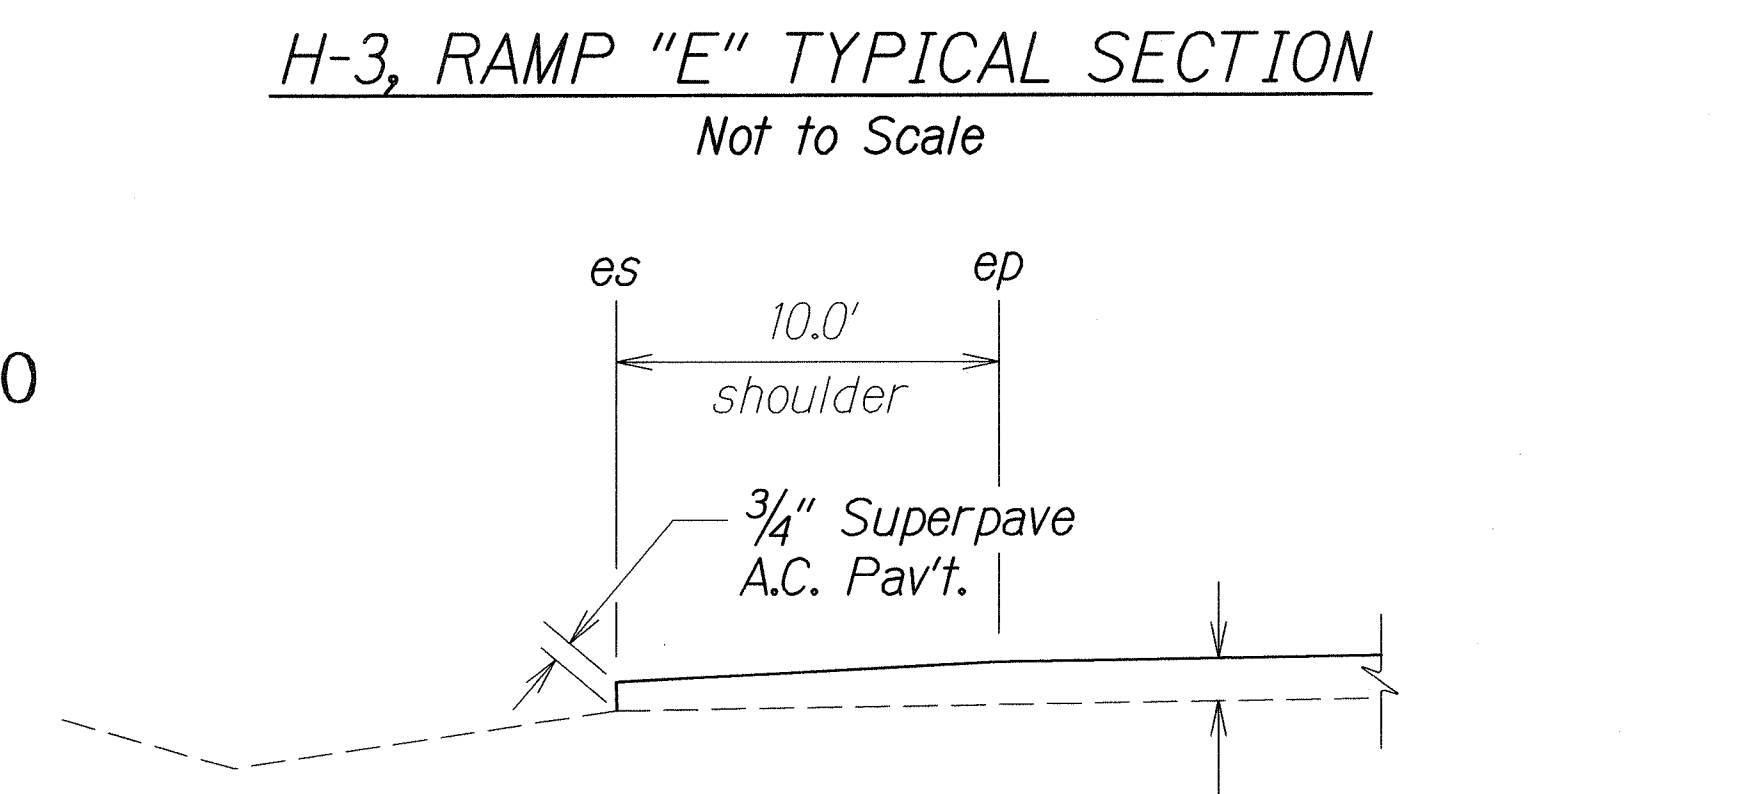

H-3, RAMP "E" TYPICAL SECTION
Not to Scale

**PARTIAL TYPICAL SECTION
AT CONCRETE SWALE**
Not to Scale

LEGEND FOR AS-BUILT POSTINGS	
	Squiggly line for as-built deletion
	Double line for as-built deletion
Roadway	Text for as-built posting

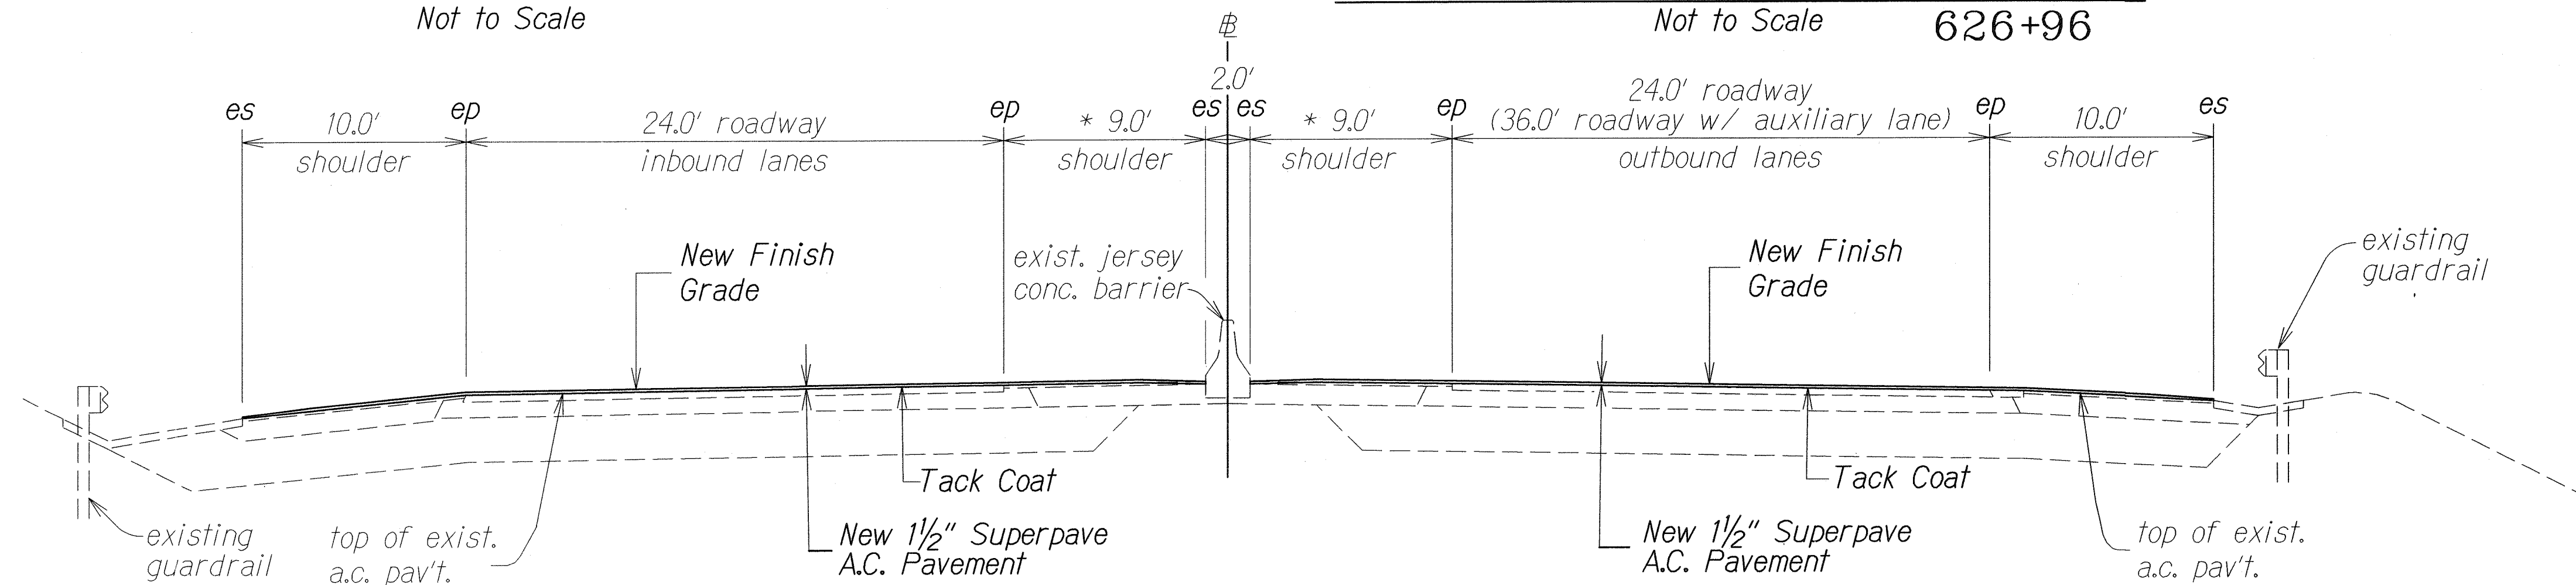

TYPICAL SECTION WITH JERSEY BARRIER
~~# STA. 652+60.00 TO # STA. 744+82.00~~
 Not to Scale

* Note:
Exist. shoulder width varies, 19'± to 4.0'± from Begin of Project to # Sta. 498+30±, Lt. # Rt. (Refer to Roadway Plans)

6/16/06	Added Note.
DATE	REVISION
STATE OF HAWAII DEPARTMENT OF TRANSPORTATION HIGHWAYS DIVISION TYPICAL SECTIONS & DETAILS INTERSTATE ROUTE H-3 PAVEMENT PREVENTIVE MAINTENANCE Halekou Interchange to Kaneohe Marine Corps Base Hawaii Federal-Aid Project No. IM-H3-1(80) Scale: As Shown Date: June, 2005	
SHEET No. 2 OF 2 SHEETS	

DATE	_____
DESIGNED BY	_____
TRACED BY	_____
QUANTITIES BY	_____
CHECKED BY	_____
ORIGINAL PLAN	_____
NOTE BOOK	_____
FILED	_____

asbuilt2008.41h3dts2.dgn

"AS-BUILT"

ADD. 7