


FED. ROAD DIST. NO.	STATE	FED. AID PROJ. NO.	FISCAL YEAR	SHEET NO.	TOTAL SHEETS
HAWAII	HAW.	HSIP-H3-1(081)	2013	19	36

TRUE NORTH
SCALE: 1" = 40'

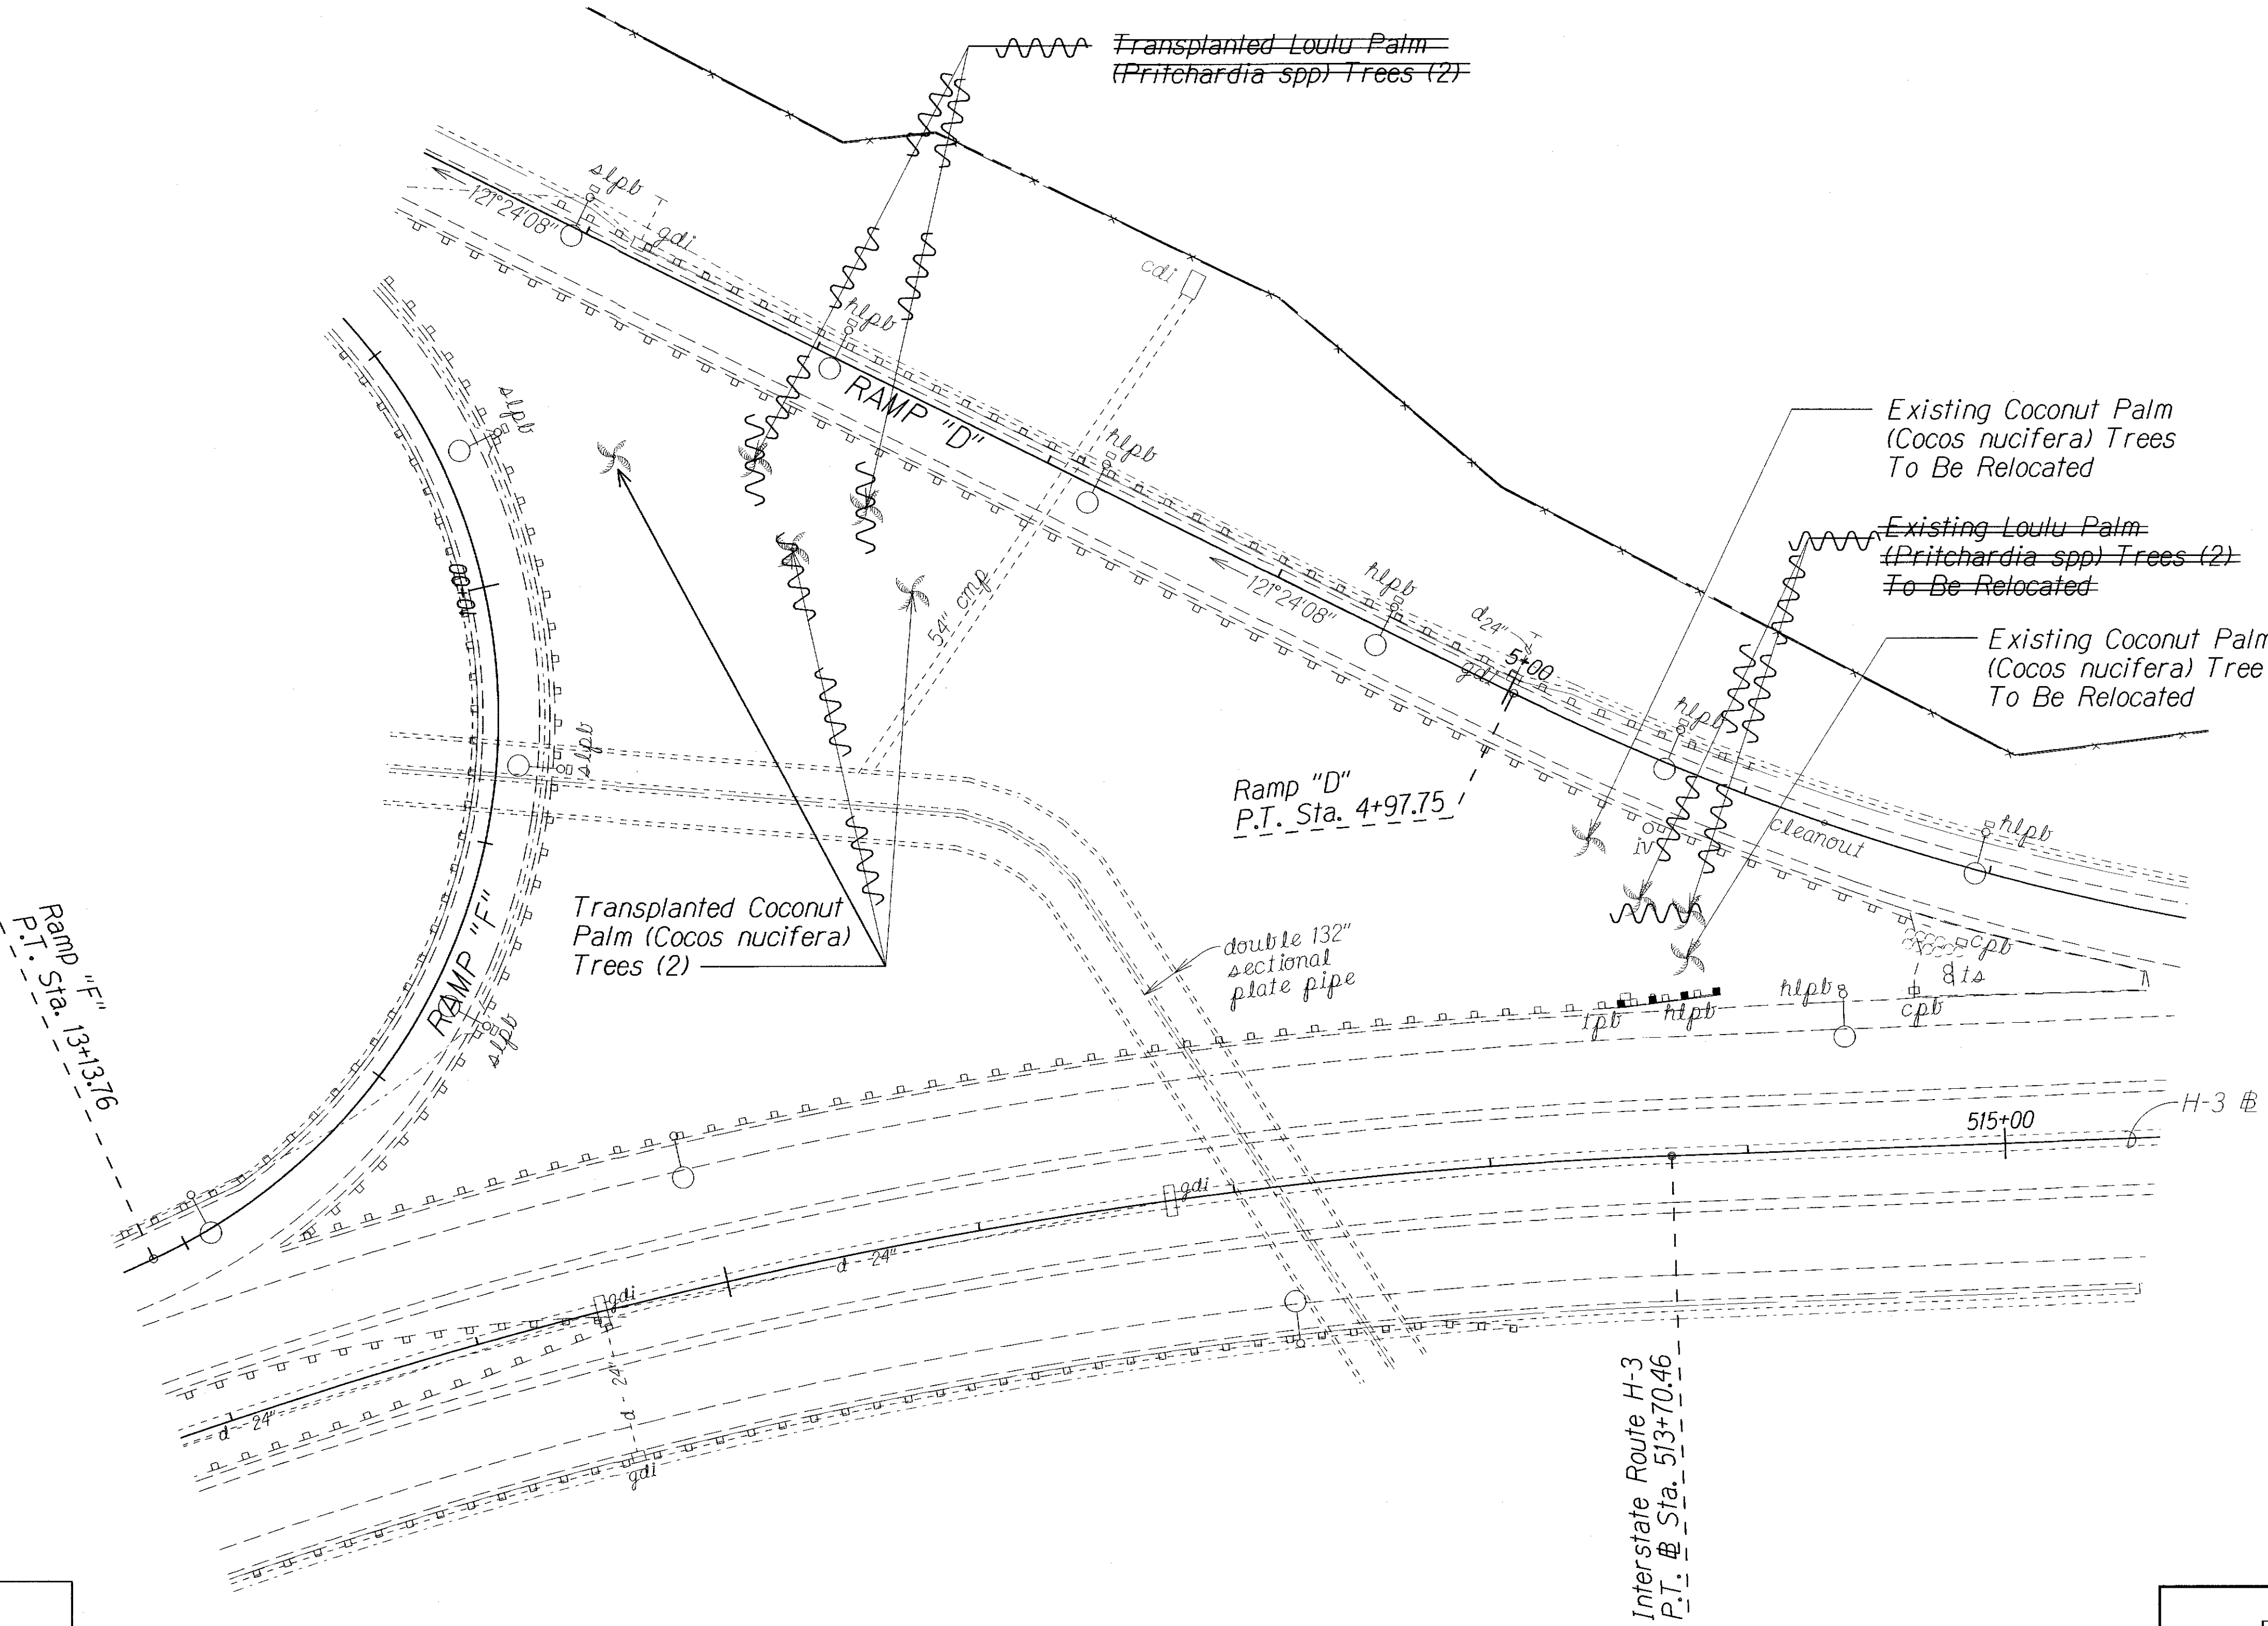

LEGEND FOR AS-BUILT POSTINGS	
	Squiggly line for as-built deletion
	Double line for as-built deletion
Roadway	Text for as-built posting

LANDSCAPING PLAN
Scale 1"=40'

STATE OF HAWAII
DEPARTMENT OF TRANSPORTATION
HIGHWAYS DIVISION

LANDSCAPING PLAN

INTERSTATE ROUTE H-3 SAFETY IMPROVEMENTS
Halekou Interchange to Kaneohe
Marine Corps Base Hawaii
Federal Aid Project No. HSIP-H3-1(081)

Scale: 1"=40' Date: Aug, 2013

SHEET No. 1 OF 1 SHEETS

ORIGINAL PLAN	SURVEY PLOTTED BY	DATE
NOTE BOOK	DRAWN BY	
	DESIGNED BY	
	CHECKED BY	

"AS-BUILT"