

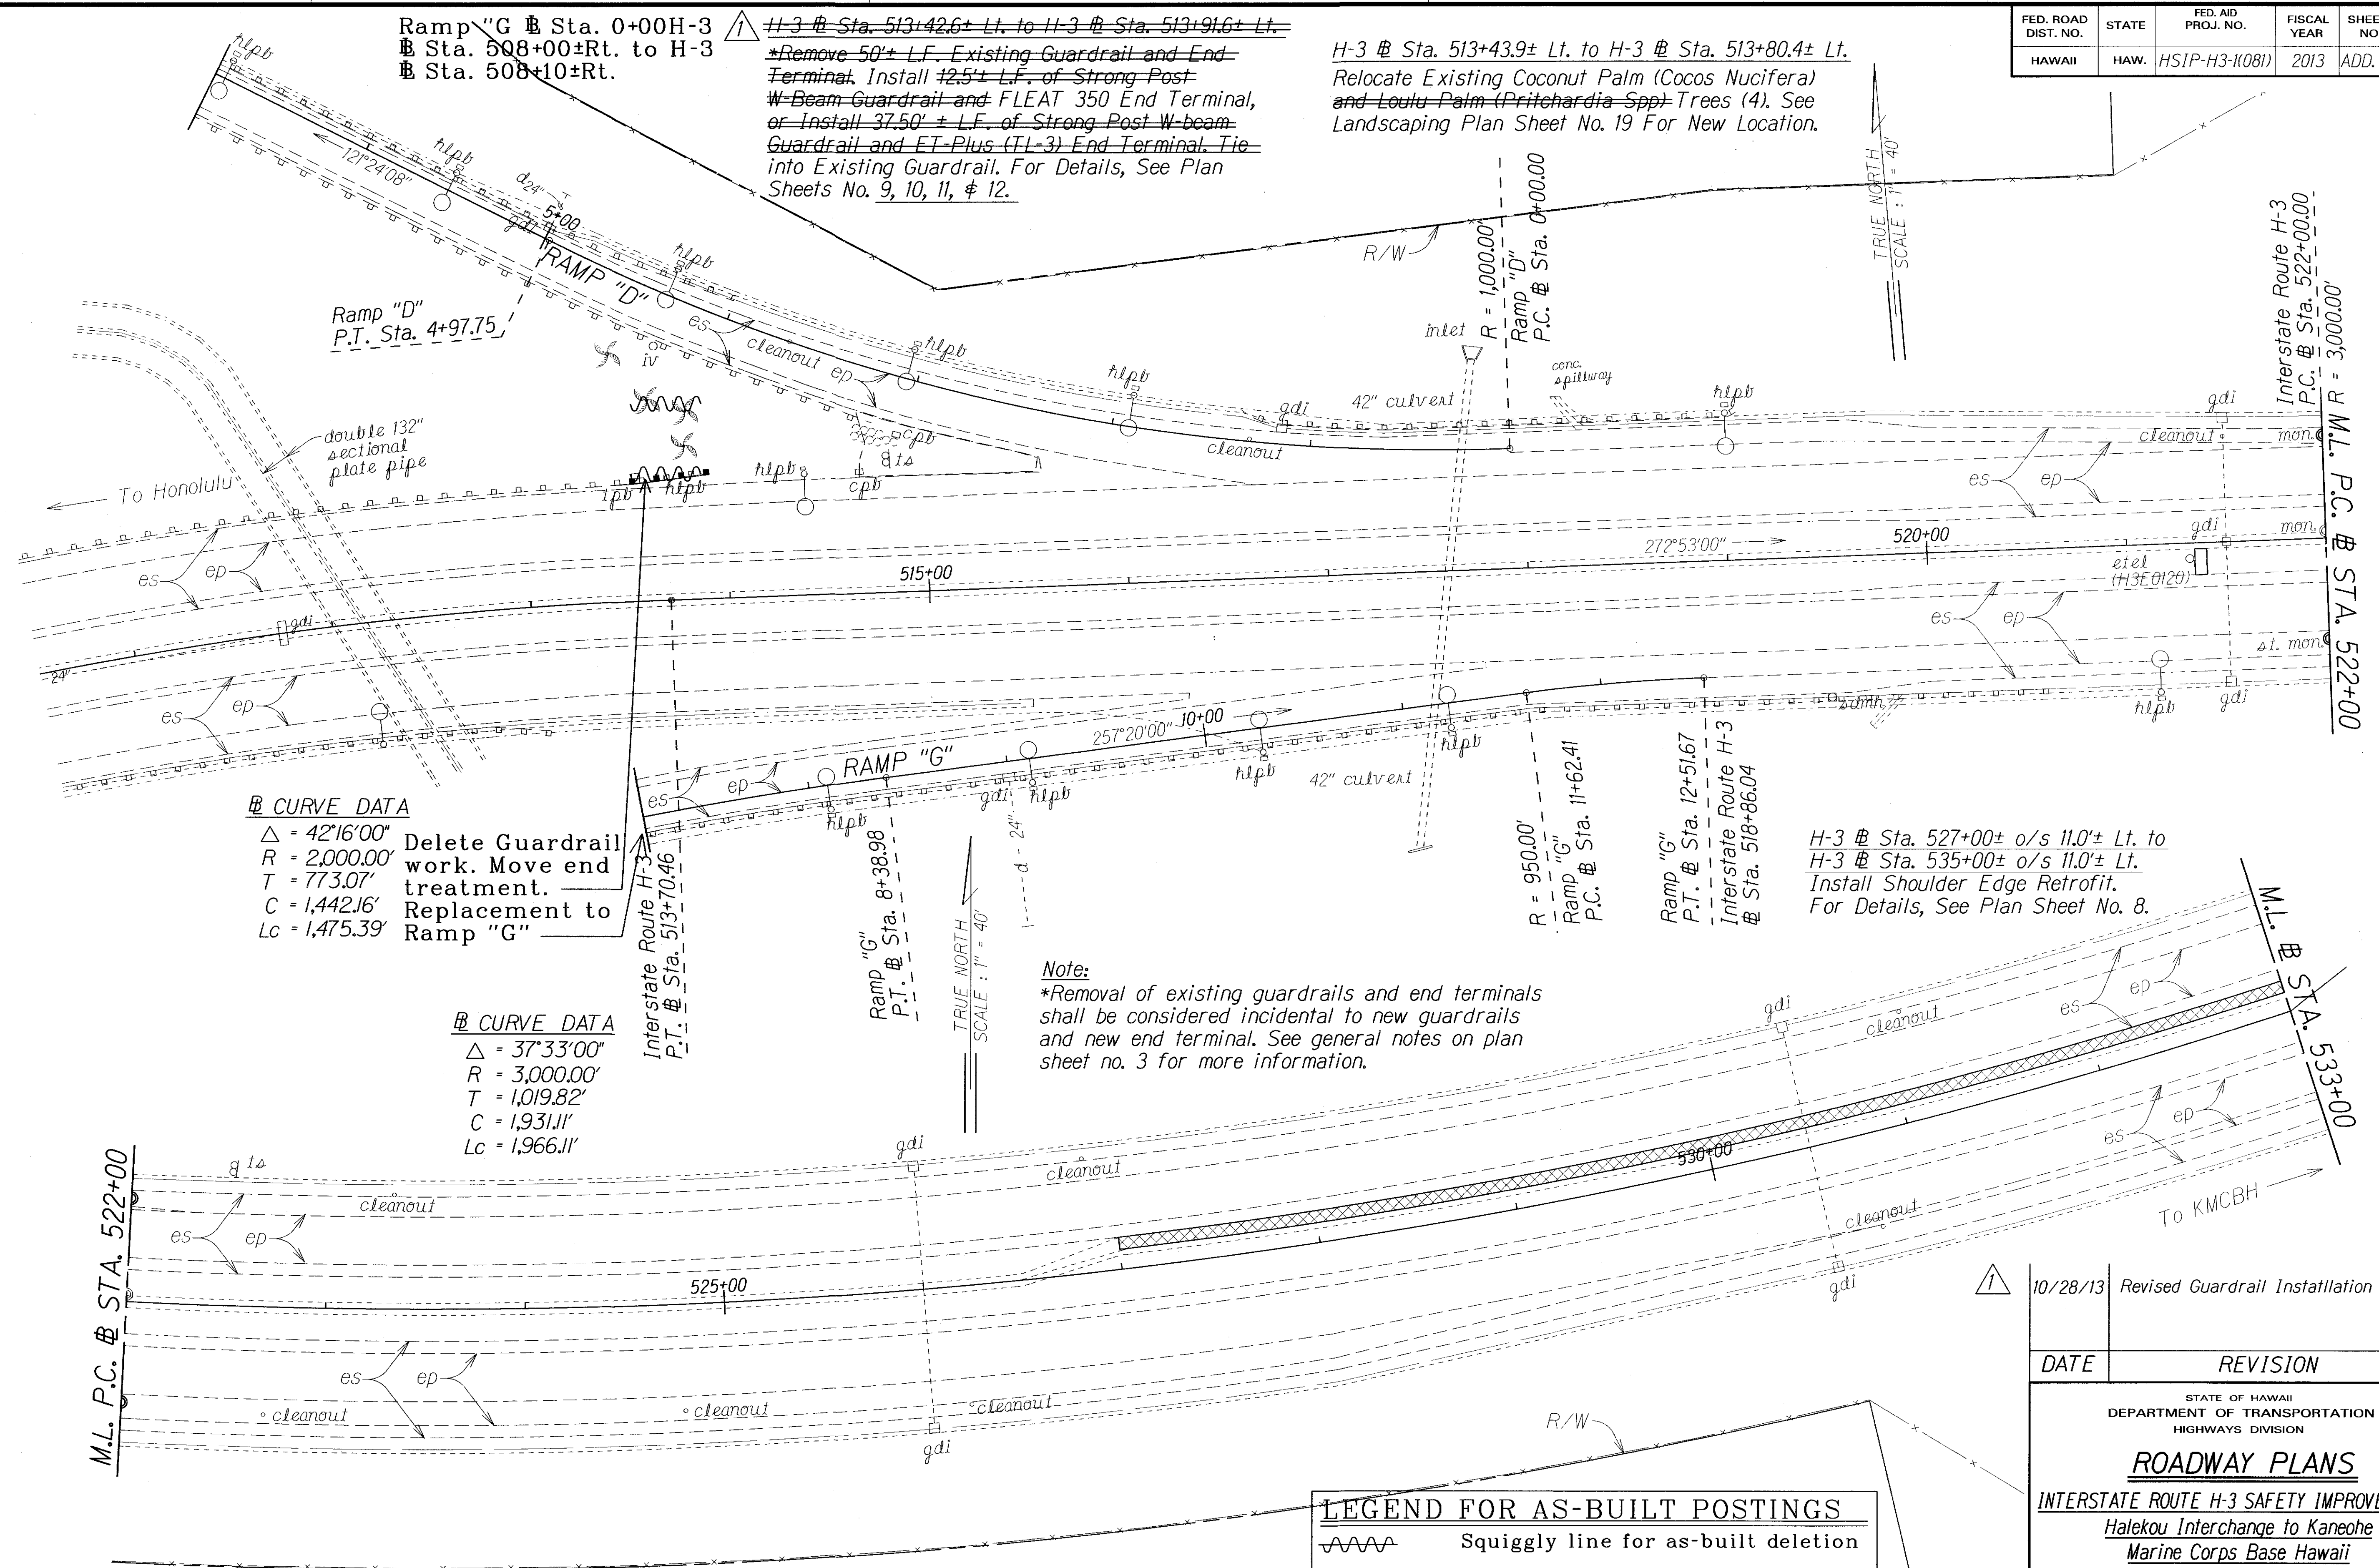
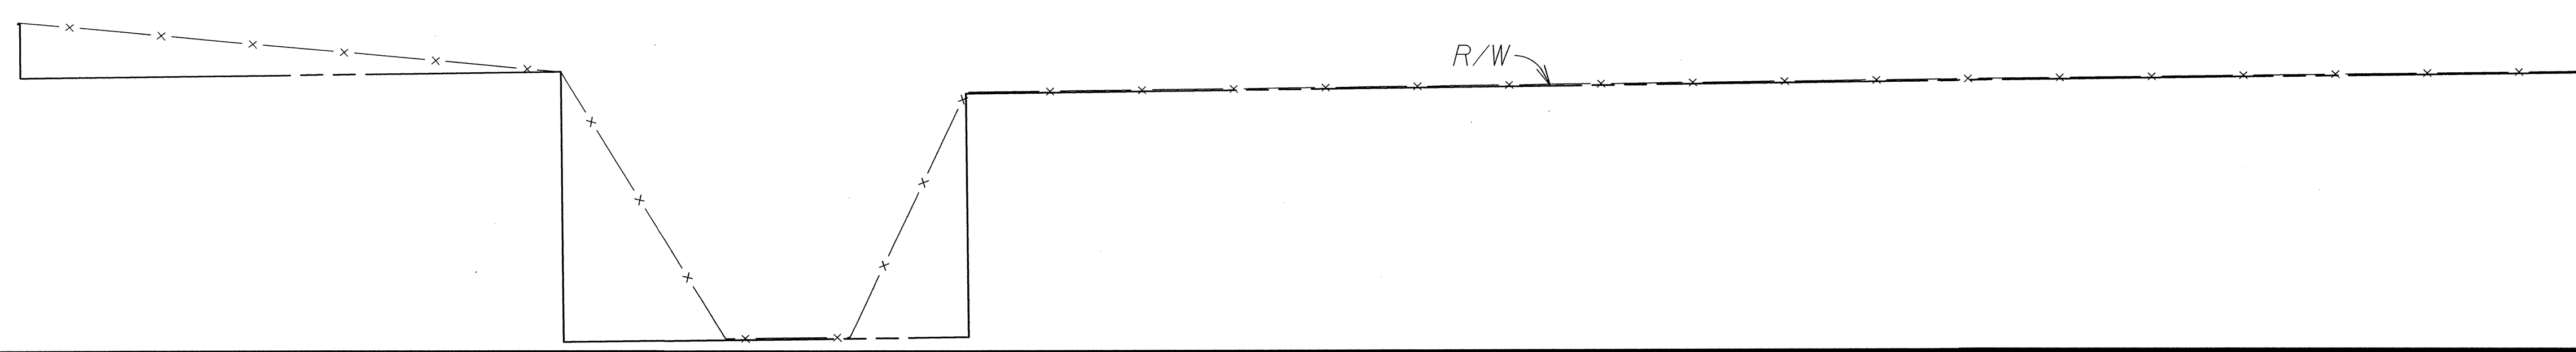


| FED. ROAD<br>DIST. NO. | STATE | FED. AID<br>PROJ. NO. | FISCAL<br>YEAR | SHEET<br>NO. | TOTAL<br>SHEETS |
|------------------------|-------|-----------------------|----------------|--------------|-----------------|
| HAWAII                 | HAW.  | HSIP-H3-1(081)        | 2013           | ADD. 13      | 36              |

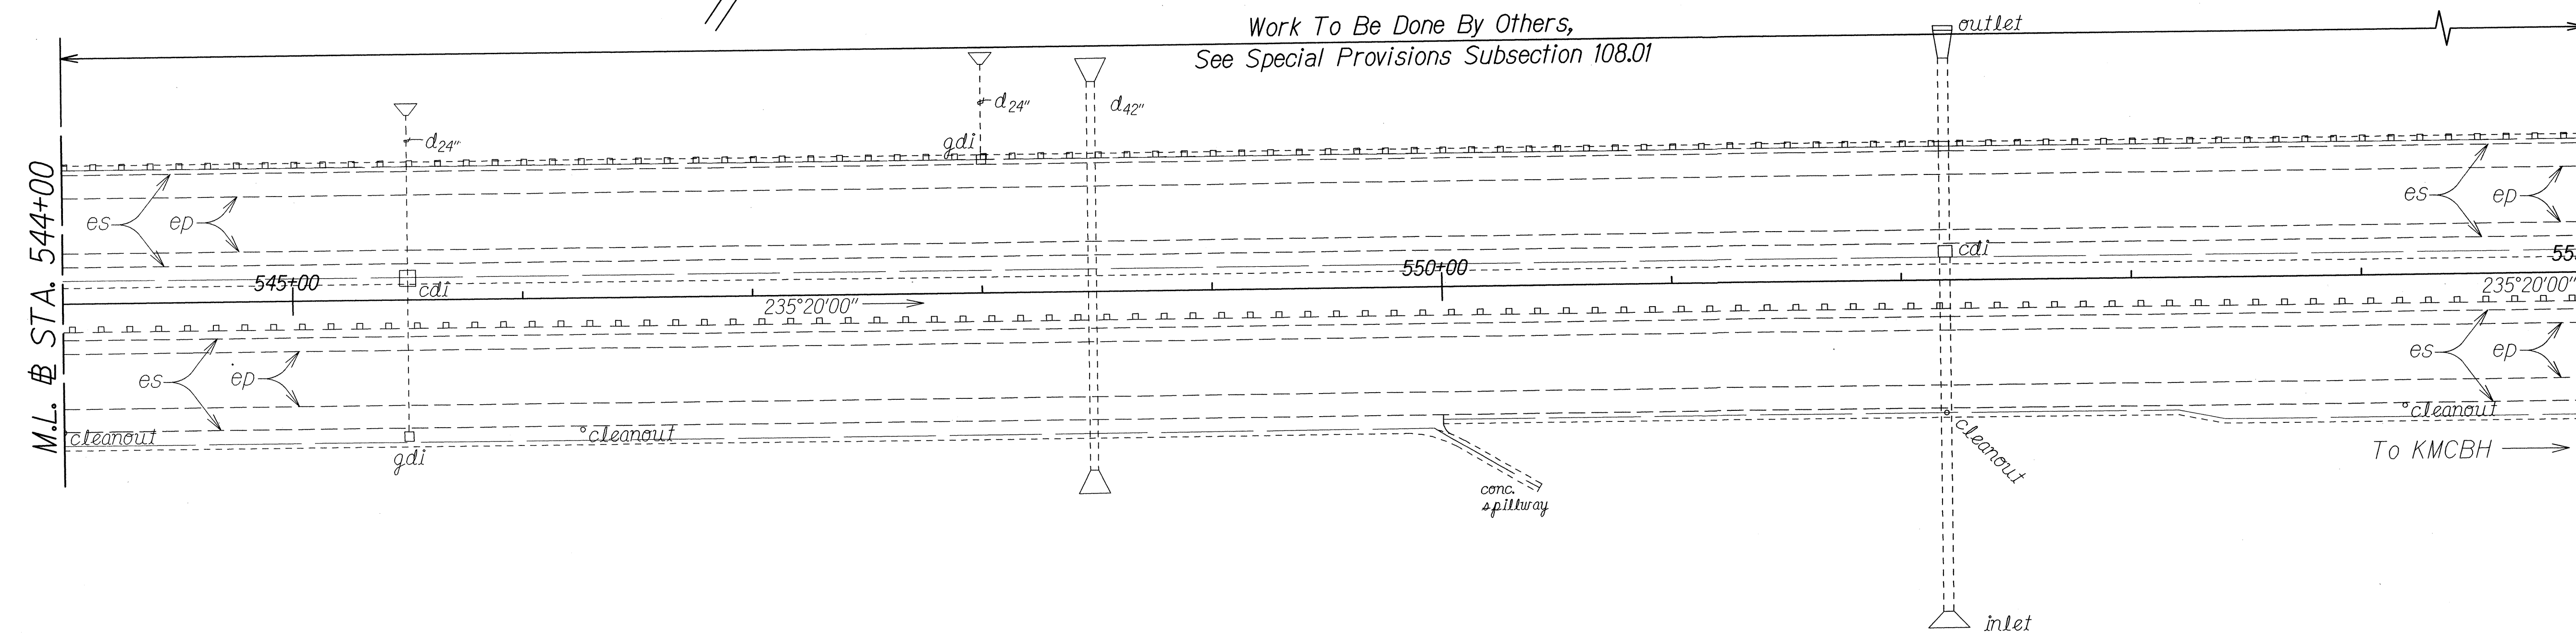

| FED. ROAD DIST. NO. | STATE | FED. AID PROJ. NO. | FISCAL YEAR | SHEET NO. | TOTAL SHEETS |
|---------------------|-------|--------------------|-------------|-----------|--------------|
| HAWAII              | HAW.  | HSIP-H3-1(081)     | 2013        | 14        | 36           |

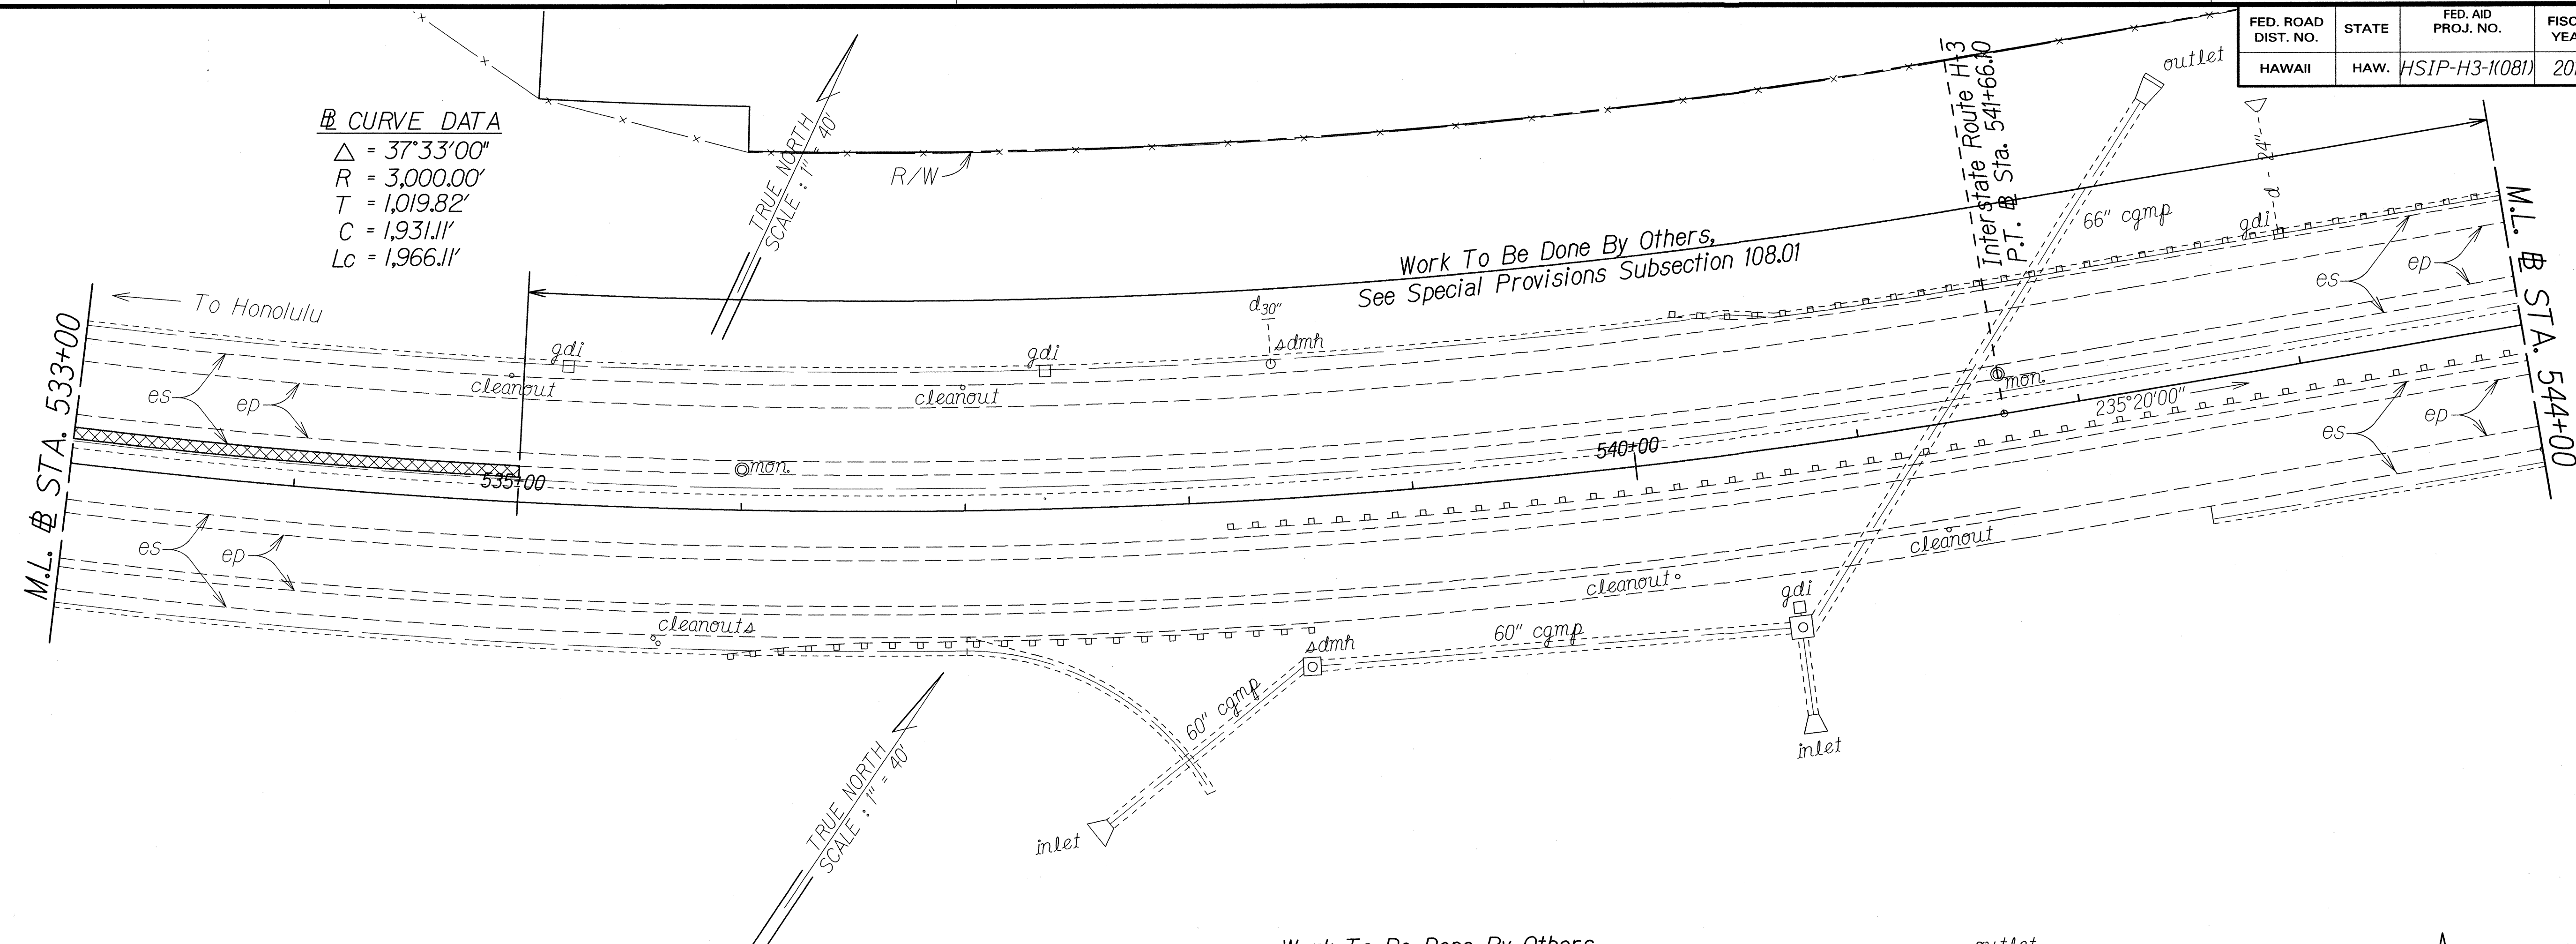

|                   |      |
|-------------------|------|
| SURVEY PLOTTED BY | DATE |
| DESIGNED BY       |      |
| CHECKED BY        |      |
| NOTED BY          |      |
| QUANTITIES BY     |      |
| CHECKED BY        |      |

STATE OF HAWAII  
DEPARTMENT OF TRANSPORTATION  
HIGHWAYS DIVISION

**ROADWAY PLANS**


INTERSTATE ROUTE H-3 SAFETY IMPROVEMENTS  
Halekou Interchange to Kaneohe  
Marine Corps Base Hawaii  
Federal Aid Project No. HSIP-H3-1(081)

Scale: 1"=40' Date: Aug, 2013

SHEET No. 2 OF 6 SHEETS

| FED. ROAD DIST. NO. | STATE | FED. AID PROJ. NO. | FISCAL YEAR | SHEET NO. | TOTAL SHEETS |
|---------------------|-------|--------------------|-------------|-----------|--------------|
| HAWAII              | HAW.  | HSIP-H3-1(081)     | 2013        | 15        | 36           |

@ CURVE DATA  
 $\Delta = 43^\circ 53' 10''$   
 $R = 3,000.00'$   
 $T = 1,208.61'$   
 $C = 2,242.11'$   
 $Lc = 2,297.87'$

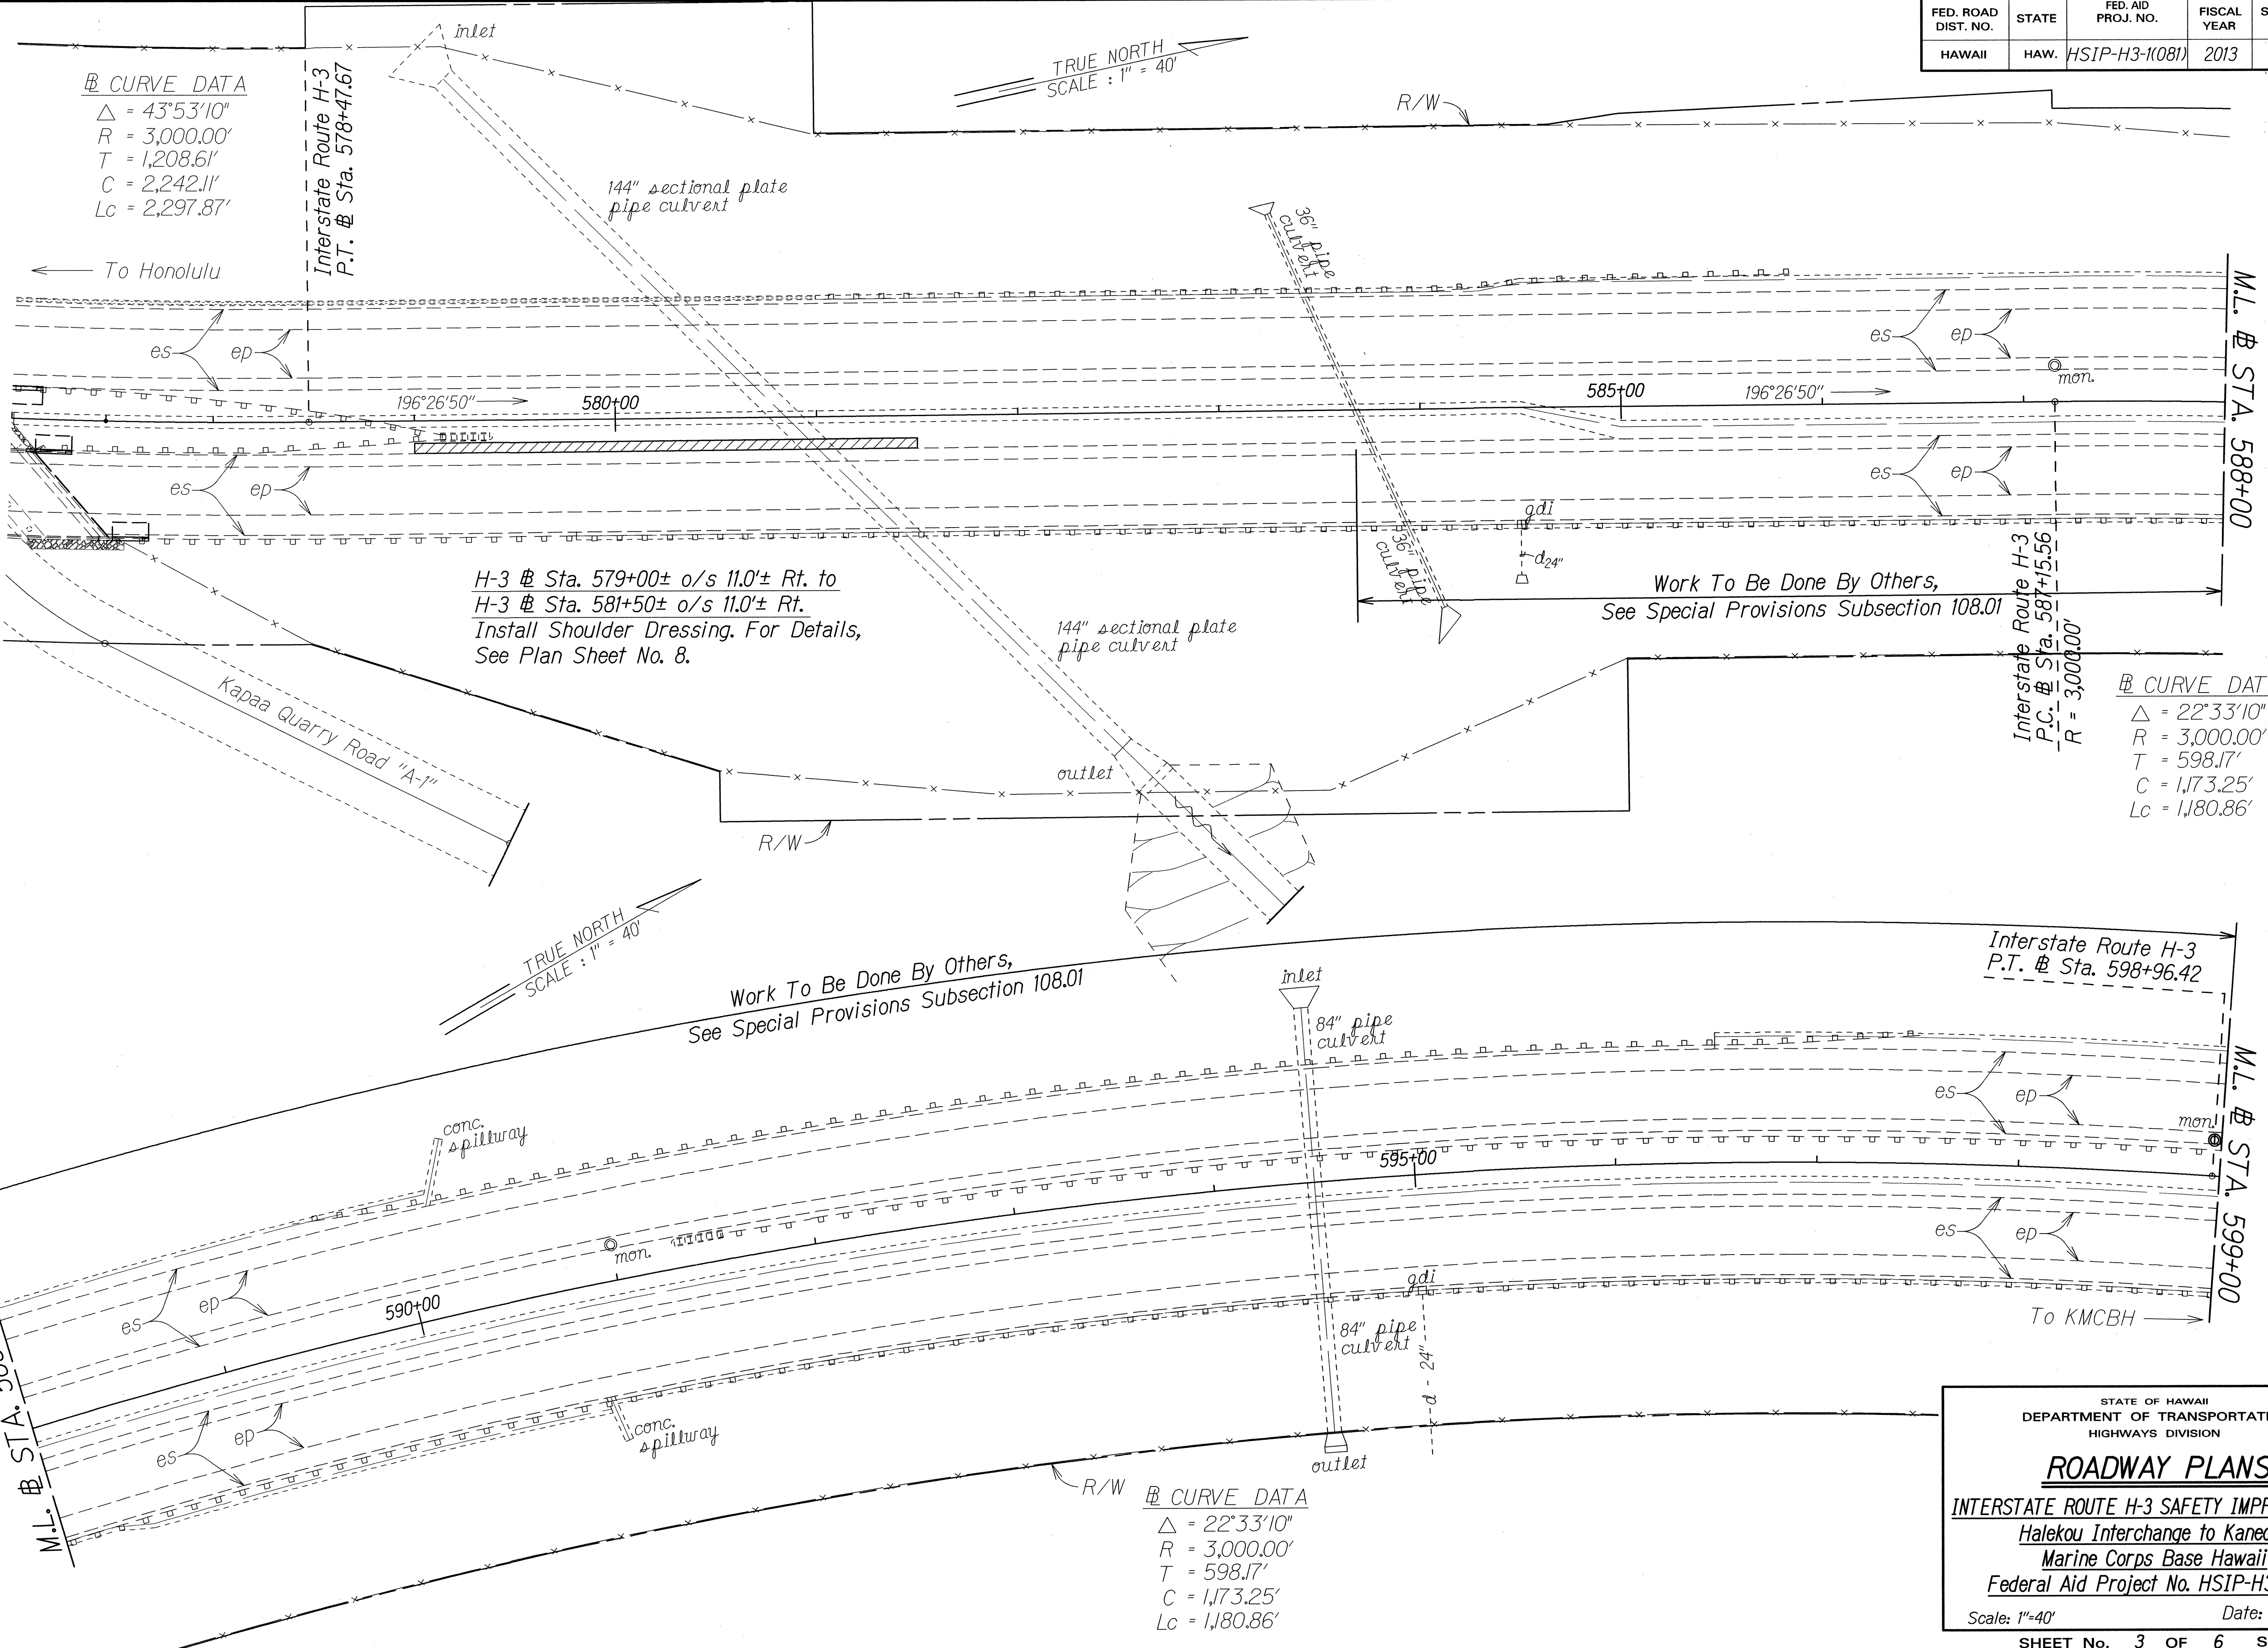

H-3 @ Sta. 579+00± o/s 11.0± Rt. to  
 H-3 @ Sta. 581+50± o/s 11.0± Rt.  
 Install Shoulder Dressing. For Details,  
 See Plan Sheet No. 8.

Work To Be Done By Others,  
 See Special Provisions Subsection 108.01

@ CURVE DATA  
 $\Delta = 22^\circ 33' 10''$   
 $R = 3,000.00'$   
 $T = 598.17'$   
 $C = 1,173.25'$   
 $Lc = 1,180.86'$

Work To Be Done By Others,  
 See Special Provisions Subsection 108.01



Interstate Route H-3  
 P.T. @ Sta. 598+96.42

@ CURVE DATA  
 $\Delta = 22^\circ 33' 10''$   
 $R = 3,000.00'$   
 $T = 598.17'$   
 $C = 1,173.25'$   
 $Lc = 1,180.86'$

|                   |      |
|-------------------|------|
| SURVEY PLOTTED BY | DATE |
| DRAWN BY          |      |
| DESIGNED BY       |      |
| QUANTITIES BY     |      |
| CHECKED BY        |      |

STATE OF HAWAII  
 DEPARTMENT OF TRANSPORTATION  
 HIGHWAYS DIVISION  
**ROADWAY PLANS**  
 INTERSTATE ROUTE H-3 SAFETY IMPROVEMENTS  
 Halekou Interchange to Kaneohe  
 Marine Corps Base Hawaii  
 Federal Aid Project No. HSIP-H3-1(081)  
 Scale: 1"=40' Date: Aug, 2013  
 SHEET No. 3 OF 6 SHEETS

| FED. ROAD DIST. NO. | STATE | FED. AID PROJ. NO. | FISCAL YEAR | SHEET NO. | TOTAL SHEETS |
|---------------------|-------|--------------------|-------------|-----------|--------------|
| HAWAII              | HAW.  | HSIP-H3-1(081)     | 2013        | 16        | 36           |

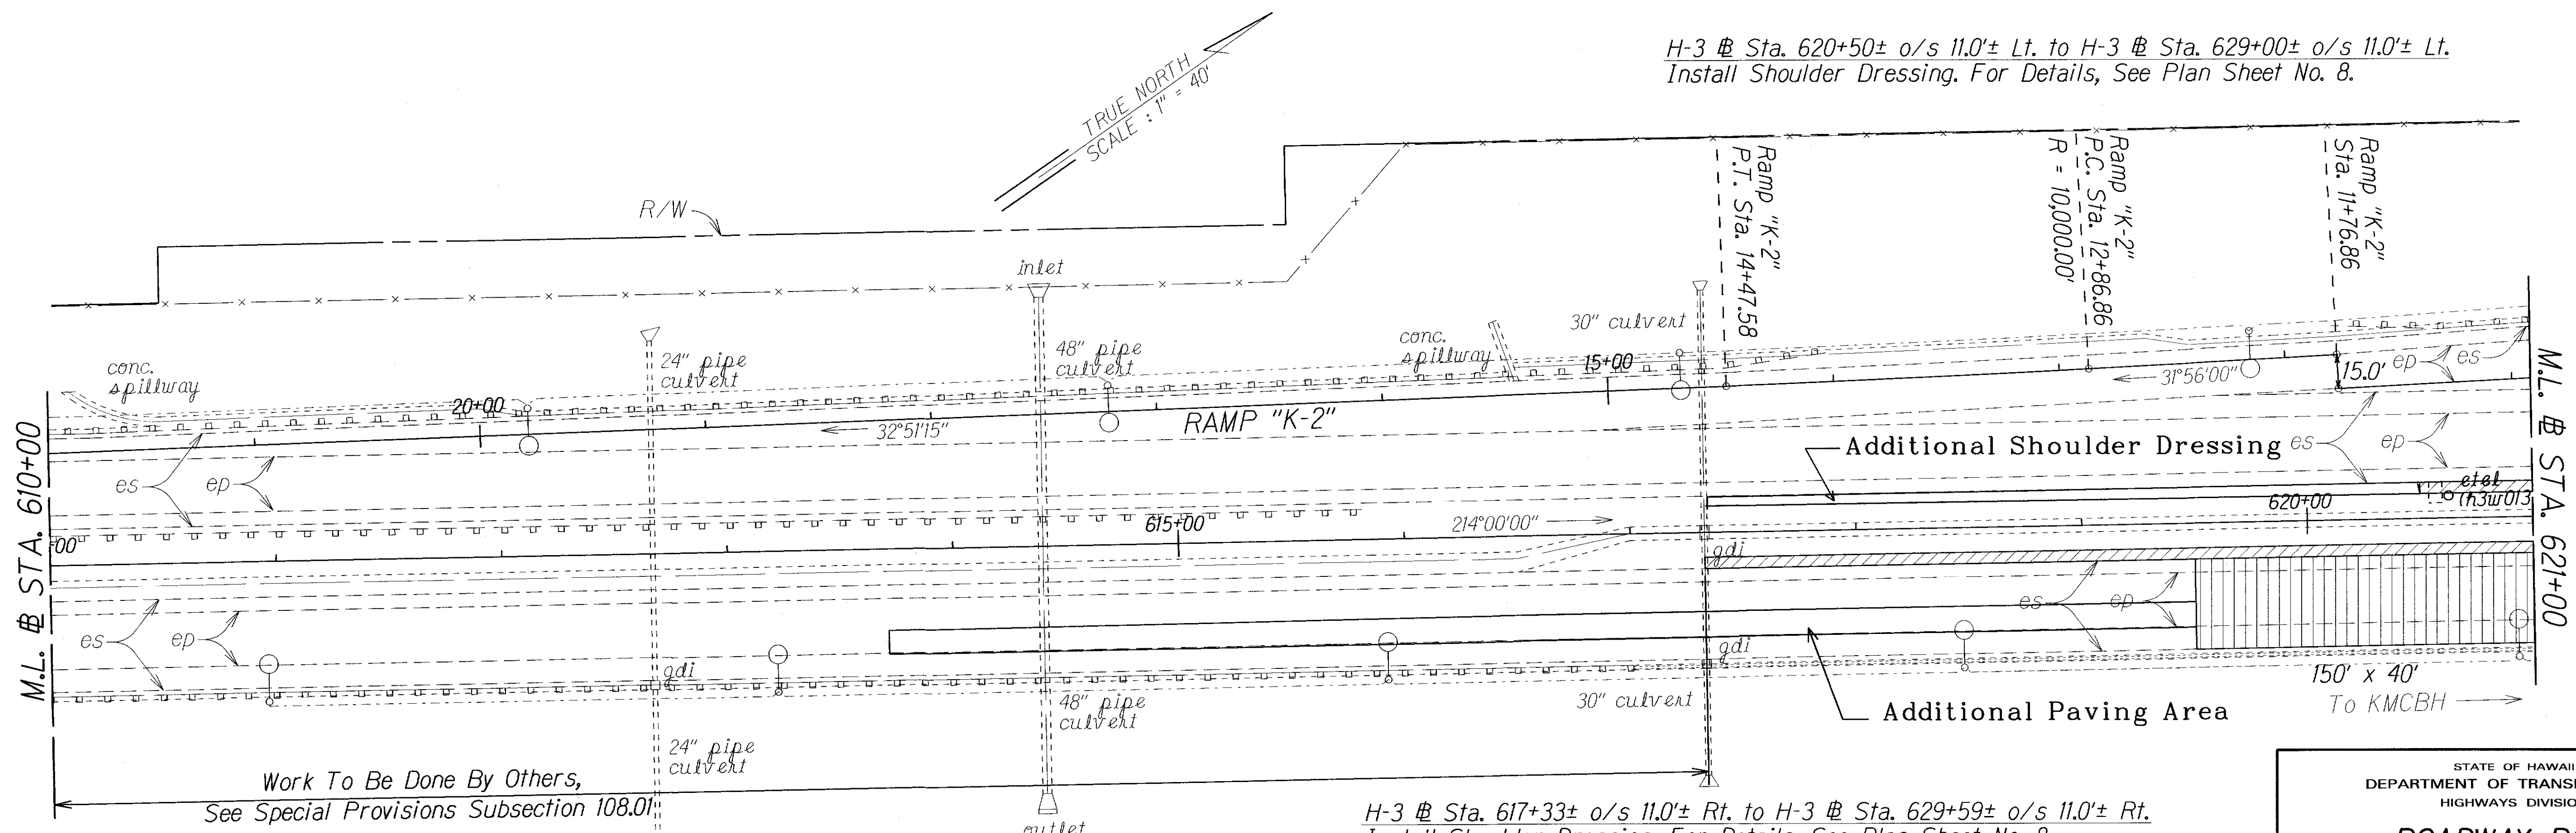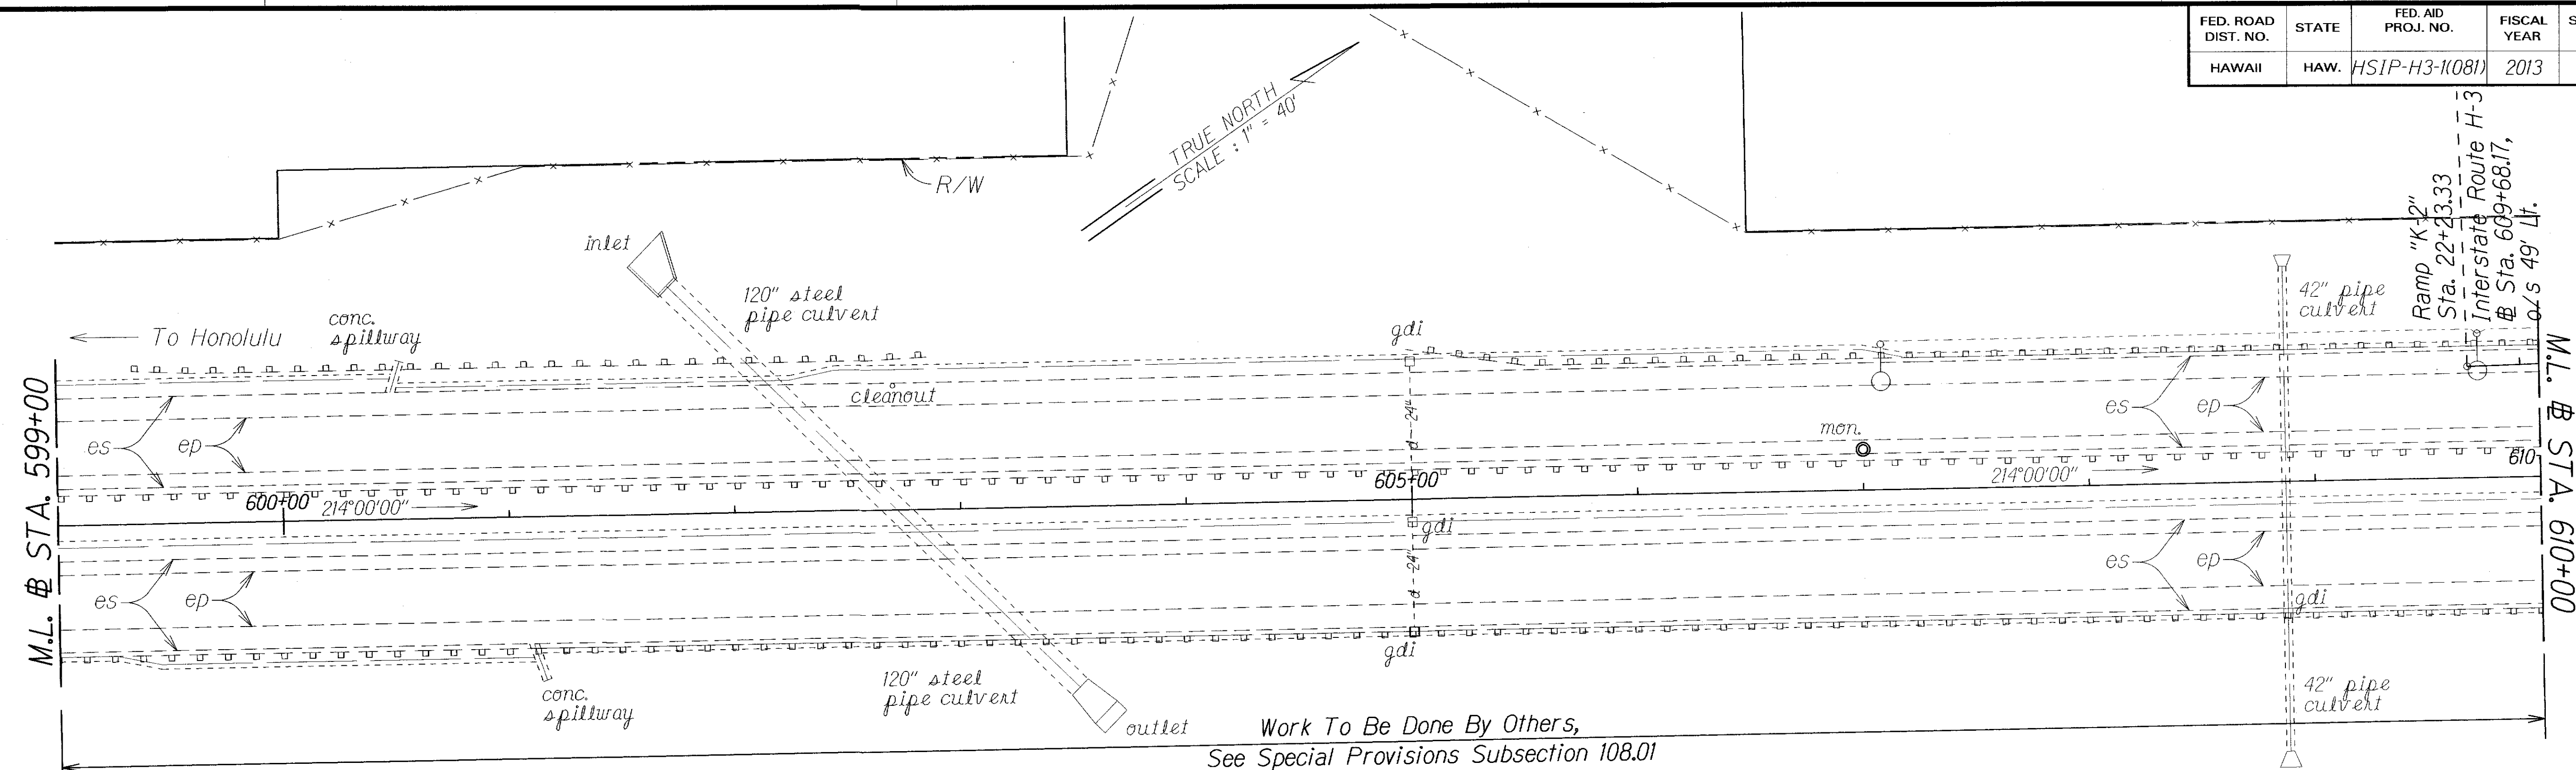

| LEGEND FOR AS-BUILT POSTINGS |                                     |
|------------------------------|-------------------------------------|
|                              | Squiggly line for as-built deletion |
|                              | Double line for as-built deletion   |
| Roadway                      | Text for as-built posting           |

H-3 @ Sta. 617+33± o/s 11.0± Rt. to H-3 @ Sta. 629+59± o/s 11.0± Rt.  
Install Shoulder Dressing. For Details, See Plan Sheet No. 8.

H-3 @ Sta. 619+50± o/s 16.0± Rt. to H-3 @ Sta. 627+47± o/s 74.0± Rt.  
Resurface 40,200 SF of Existing Pavement. For Details, See Plan Sheet No. 7.

STATE OF HAWAII  
DEPARTMENT OF TRANSPORTATION  
HIGHWAYS DIVISION

**ROADWAY PLANS**


INTERSTATE ROUTE H-3 SAFETY IMPROVEMENTS  
Halekou Interchange to Kaneohe  
Marine Corps Base Hawaii  
Federal Aid Project No. HSIP-H3-1(081)

Scale: 1"=40' Date: Aug, 2013

SHEET No. 4 OF 6 SHEETS

"AS-BUILT"

| FED. ROAD DIST. NO. | STATE | FED. AID PROJ. NO. | FISCAL YEAR | SHEET NO. | TOTAL SHEETS |
|---------------------|-------|--------------------|-------------|-----------|--------------|
| HAWAII              | HAW.  | HSIP-H3-1081       | 2013        | ADD. 17   | 36           |

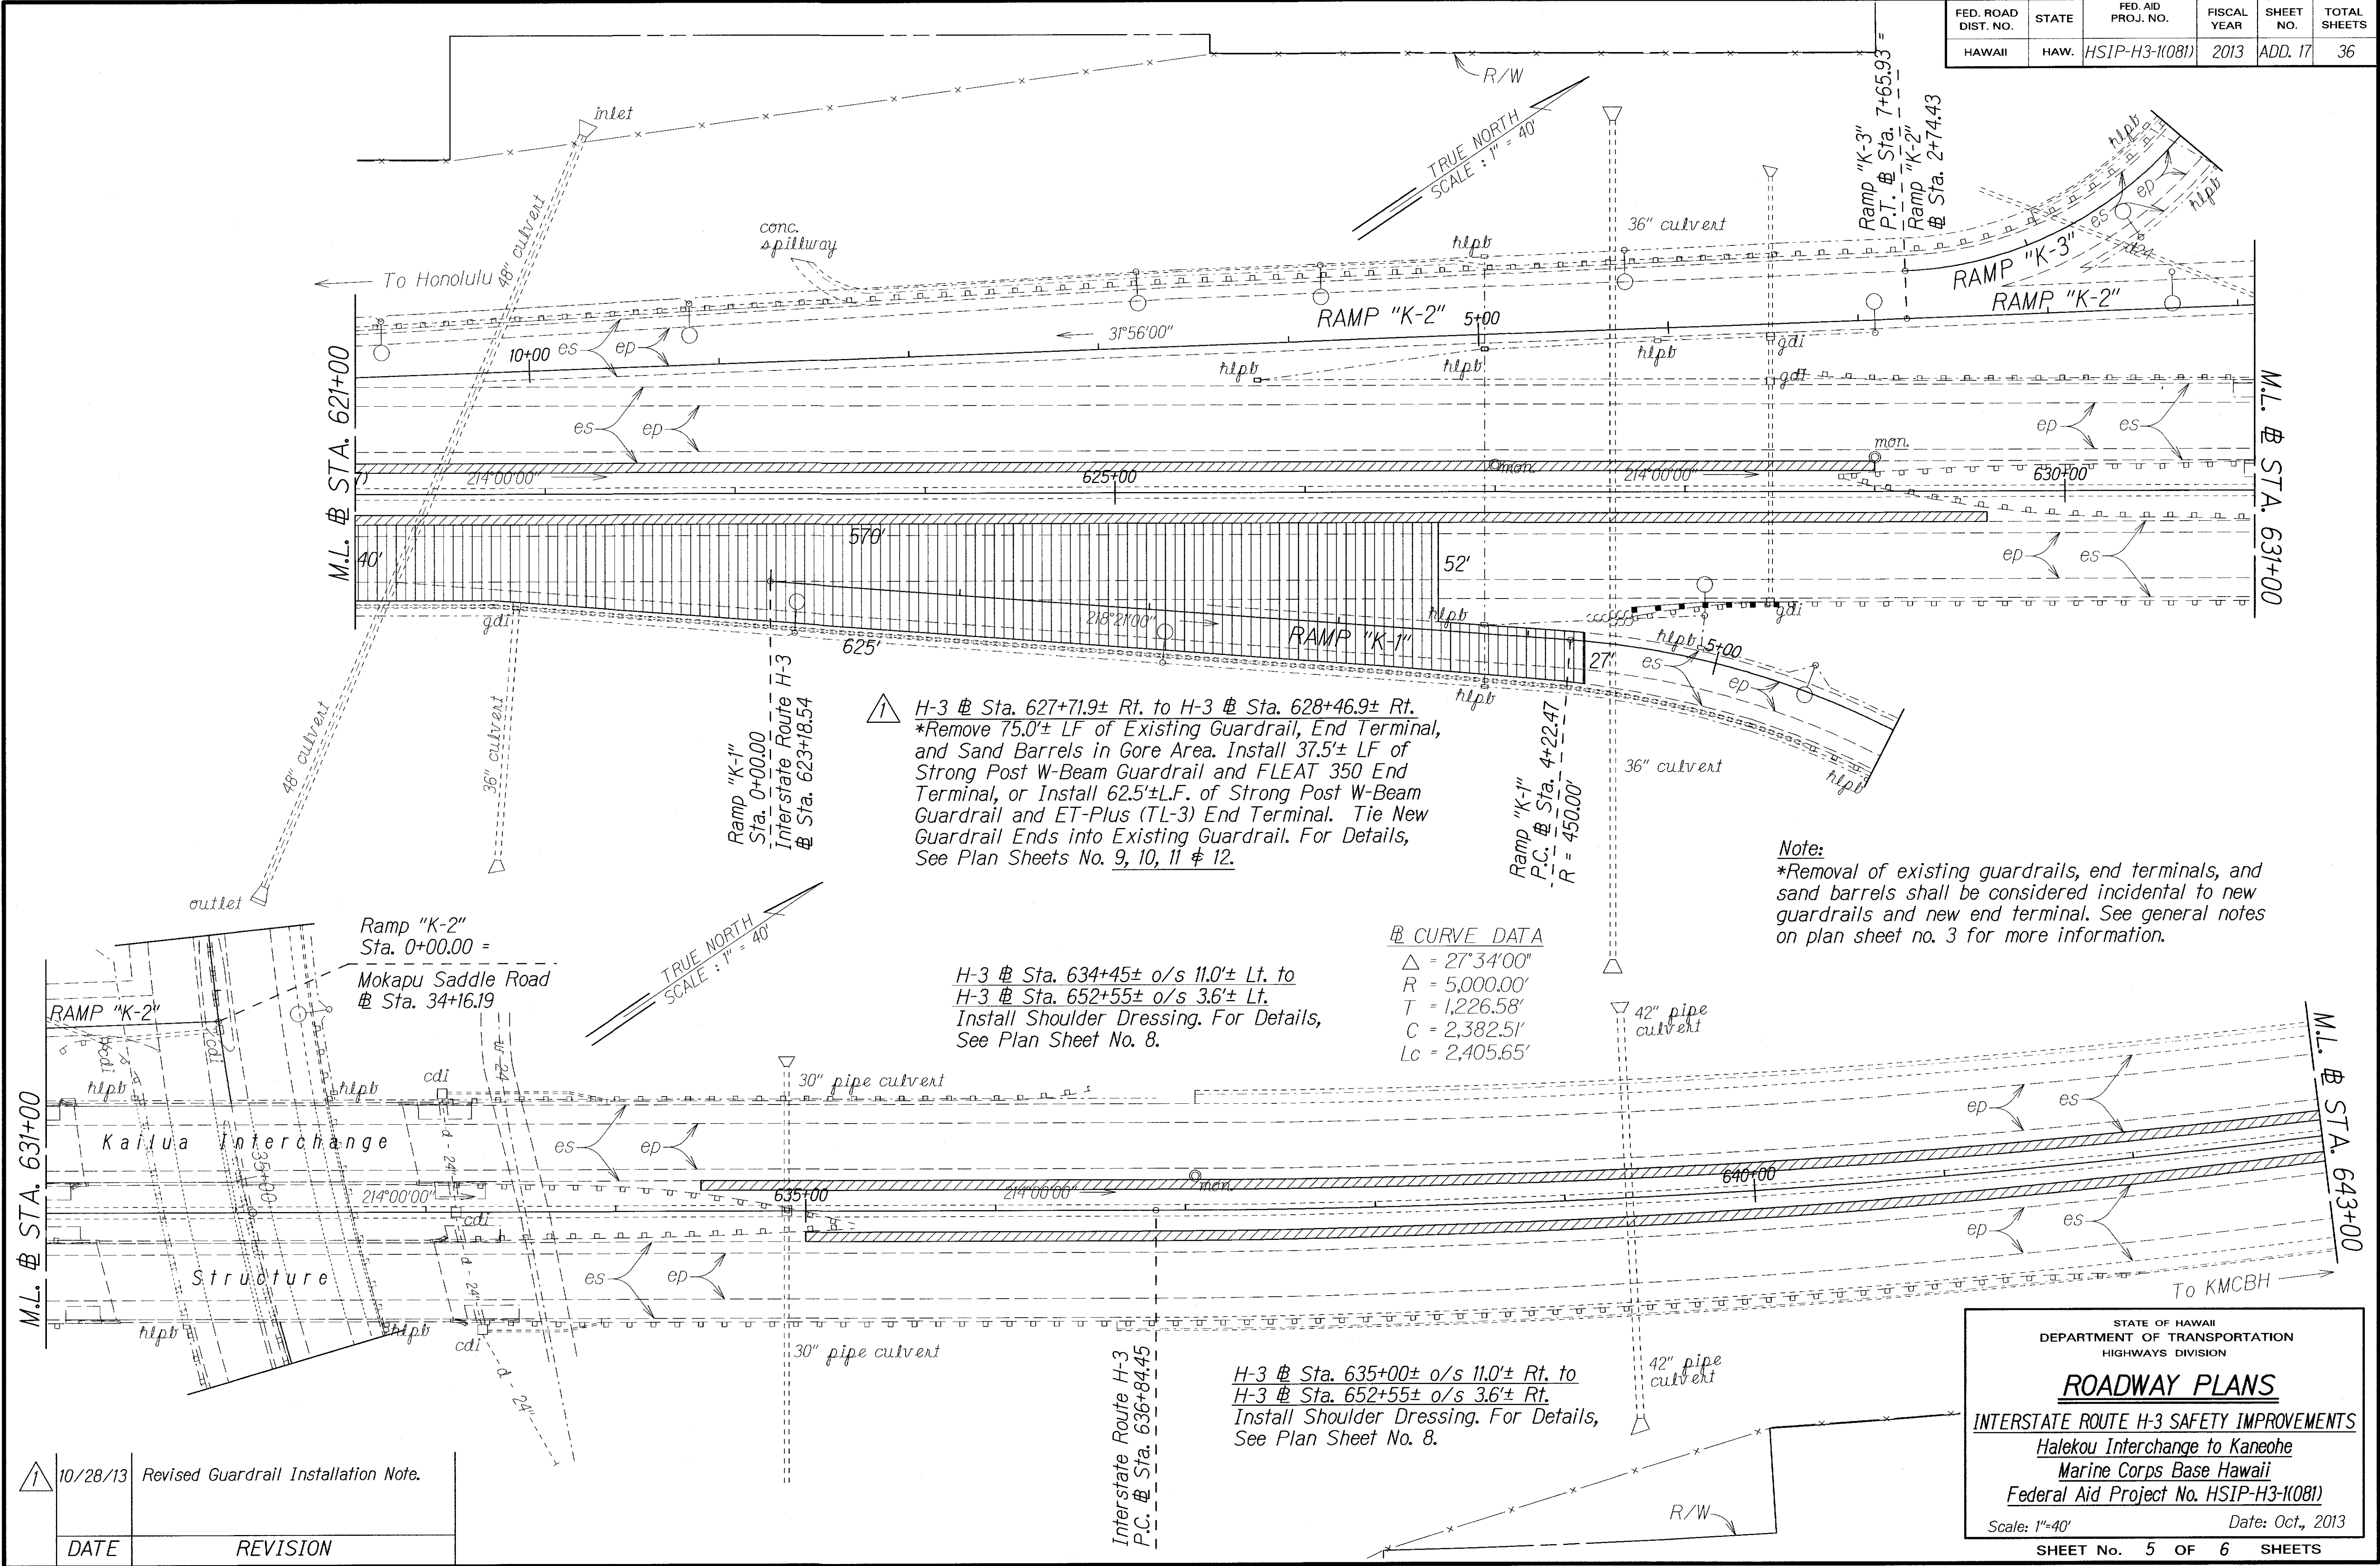

|               |                   |      |
|---------------|-------------------|------|
| ORIGINAL PLAN | SURVEY PLOTTED BY | DATE |
| NOTE BOOK     | DRAWN BY          |      |
| DESIGNED BY   | CHECKED BY        |      |
| QUANTITIES BY |                   |      |
| CHECKED BY    |                   |      |

| 10/28/13 | Revised Guardrail Installation Note. |
|----------|--------------------------------------|
| DATE     | REVISION                             |

STATE OF HAWAII  
DEPARTMENT OF TRANSPORTATION  
HIGHWAYS DIVISION


### ROADWAY PLANS

INTERSTATE ROUTE H-3 SAFETY IMPROVEMENTS  
Halekou Interchange to Kaneohe  
Marine Corps Base Hawaii  
Federal Aid Project No. HSIP-H3-1081

Scale: 1"=40'      Date: Oct., 2013

SHEET No. 5 OF 6 SHEETS

| FED. ROAD DIST. NO. | STATE | FED. AID PROJ. NO. | FISCAL YEAR | SHEET NO. | TOTAL SHEETS |
|---------------------|-------|--------------------|-------------|-----------|--------------|
| HAWAII              | HAW.  | HSIP-H3-1(081)     | 2013        | 18        | 36           |

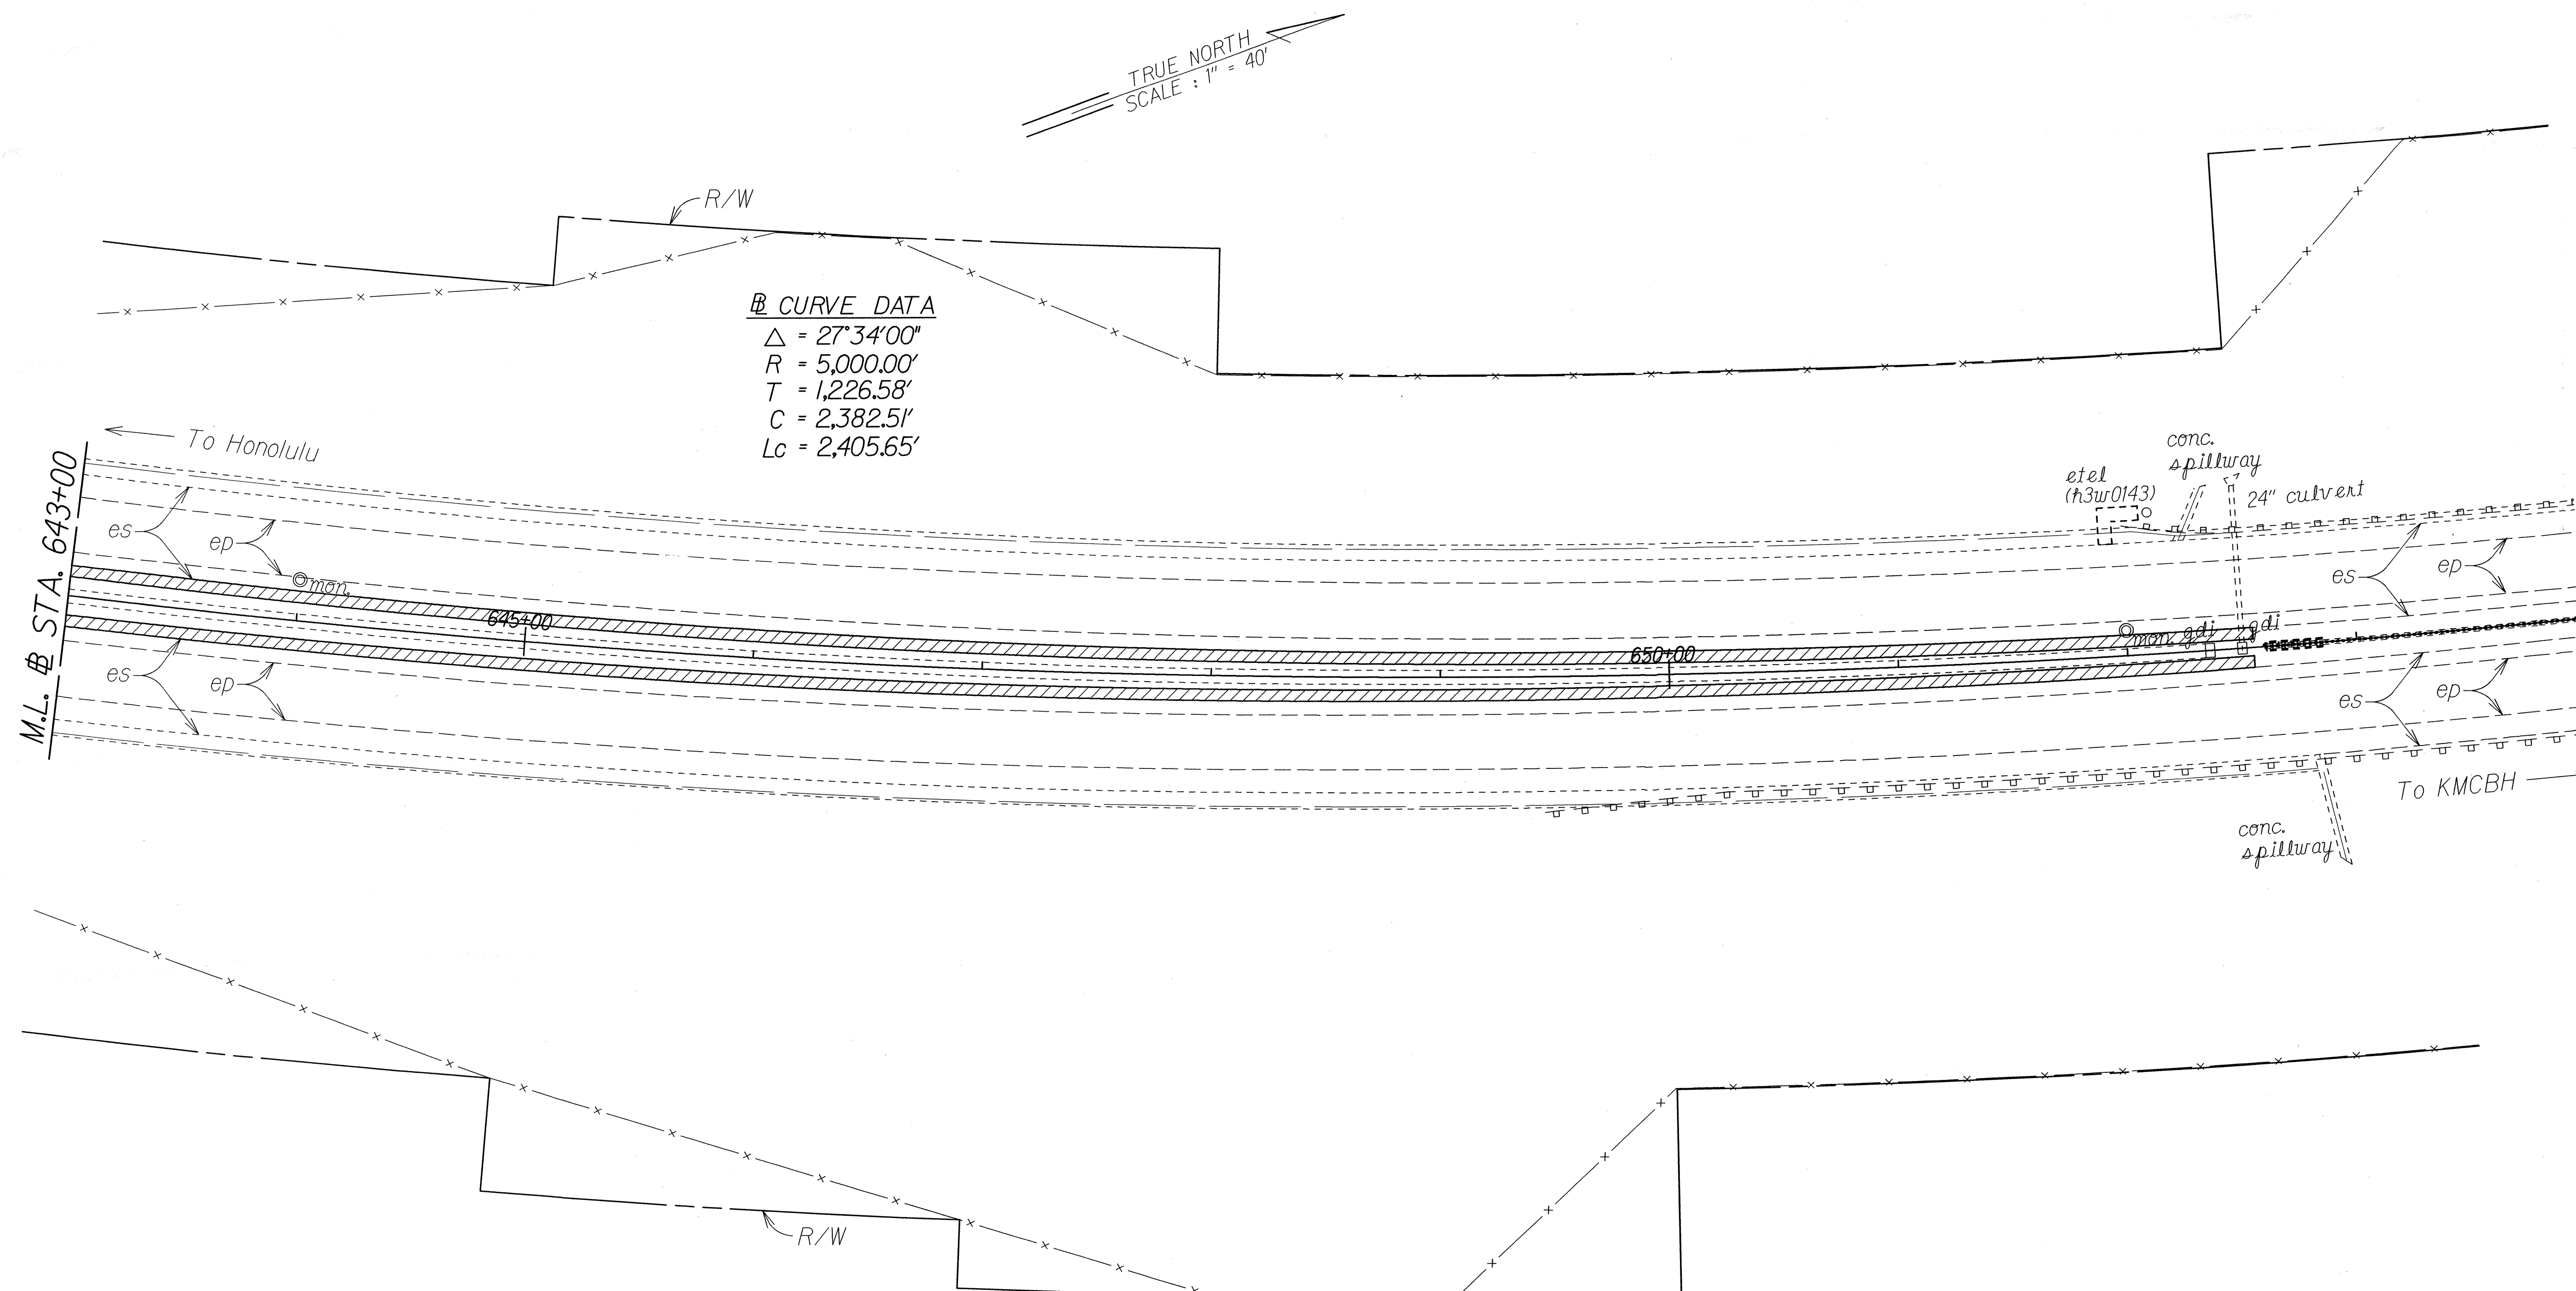

Curve Data  
 $\Delta = 27^{\circ}34'00''$   
 $R = 5,000.00'$   
 $T = 1,226.58'$   
 $C = 2,382.51'$   
 $L_c = 2,405.65'$

|               |                   |            |
|---------------|-------------------|------------|
| ORIGINAL PLAN | SURVEY PLOTTED BY | DATE       |
| DRAWN BY      | DESIGNED BY       | CHECKED BY |
| NOTE BOOK     | QUANTITIES BY     |            |
| dal/robert    |                   |            |
| 8/13/2013     |                   |            |

STATE OF HAWAII  
DEPARTMENT OF TRANSPORTATION  
HIGHWAYS DIVISION

**ROADWAY PLANS**

INTERSTATE ROUTE H-3 SAFETY IMPROVEMENTS  
Halekou Interchange to Kaneohe  
Marine Corps Base Hawaii  
Federal Aid Project No. HSIP-H3-1(081)

Scale: 1"=40' Date: Aug, 2013

SHEET No. 6 OF 6 SHEETS