

INDEX TO DRAWINGS	
SHEET NO.	DESCRIPTION
1	TITLE SHEET
2	STANDARD PLANS SUMMARY
3	GENERAL NOTES AND LEGEND
4 - 5	WATER POLLUTION AND EROSION CONTROL NOTES
6	GUARDRAIL AND SHOULDER EDGE RETROFIT / DRESSING LAYOUT PLAN
7	TYPICAL SECTIONS
8	TYPICAL DETAILS
9 - 12	GUARDRAIL DETAILS AND NOTES
13 - 18	ROADWAY PLANS
19	LANDSCAPING PLAN
20 - 36	TRAFFIC PLANS

STATE OF HAWAII

DEPARTMENT OF TRANSPORTATION

HIGHWAYS DIVISION

HONOLULU, HAWAII

AS-BUILT

PLANS FOR

INTERSTATE ROUTE H-3 SAFETY IMPROVEMENTS


HALEKOU INTERCHANGE TO KANEOHE MARINE CORPS BASE HAWAII

FEDERAL AID PROJECT NO. HSIP-H3-1(081)

DISTRICT OF KOOLAUPOKO

ISLAND OF OAHU

PROJECT LIMITS

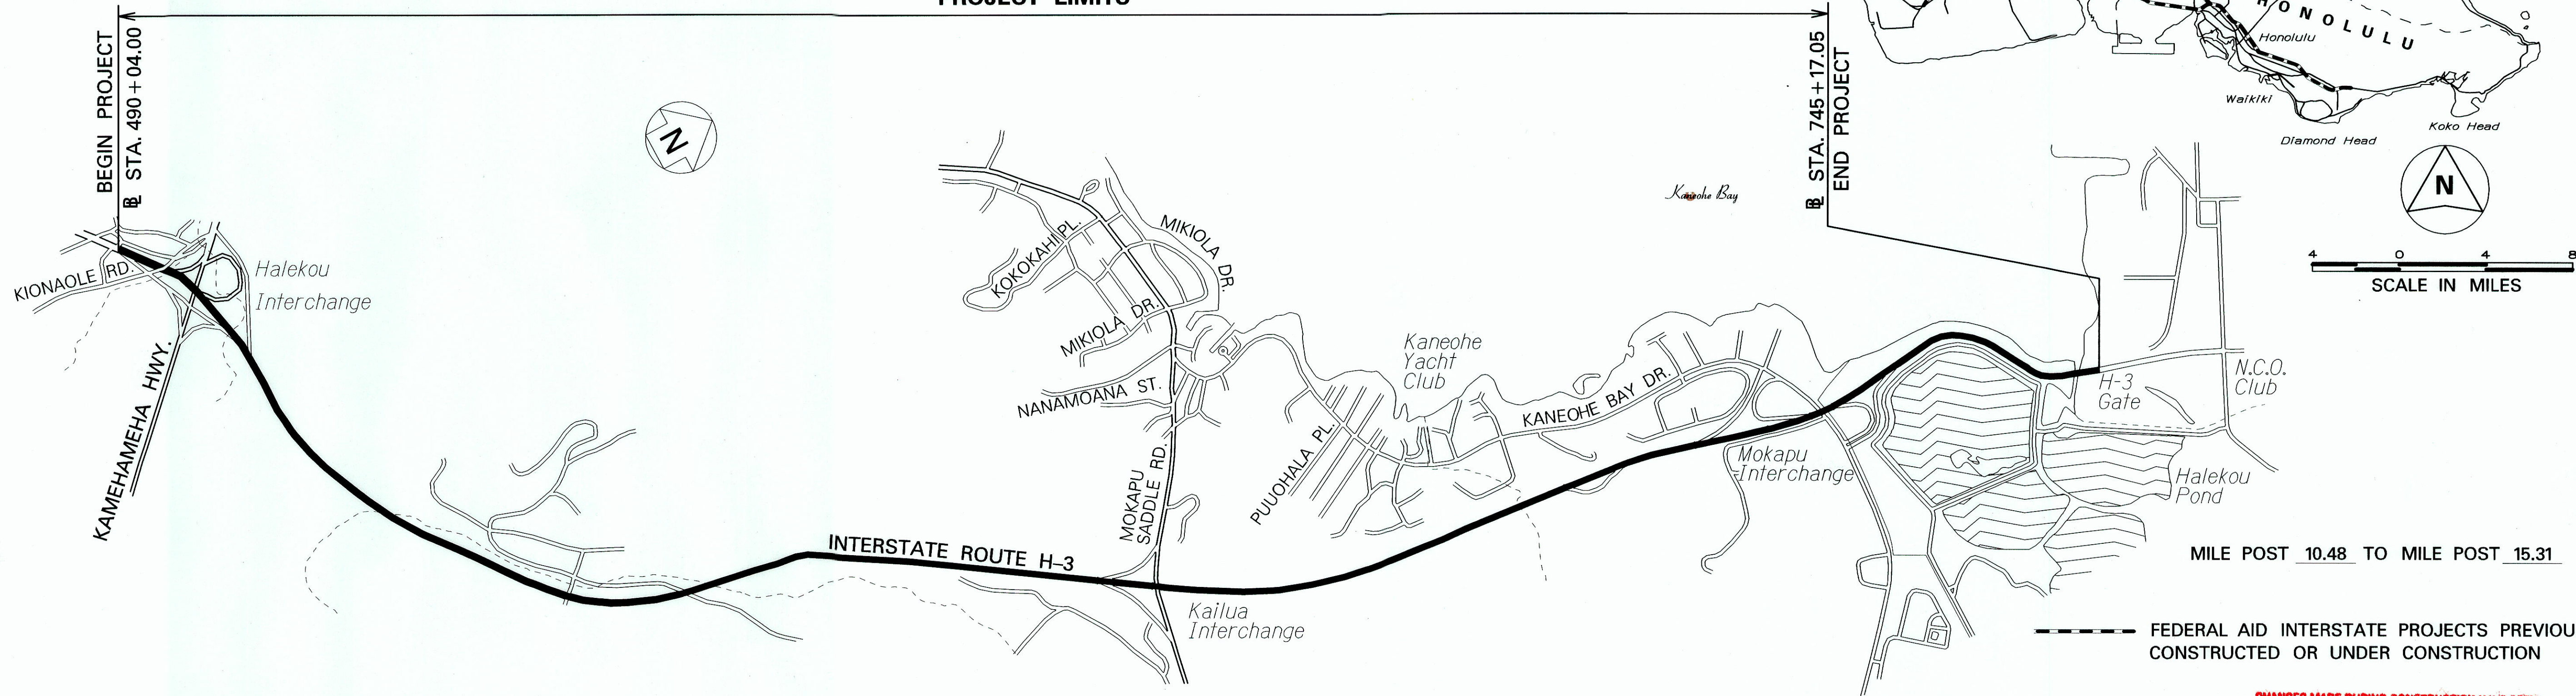

MILE POST 10.48 TO MILE POST 15.31

FEDERAL AID INTERSTATE PROJECTS PREVIOUSLY CONSTRUCTED OR UNDER CONSTRUCTION

DESIGN DESIGNATION	Interstate Route H-3 Kamehameha Off Ramp to Kailua Interchange	Interstate Route H-3 Kailua Interchange to Mokapu Interchange	Interstate Route H-3 Mokapu Interchange to Kaneohe Marine Corps Base Hawaii
ADT (2012)	25,800	13,700	16,300
ADT (2022)	29,500	16,900	19,300
DHV	2,800	1,690	1,740
K	9.5 %	10.0 %	9.0 %
D	55/45	60/40	75/25
T	3.5 %	2.5 %	4.0 %
T24	4.0 %	3.0 %	4.0 %

CHANGES MADE DURING CONSTRUCTION HAVE BEEN INCORPORATED ON THESE PLANS EXCEPT CHANGES IN THE ORIGINAL THEORETICAL QUANTITIES. FOR ACTUAL QUANTITIES, REFER TO PROJECT LEDGER AND/OR COMPUTATION BOOK.

Matthew N. Smith
RESIDENT ENGINEER

6/14/16
DATE

DEPARTMENT OF TRANSPORTATION

STATE OF HAWAII

APPROVED:

David A. J. Chua
DIR. OF TRANSPORTATION


8/19/13
DATE

692-7570
PHONE

AUG 2013
DATE

HWY-DD
MANAGED BY


HWY-D
DESIGNED BY

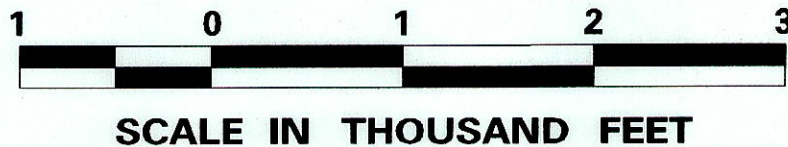

LAYOUT PLAN

LENGTH OF PROJECT.....4.83 MILES

FED. ROAD DIST. NO.	STATE	FED. AID PROJ. NO.	FISCAL YEAR	SHEET NO.	TOTAL SHEETS
HAWAII	HAW.	HSIP-H3-1(081)	2013	1	36

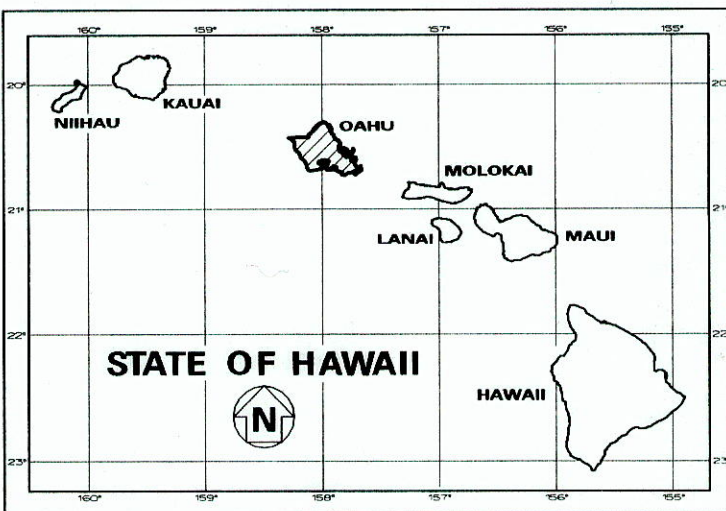

LOCATION OF PROJECT