



FED. ROAD DIST. NO.	STATE	FED. AID PROJ. NO.	FISCAL YEAR	SHEET NO.	TOTAL SHEETS
HAWAII	HAW.	HSIP-H3-1(081)	2013	8	36

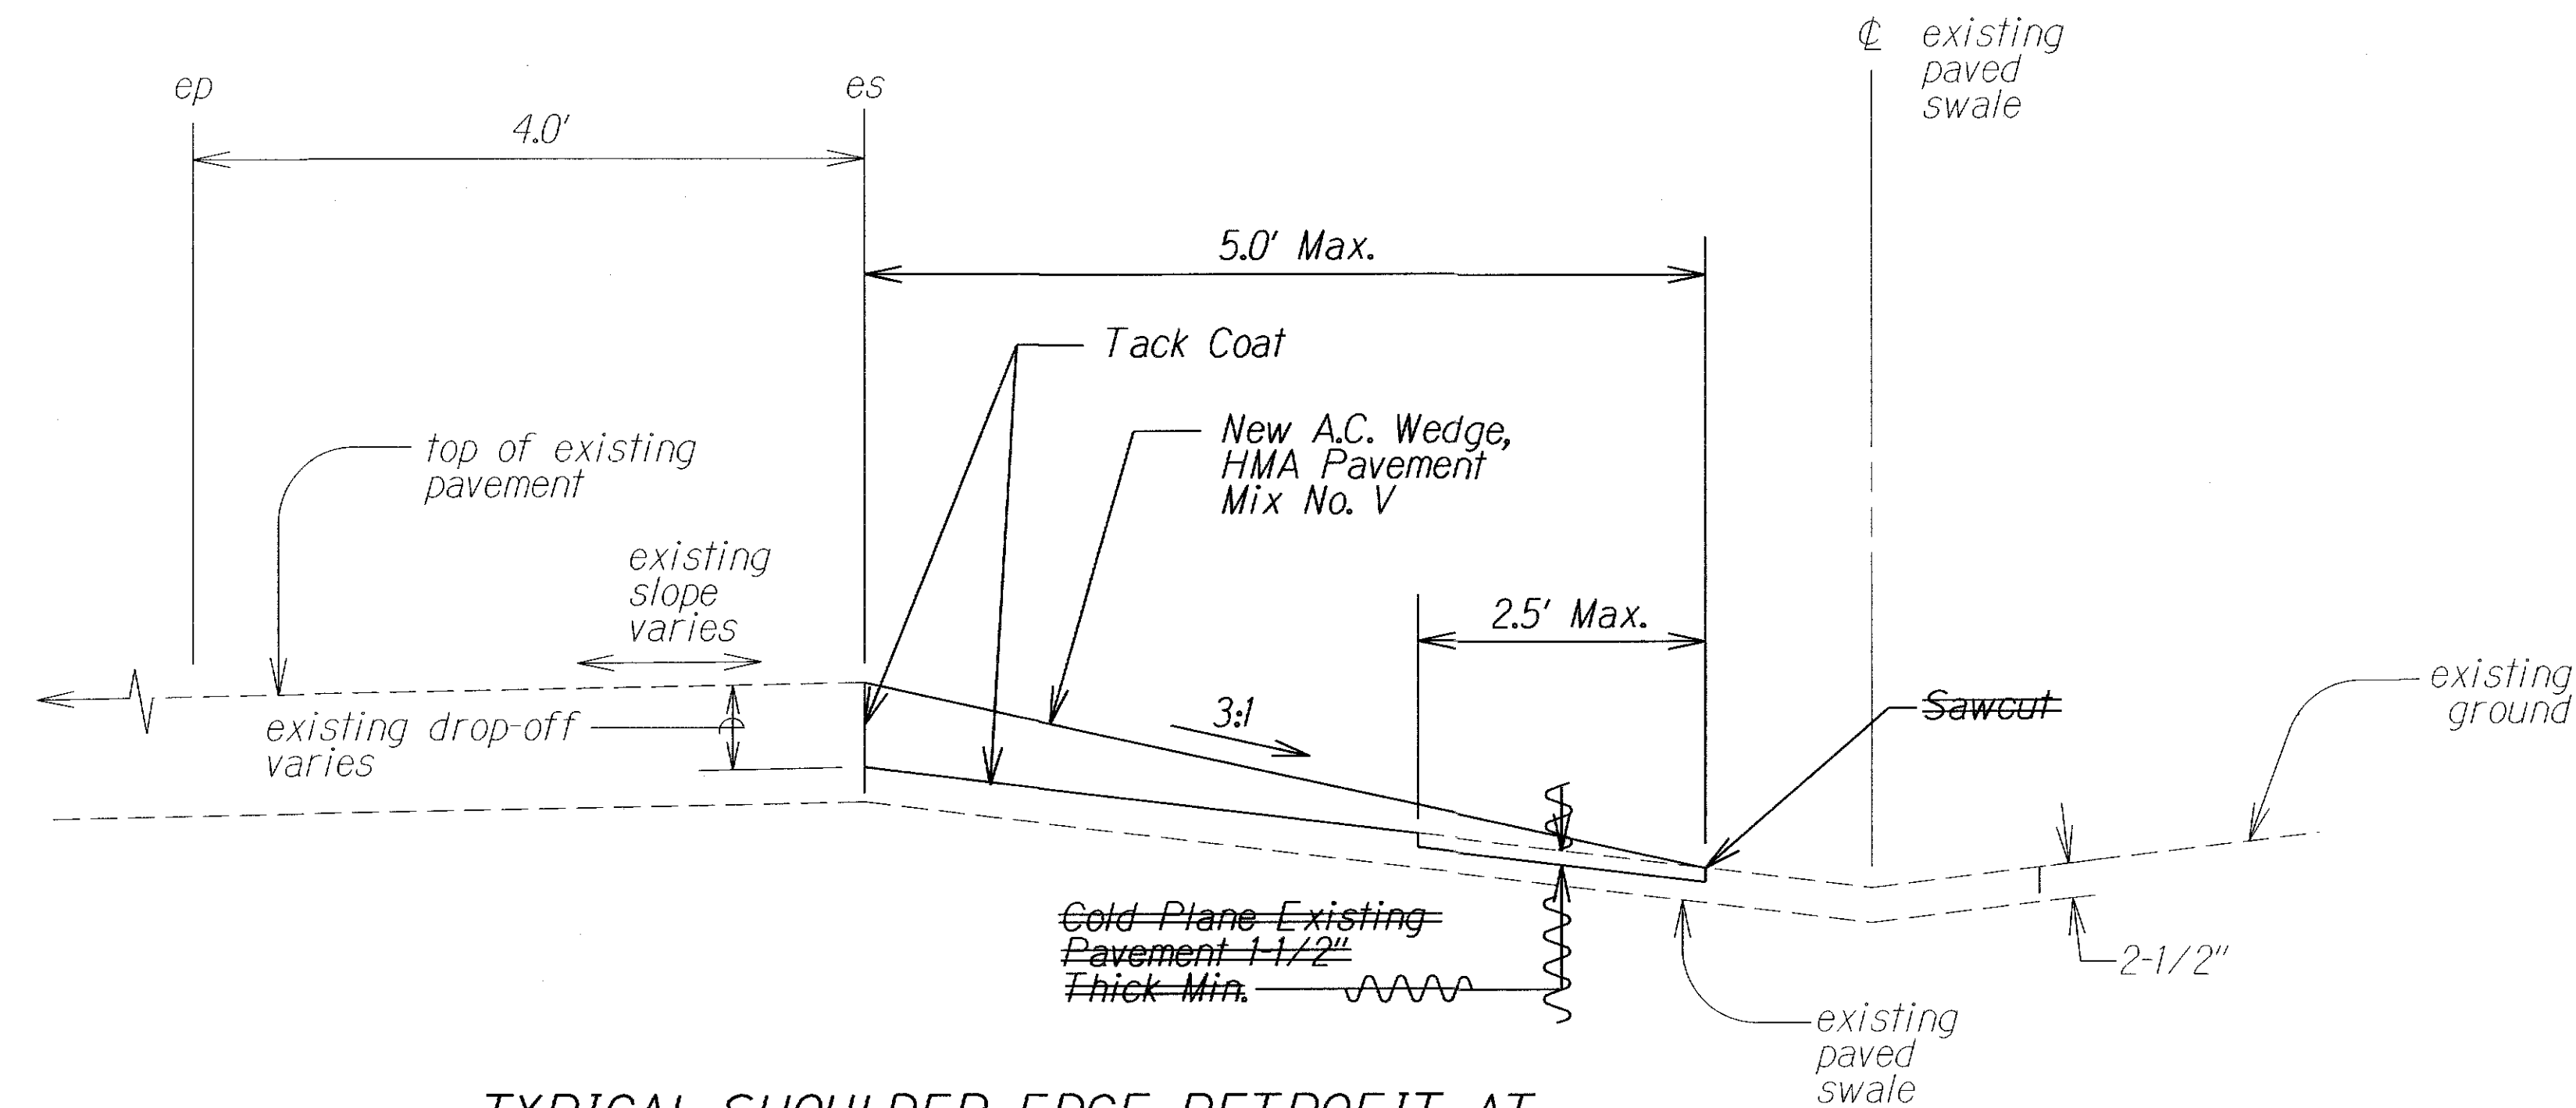

**TYPICAL SHOULDER EDGE RETROFIT AT EXISTING PAVED SWALE DETAIL**  
(For limits, see plan sheet no. 13 & 14.)  
Not to Scale

**Notes:**

- The Contractor shall clean and devegetate asphalt surface prior to installing New A.C. Wedge. This work shall be considered incidental to HMA Pavement Mix No. V.
- Shoulder dressing shall be paid for under item no. 203.1000 Borrow Excavated Material.
- ~~Prior to placement of any fill, the existing ground shall be scarified to a depth of six inches and compacted to a minimum of 90 percent compaction as determined by AASHTO T-100. This work shall be considered incidental to Borrow Excavated Material.~~
- For carpet grass installation refer to Special Provisions Section 641 - Hydro-mulch Seeding.
- Carpet grass sod shall be allowed to grow at a nursery for 4 months.
- The Contractor shall be solely responsible for eradicating all fireweed (senecio madagascariensis) as a result of carpet grass use.
- The Contractor shall be solely responsible for the complete removal and damages resulting from planting any plant species listed on the Hawaii Department of Agriculture "Noxious Weed Rules" as defined in the statute, Hawaii Administrative Rules 4-68.1 or the "Federal Noxious Weed List" as defined in Title 7 of the Code of Federal Regulations (CFR), parts 360 and 361.

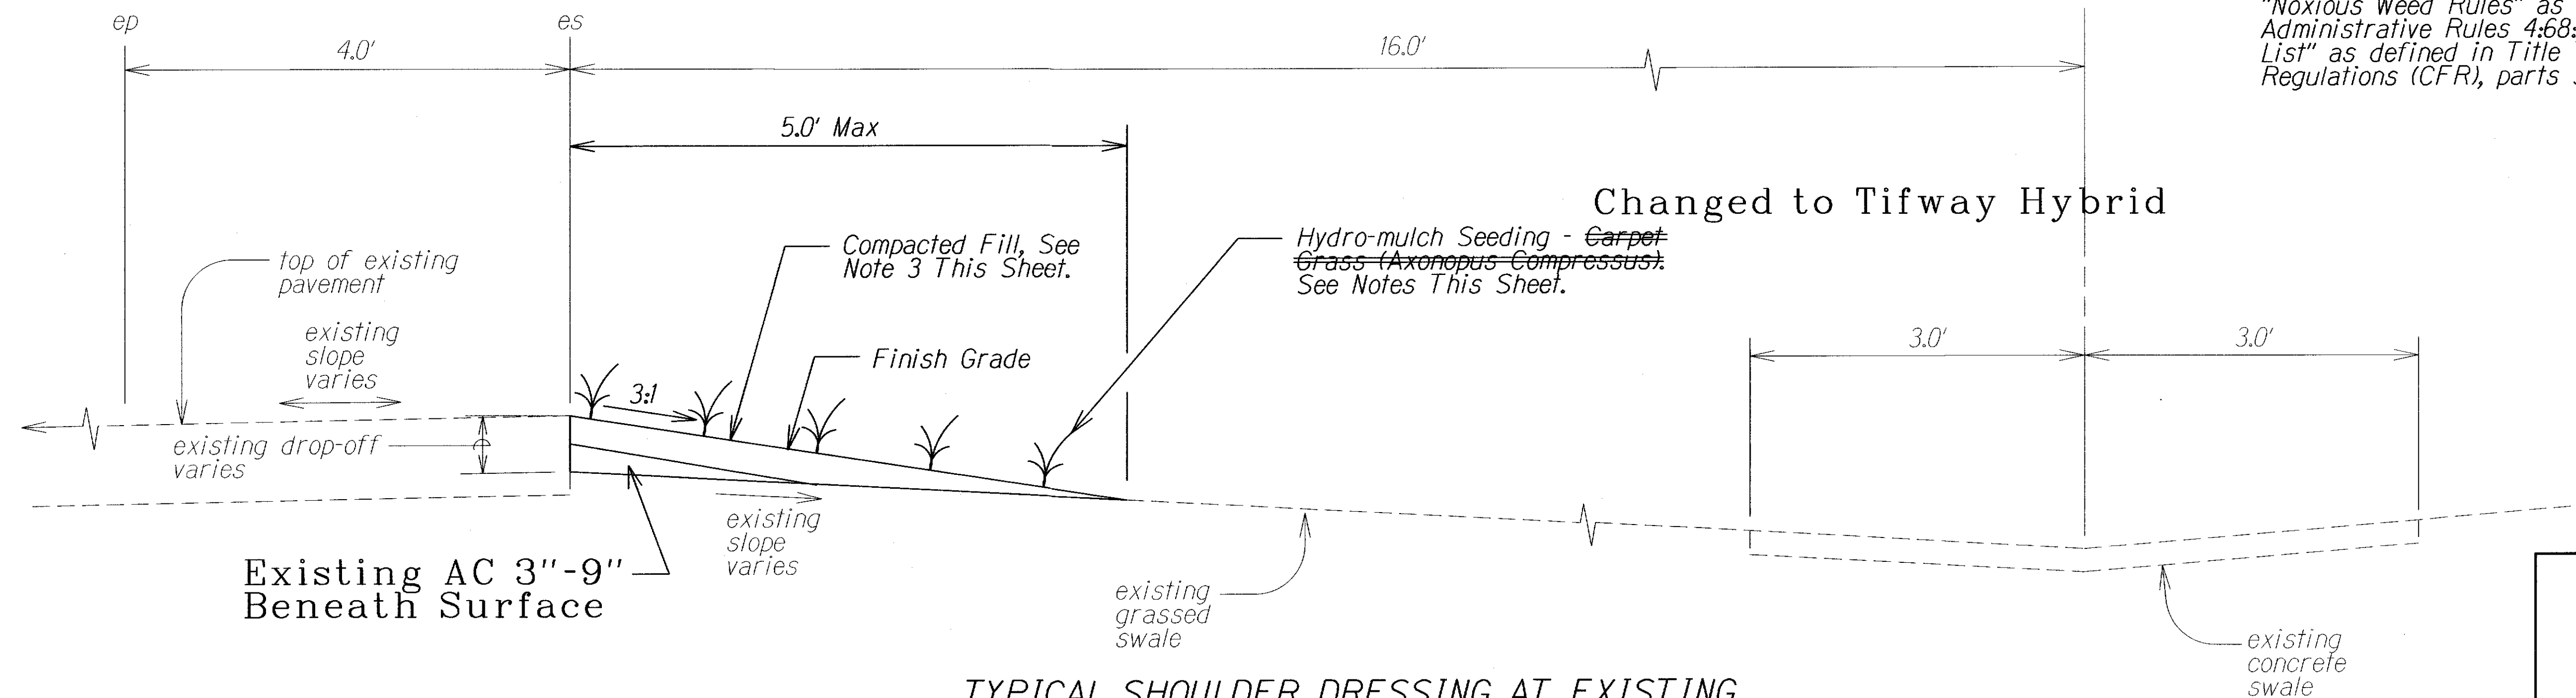

Existing AC 3"-9" Beneath Surface

**TYPICAL SHOULDER DRESSING AT EXISTING GRASSED SWALE DETAIL**  
(For limits, see plan sheet no. 15, 16, 17, & 18.)  
Not to Scale

LEGEND FOR AS-BUILT POSTINGS	
	Squiggly line for as-built deletion
	Double line for as-built deletion
Roadway	Text for as-built posting

STATE OF HAWAII DEPARTMENT OF TRANSPORTATION HIGHWAYS DIVISION	
<b>TYPICAL DETAILS</b>	
INTERSTATE ROUTE H-3 SAFETY IMPROVEMENTS Halekolu Interchange to Kaneohe Marine Corps Base Hawaii Federal Aid Project No. HSIP-H3-1(081)	
Scale: Not to Scale	Date: Aug, 2013
SHEET No. 1 OF 1 SHEETS	