
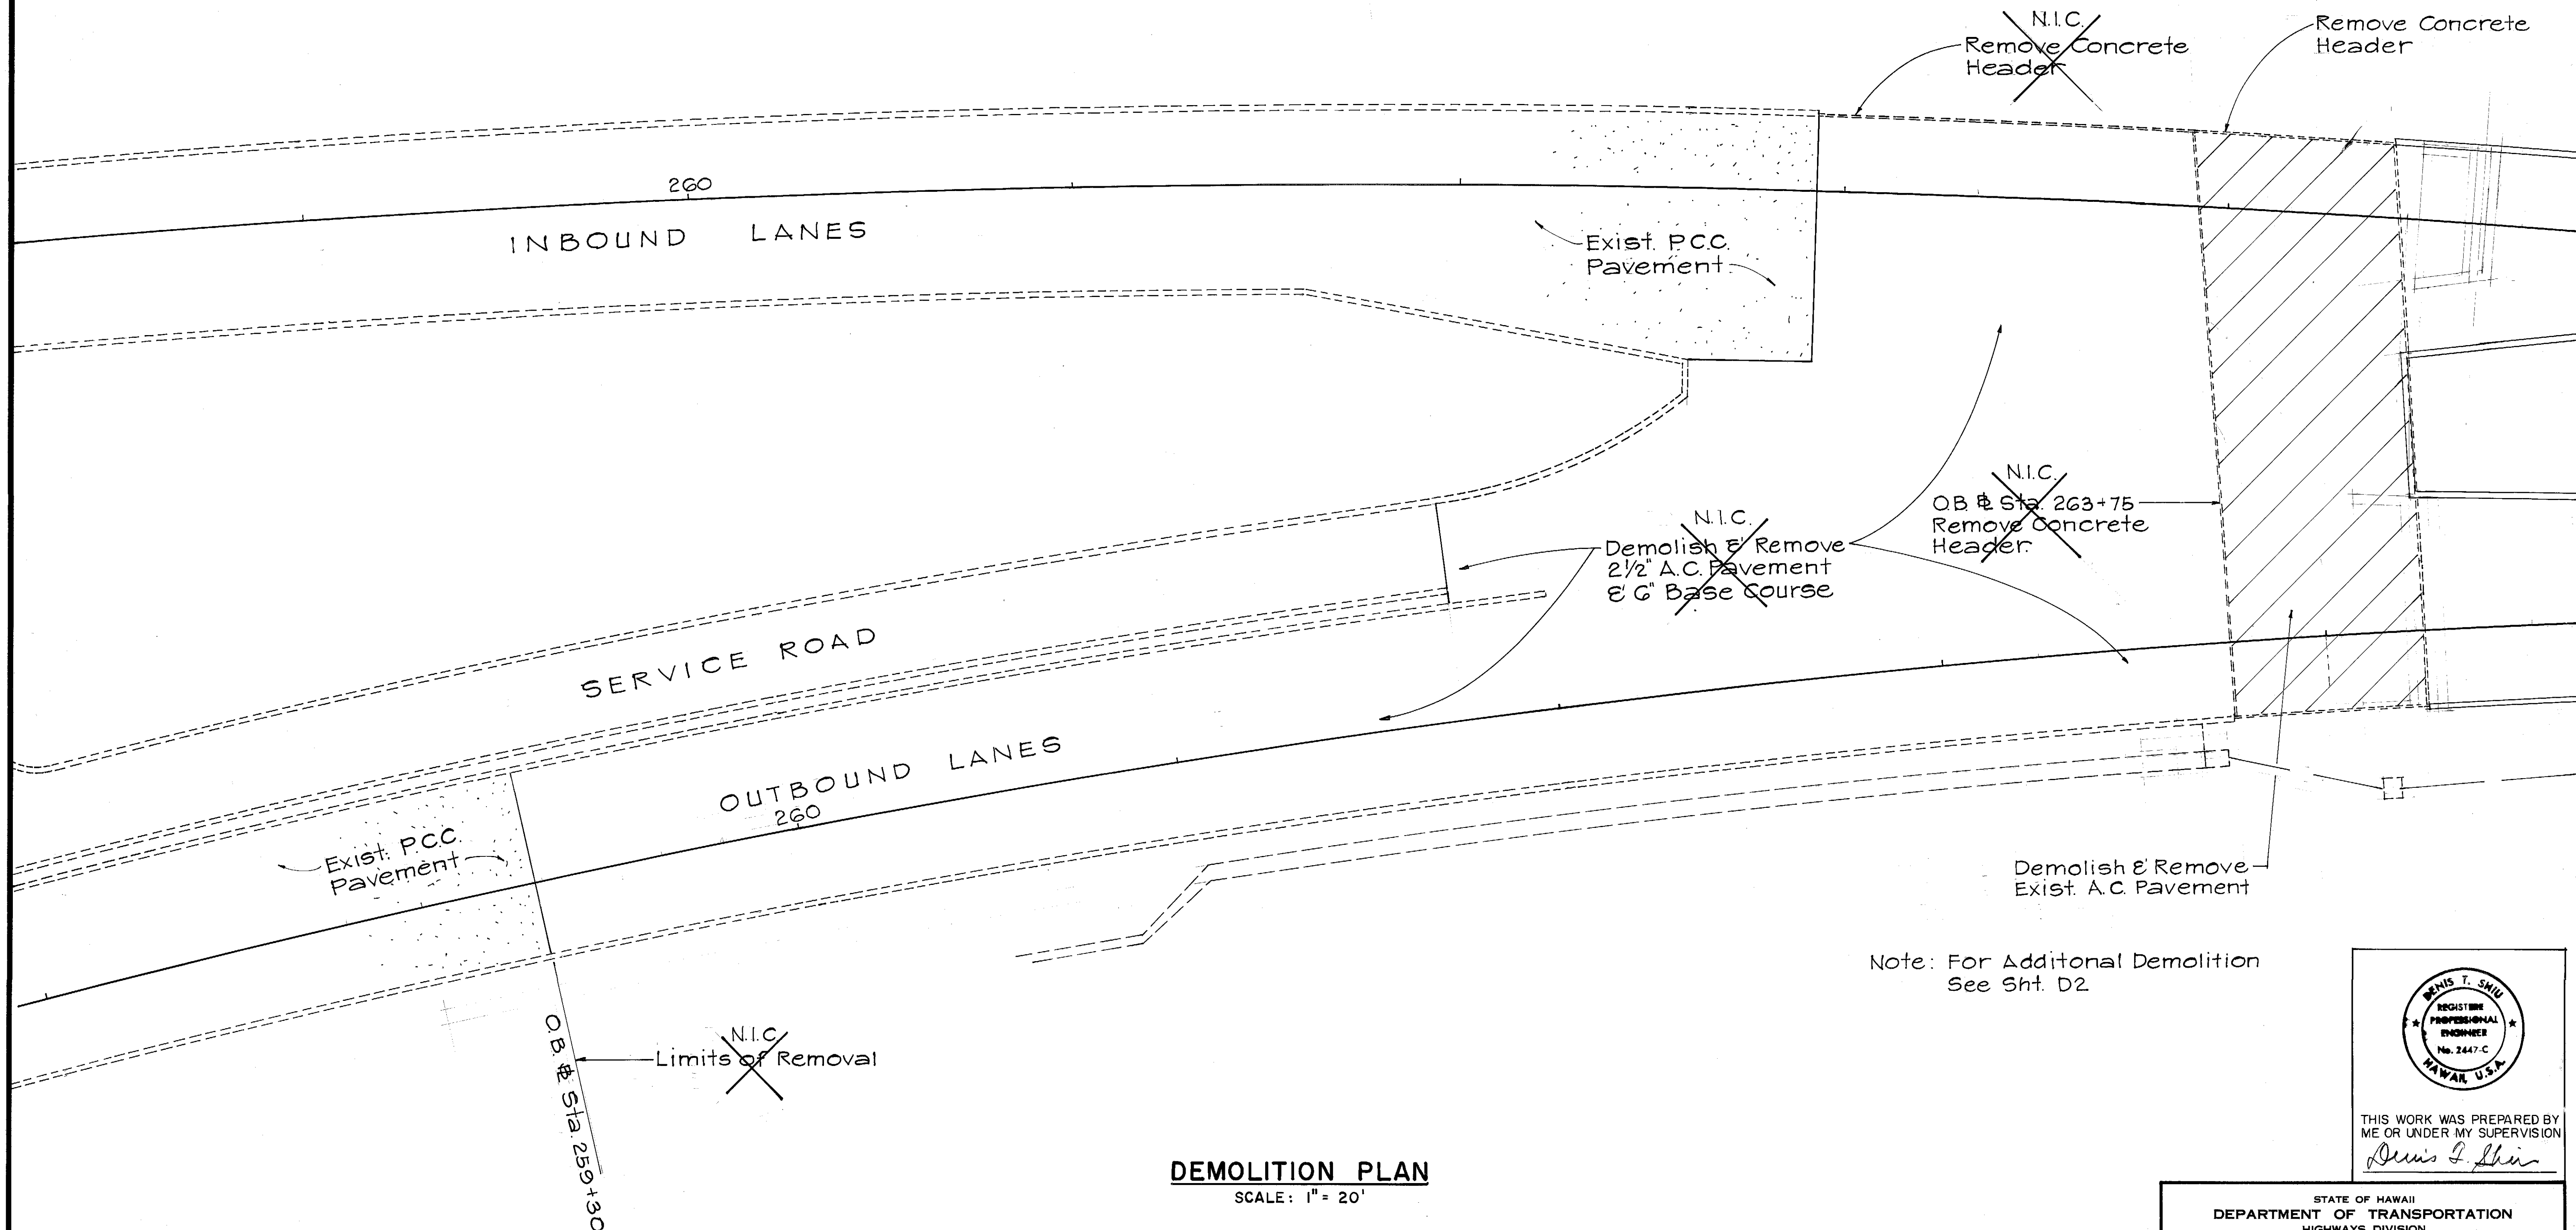



FED. ROAD DIST. NO.	STATE	FED. AID PROJ. NO.	FISCAL YEAR	SHEET NO.	TOTAL SHEETS
HAWAII	HAW.	I-H3-1(57)	1988	25	274

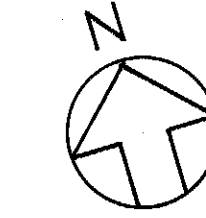

SURVEY PLOTTED BY	DATE
DRAWN BY	
TRACED BY	
QUANTITIES BY	
CHECKED BY	
ORIGINAL PLAN	
NOTE BOOK	
No.	

**DEMOLITION PLAN**  
SCALE: 1" = 20'

Note: For Additional Demolition See Sht. D2

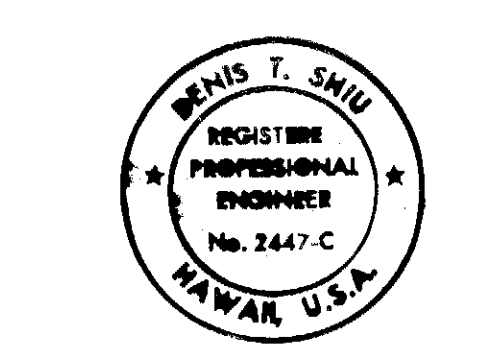

THIS WORK WAS PREPARED BY ME OR UNDER MY SUPERVISION  
*Dennis T. Shiu*

STATE OF HAWAII  
DEPARTMENT OF TRANSPORTATION  
HIGHWAYS DIVISION

**DEMOLITION PLAN**

INTERSTATE ROUTE H-3  
F.A.I. PROJECT NO. I-H3-1(57)  
F.A.I. PROJECT NO. I-H3-1(58)  
SCALE: AS NOTED DATE: SEPT. 1988  
SHEET No. H15 OF 18 SHEETS

DATE	REVISION