



| FED. ROAD DIST. NO. | STATE | FED. AID PROJ. NO. | FISCAL YEAR | SHEET NO. | TOTAL SHEETS |
|---------------------|-------|--------------------|-------------|-----------|--------------|
| HAWAII              | HAW.  | I- H3 - I (57)     | 1988        | 36        | 274          |

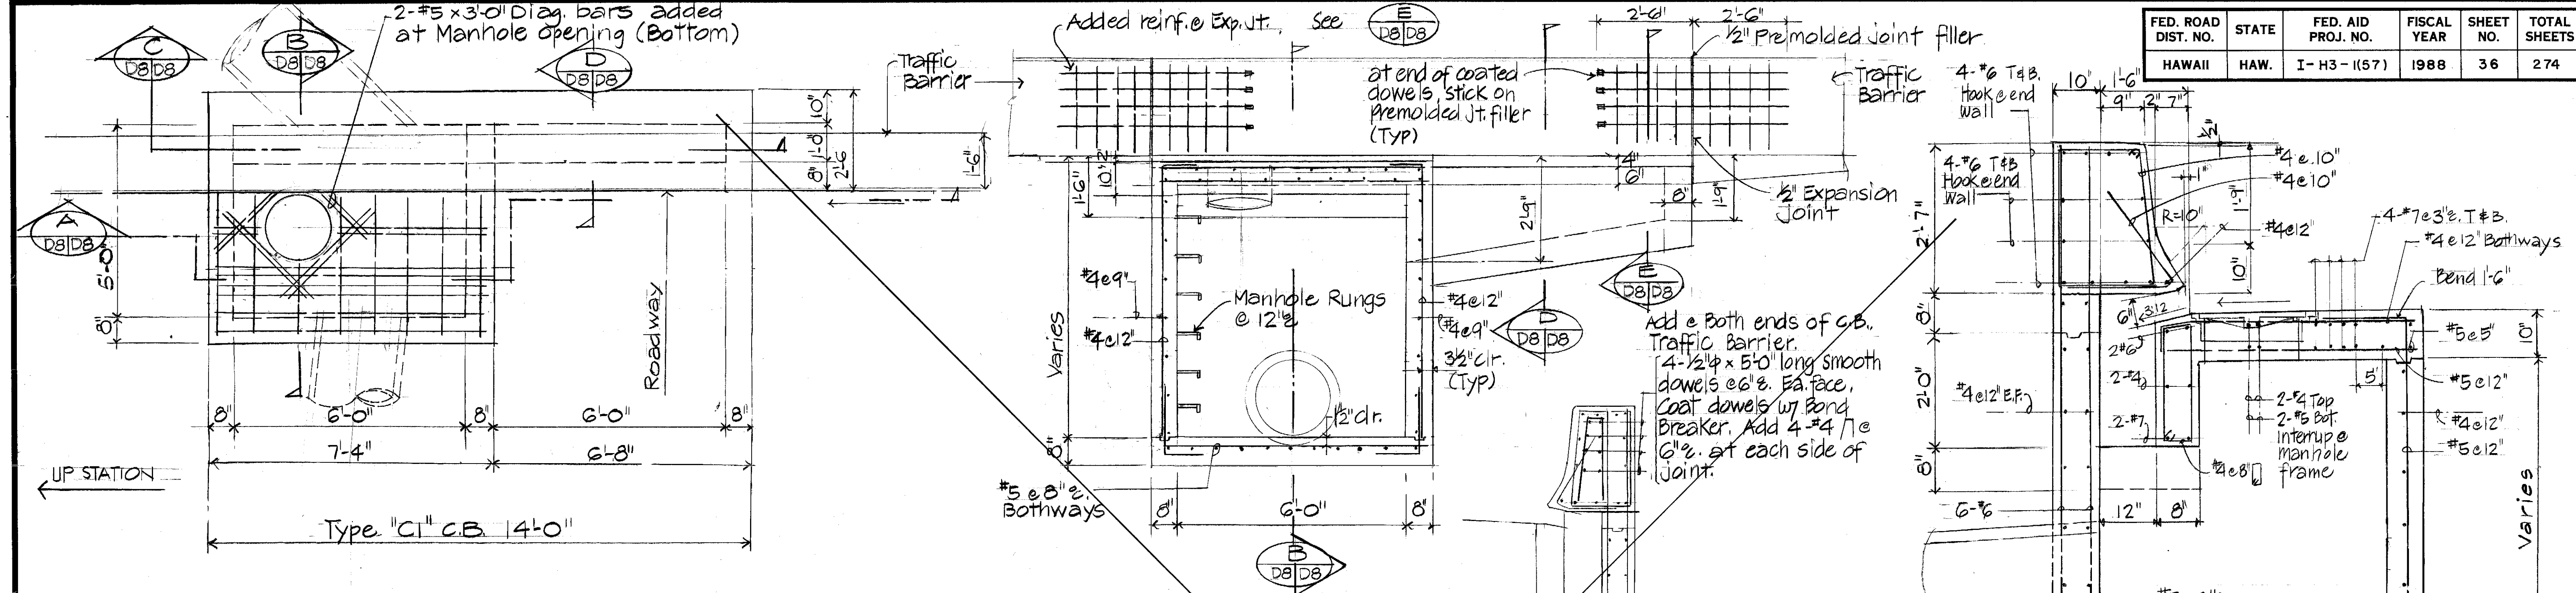


PLAN VIEW OF REINFORCING STEEL  
SCALE: 1/2" = 1'-0"

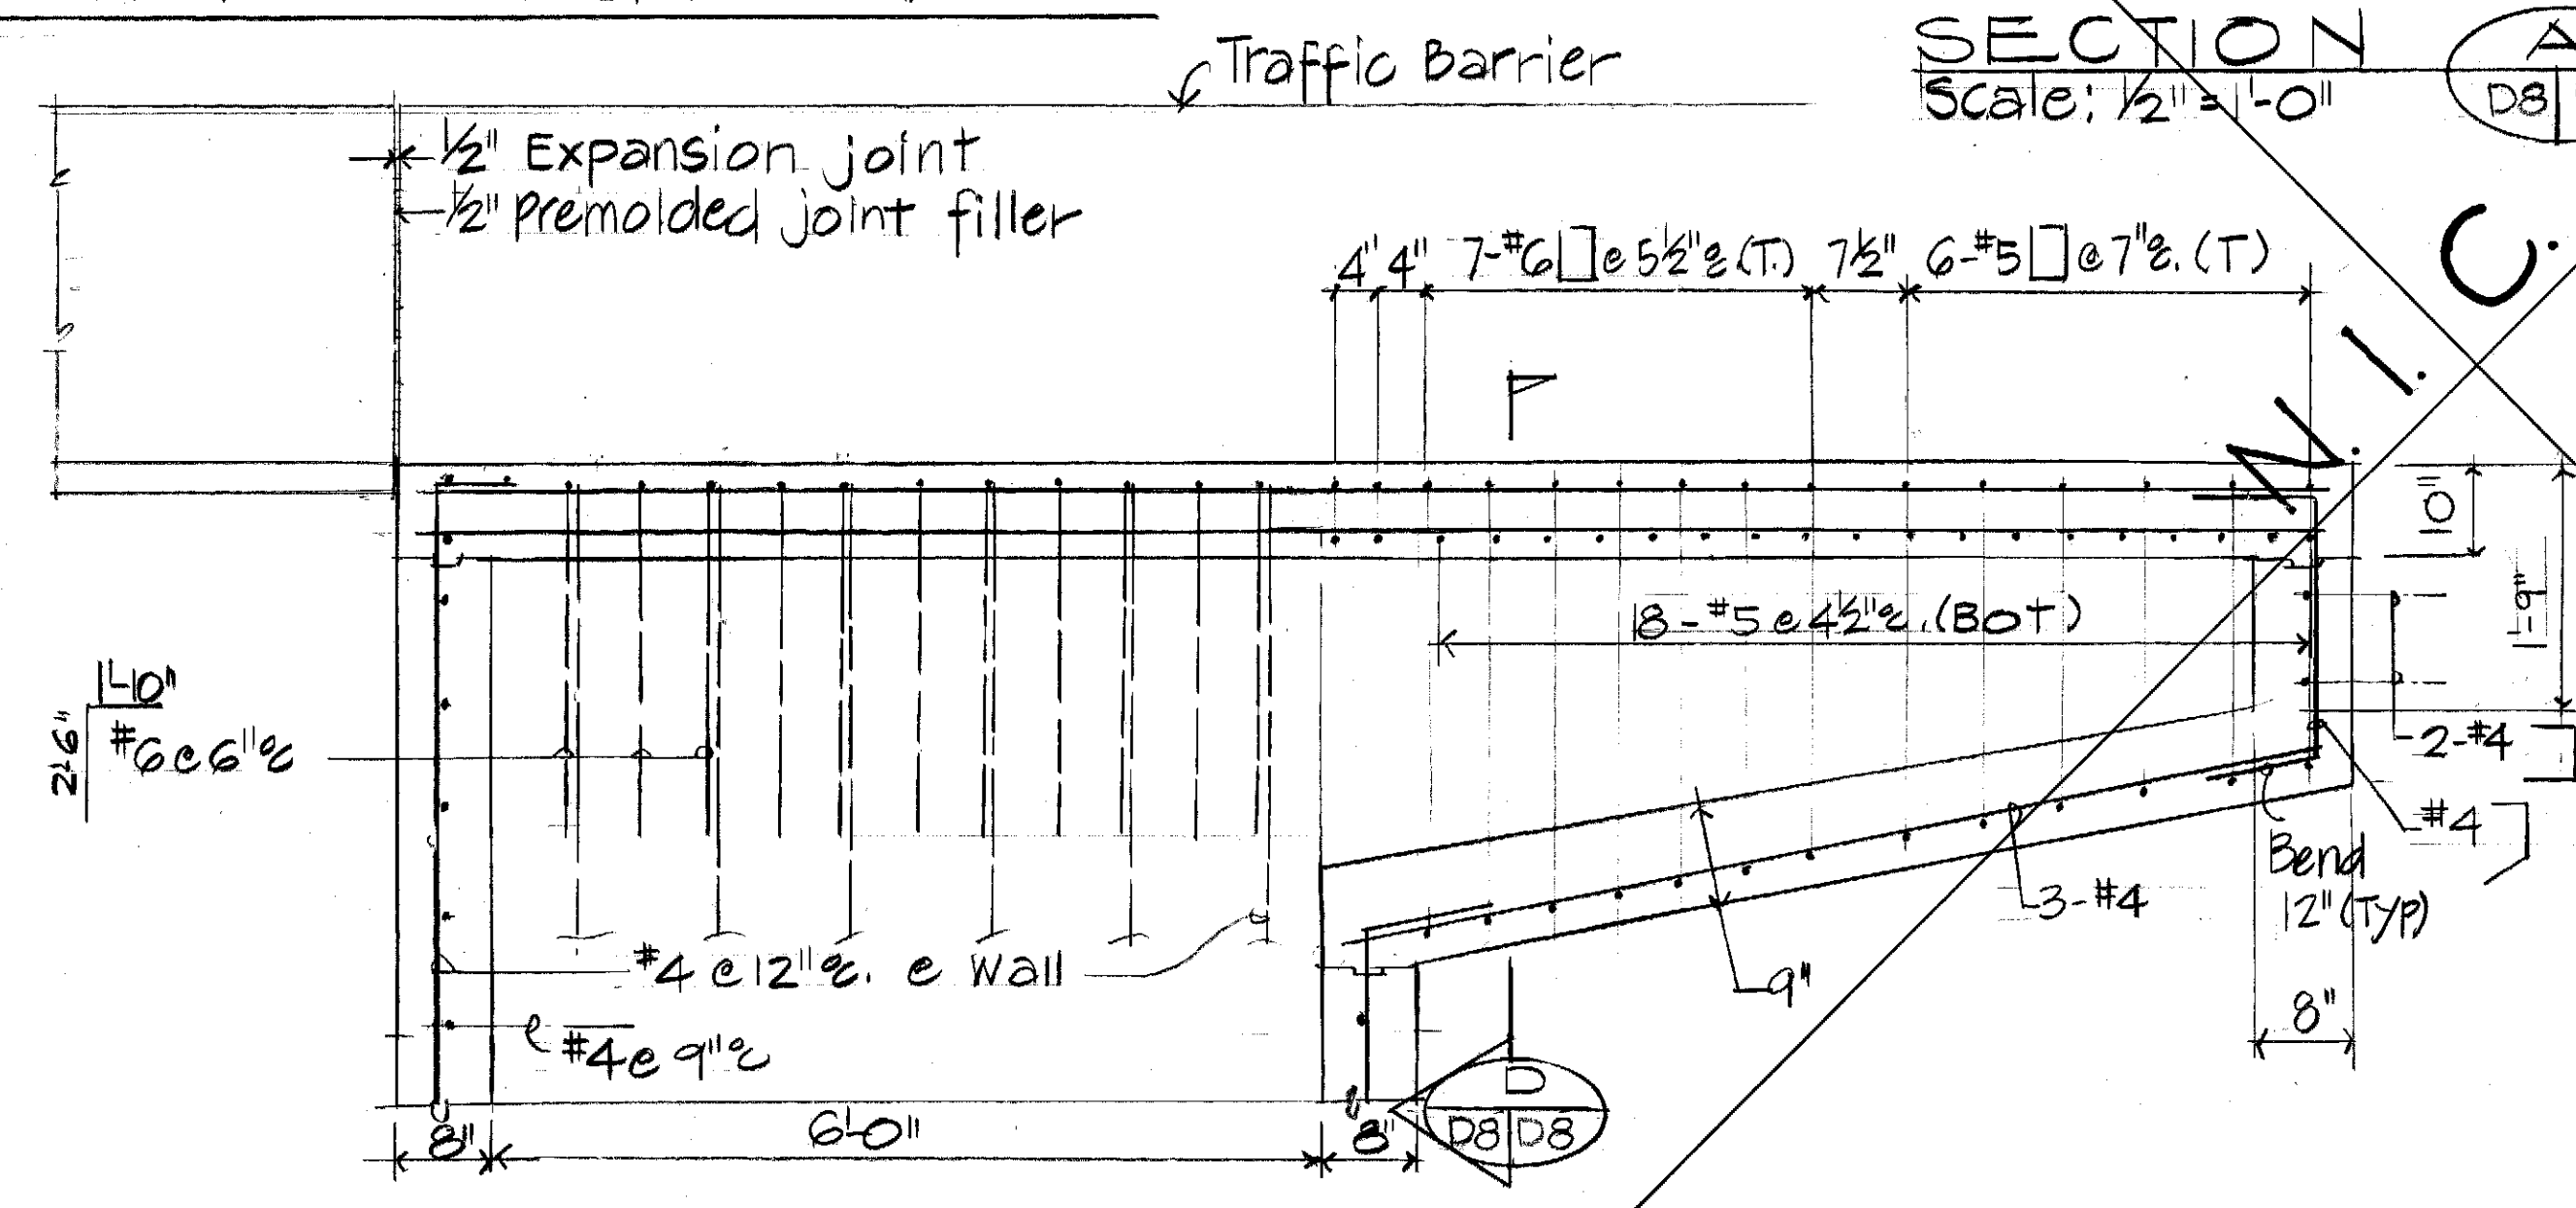


SECTION A-A  
Scale: 3/4" = 1'-0"  
MODIFIED TYPE "C1" CATCH BASIN

- NOTES:
1. Catch Basin Type "C1" to be modified as shown. For balance of Details; also for Manhole Type "A" Cast Iron frame & Cover, Manhole Rungs, see "State of Hawaii, D.O.T. Highways Division" Standard Plan H-02.
  2. Depth of Catch Basin shall be as shown on plan and profile. Finish grade minus culvert invert.
  3. For Culvert location and invert, see Civil Drawings, plan and profile sheets. For added reinforcing at culvert opening, see Standard Details on Standard Plan H-08.

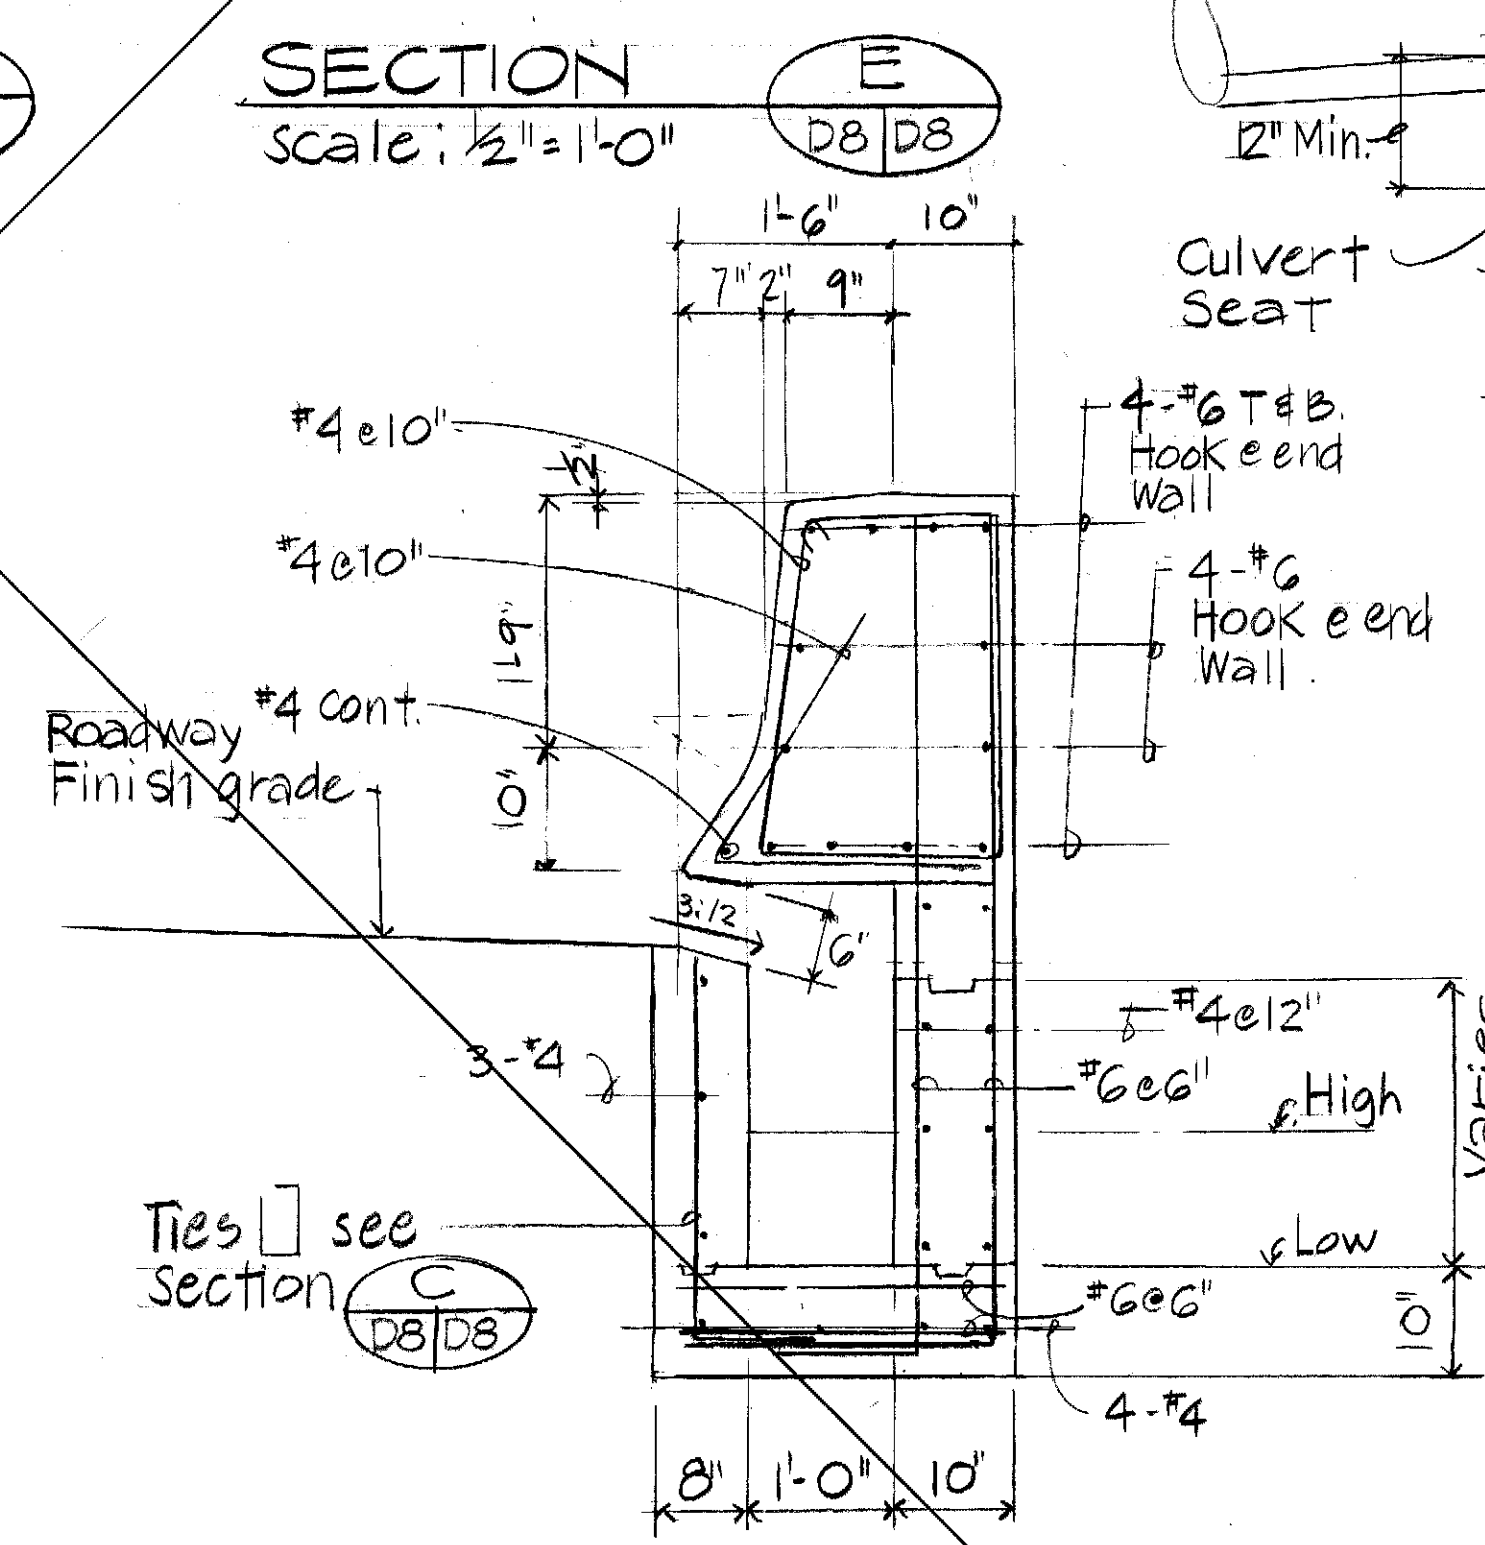

SECTION E-E  
Scale: 3/4" = 1'-0"

SECTION B-B  
Scale: 3/4" = 1'-0"

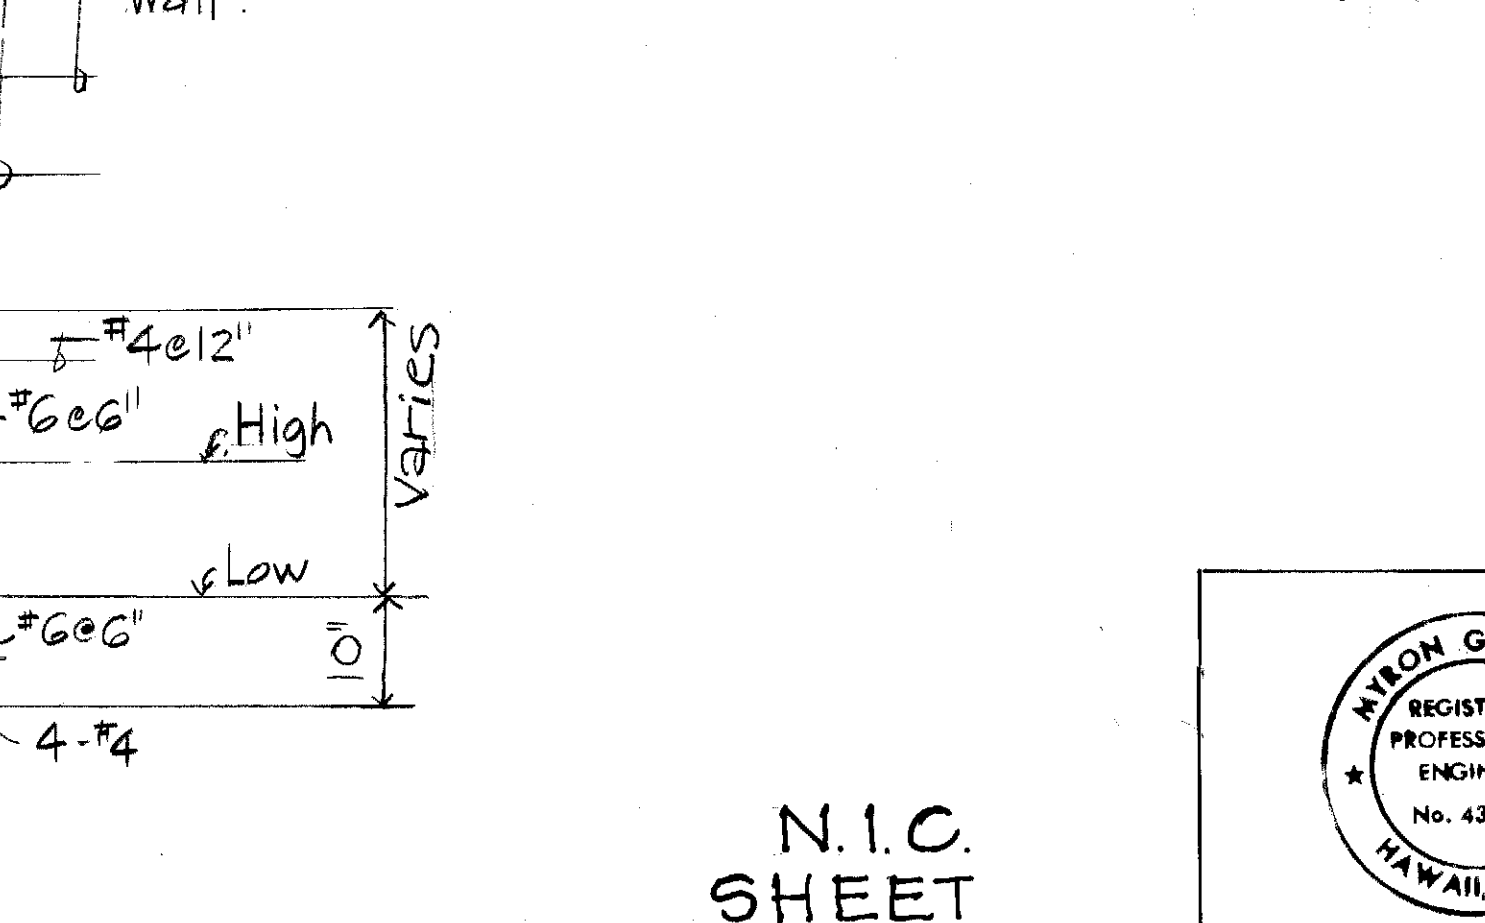

N.I.C. SHEET

WILSON G. OKUNO  
REGISTERED PROFESSIONAL ENGINEER  
No. 4320-S  
HAWAII, U.S.A.

THIS WORK WAS PREPARED BY ME OR UNDER MY SUPERVISION

*Myron Okuno*

STATE OF HAWAII  
DEPARTMENT OF TRANSPORTATION  
HIGHWAYS DIVISION

**MODIFIED TYPE "C1"**  
**CATCH BASIN**

INTERSTATE ROUTE H-3  
F.A.I. PROJECT NO. I-H3-I (57)  
F.A.I. PROJECT NO. I-H3-I (58)  
SCALE: AS NOTED DATE: SEPT. 1988

SHEET NO. D8 OF 9 SHEETS

| DATE | REVISION |
|------|----------|
|      |          |