



FED. ROAD DIST. NO.	STATE	FED. AID PROJ. NO.	FISCAL YEAR	SHEET NO.	TOTAL SHEETS
HAWAII	HAW.	I-H3-1 (57)	1988		

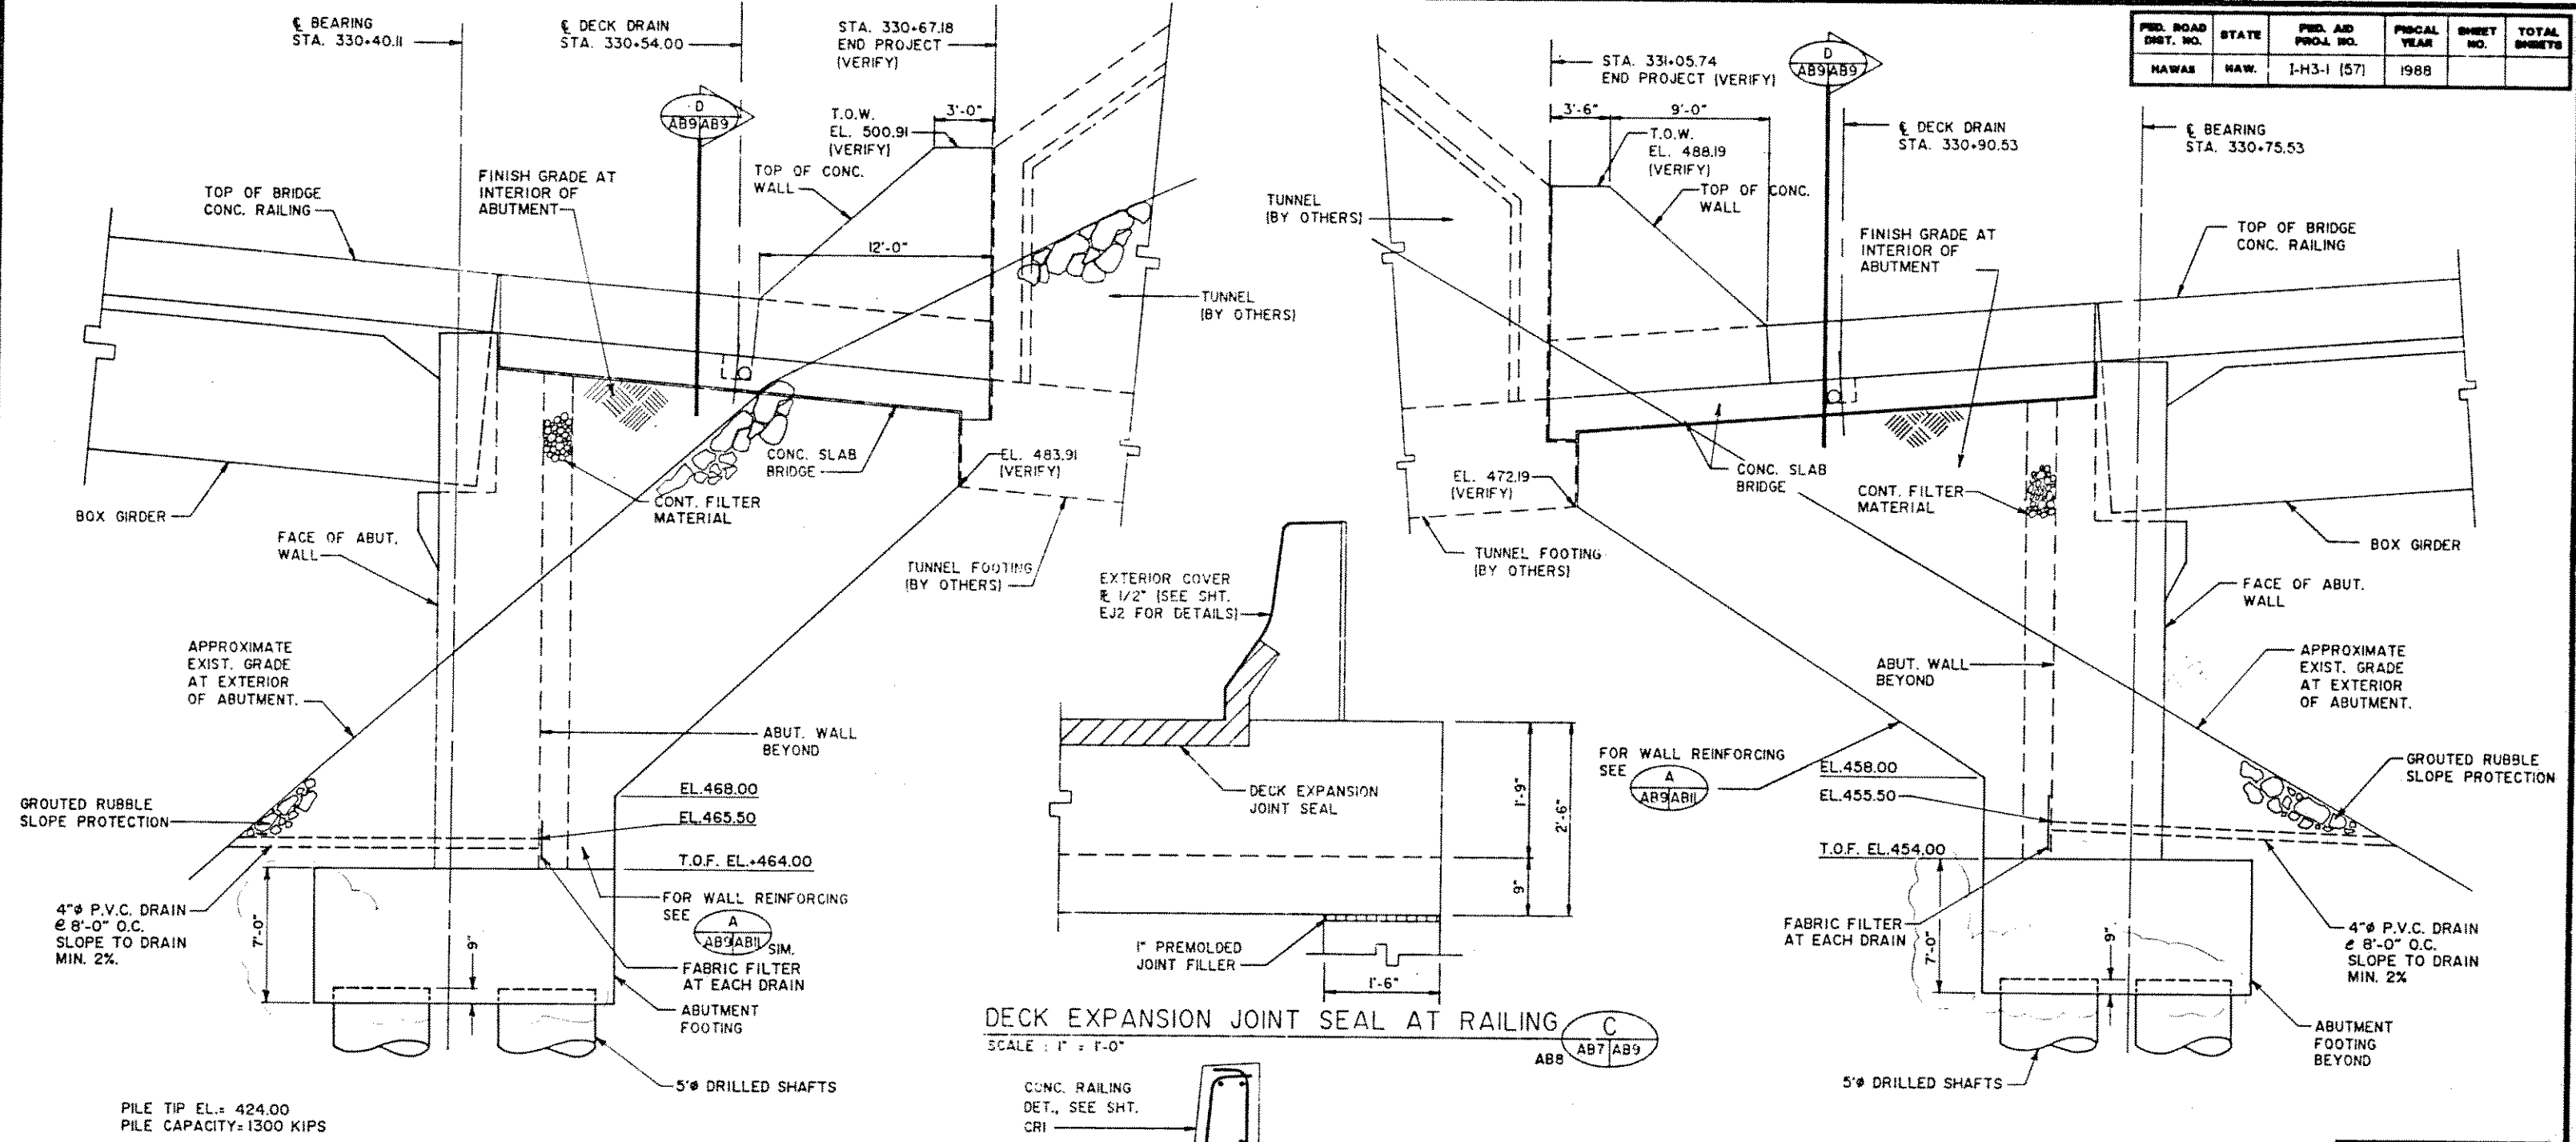

WALL ELEVATION - OUTBOUND
SCALE: 1/4" = 1'-0"

CONTRACTOR SHALL TAKE ADEQUATE PRECAUTIONS TO AVOID DISTURBING EXISTING HOSPITAL ROCK TUNNEL.

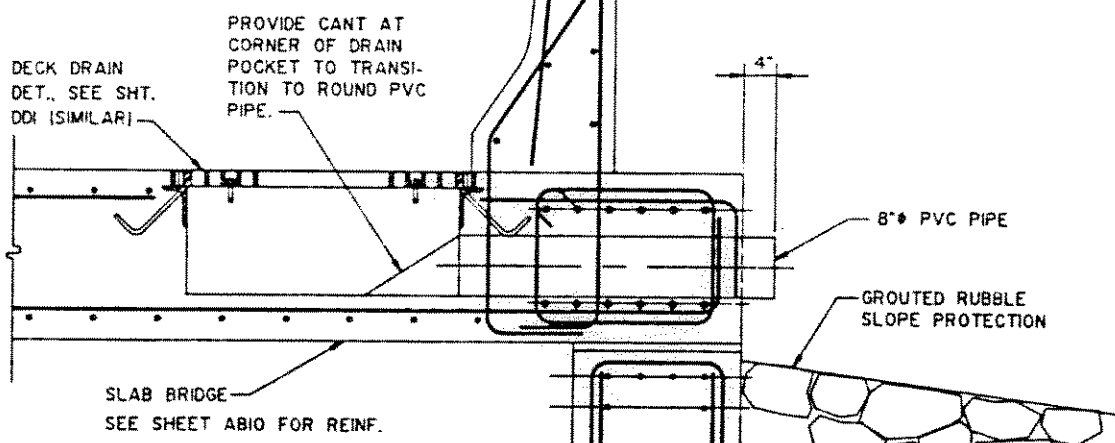

DECK DRAIN AT SLAB BRIDGE
SCALE: 1" = 1'-0"

WALL ELEVATION - INBOUND
SCALE: 1/4" = 1'-0"

THIS WORK WAS PREPARED BY ME OR UNDER MY SUPERVISION

STATE OF HAWAII
DEPARTMENT OF TRANSPORTATION
HIGHWAYS DIVISION
ABUTMENT ELEVATIONS
INBOUND - STA. 330+75.53
OUTBOUND - STA. 330+40.11
INTERSTATE ROUTE H-3
F.A.I. PROJECT NO. I-H3-1 (57)
F.A.I. PROJECT NO. I-H3-1 (58)
SCALE: AS NOTED
DATE: SEPT. 1988
SHEET No. AB9 OF 1 SHEETS

09/30/91 DATE
UPDATED DRAWING. REVISION