

119, 419, & 120

4-0.6"ϕ STRANDS TYP.

1'-0" 1'-0"

20'-0" R




10 3/4" g

1'-0" PI

11" 1'-2"

LONGITUDINAL SECTION

SCALE : 3/4" = 1'-0"

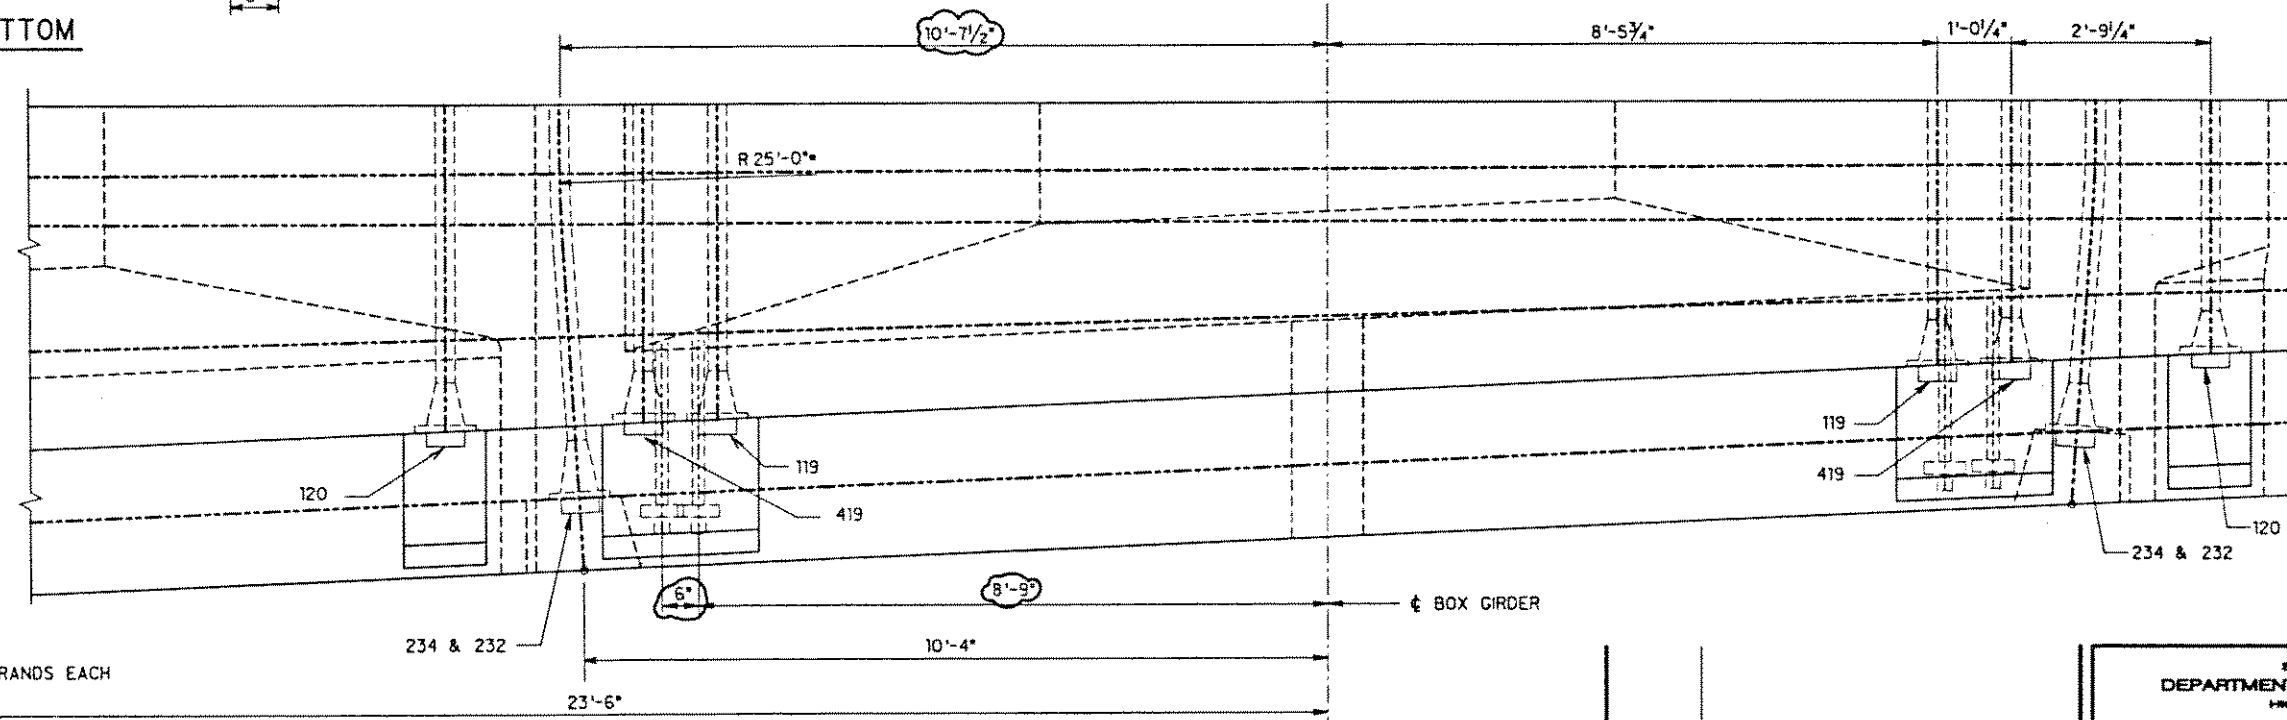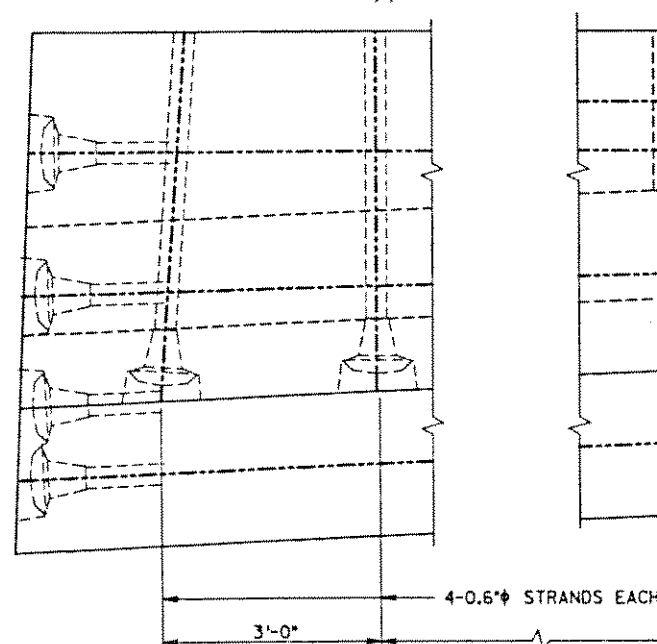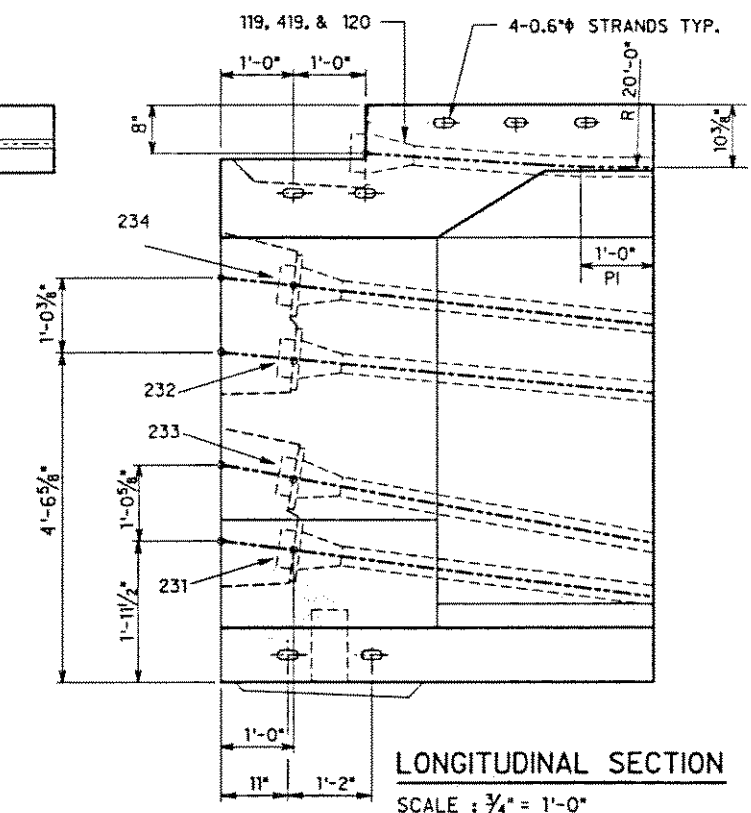

- | | | |
|--|--|--|
| 10/04/90 | UPDATED DRAWING. | |
| DATE | REVISION | |
|  J. MULLER
INTERNATIONAL |  Libby
Engineers | |

STATE OF HAWAII
DEPARTMENT OF TRANSPORTATION
HIGHWAYS DIVISION

ABUTMENT 1 SEGMENT
P.T. DETAILS
OUTBOUND STRUCTURE
INTERSTATE ROUTE H-3
F.A.I. PROJECT No. I-H3-1(57)
F.A.I. PROJECT No. I-H3-1(58)

SCALE : AS NOTED DATE : JUN. 1990

SHEET No. DP15 OF SHEETS

ORIGINAL PLAN	SURVEY PLOTTING BY	DATE
	DRAWN BY	
	TRACED BY	
	DESIGNED BY	
NOTE BOOK	QUANTITIES BY	
	CHECKED BY	