


FED. ROAD DIST. NO.	STATE	FED. AID PROJ. NO.	FISCAL YEAR	SHEET NO.	TOTAL SHEETS
HAWAII	HAW.	I-H3-1(57)	1988		



DESIGNED BY	DATE
DRAWN BY	
CHECKED BY	
NOTED BY	
CONSTRUCTED BY	

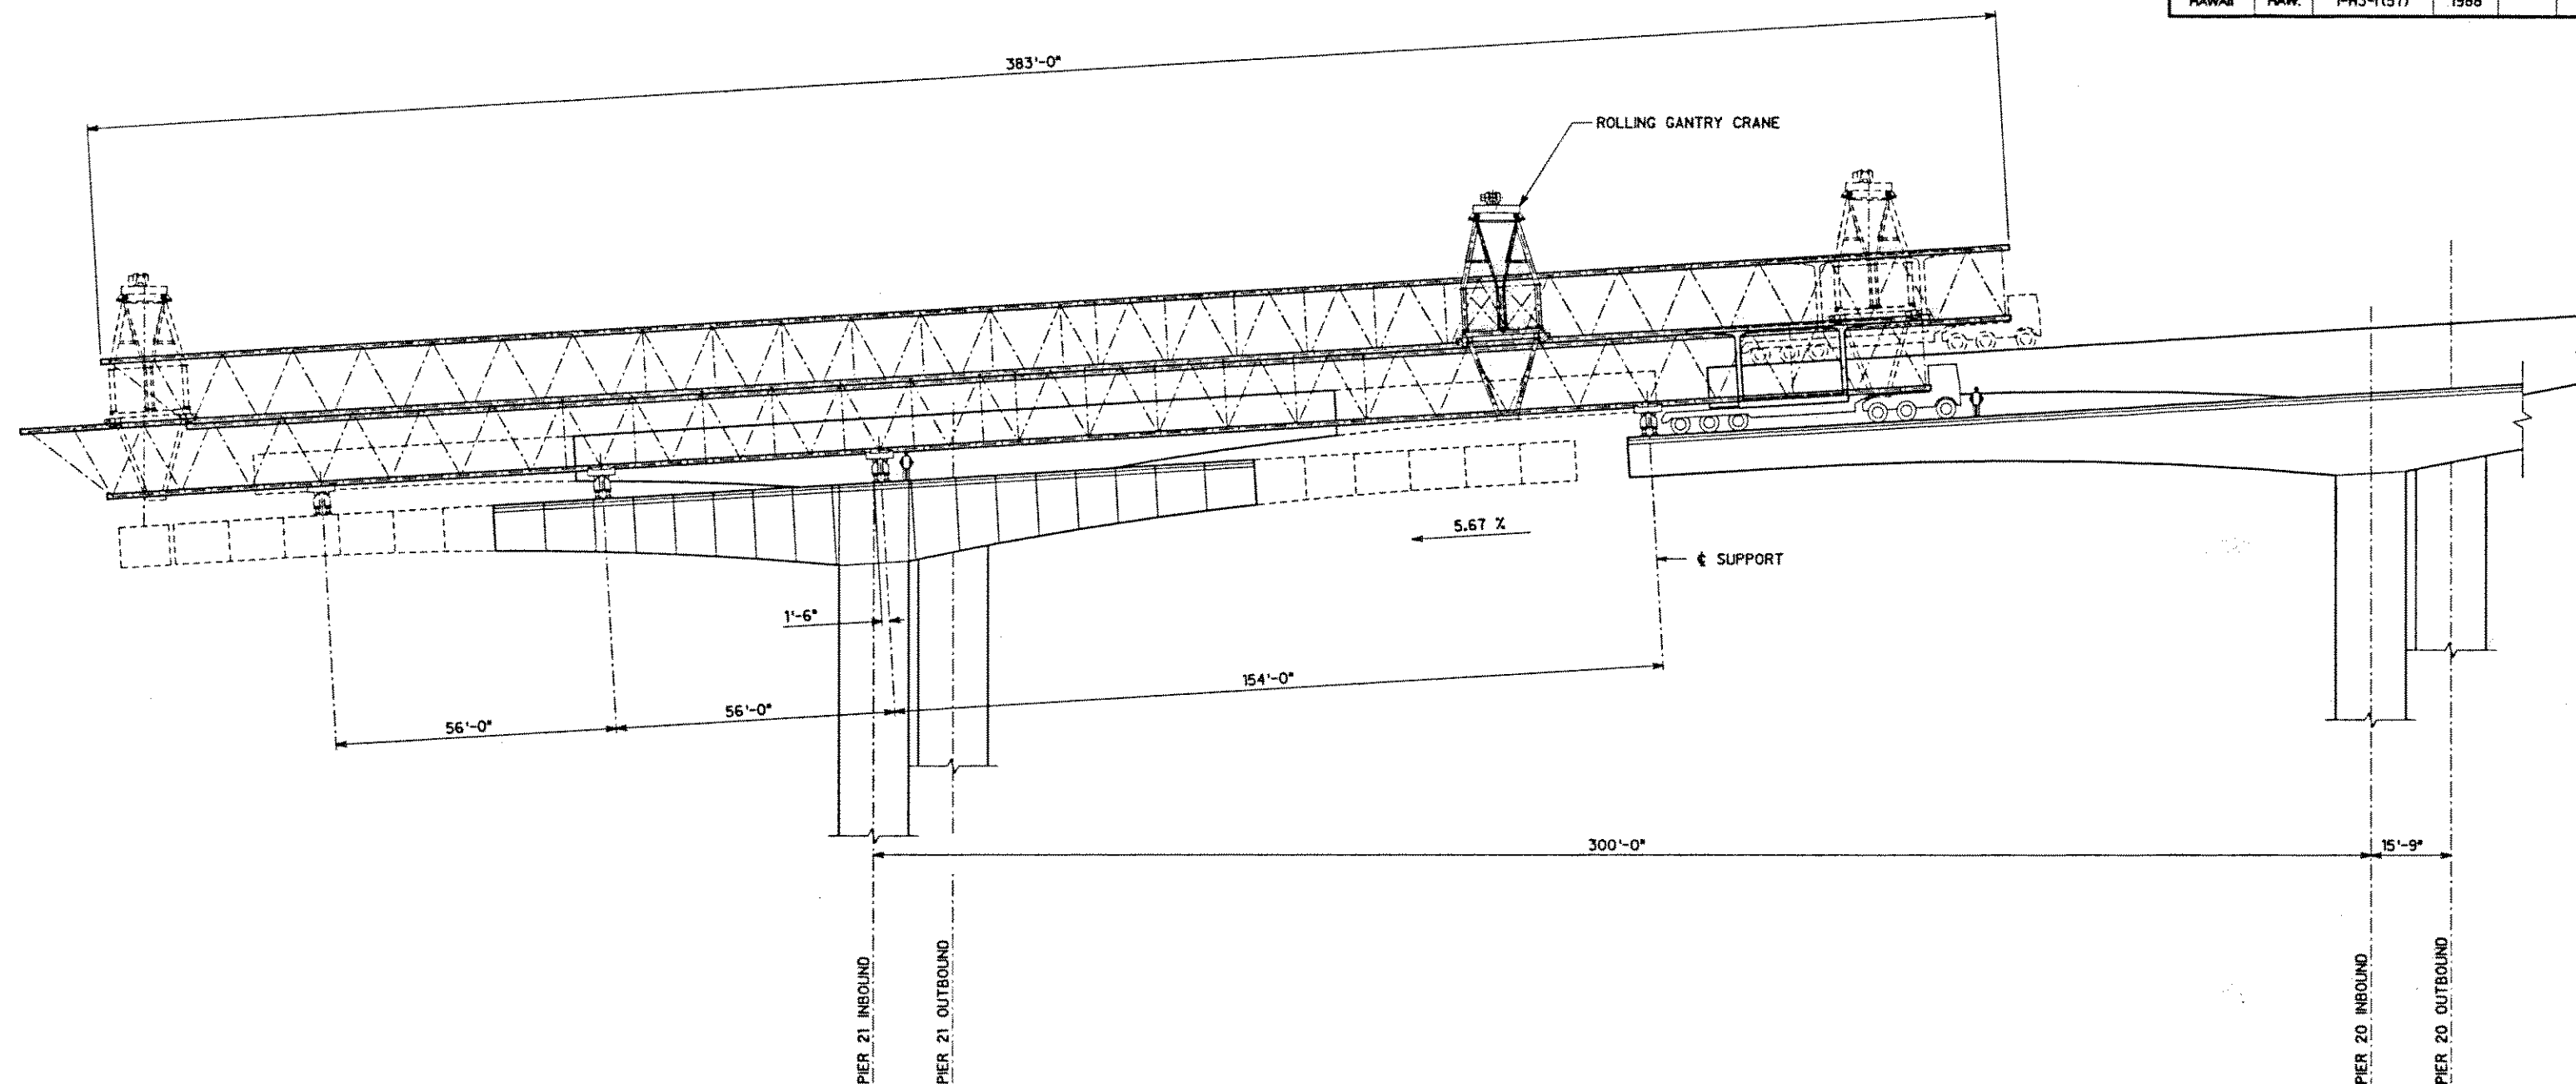

THIS WORK WAS PREPARED BY
ME OR UNDER MY SUPERVISION

DATE	REVISION
J. MULLER INTERNATIONAL	Libby Engineers

STATE OF HAWAII
DEPARTMENT OF TRANSPORTATION
HIGHWAYS DIVISION


ERECTION SCHEMATIC I

INTERSTATE ROUTE H-3
F.A.I. PROJECT No. I-H3-1(57)
F.A.I. PROJECT No. I-H3-1(58)


SCALE: AS NOTED DATE: JUN. 1990

SHEET No. CM1 OF SHEETS

FED. ROAD DIST. NO.	STATE	FED. AID PROJ. NO.	FISCAL YEAR	SHEET NO.	TOTAL SHEETS
HAWAII	HAW.	I-H3-1 (57)	1988		

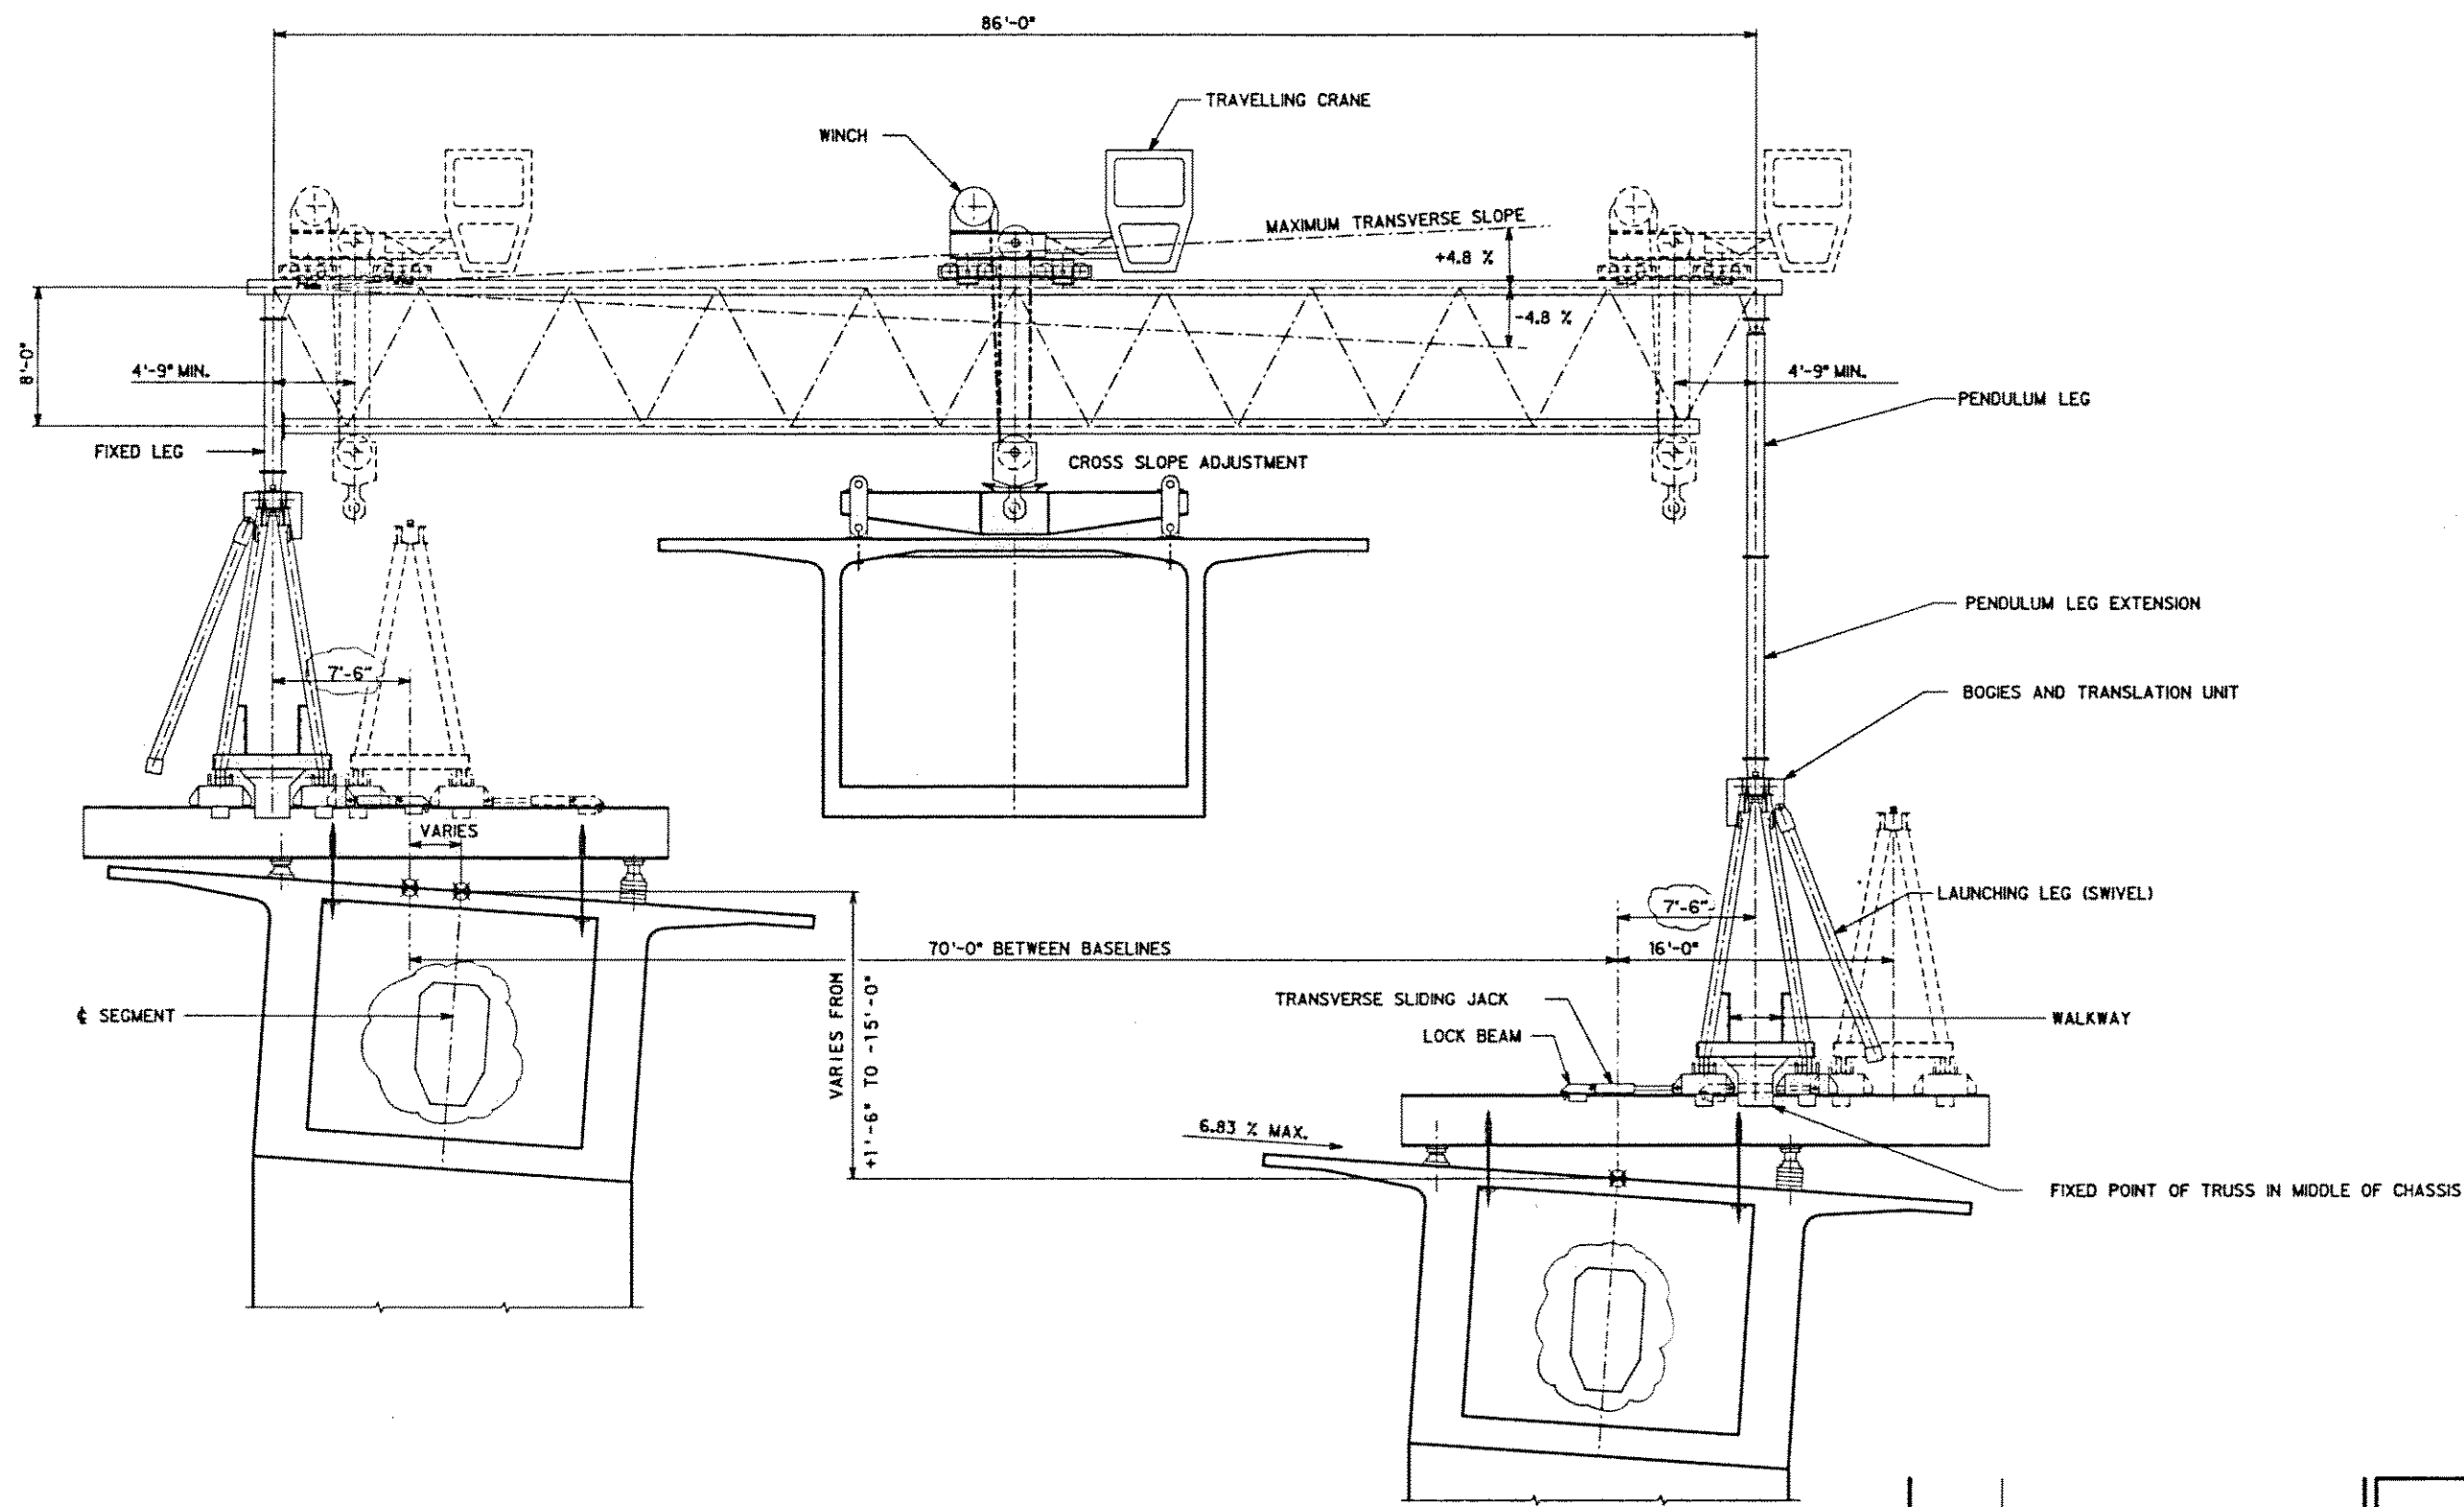

DESIGNED BY	DATE
DRAWN BY	
CHECKED BY	
NOTED BY	
QUANTITY BY	
PLANNED BY	

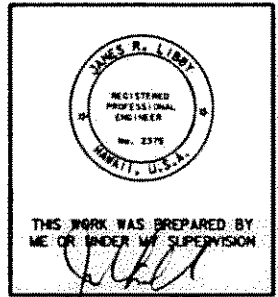

STATE OF HAWAII

DEPARTMENT OF TRANSPORTATION

HIGHWAYS DIVISION

ERECTION SCHEMATIC II

INTERSTATE ROUTE H-3

F.A.J. PROJECT No. I-H3-1(57)

F.A.J. PROJECT No. I-H3-1(58)

SCALE : AS NOTED

DATE : JUN. 1990

08/23/91

UPDATED DRAWING.

DATE

REVISION


J. MULLER INTERNATIONAL

Libby Engineers


SHEET No. CM2 OF

SHEETS


FED. ROAD DIST. NO.	STATE	FED. AID PROJ. NO.	FISCAL YEAR	SHEET NO.	TOTAL SHEETS
HAWAII	HAW.	I-H3-1(57)	1988		

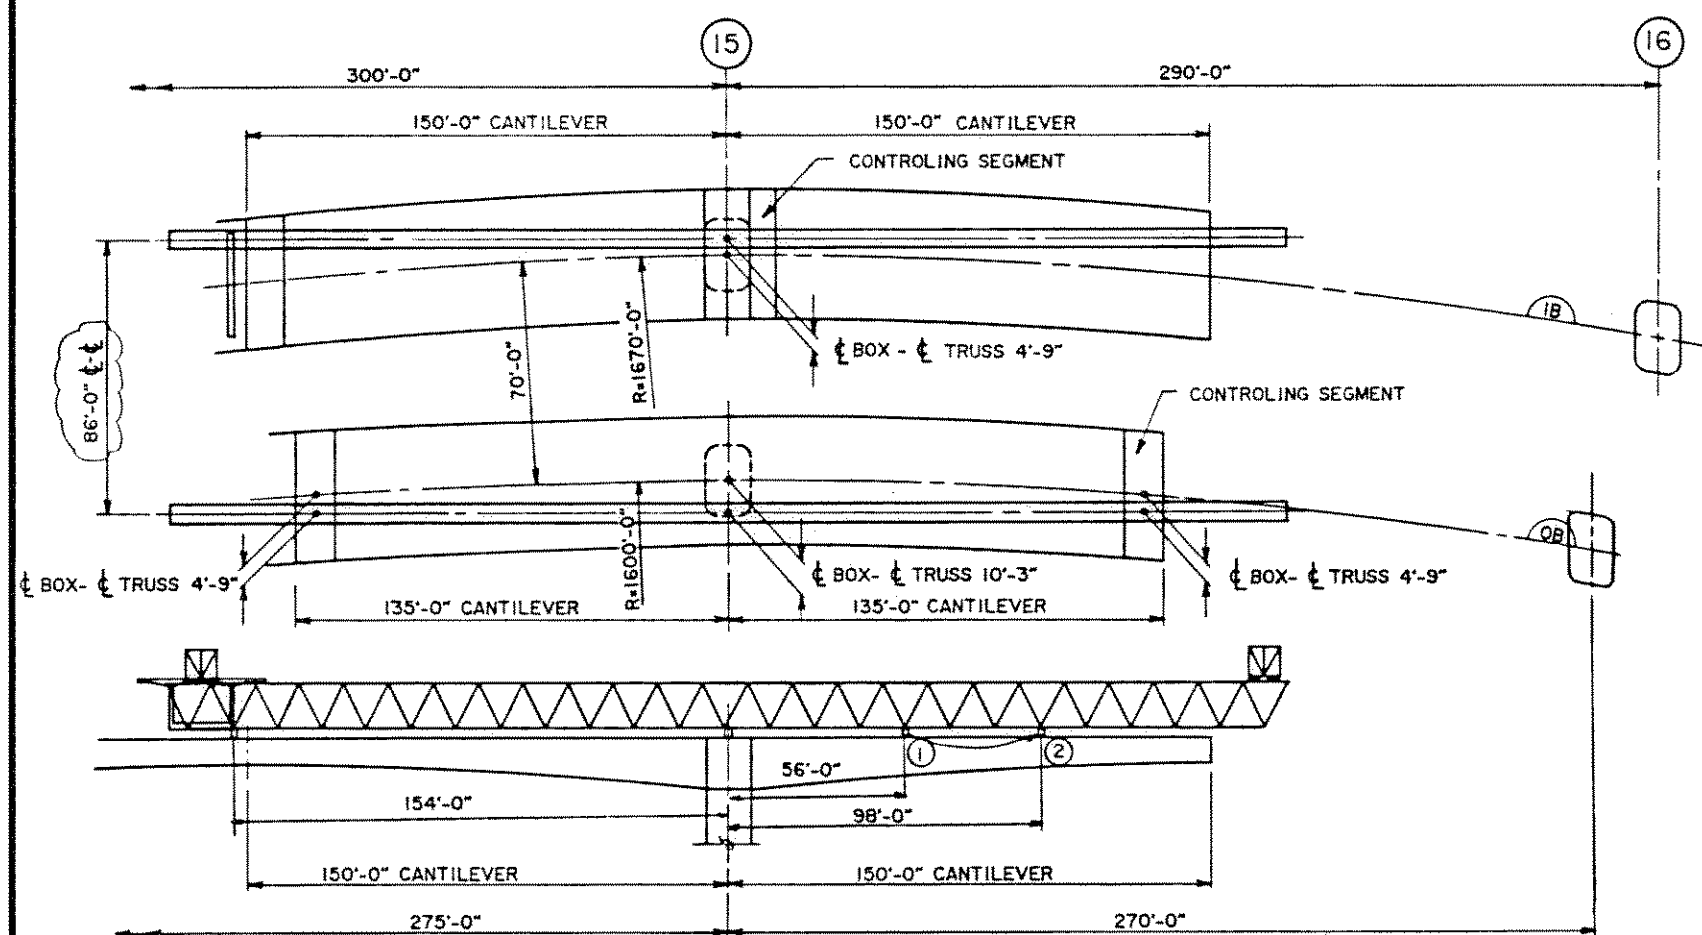

① PLACING SEGMENTS

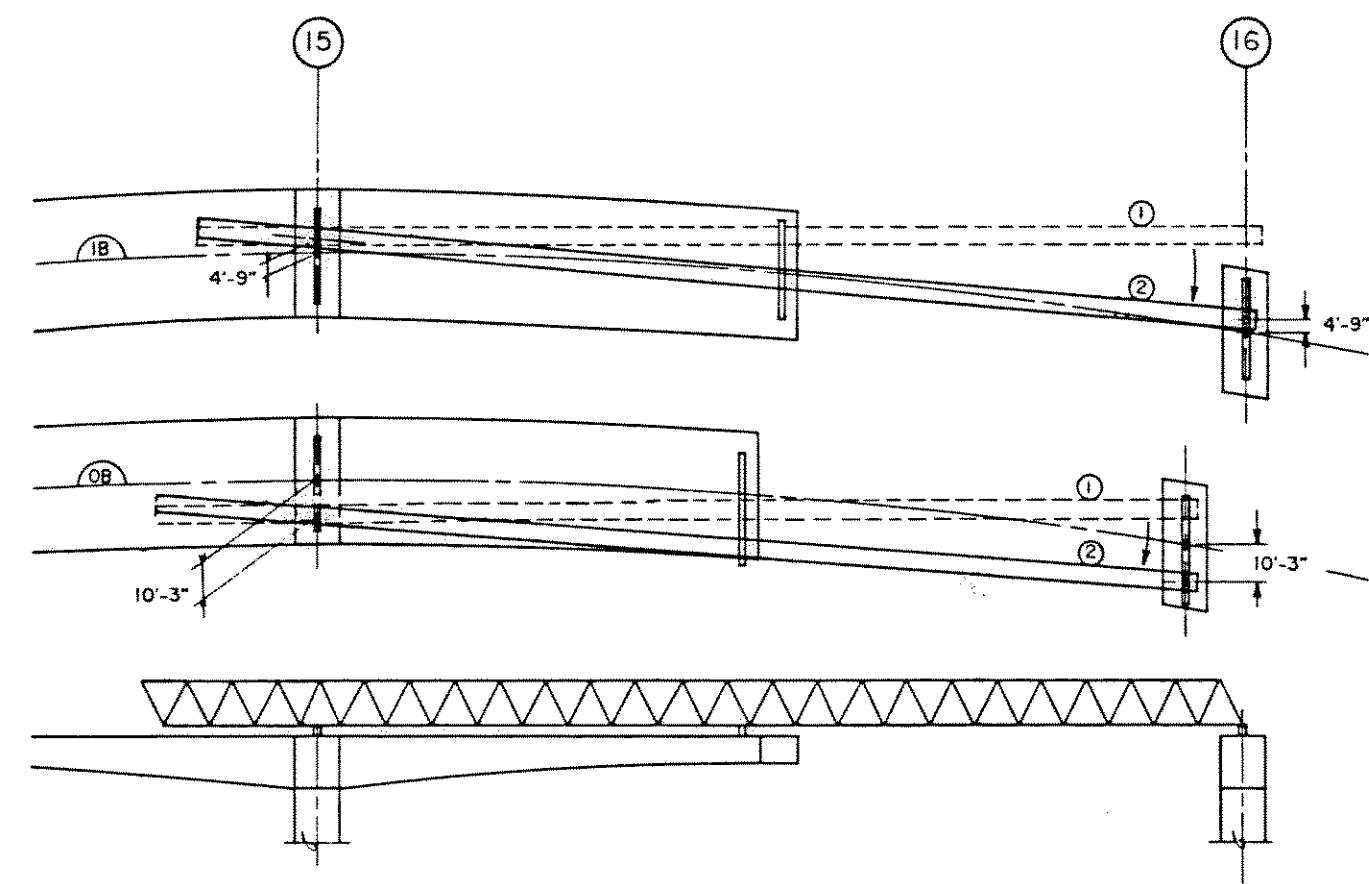


② LAUNCHING TRUSSES - PHASE I

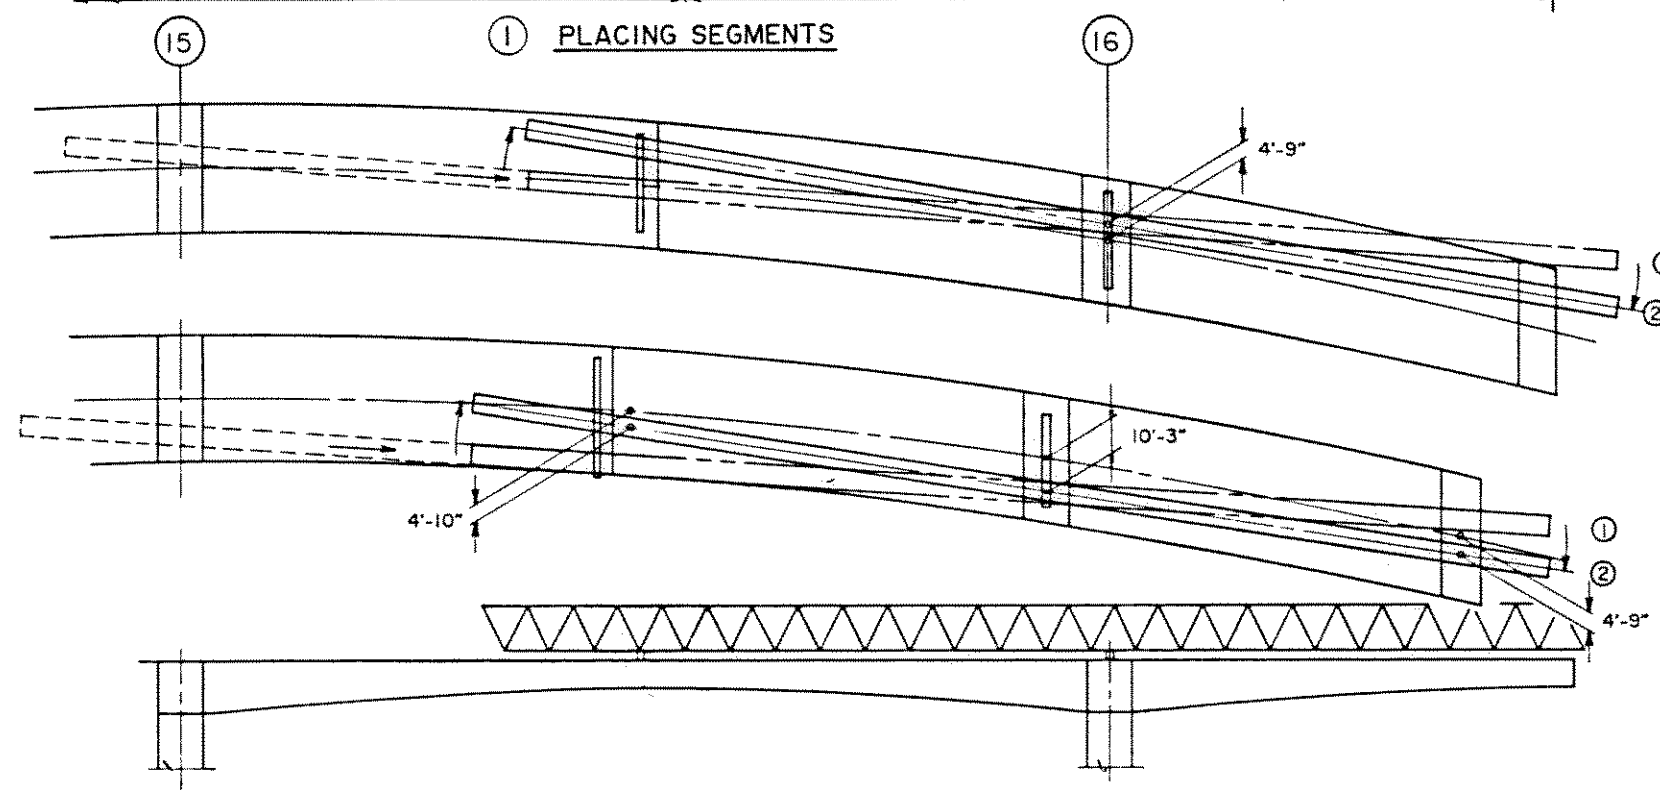

③ LAUNCHING TRUSSES - PHASE II

DATE	08/23/91
DESIGNED BY	J.M.
CHECKED BY	J.M.
NOTED BY	
ORIGINAL PLAN	

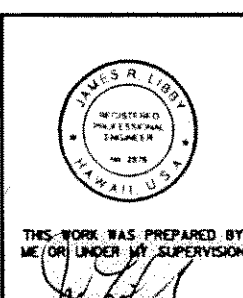

08/23/91 UPDATED DRAWING.

DATE REVISION

J. MULLER INTERNATIONAL E Libby Engineers

STATE OF HAWAII
DEPARTMENT OF TRANSPORTATION
HIGHWAYS DIVISION

ERECTION SCHEMATIC III

INTERSTATE ROUTE H-3
F.A.I. PROJECT No. I-H3-1(57)
F.A.I. PROJECT No. I-H3-1(58)

SCALE: NO SCALE DATE: APR. 1990

SHEET No. CM30F SHEETS