



FED. ROAD DIST. NO.	STATE	FED. AID PROJ. NO.	FISCAL YEAR	SHEET NO.	TOTAL SHEETS
HAWAII	HAW.	I-H3-1(57)	1988		

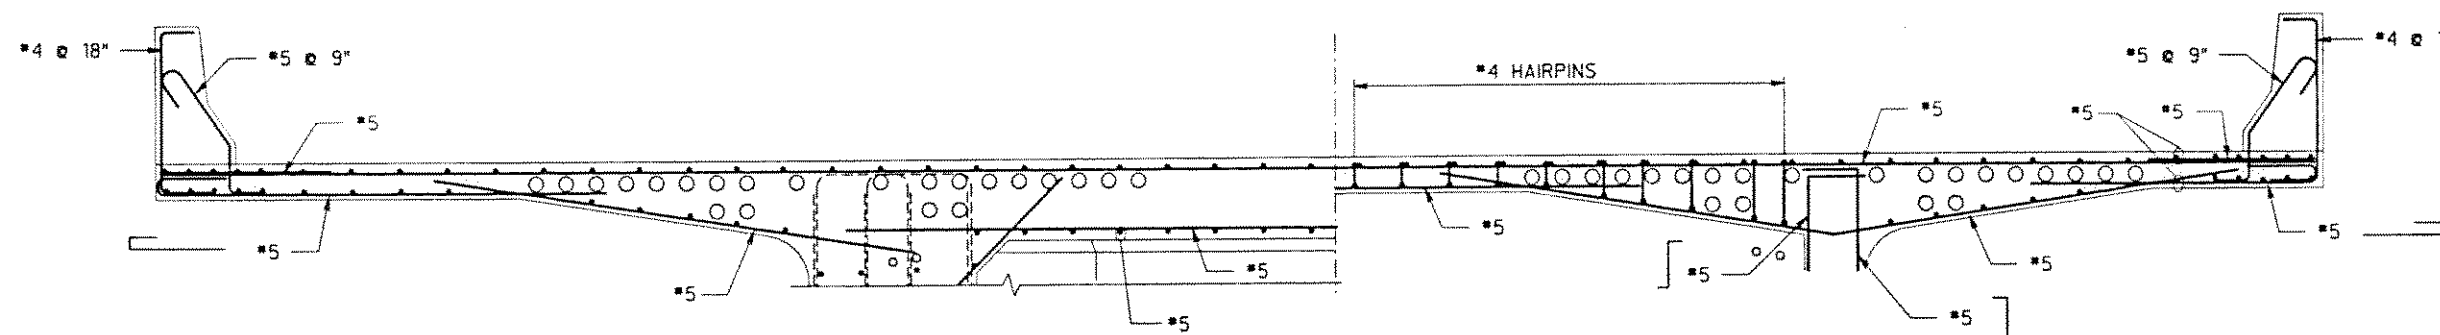

HALF SECTION B
1/2" = 1'-0"

HALF SECTION A
1/2" = 1'-0"

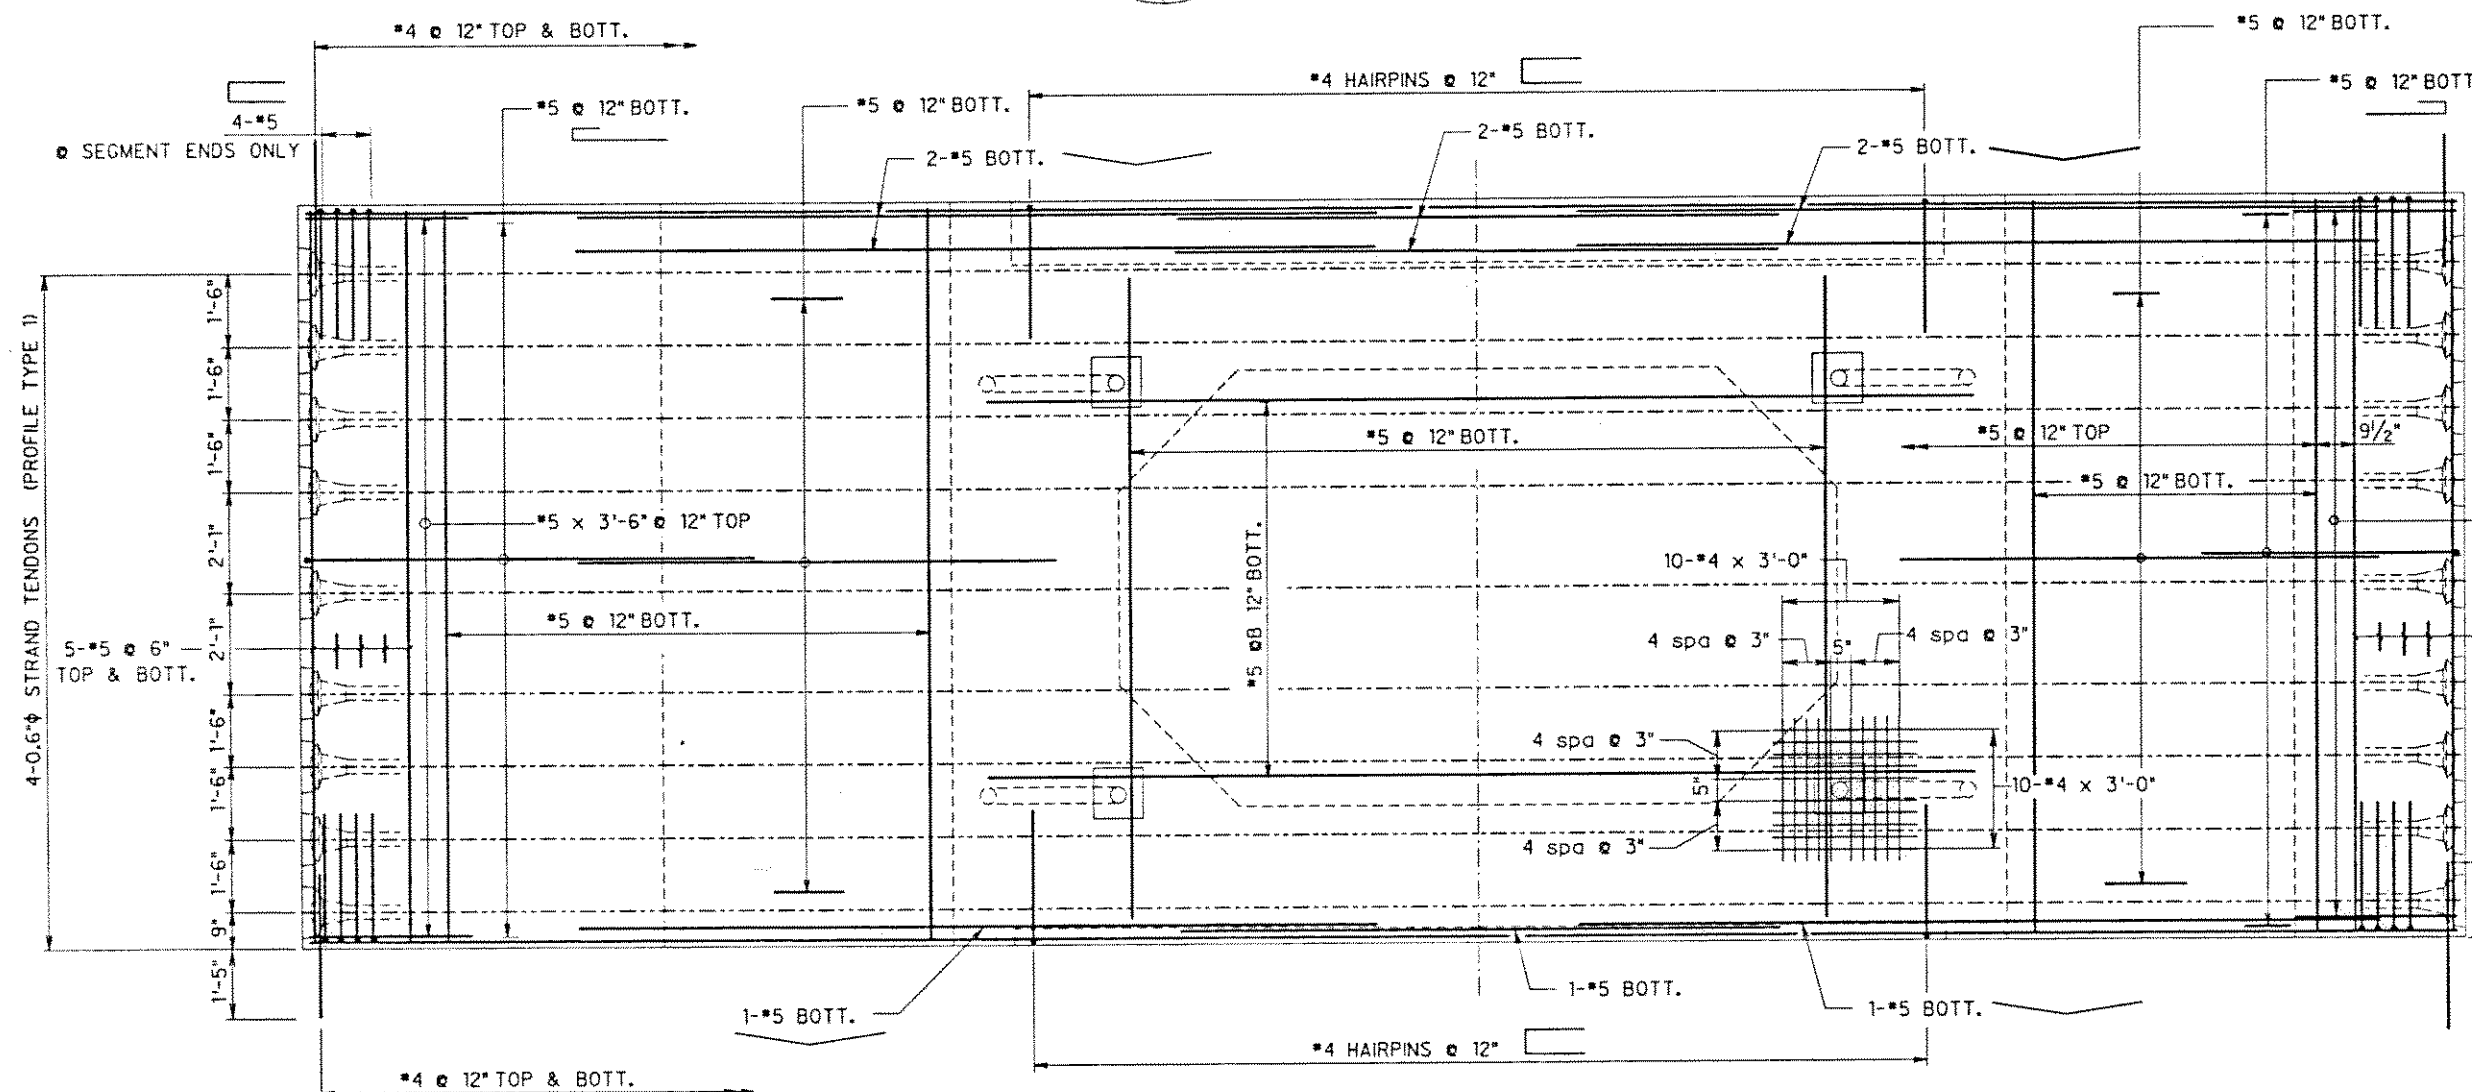


PLAN
1/2" = 1'-0"

NOTE: FOR TRANSVERSE TENDON PROFILES SEE SHEET TT1

5-#5 @ 6" TOP & BOTT.

5-#5 @ 6" TOP & BOTT.

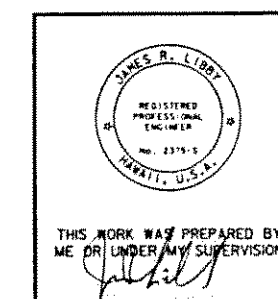

THIS WORK WAS PREPARED BY ME OR UNDER MY SUPERVISION

MAR 1991 REVISED DRAWING
DATE REVISION
J. MULLER INTERNATIONAL Libby Engineers

STATE OF HAWAII
DEPARTMENT OF TRANSPORTATION
HIGHWAYS DIVISION
TOP SLAB PIER SEGMENTS
REINFORCING

INTERSTATE ROUTE H-3
F.A.I. PROJECT No. I-H3-1(57)
F.A.I. PROJECT No. I-H3-1(58)
SCALE: AS NOTED DATE: JUN 1990

SHEET No. DP4 OF SHEETS