

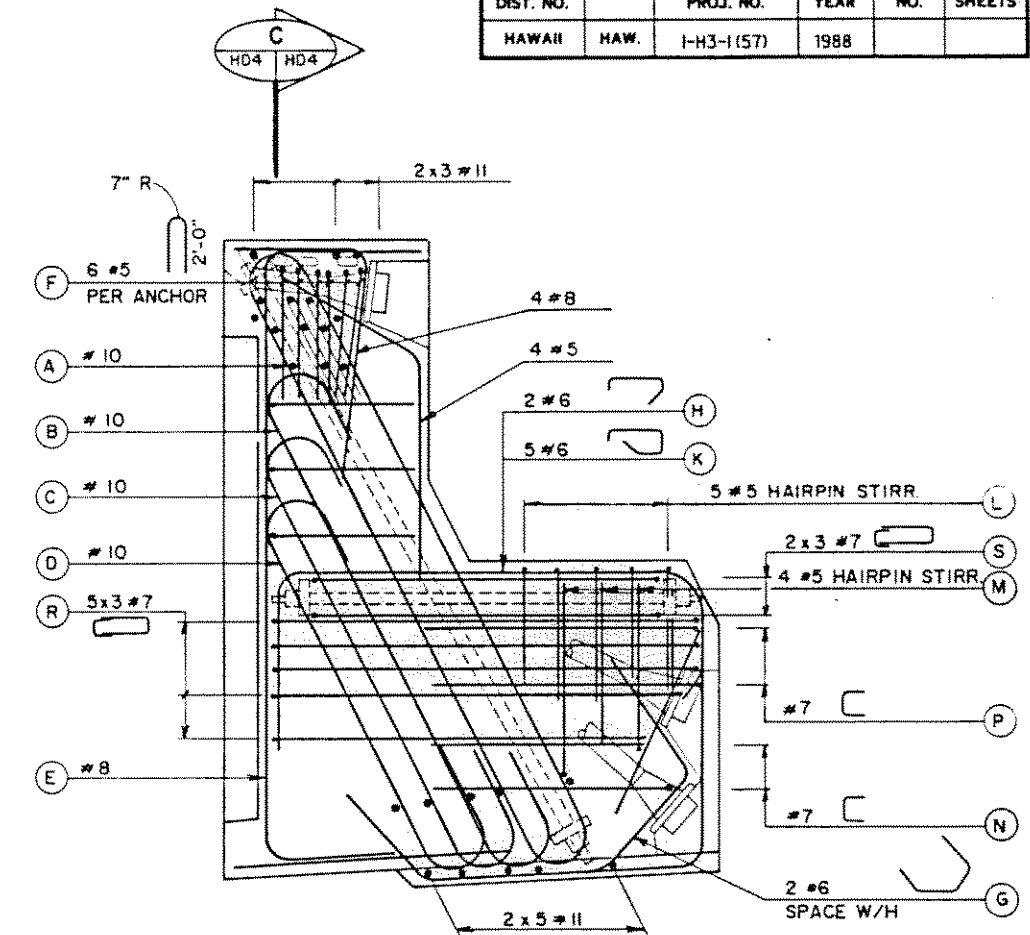


FED. ROAD DIST. NO.	STATE	FED. AID PROJ. NO.	FISCAL YEAR	SHEET NO.	TOTAL SHEETS
HAWAII	HAW.	I-H3-1(57)	1988		

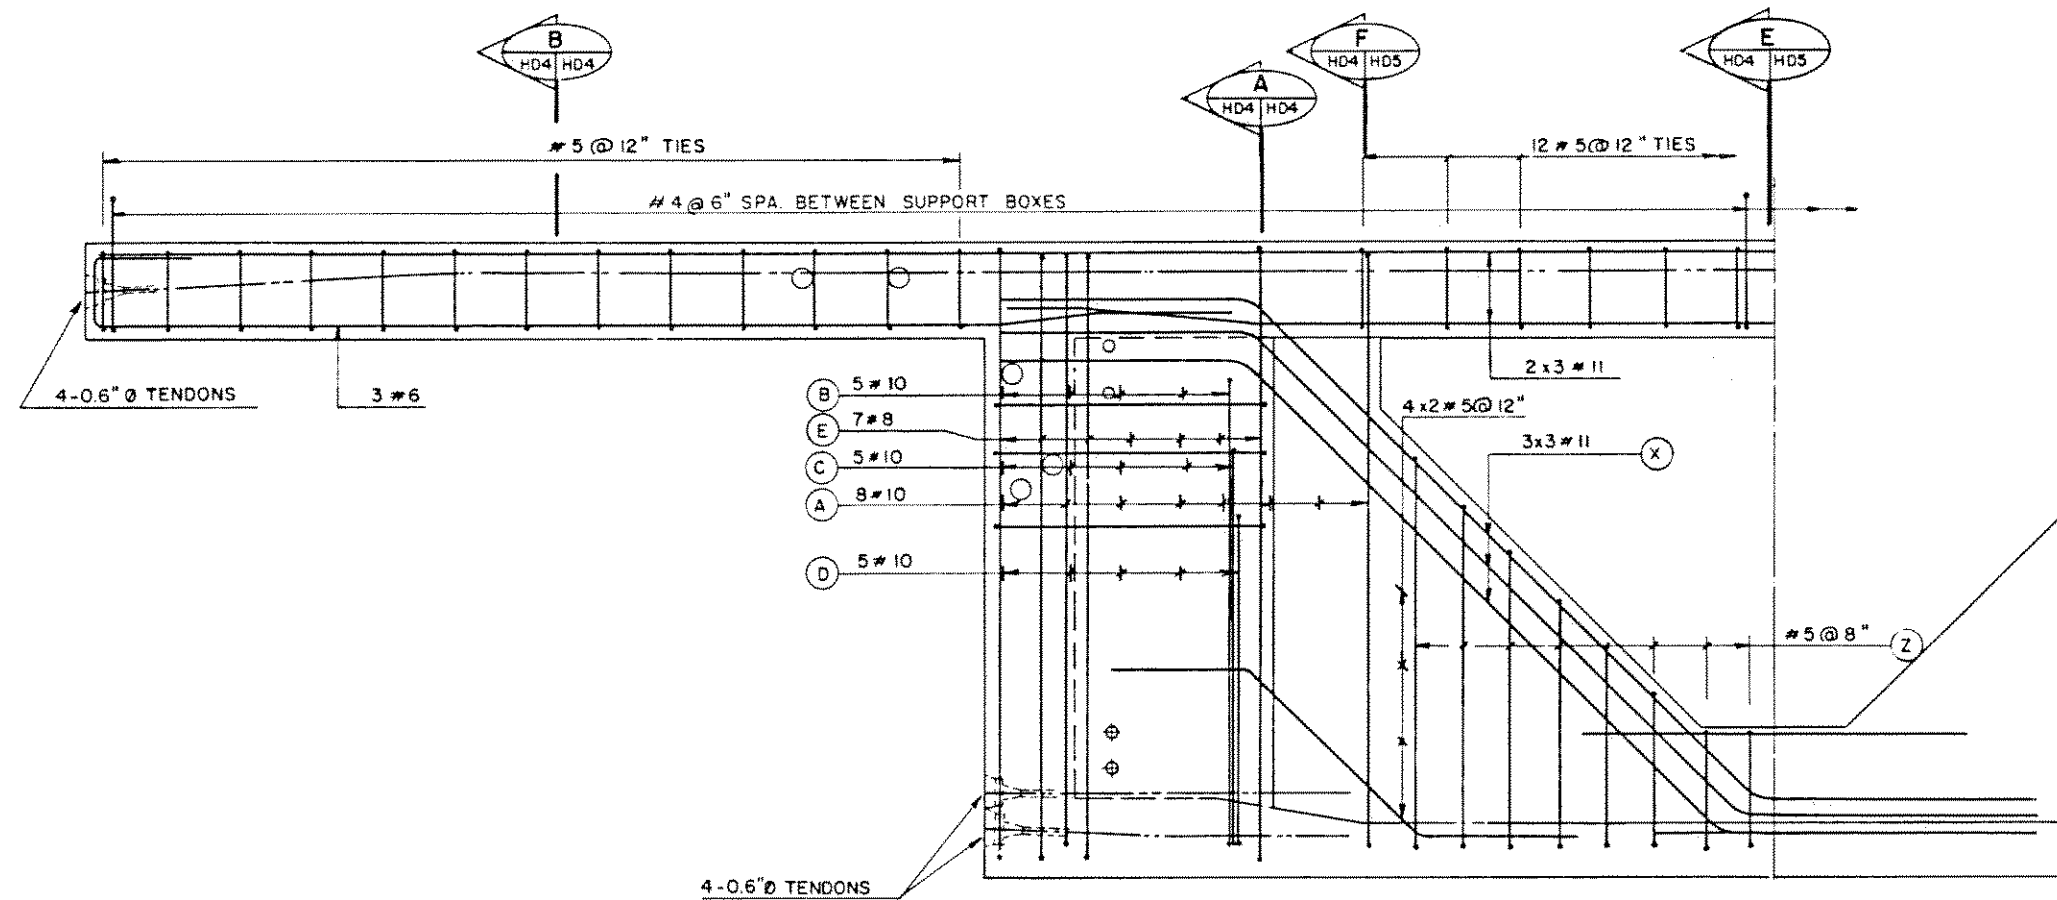


SECTION C
SCALE: 3/4" = 1'-0"


SECTION A
SCALE: 3/4" = 1'-0"

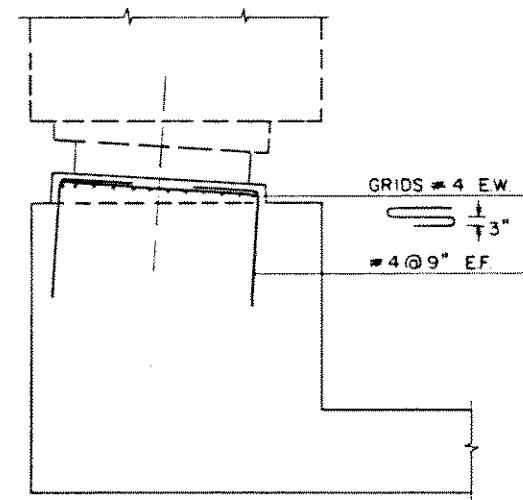


BEARING PLINTH
SCALE: 3/4" = 1'-0"

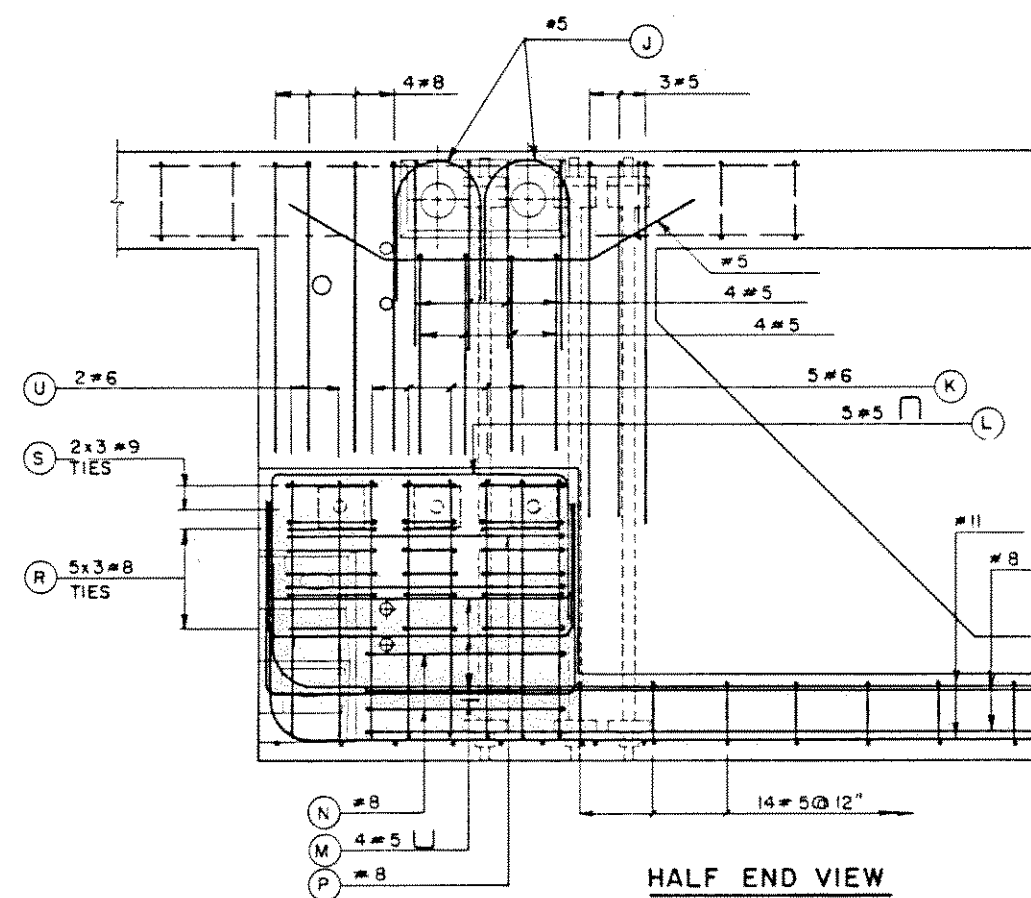

HALF END VIEW
SCALE: 3/4" = 1'-0"

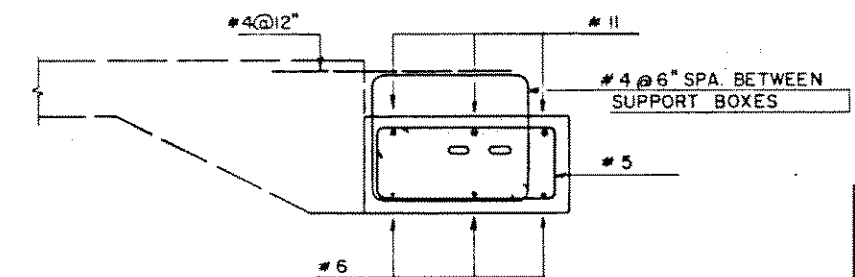

SECTION B
SCALE: 3/4" = 1'-0"

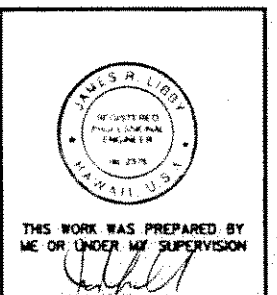

DATE	REVISION
J. MULLER INTERNATIONAL	Libby Engineers


STATE OF HAWAII
DEPARTMENT OF TRANSPORTATION
HIGHWAYS DIVISION

**HINGE SEGMENT A
REINFORCING I**


INTERSTATE ROUTE H-3
F.A.I. PROJECT No. I-H3-1(57)
F.A.I. PROJECT No. I-H3-1(58)
SCALE: AS NOTED DATE: JUN. 1990

SHEET No. HD4 OF SHEETS


FED. ROAD DIST. NO.	STATE	FED. AID PROJ. NO.	FISCAL YEAR	SHEET NO.	TOTAL SHEETS
HAWAII	HAW.	I-H3-I (57)	1988		

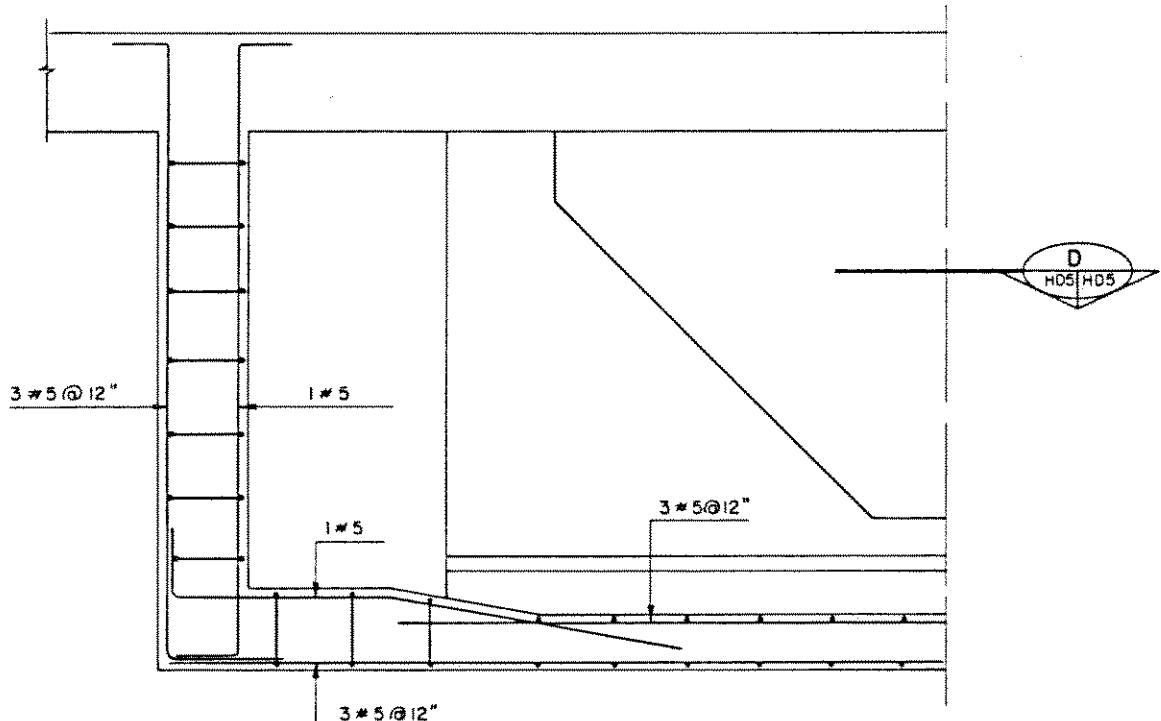


VIEW
SCALE: 3/4" = 1'-0"

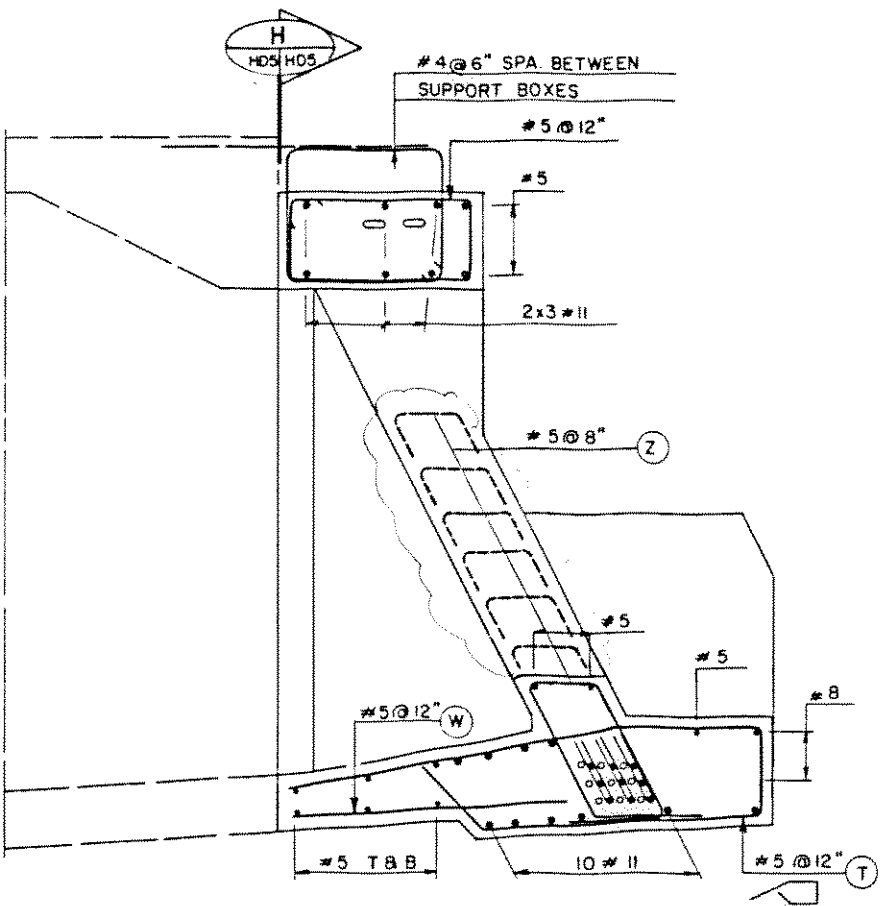

SECTION
SCALE: 3/4" = 1'-0"

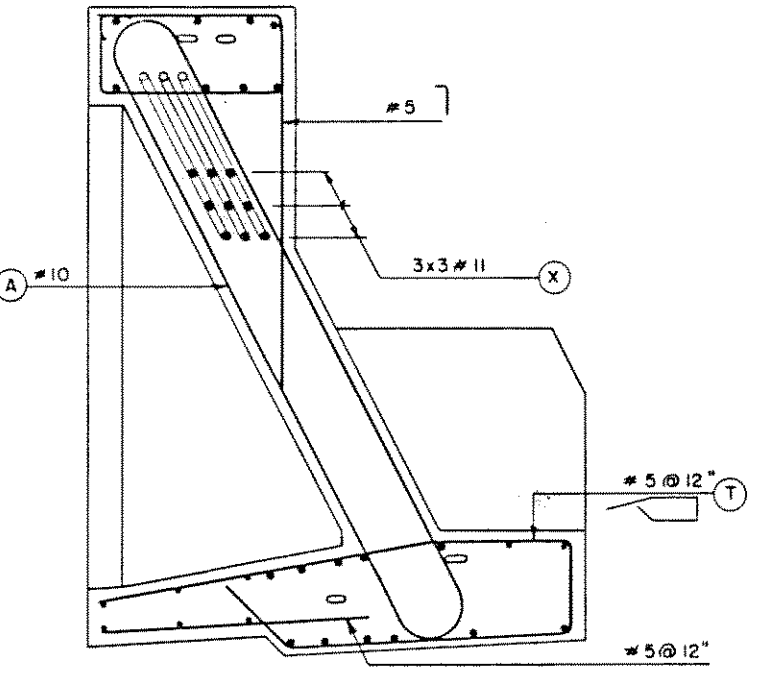

SECTION
SCALE: 3/4" = 1'-0"

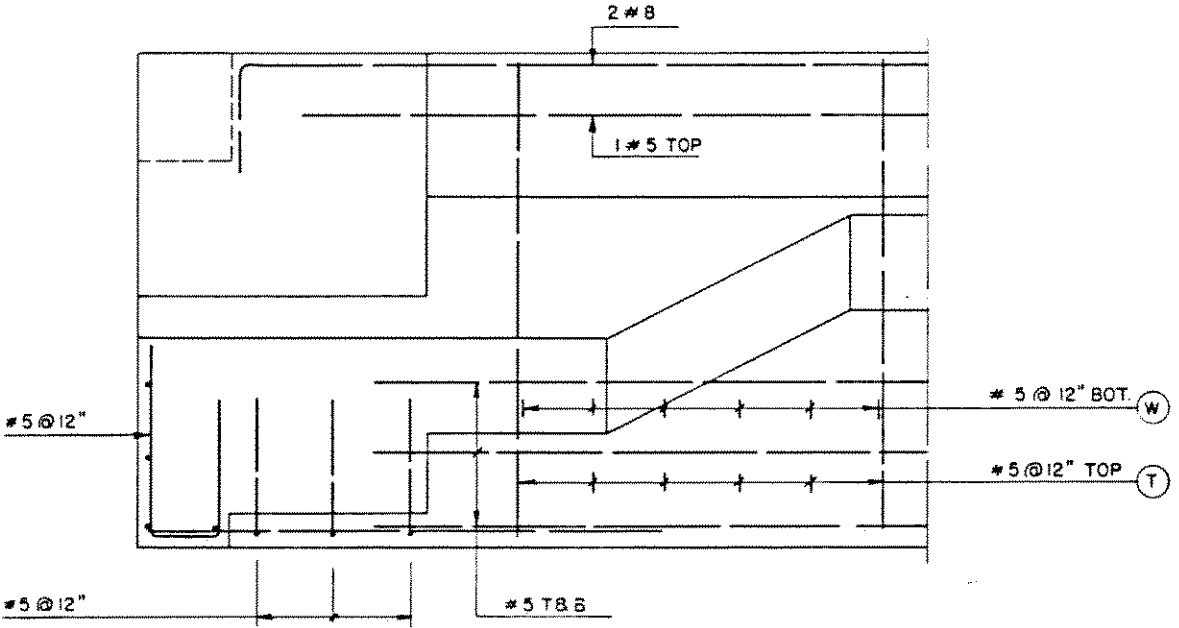

SECTION
SCALE: 3/4" = 1'-0"

DESIGNED BY	DATE
DRAWN BY	
CHECKED BY	
IN CHARGE	
NOTED BY	
REVISION	

08/23/91 UPDATED DRAWING.

DATE

REVISION

J. MULLER INTERNATIONAL

Libby Engineers

STATE OF HAWAII
DEPARTMENT OF TRANSPORTATION
HIGHWAYS DIVISION

HINGE SEGMENT A
REINFORCING II

INTERSTATE ROUTE H-3
F.A.I. PROJECT No. I-H3-I (57)
F.A.I. PROJECT No. I-H3-I (58)

SCALE: AS NOTED DATE: JUN. 1990

SHEET No. HD5 OF SHEETS

THIS WORK WAS PREPARED BY ME OR UNDER MY SUPERVISION