
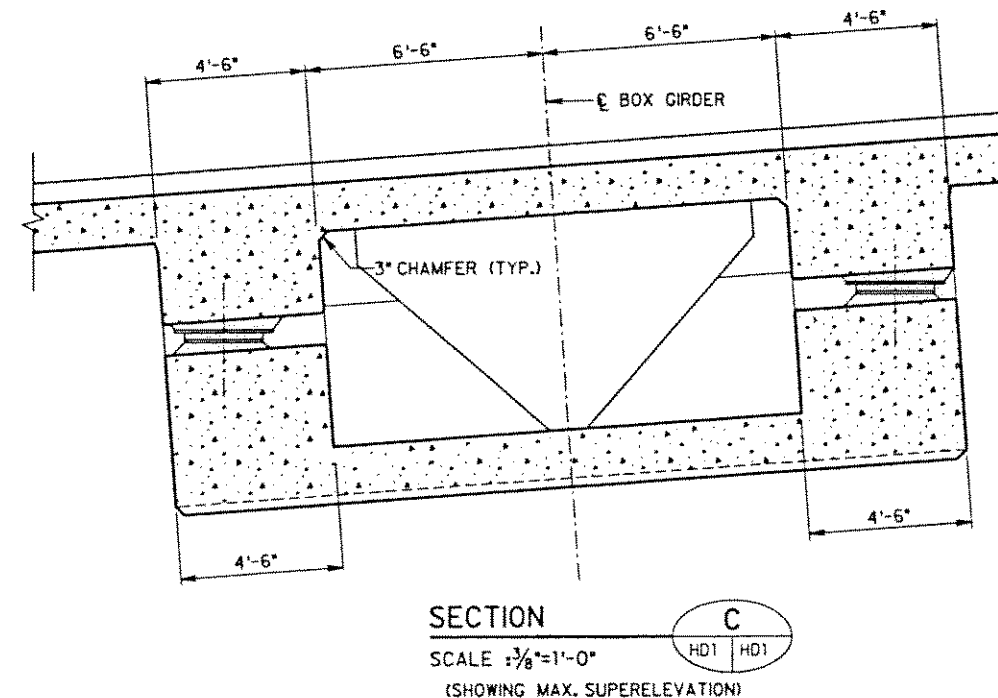
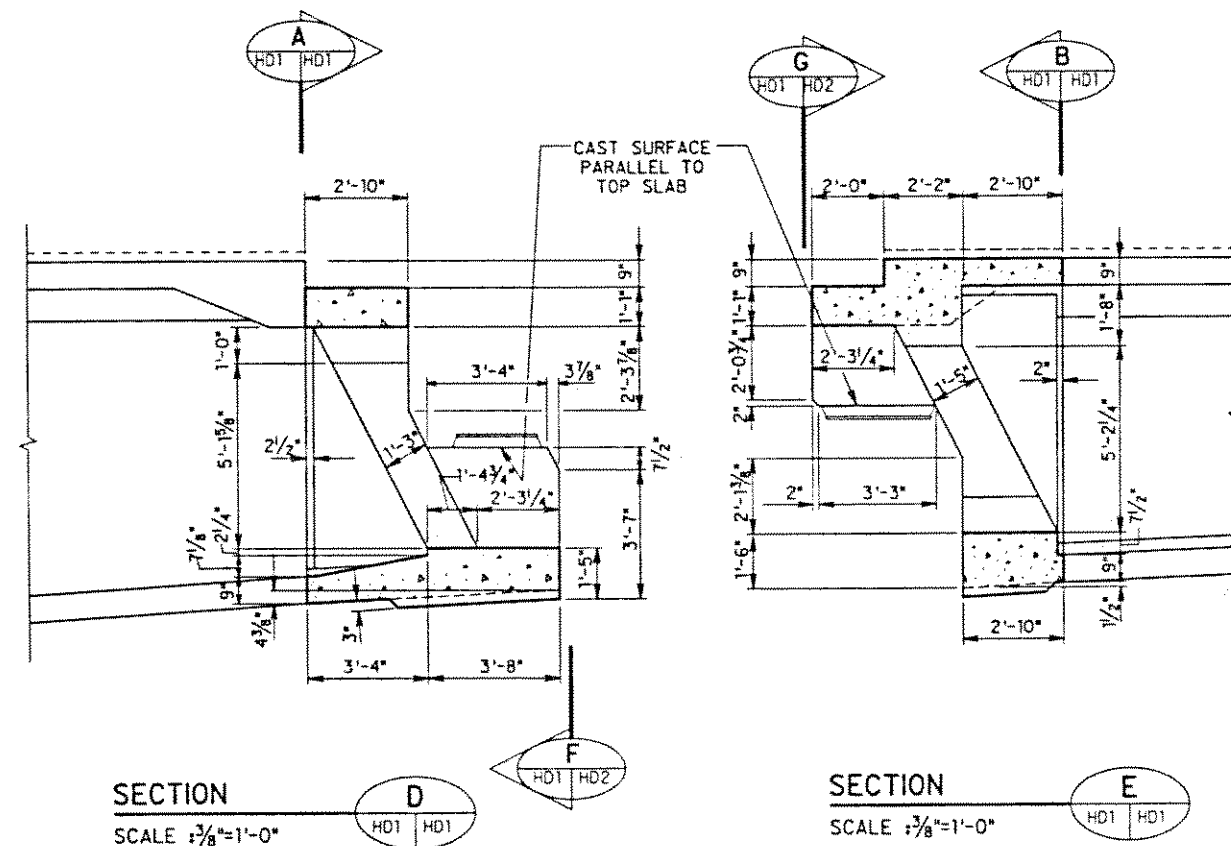


Technical drawing of a bridge deck cross-section, showing Segment A and Segment B. The drawing includes dimensions for various parts of the deck, including the main deck width (47'-0"), deck overlay (3"), and internal structural dimensions. It also shows the location of the centerline (SYMM. ABOUT C) and the deck edge (D). The drawing is labeled "SEGMENT A" and "SEGMENT B" and includes a scale of 3/8" = 1'-0".

SEGMENT A
 HALF SECTION
 SCALE: 3/8" = 1'-0"

SEGMENT B
 HALF SECTION
 SCALE: 3/8" = 1'-0"

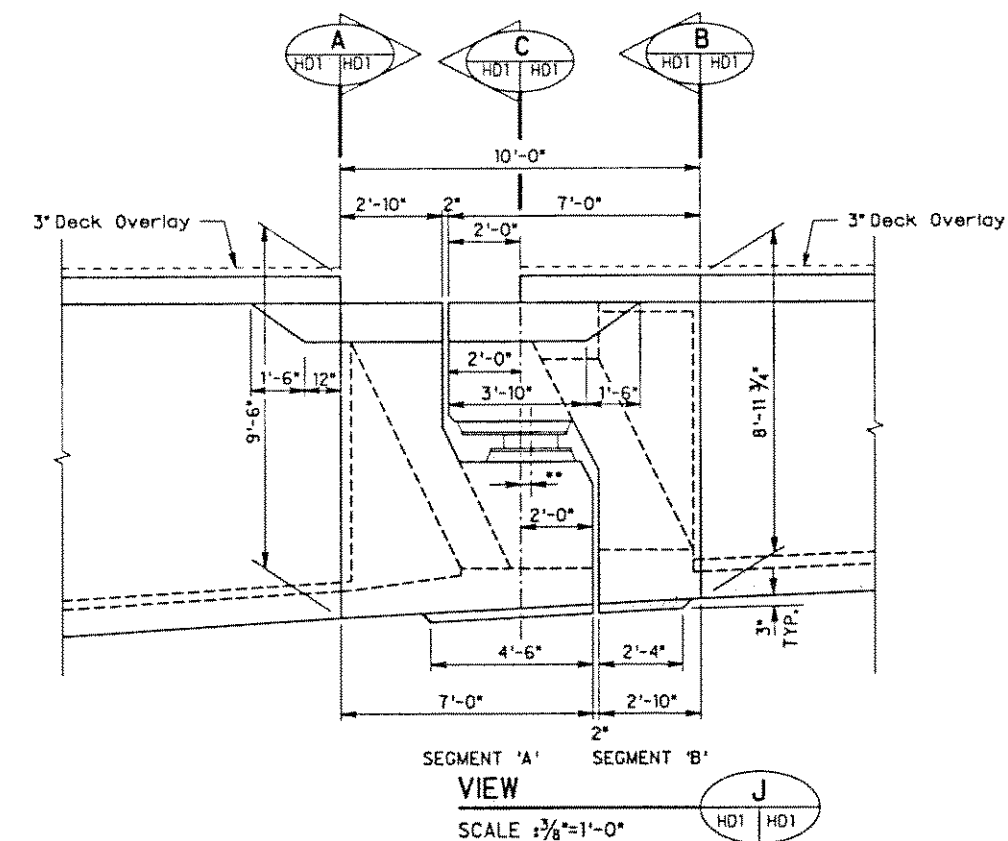


- | | | |
|---|----------------------------|--|
| 10/04/90 | UPDATED DRAWING. | |
| DATE | REVISION | |
|  | J. MULLER
INTERNATIONAL |  Libby
Engineers |

ORIGINAL PLAN NUMBER	SURVEY PLOTTED BY	DATE
DEATH BY		
TRACED BY		
DESIGNED BY		
NOTES MADE		
QUANTITIES BY		
CHECKED BY		



FED. ROAD DIST. NO.	STATE	FED. AID PROJ. NO.	FISCAL YEAR	SHEET NO.	TOTAL SHEETS
HAWAII	HAW.	I-H3-1(57)	1988		

ERECTION SEQUENCE

PHASE 1

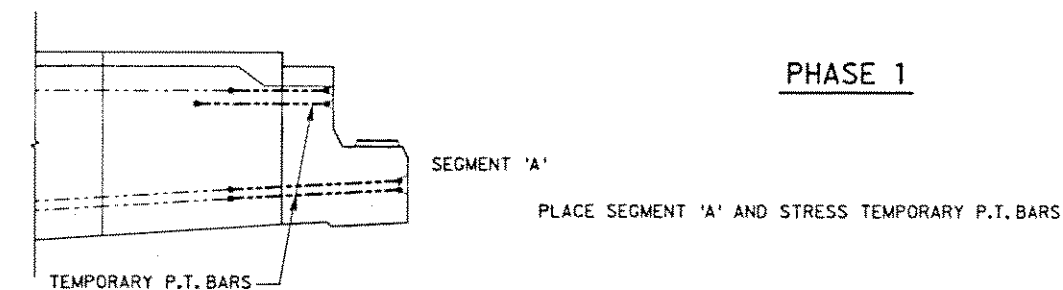


PHASE II

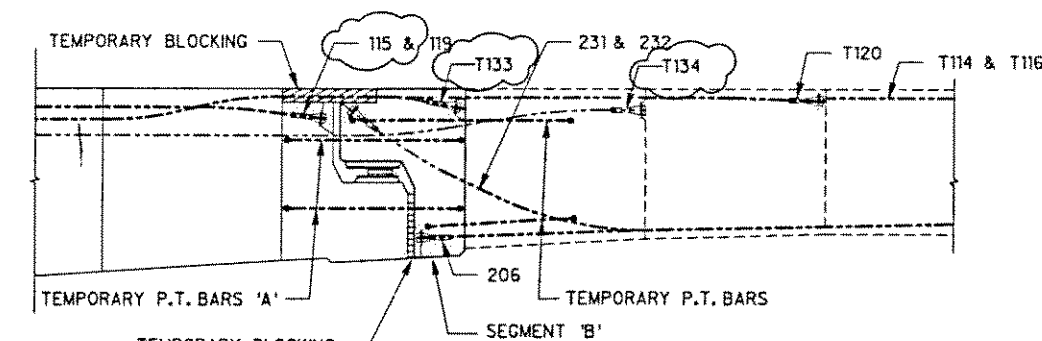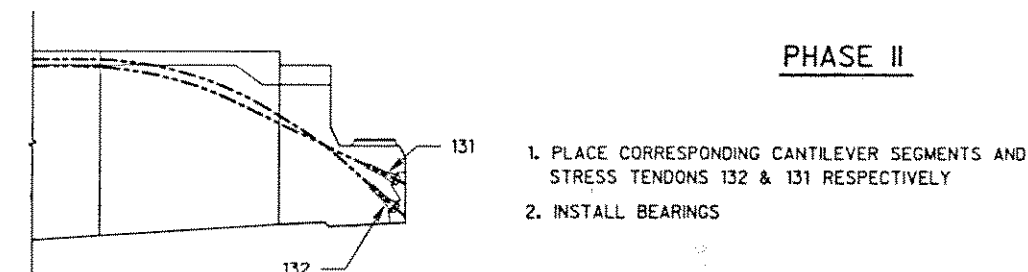

PHASE III

1. ERECT AND ADJUST SEGMENT 'B'
2. PLACE TEMPORARY SHIMS IN THE EXPANSION JOINT GAP AND STRESS TEMPORARY P.T. BARS 'A'
3. INSTALL TEMPORARY BLOCKING ACCORDING TO DETAILS SHOWN ON SHEET HD9
4. ERECT SEGMENT AT OPPOSITE END OF CANTILEVER
5. INSTALL AND STRESS TENDONS T134 AND T119
6. ERECT REMAINING PAIRS OF CANTILEVER SEGMENTS, STARTING WITH THE DOWNSTATION SEGMENT. STRESS TENDONS T133, T120, T115, T114, & T116.
7. FOLLOWING CLOSURE AND STRESSING OF CONTINUITY TENDONS IN THE SPAN UPSTATION OF THE HINGED SPAN AND AFTER THE ERECTION GANTRY CENTER LEGS HAS BEEN MOVED TO THE THIRD PIER AFTER THE HINGE, THE HINGE WILL BE RELEASED AS FOLLOWS:
 - a. RELEASE TEMPORARY P.T. BARS 'A' THROUGH THE HINGE SEGMENT.
 - b. RELEASE TEMPORARY TENDONS IN THE FOLLOWING ORDER: T133, T120, T114, T116
 - c. REMOVE TEMPORARY BLOCKING

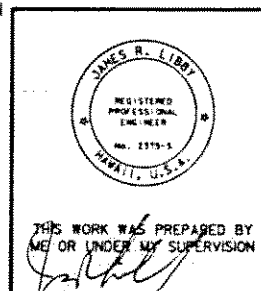

10/04/90

UPDATED DRAWING.

DATE

REVISION

J. MULLER INTERNATIONAL

Libby Engineers

STATE OF HAWAII

DEPARTMENT OF TRANSPORTATION

HIGHWAYS DIVISION

HINGE SEGMENT

DIMENSIONS II

INTERSTATE ROUTE H-3

F.A.J. PROJECT No. I-H3-1(57)


F.A.J. PROJECT No. I-H3-1(58)

SCALE : AS NOTED


DATE : SEP. 1990

SHEET No. HD2 OF

SHEETS

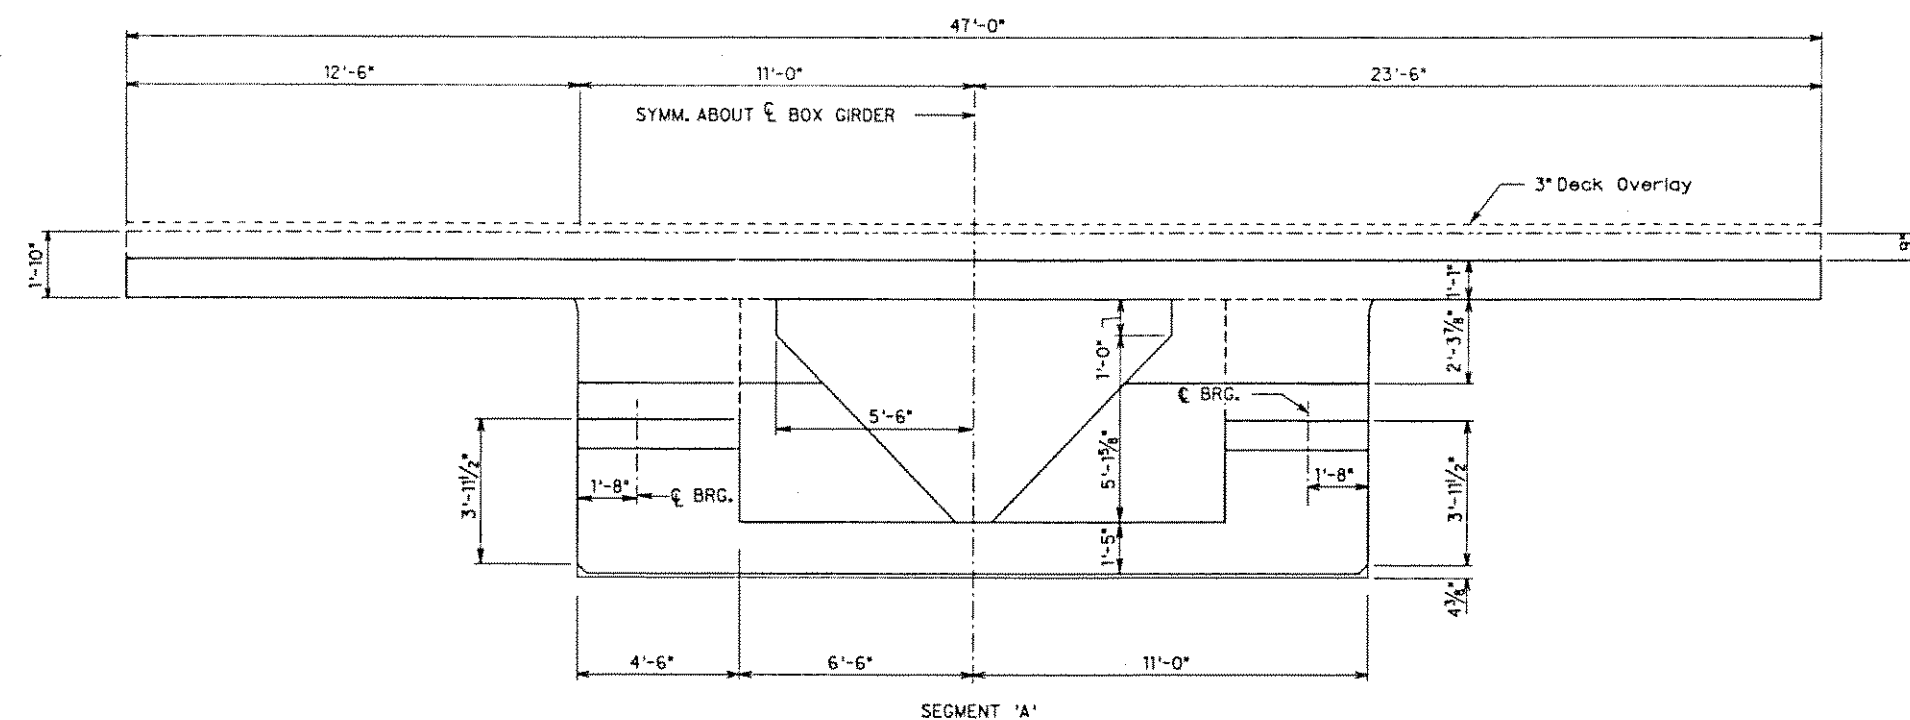

SECTION F
SCALE 3/8"=1'-0"

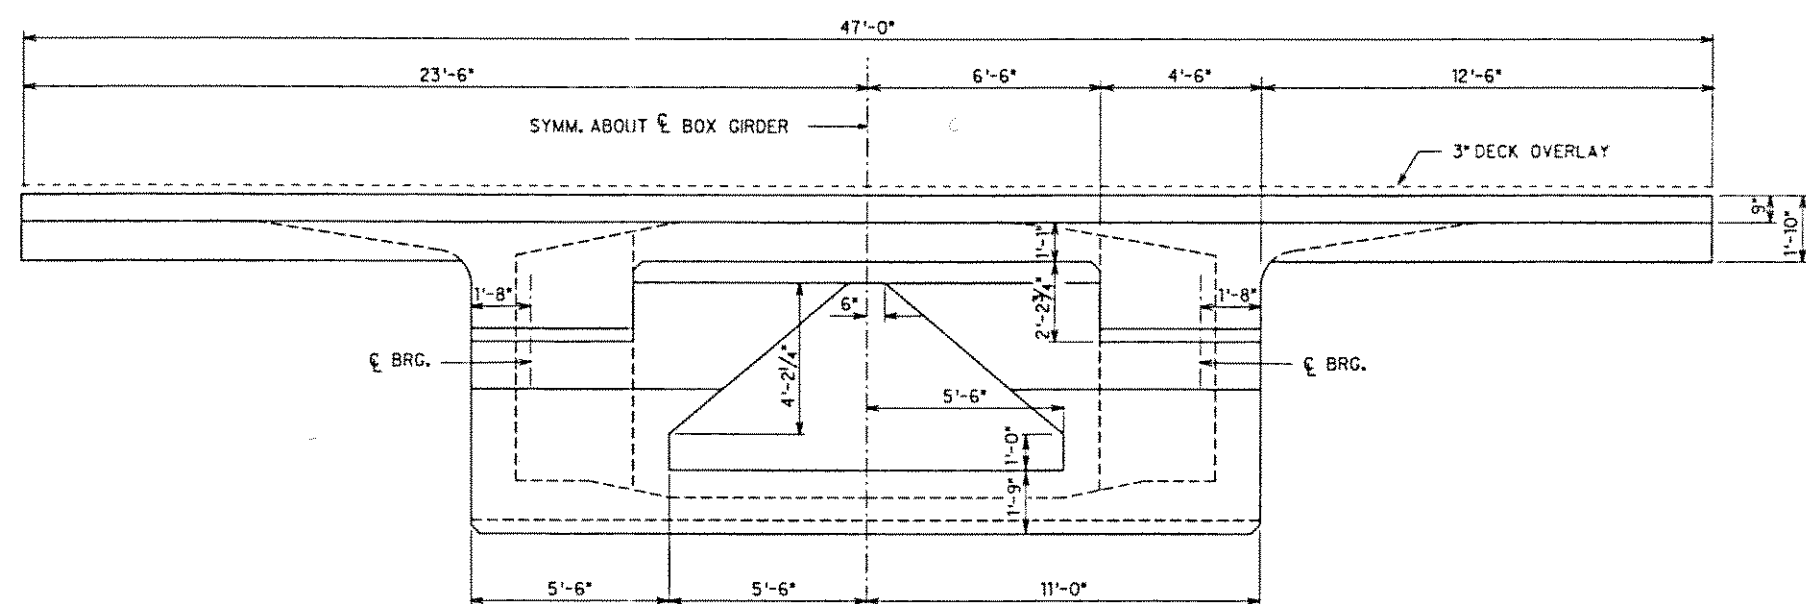

SECTION G
SCALE 3/8"=1'-0"

NOTES:
1. FOR NOTES SEE SHEET HD1.

ORIGINAL PLAN	DATE
DRAWN BY	
DESIGNED BY	
CHECKED BY	
NOTE BOOK	
No.	