

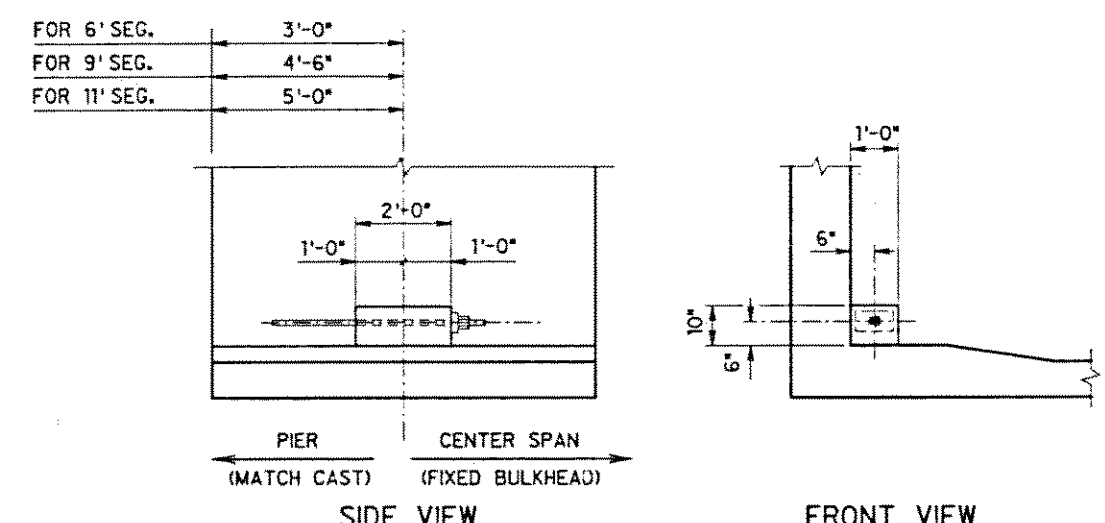
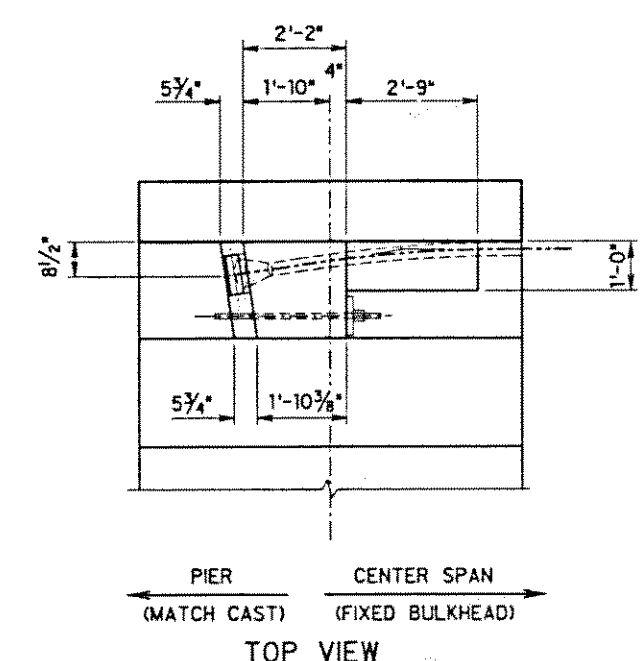
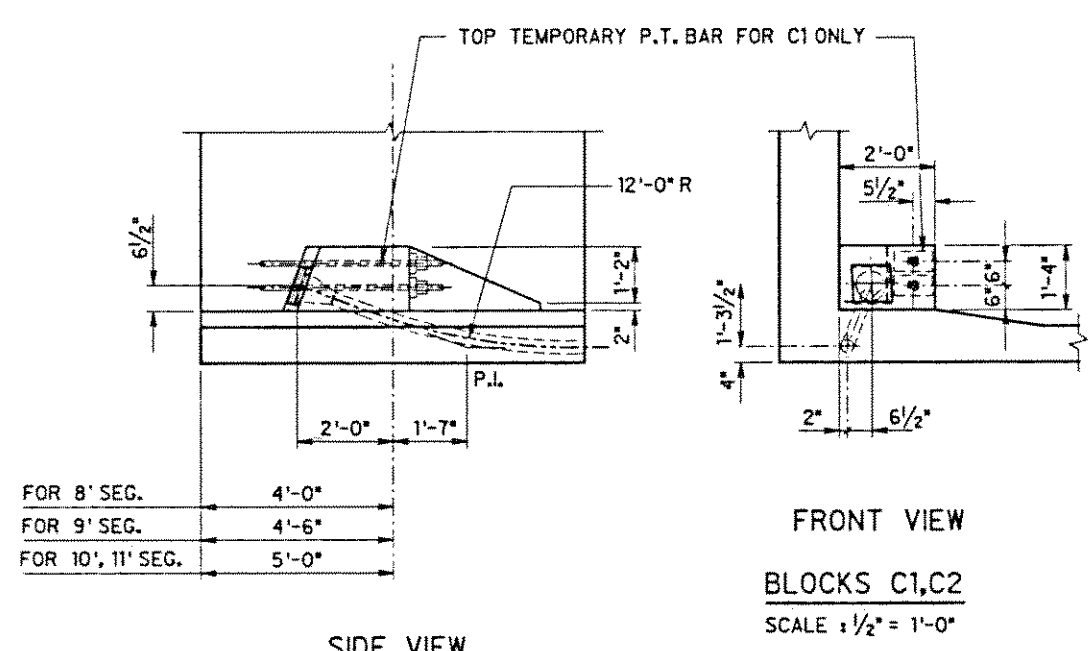
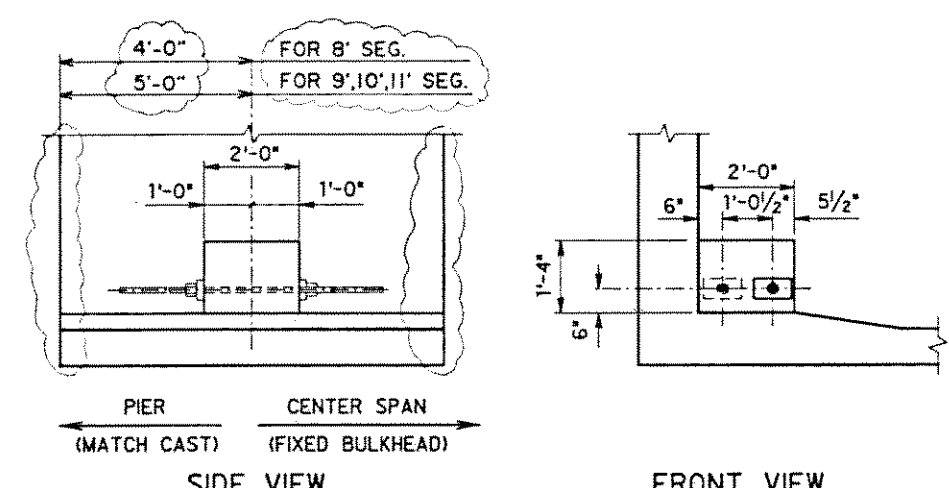
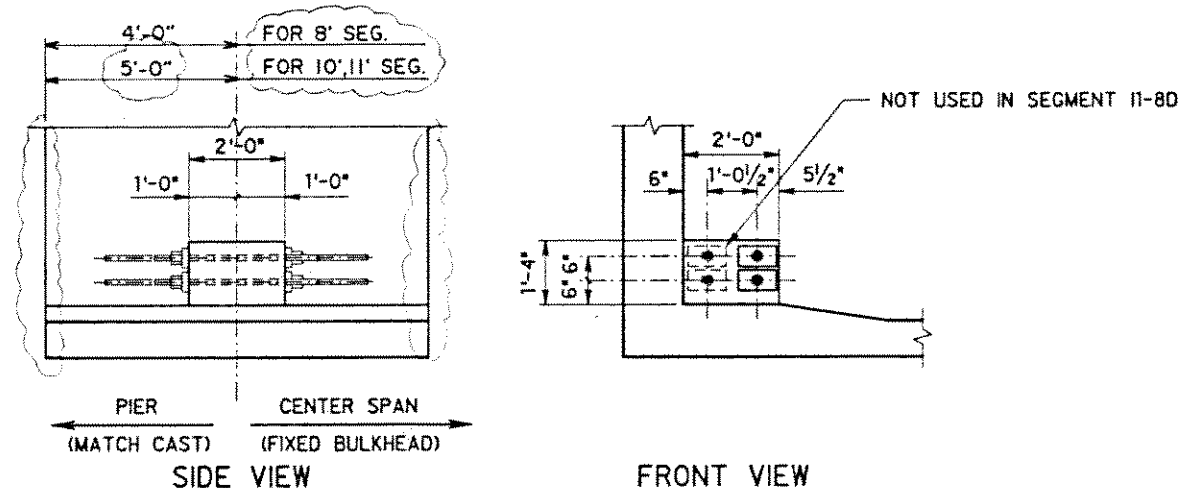


FED. ROAD DIST. NO.	STATE	FED. AID PROJ. NO.	FISCAL YEAR	SHEET NO.	TOTAL SHEETS
HAWAII	HAW.	I-H3-1 (57)	1988		

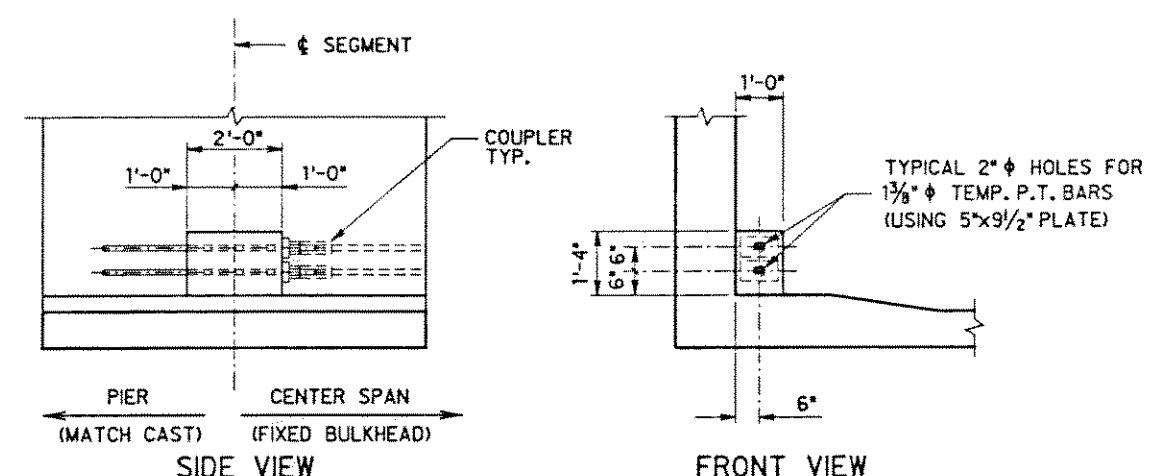

NOTE: FOR BLOCKS B3 THRU B5, C3, C4, E1, E2 SEE SHEET No. PT2

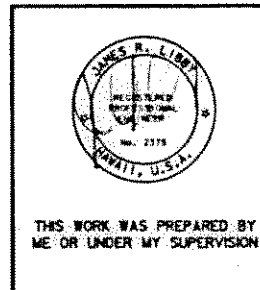

02/25/91 UPDATED DRAWING.
07/25/90 UPDATED DRAWING

DATE	REVISION
J. MULLER INTERNATIONAL	Libby Engineers

STATE OF HAWAII
DEPARTMENT OF TRANSPORTATION
HIGHWAYS DIVISION

**POST-TENSIONING DETAILS I
BOTTOM BLOCKS**

INTERSTATE ROUTE H-3
F.A.I. PROJECT No. I-H3-1 (57)
F.A.I. PROJECT No. I-H3-1 (58)
SCALE: AS NOTED DATE: JUN. 1990