
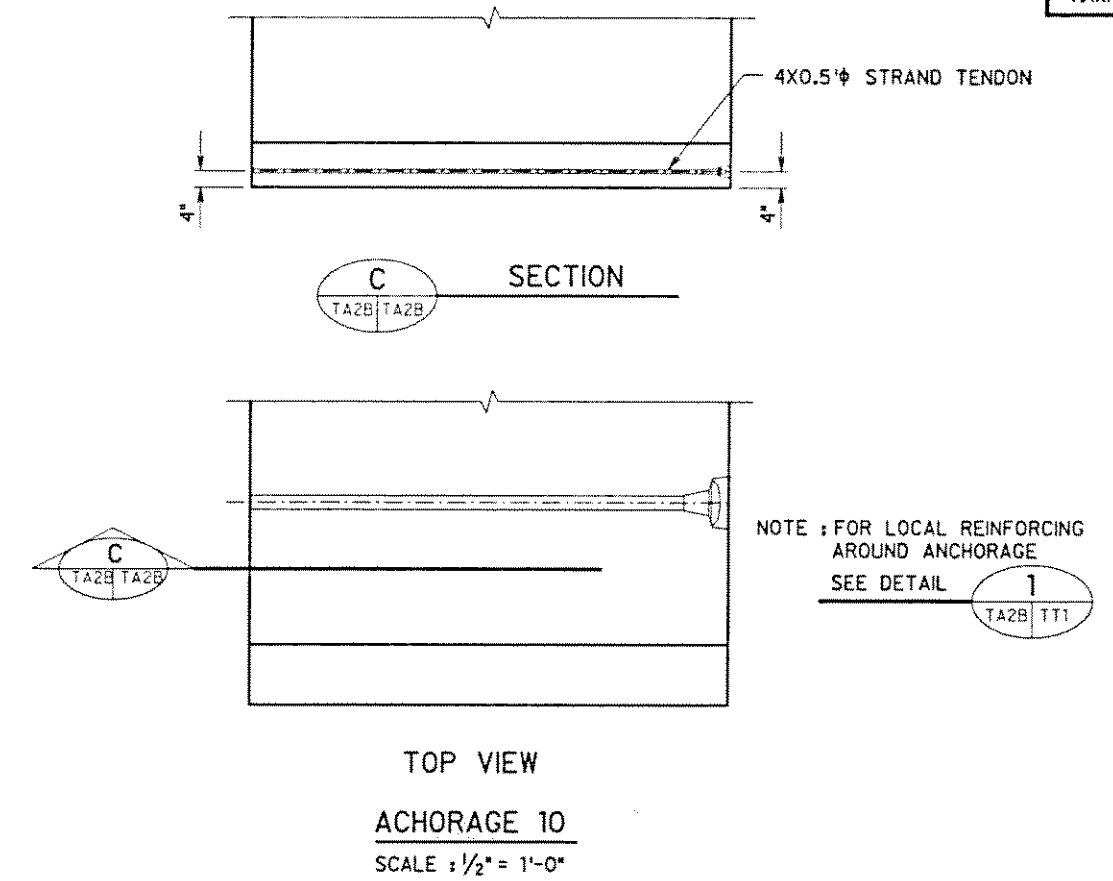
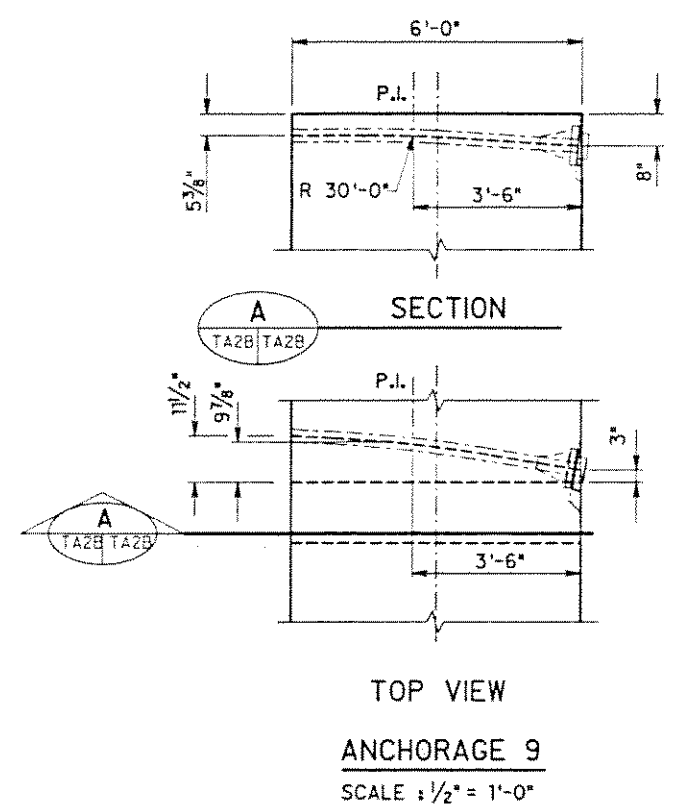


FED. ROAD DIST. NO.	STATE	FED. AID PROJ. NO.	FISCAL YEAR	SHEET NO.	TOTAL SHEETS
HAWAII	HAW.	I-H3-1(57)	1988		

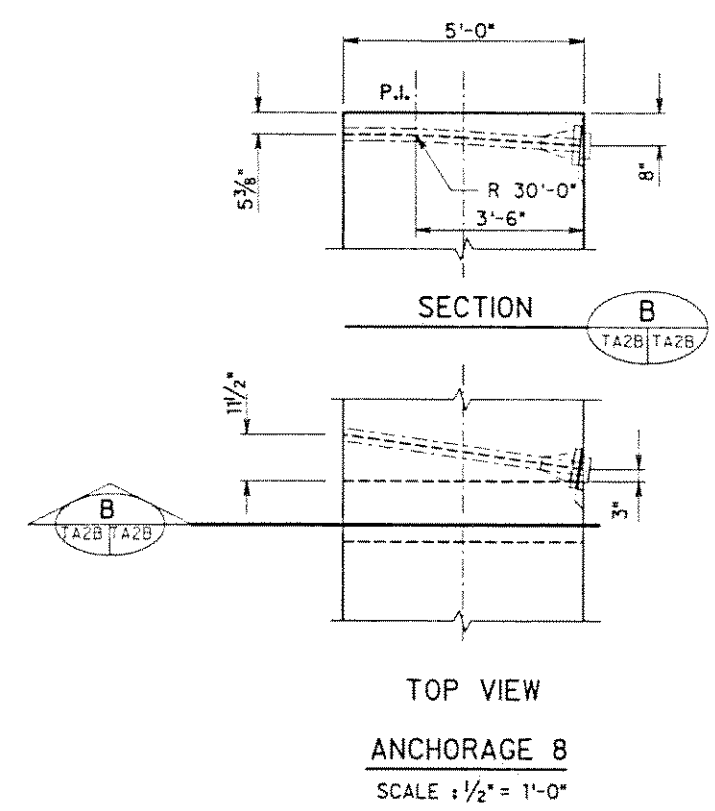

NOTE : FOR LOCAL REINFORCING
AROUND ANCHORAGE
SEE DETAIL 1

ORIGINAL PLAN	DATE
DRAWN BY	
CHECKED BY	
NOTED BY	
NO.	

04/01/91

ADDED ANCHORAGE 9 AND 10.

DATE

REVISION

J. MULLER INTERNATIONAL

Libby Engineers

STATE OF HAWAII

DEPARTMENT OF TRANSPORTATION

HIGHWAYS DIVISION

POST-TENSIONING DETAILS IIB

ANCHORAGE DETAILS

INTERSTATE ROUTE H-3

F.A.I. PROJECT No. I-H3-1(57)

F.A.I. PROJECT No. I-H3-1(58)

SCALE : AS NOTED

DATE : FEB. 1991

SHEET No. TA2B OF

SHEETS



THIS WORK WAS PREPARED BY
ME OR UNDER MY SUPERVISION