



FED. ROAD DIST. NO.	STATE	FED. AID PROJ. NO.	FISCAL YEAR	SHEET NO.	TOTAL SHEETS
HAWAII	HAW.	I-H3-1(57)	1988		

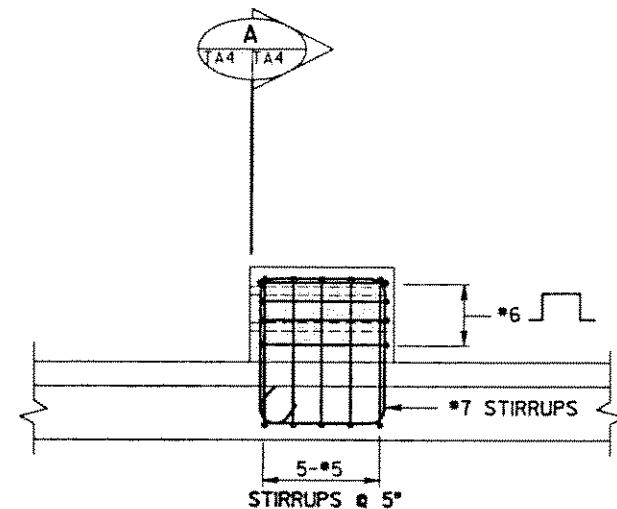

ELEVATION


SCALE: 3/4" = 1'-0"

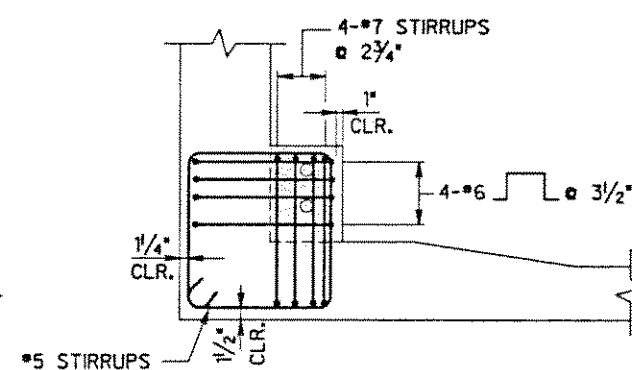

SECTION


SCALE: 3/4" = 1'-0"

BLOCK A

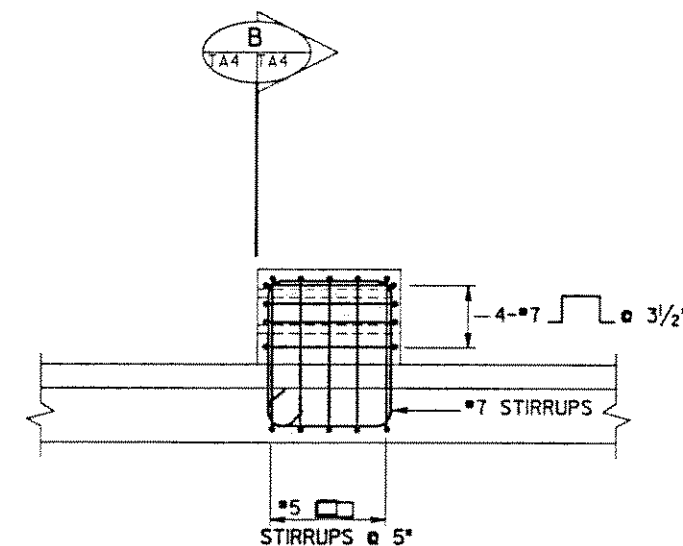

ELEVATION


SCALE: 3/4" = 1'-0"

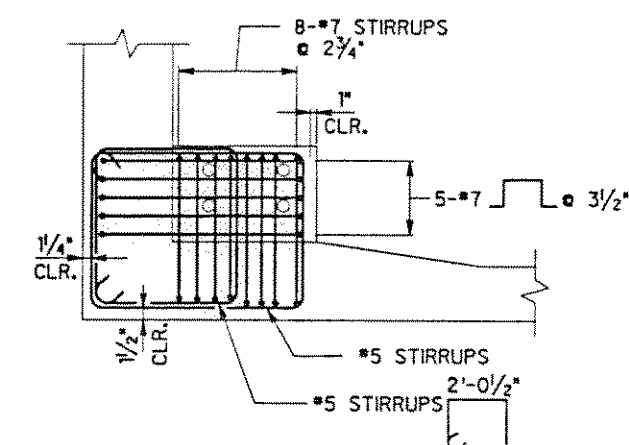

SECTION


SCALE: 3/4" = 1'-0"

BLOCK B

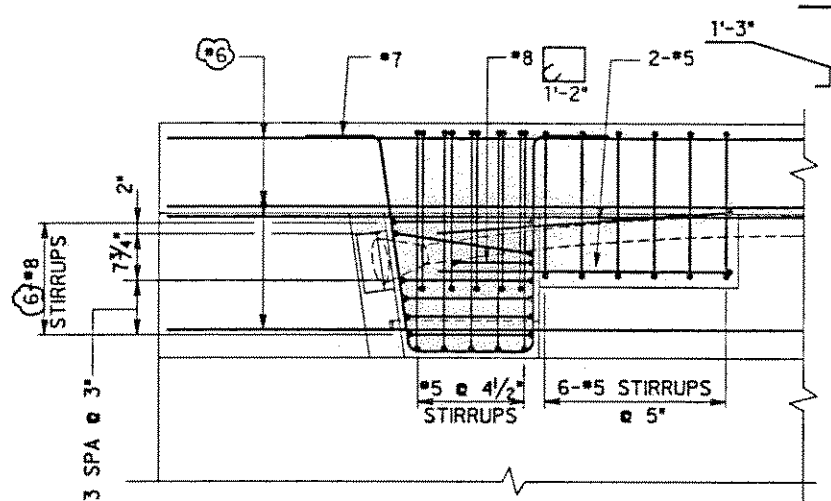


PLAN

SCALE: 3/4" = 1'-0"

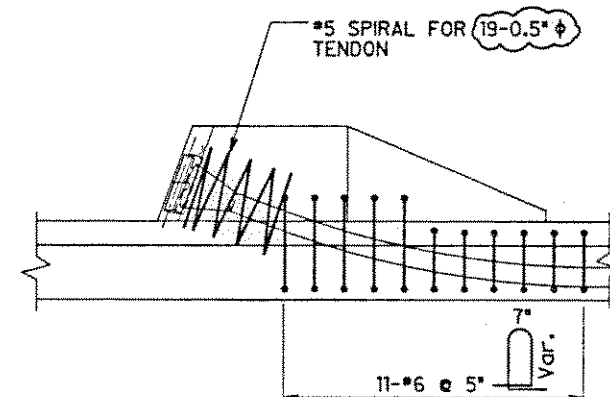


REINFORCING AT ANCHORAGE AND TENDON

SCALE: 3/4" = 1'-0"

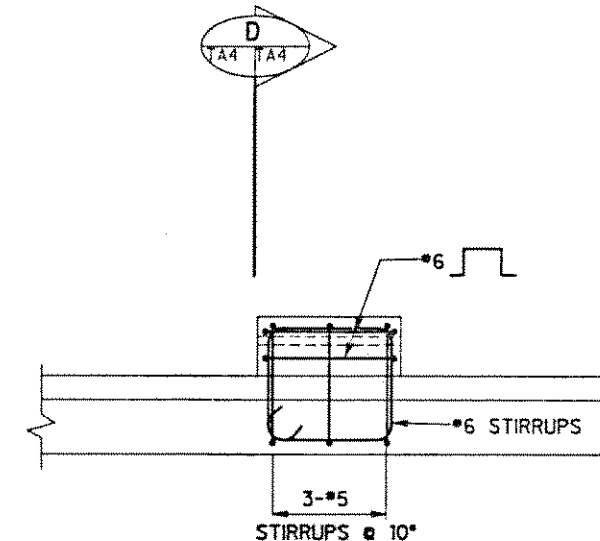

ELEVATION


SCALE: 3/4" = 1'-0"

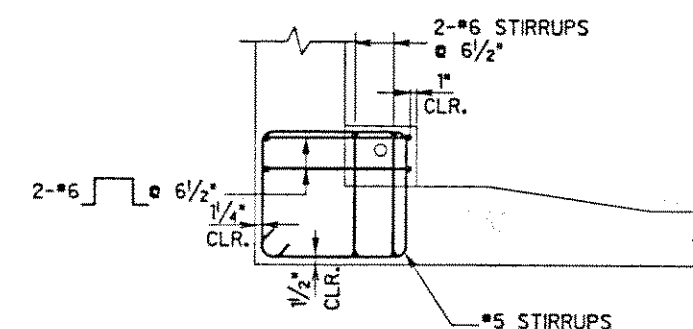

SECTION

SCALE: 3/4" = 1'-0"


BLOCK D

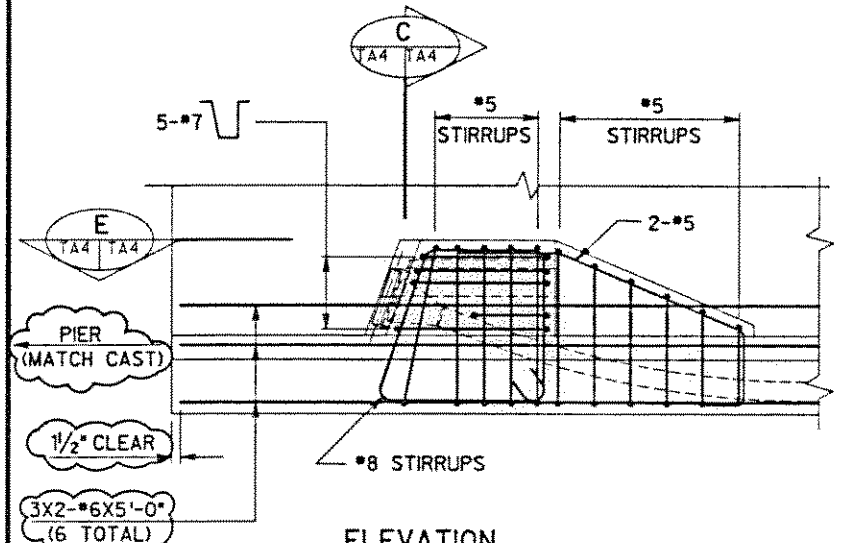

ELEVATION


SCALE: 3/4" = 1'-0"

BLOCK C

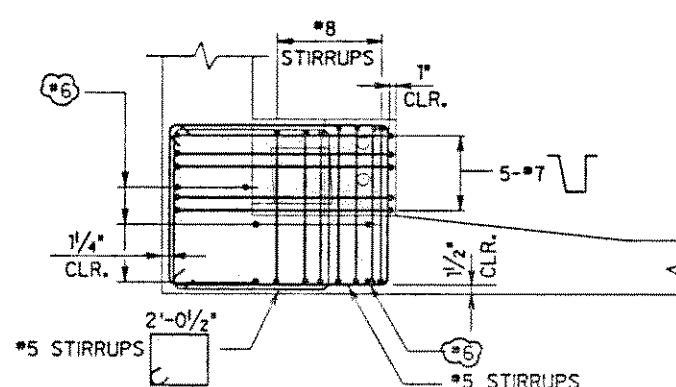

SECTION

SCALE: 3/4" = 1'-0"

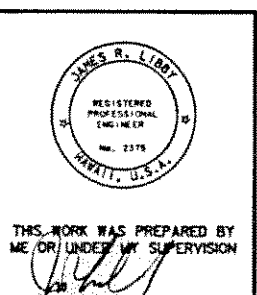

THIS WORK WAS PREPARED BY ME OR UNDER MY SUPERVISION

01/21/91 REVISED REINFORCING.
07/25/90 UPDATED DRAWING

DATE REVISION

J. MULLER INTERNATIONAL

Libby Engineers

STATE OF HAWAII
DEPARTMENT OF TRANSPORTATION
HIGHWAYS DIVISION

POST-TENSIONING DETAILS IV
REINFORCING I
BOTTOM BLOCKS

INTERSTATE ROUTE H-3
F.A.I. PROJECT No. I-H3-1(57)
F.A.I. PROJECT No. I-H3-1(58)

SCALE: AS NOTED DATE: JUN. 1990

SHEET No. TA4 OF SHEETS