




FED. ROAD DIST. NO.	STATE	FED. AID PROJ. NO.	FISCAL YEAR	SHEET NO.	TOTAL SHEETS
HAWAII	HAW.	I-H3-1(57)	1988		

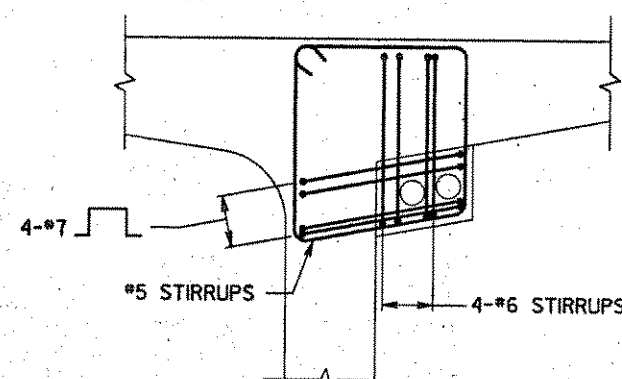


FRONT VIEW

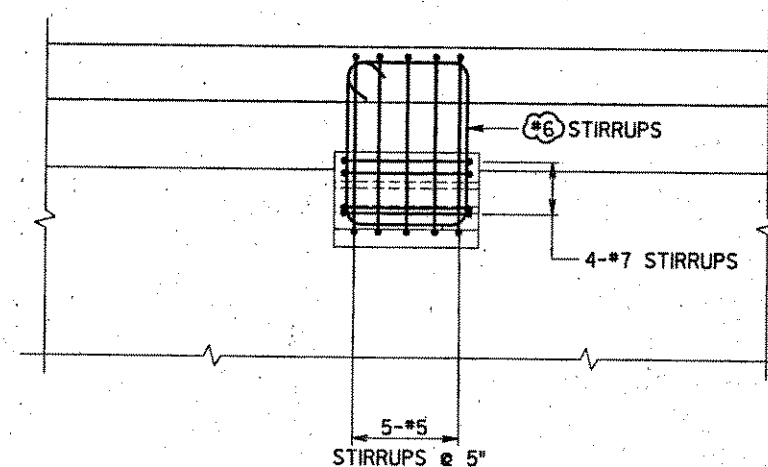

SIDE VIEW

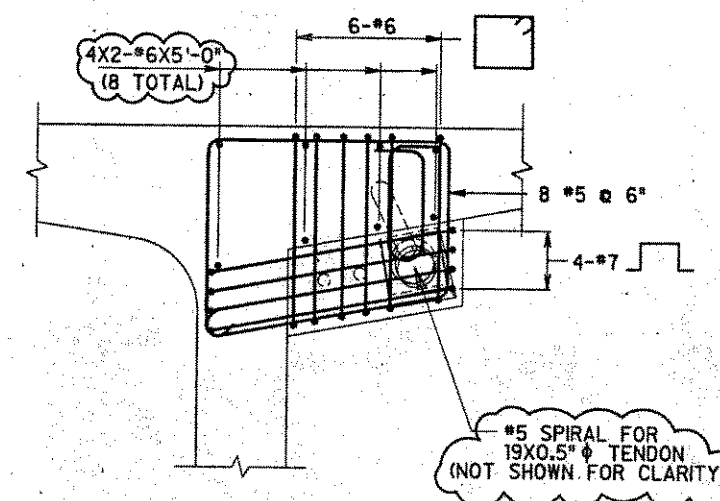


FRONT VIEW

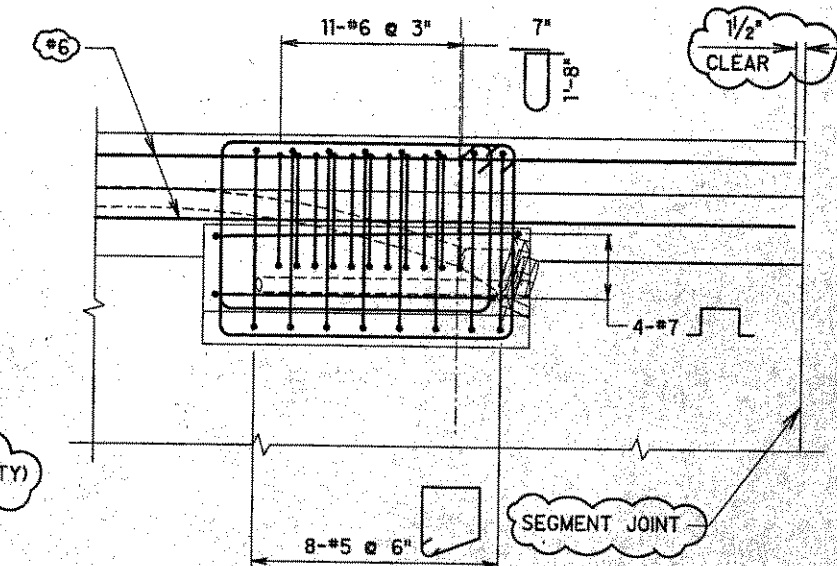


SIDE VIEW


TOP BLOCK 1 & 3
SCALE : 3/4" = 1'-0"

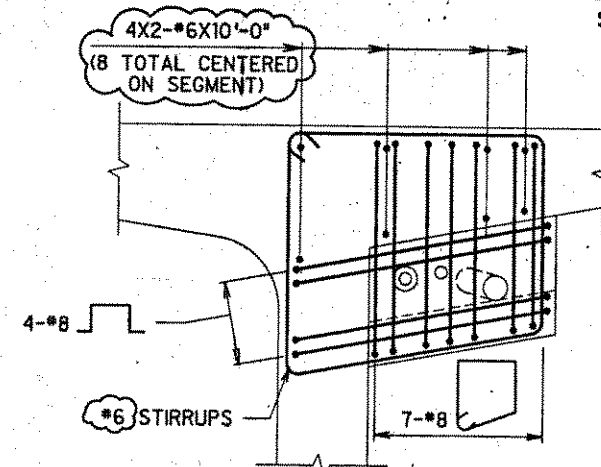

FRONT VIEW

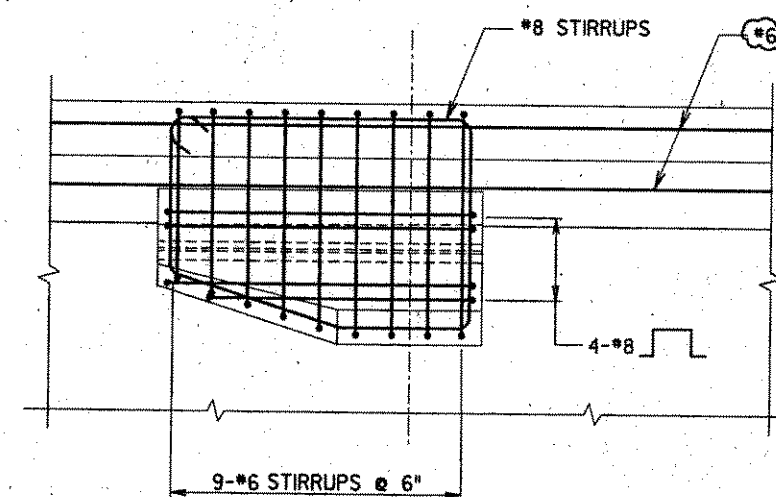


SIDE VIEW

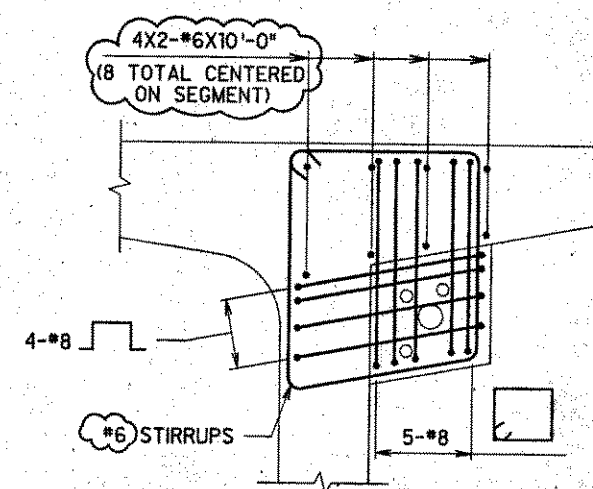

FRONT VIEW

TOP BLOCK 2
SCALE : 3/4" = 1'-0"

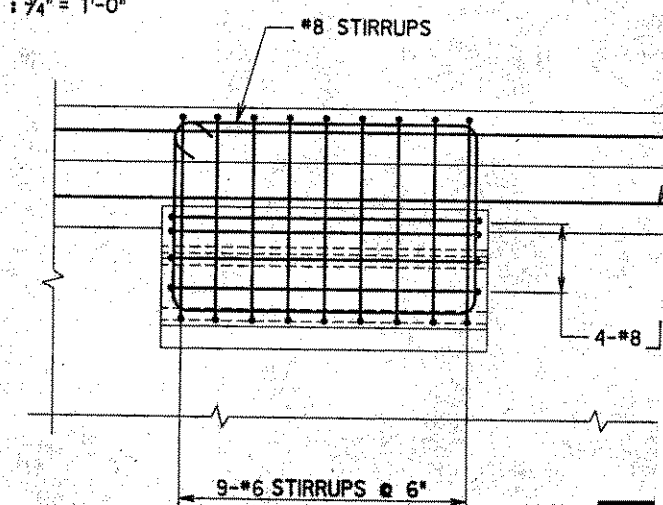

SIDE VIEW

TOP BLOCK 4
SCALE : 3/4" = 1'-0"


DESIGNED BY	DATE
DRAWN BY	
CHECKED BY	
NOTES	

TAG
NEED 1/2 size
1/16" MIN

TOP BLOCK 5
SCALE : 3/4" = 1'-0"

01/21/91 07/25/90	REVISED REINFORCING. UPDATED DRAWING
DATE	REVISION
J. MULLER INTERNATIONAL	Libby Engineers

RECEIVED
SEP 11 1991
HIGHWAY DIVISION

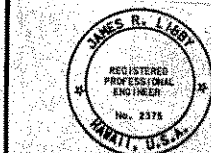

THIS WORK WAS PREPARED BY
ME OR UNDER MY SUPERVISION


STATE OF HAWAII
DEPARTMENT OF TRANSPORTATION
HIGHWAYS DIVISION

POST-TENSIONING DETAILS VI
REINFORCING
TOP BLOCK


INTERSTATE ROUTE H-3
F.A.I. PROJECT No. I-H3-1(57)
F.A.I. PROJECT No. I-H3-1(58)
SCALE : AS NOTED DATE : JUN. 1990

SHEET No. TA6 OF SHEETS

FED. ROAD DIST. NO.	STATE	FED. AID PROJ. NO.	FISCAL YEAR	SHEET NO.	TOTAL SHEETS
HAWAII	HAW.	I-H3-1(57)	1988		

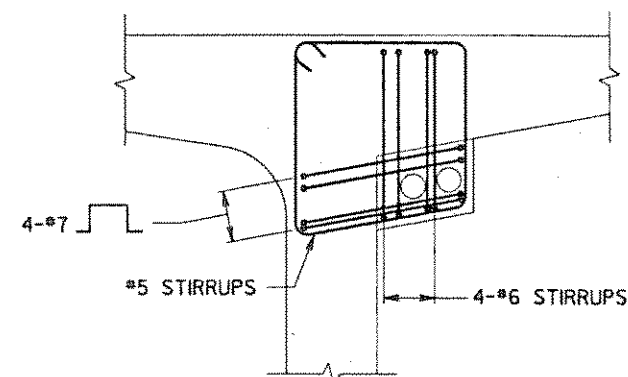


FRONT VIEW

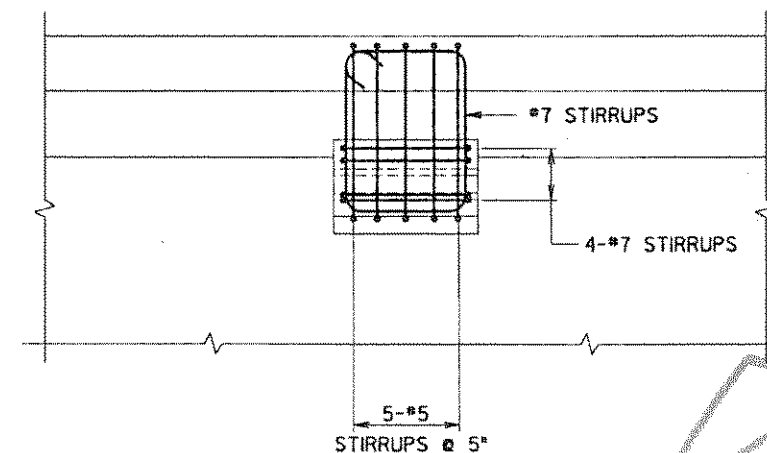


SIDE VIEW

TOP BLOCK 1 & 3
SCALE : $\frac{3}{4}$ " = 1'-0"

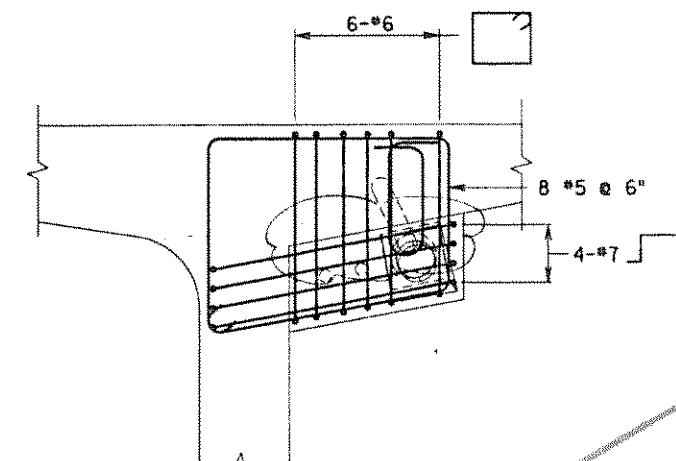


FRONT VIEW

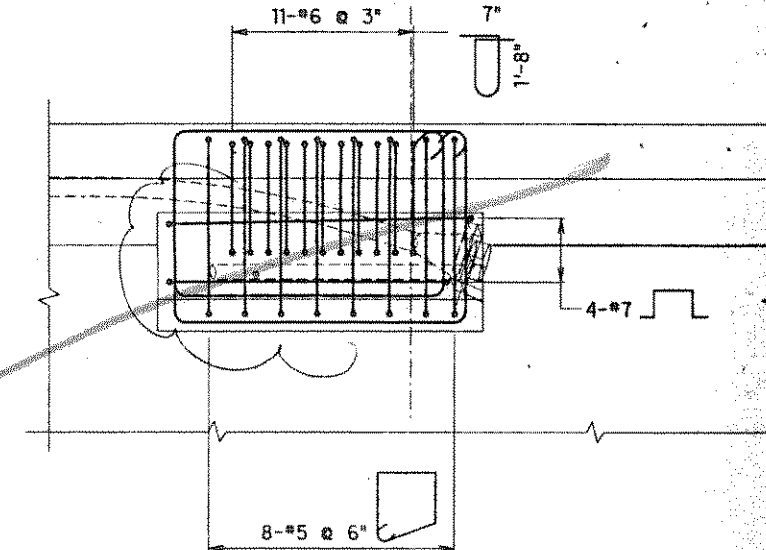


SIDE VIEW

TOP BLOCK 2
SCALE : $\frac{3}{4}$ " = 1'-0"

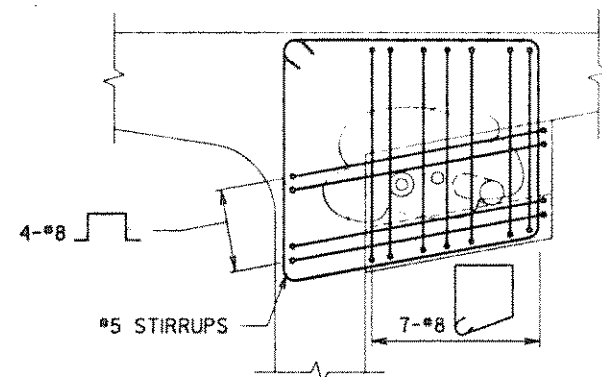


FRONT VIEW

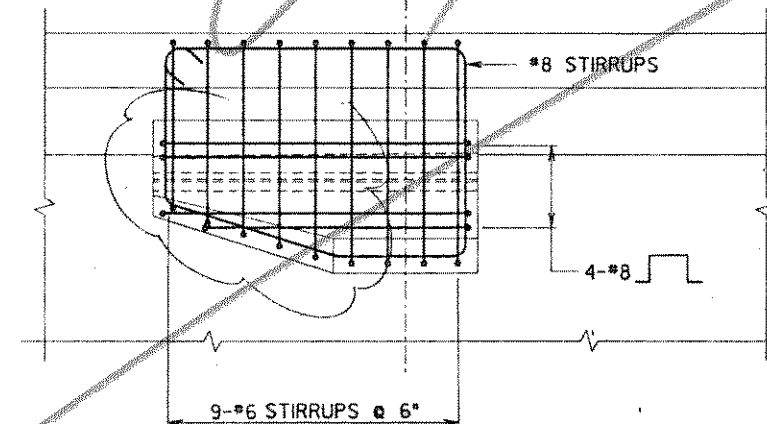


SIDE VIEW

TOP BLOCK 4
SCALE : $\frac{3}{4}$ " = 1'-0"

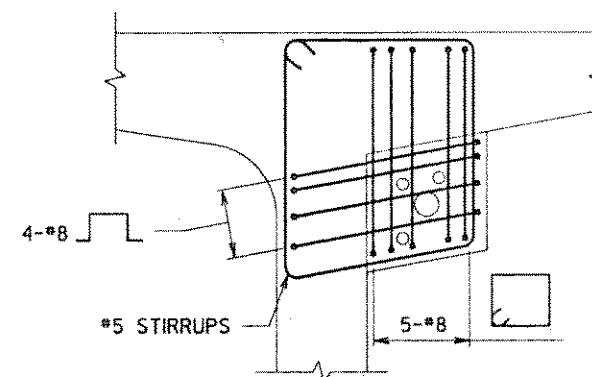

FRONT VIEW

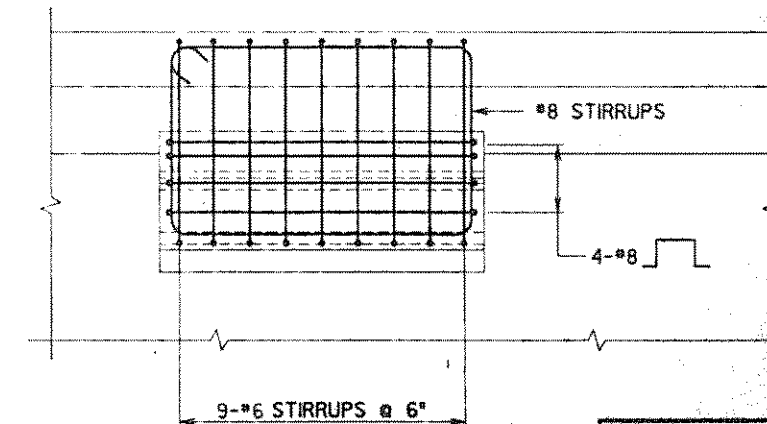

SIDE VIEW

TOP BLOCK 5
SCALE : $\frac{3}{4}$ " = 1'-0"

DESIGNED BY	DATE
DRAWN BY	
CHECKED BY	
NOTED BY	
QUANTITY BY	
CHECKED BY	

07/25/90 UPDATED DRAWING
DATE REVISION

J. MULLER INTERNATIONAL Libby Engineers

RECEIVED
SEA-BLACK
OCT 10 1990
HAWAIIAN AIRPORT

THIS WORK WAS PREPARED BY
ME OR UNDER MY SUPERVISION

STATE OF HAWAII
DEPARTMENT OF TRANSPORTATION
HIGHWAYS DIVISION
POST-TENSIONING DETAILS VI
REINFORCING
TOP BLOCK
INTERSTATE ROUTE H-3
F.A.I. PROJECT No. I-H3-1(57)
F.A.I. PROJECT No. I-H3-1(58)
SCALE : AS NOTED DATE : JUN. 1990