



FED. ROAD DIST. NO.	STATE	FED. AID PROJ. NO.	FISCAL YEAR	SHEET NO.	TOTAL SHEETS
HAWAII	HAW.	I-H3-1 (57)	1988		

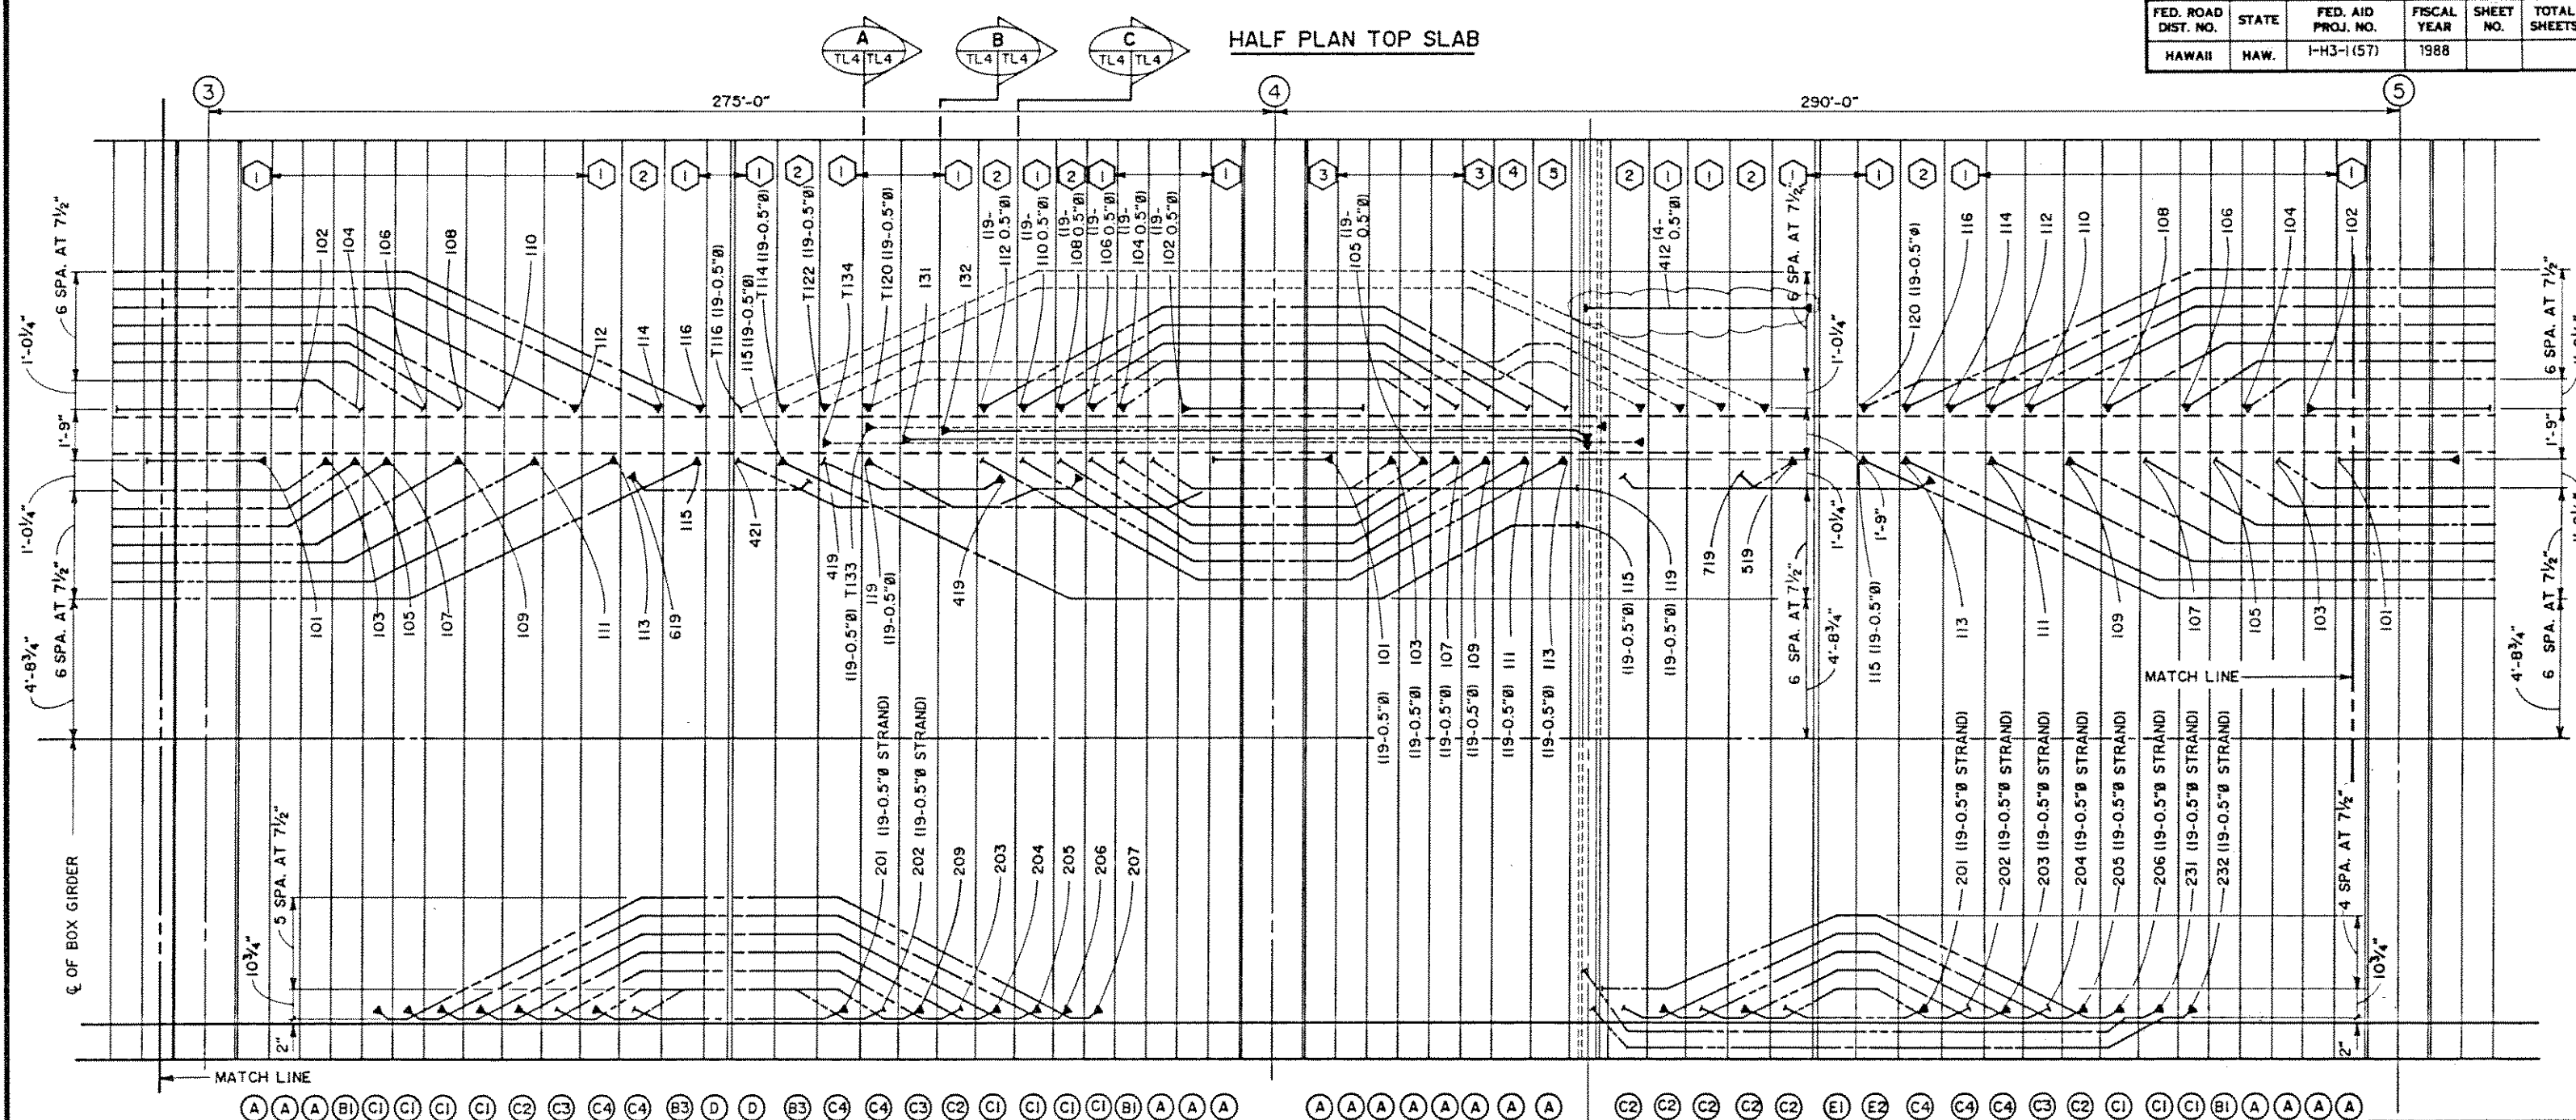

NOTES

1. ALL TENDONS SHOWN ARE 17-0.5" Ø STRAND TENDONS U.M.O.
2.  DENOTES BOTTOM BLOCK TYPES
FOR DETAILS SEE SHEETS TAI AND PT2
3. "T" DENOTES TEMPORARY TENDONS
4.  DENOTES TOP BLOCK TYPES
FOR DETAILS SEE SHEETS TA2 AND PT3
5.  --- DENOTES STRESSING END
6.  --- DENOTES NON-STRESSING END
7. ALL BOTTOM SLAB TENDONS SHALL BE STRESSED AT 216 ksi.
8. ALL TOP SLAB TENDONS SHALL BE STRESSED AT 203 ksi.

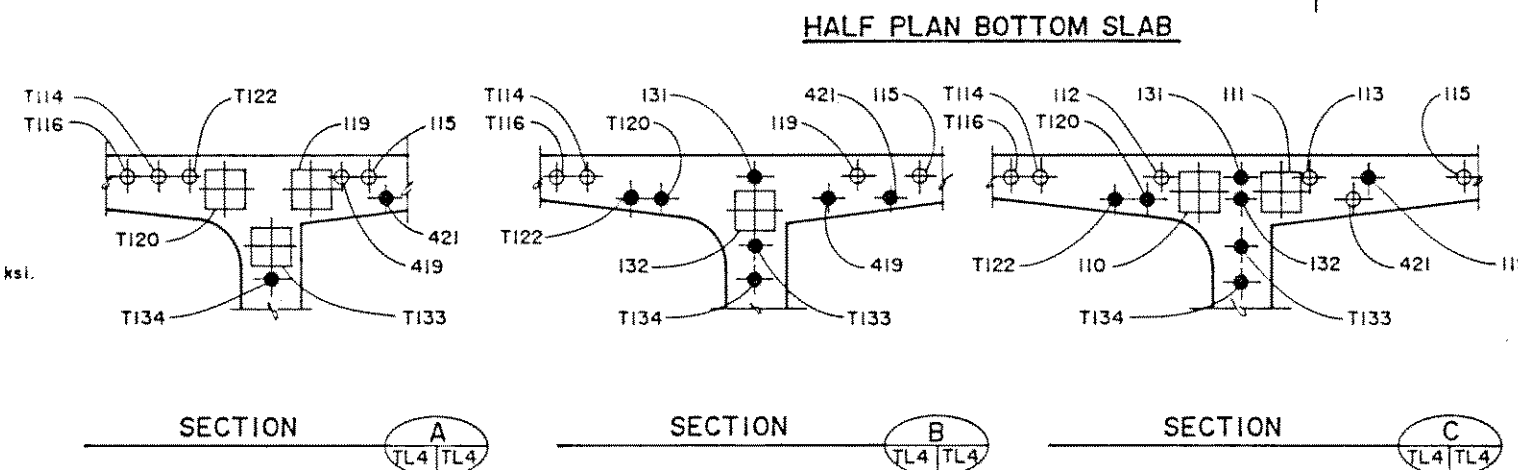

DATE	REVISION	
 J. MULLER INTERNATIONAL	 Libby Engineers	

STATE OF HAWAII
DEPARTMENT OF TRANSPORTATION
HIGHWAYS DIVISION

POST-TENSIONING LAYOUT IV
OUTBOUND PIER 3 THRU PIER 5

INTERSTATE ROUTE H-3
F.A.I. PROJECT No. I-H3-I(57)
F.A.I. PROJECT No. I-H3-I(58)
SCALE : NO SCALE DATE : JUN. 1990
SHEET No. 114 OF SHEETS