


FED. ROAD DIST. NO.	STATE	FED. AID PROJ. NO.	FISCAL YEAR	SHEET NO.	TOTAL SHEETS
HAWAII	HAW.	I-H3-1 (57)	1988		

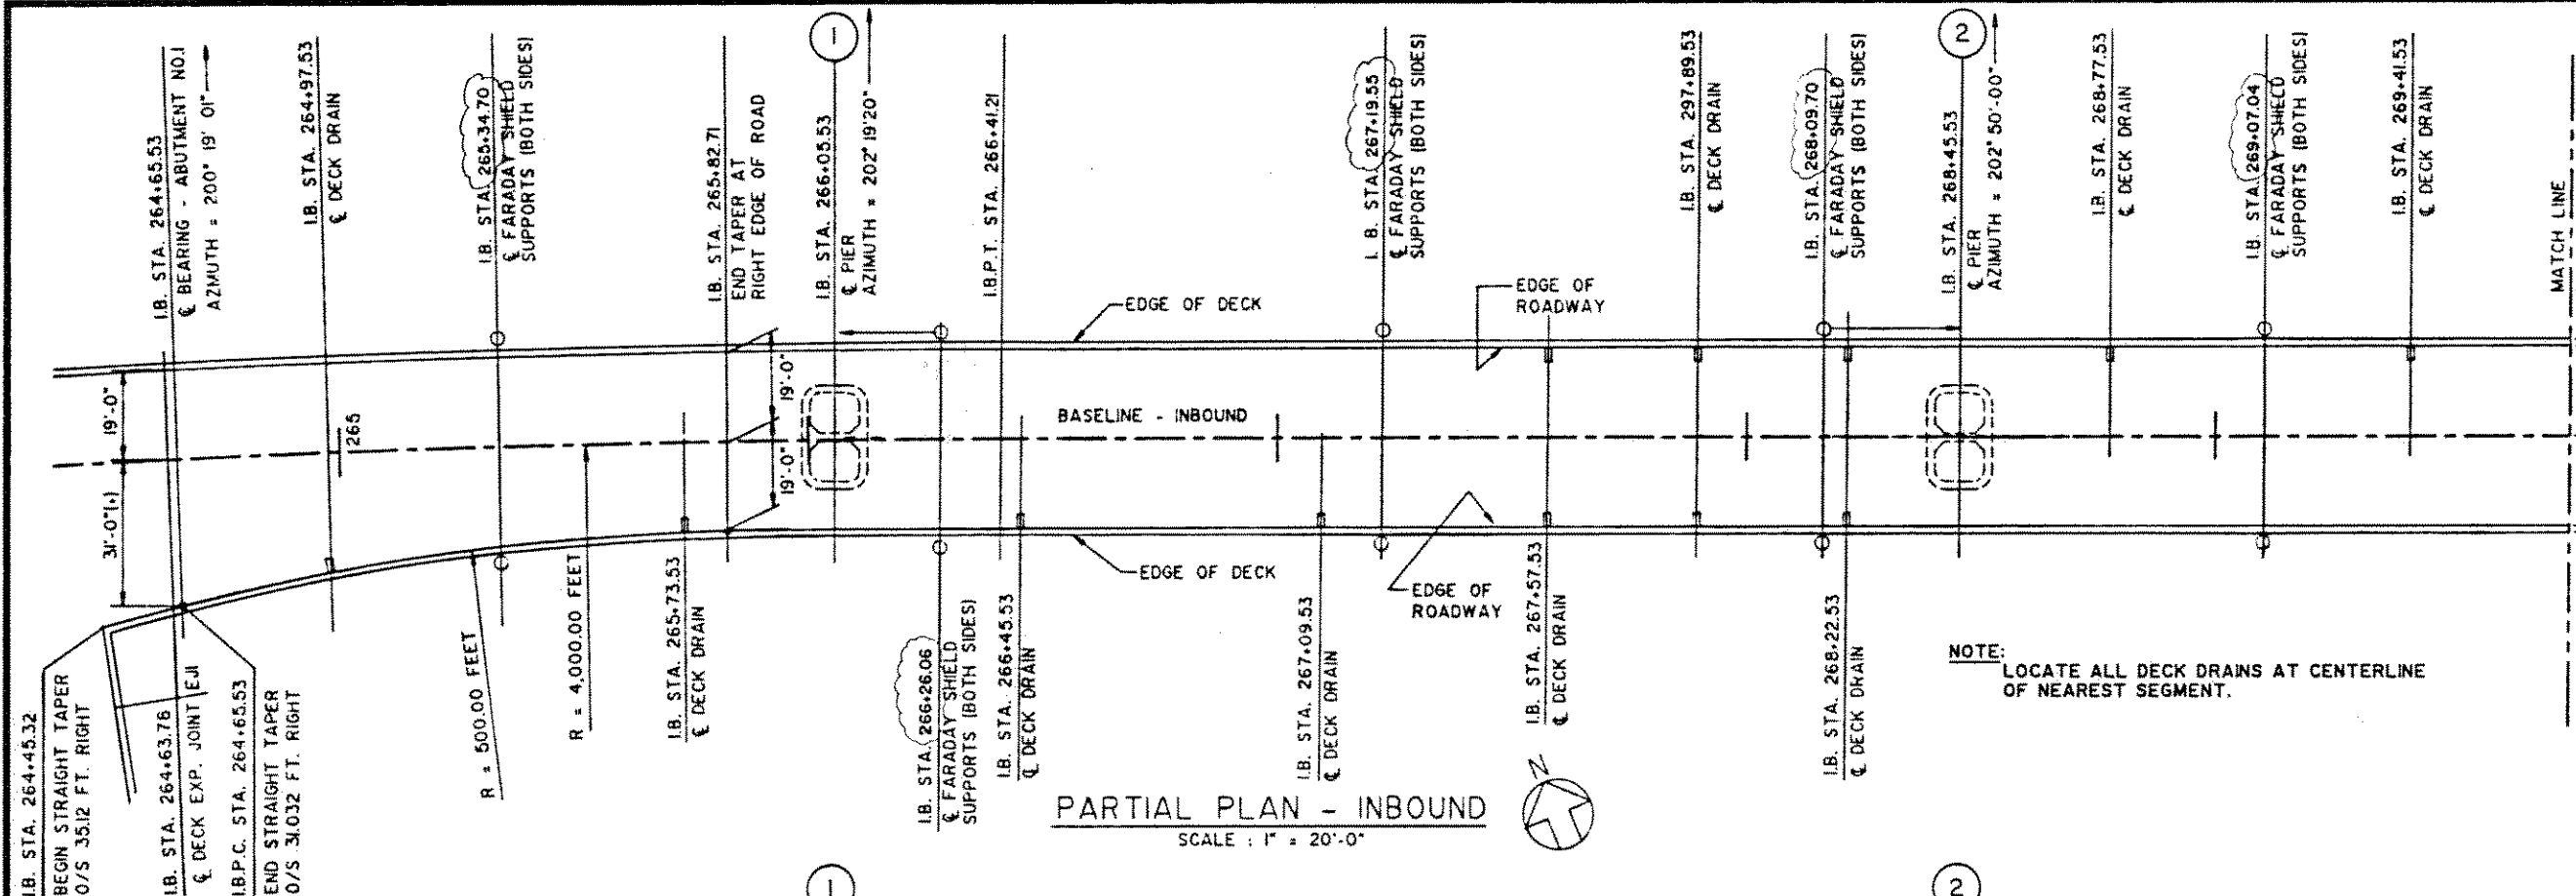


NOTE: FARADAY SHIELD SUPPORT SHALL BE LOCATED RADIALLY TO THE BASELINE.

FOR CONTINUATION SEE SHEET A2

LEGEND:

1. ——— INDICATES GROUND BUSS EXTENDING DOWN PIER TO GROUND ROD.

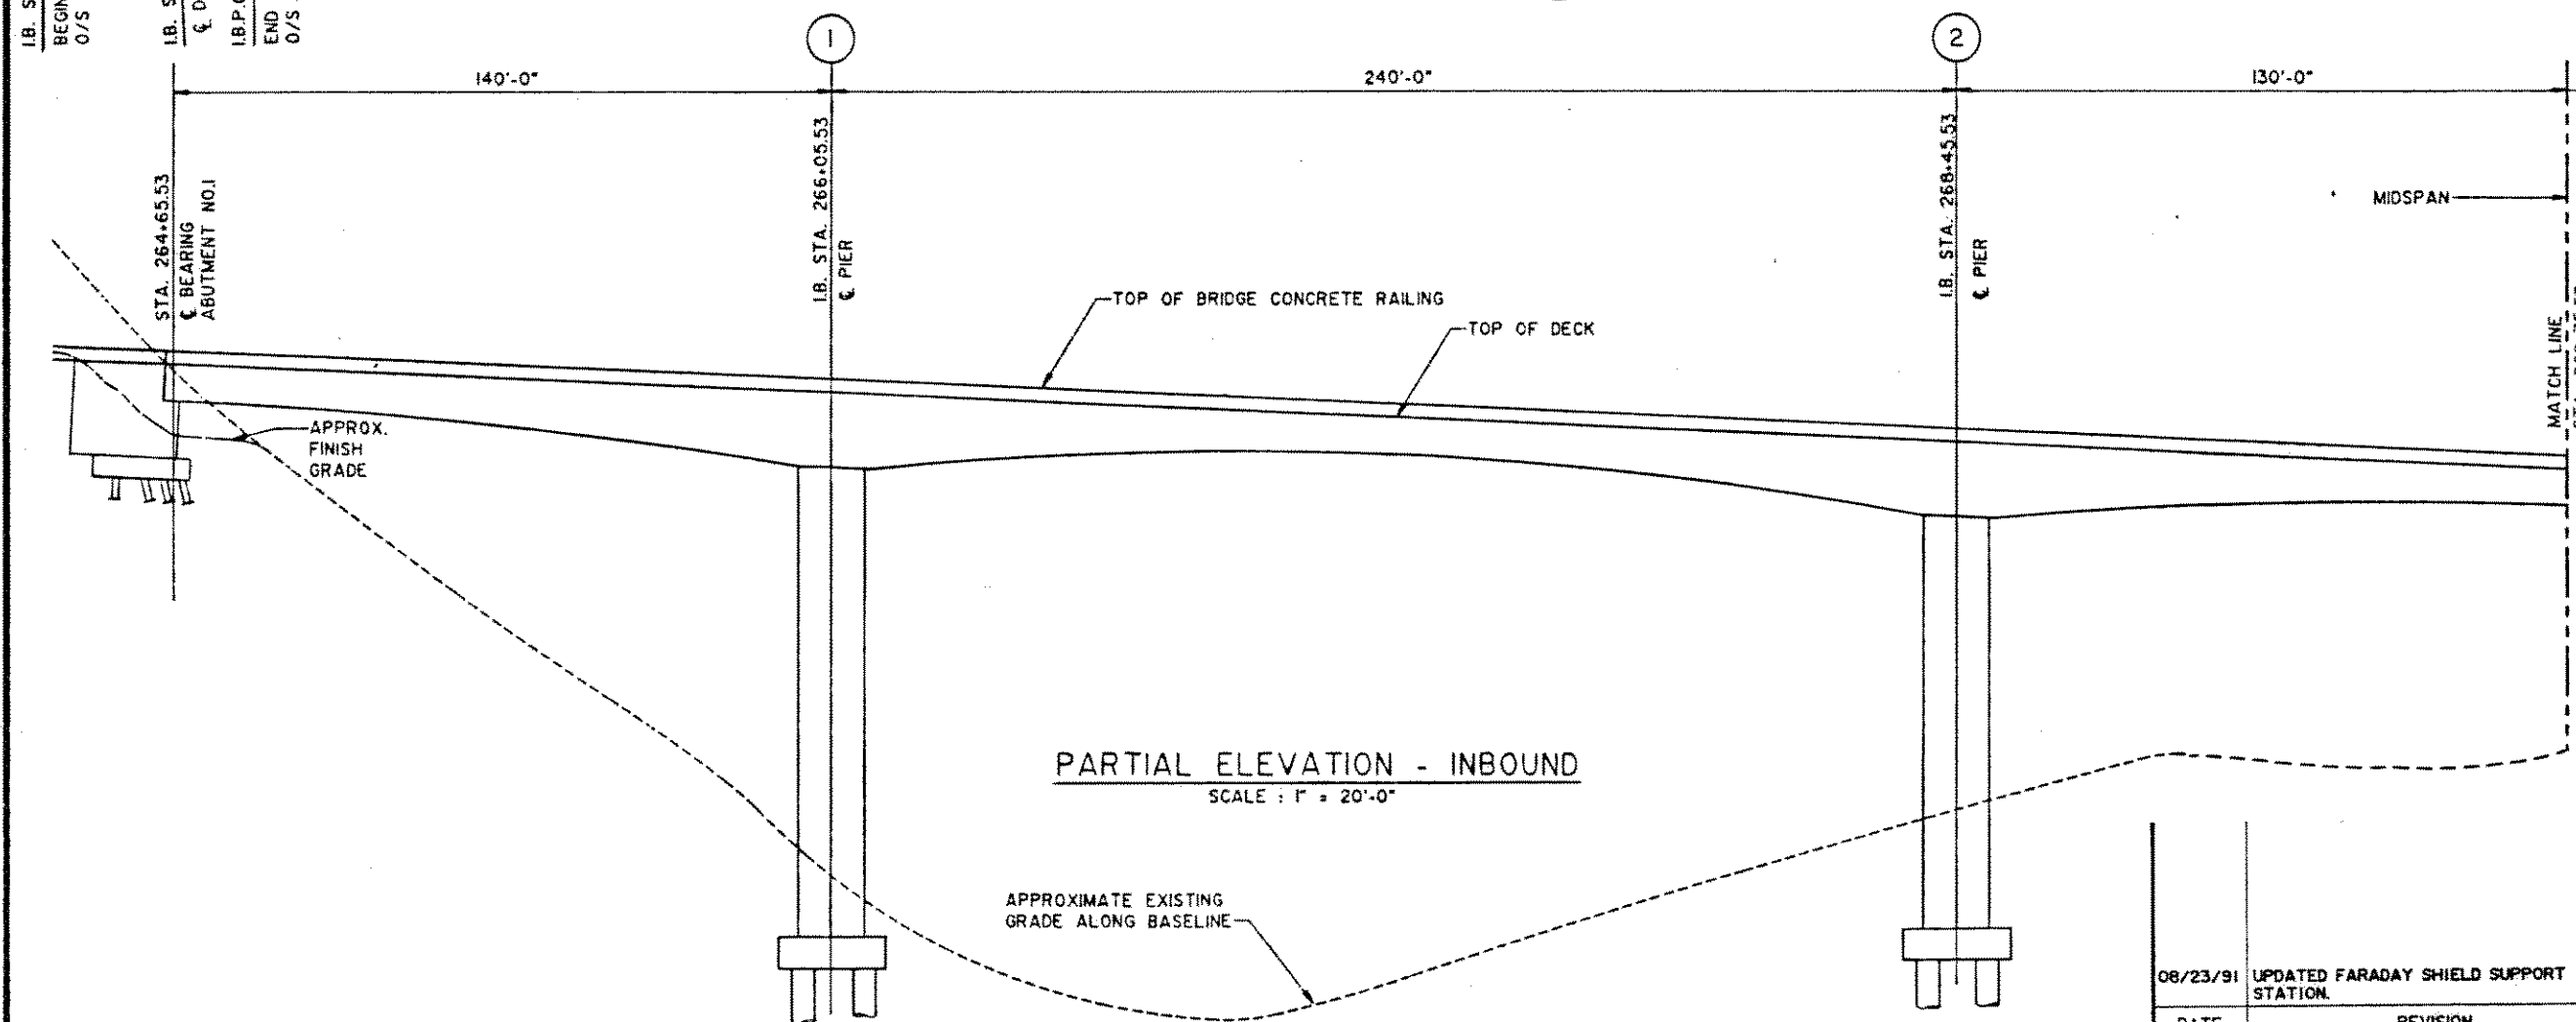


MEASURED ALONG BASELINE

FOR CONTINUATION SEE SHEET A2

DESIGNED BY	DATE
DRAWN BY	2/20
CHECKED BY	2/20
INTEGRITY BY	2/20
DATE	2/20

08/23/91	UPDATED FARADAY SHIELD SUPPORT STATION.
DATE	REVISION
J. MULLER INTERNATIONAL	Libby Engineers

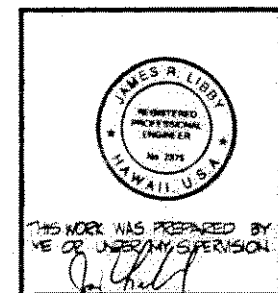

STATE OF HAWAII
DEPARTMENT OF TRANSPORTATION
HIGHWAYS DIVISION
PART. DECK LAYOUT & ELEVATION
ABUTMENT NO. 1 TO STA. 269+75.53
INBOUND STRUCTURE
INTERSTATE ROUTE H-3
F.A.I. PROJECT NO. I-H3-1 (57)
F.A.I. PROJECT NO. I-H3-1 (58)
SCALE: AS NOTED
DATE: JUNE 1990
SHEET NO. A1 OF 24 SHEETS