


FED. ROAD DIST. NO.	STATE	FED. AID PROJ. NO.	FISCAL YEAR	SHEET NO.	TOTAL SHEETS
HAWAII	HAW.	I-H3-1 (57)	1988		

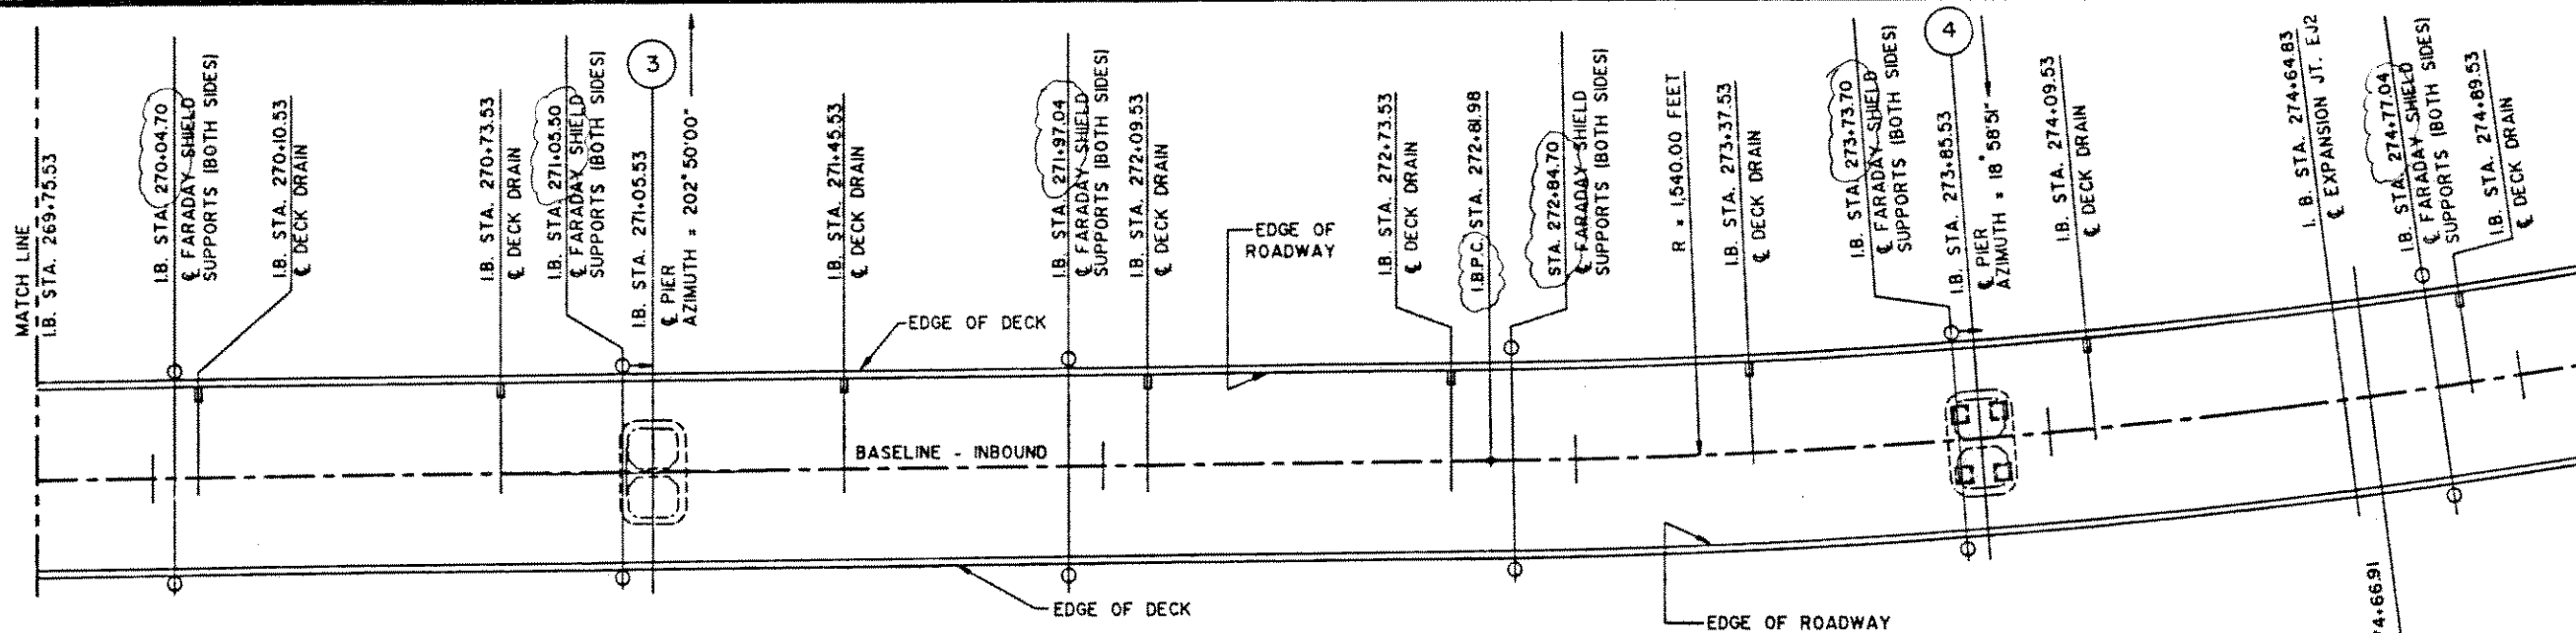


FOR CONTINUATION
SEE SHEET A1

NOTE:
LOCATE ALL DECK DRAINS AT CENTERLINE
OF NEAREST SEGMENT.

PARTIAL PLAN - INBOUND
SCALE: 1" = 20'-0"

LEGEND:
I ——— INDICATES GROUND BUSS EXTENDING
DOWN PIER TO GROUND ROD.

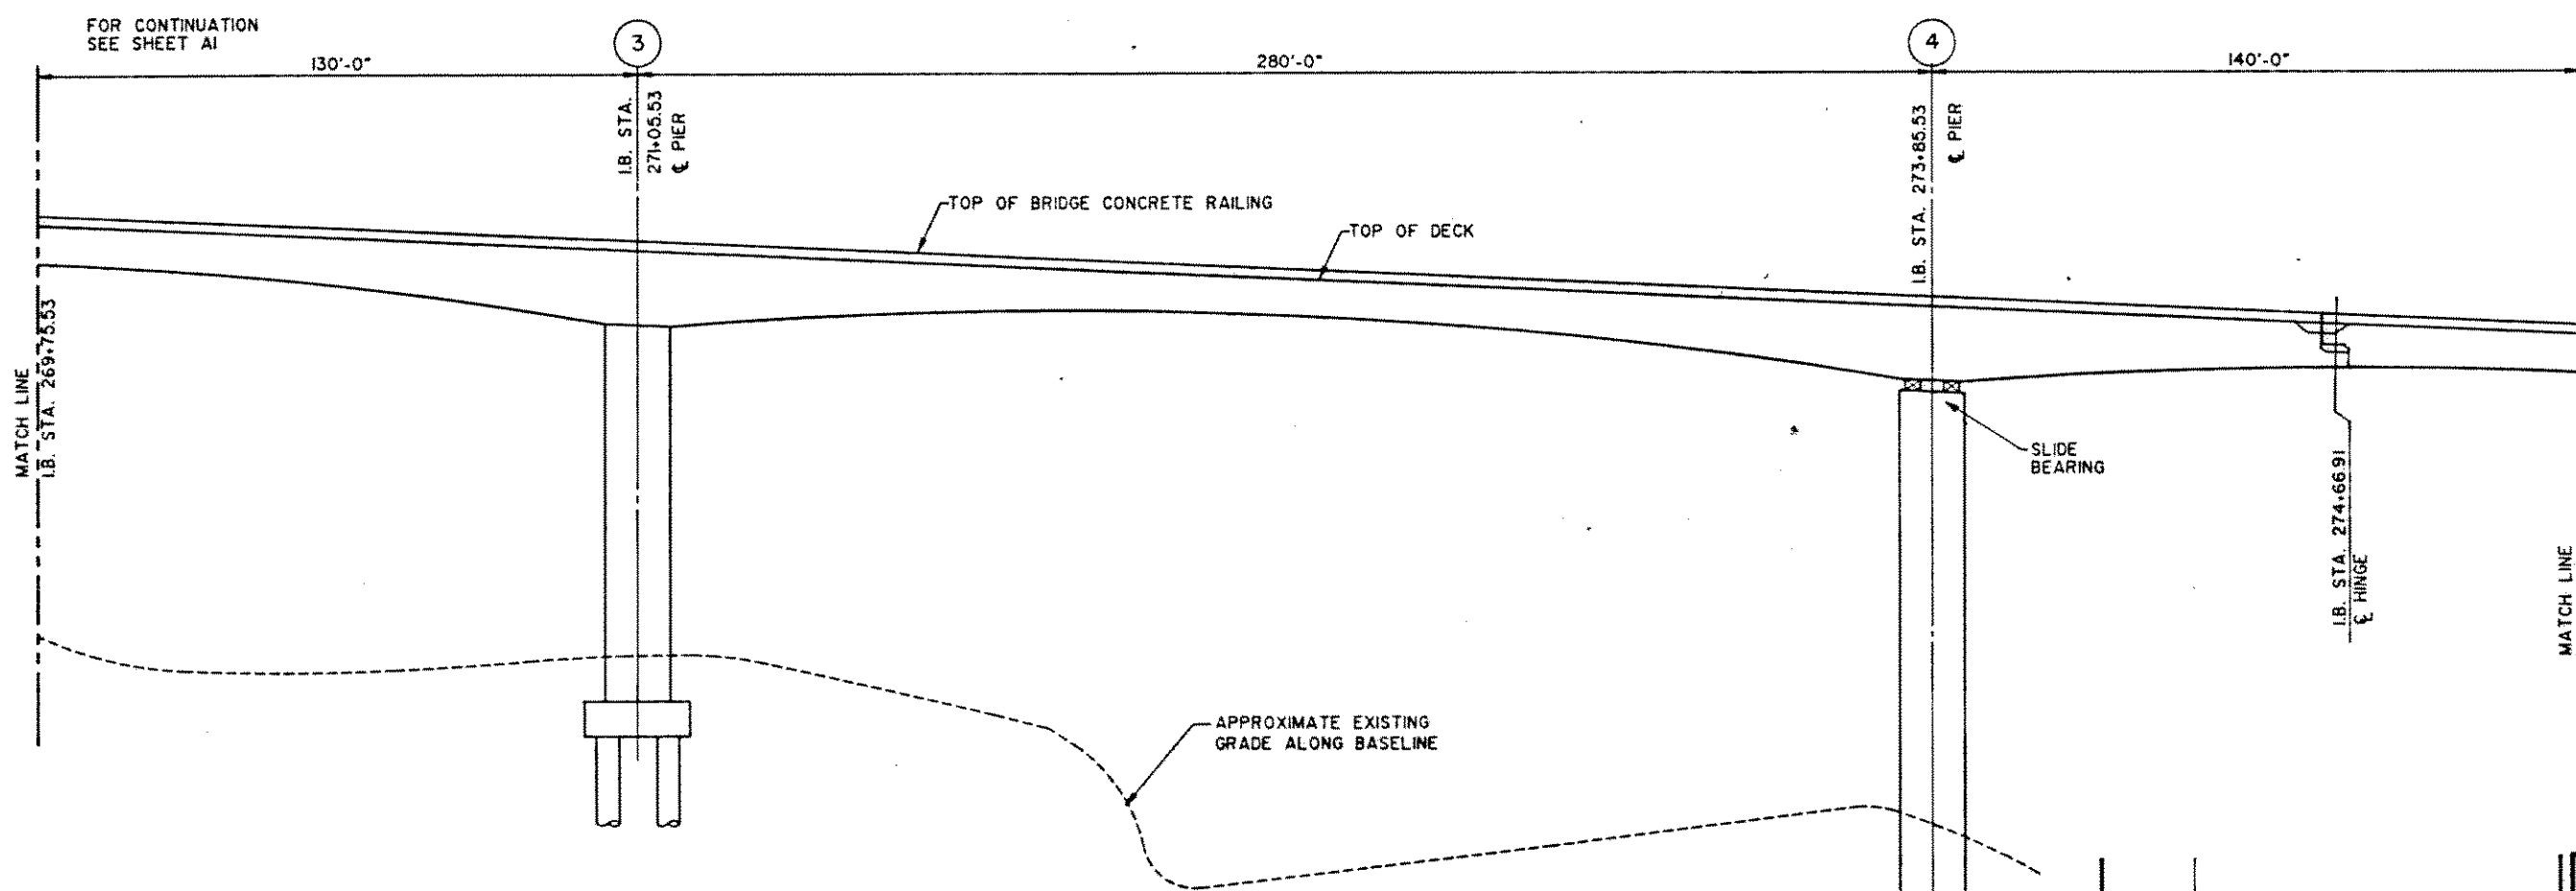

FOR CONTINUATION
SEE SHEET A1

PARTIAL ELEVATION - INBOUND
SCALE: 1" = 20'-0"

FOR CONTINUATION
SEE SHEET A3

DESIGNED BY	DATE
DRAWN BY	2/90
CHECKED BY	2/90
APPROVED BY	2/90
ORIGINAL PLAN	
NOTED	

08/23/91 UPDATED FARADAY SHIELD SUPPORT STATION.

DATE	REVISION
J. MULLER INTERNATIONAL	Libby Engineers

STATE OF HAWAII
DEPARTMENT OF TRANSPORTATION
HIGHWAYS DIVISION

PART. DECK LAYOUT & ELEVATION
STA. 269+75.53 TO STA. 275+25.53
INBOUND STRUCTURE
INTERSTATE ROUTE H-3
F.A.I. PROJECT NO. I-H3-1 (57)
F.A.I. PROJECT NO. I-H3-1 (58)
SCALE: AS NOTED DATE: JUNE 1990

SHEET No. A2 OF 24 SHEETS

JAMES R. LIBBY
REGISTERED PROFESSIONAL ENGINEER
NO. 2274
HAWAII, U.S.A.

THIS WORK WAS PREPARED BY
ME OR UNDER MY SUPERVISION