



FED. ROAD DIST. NO.	STATE	FED. AID PROJ. NO.	FISCAL YEAR	SHEET NO.	TOTAL SHEETS
HAWAII	HAW.	I-H3-1 (57)	1988		

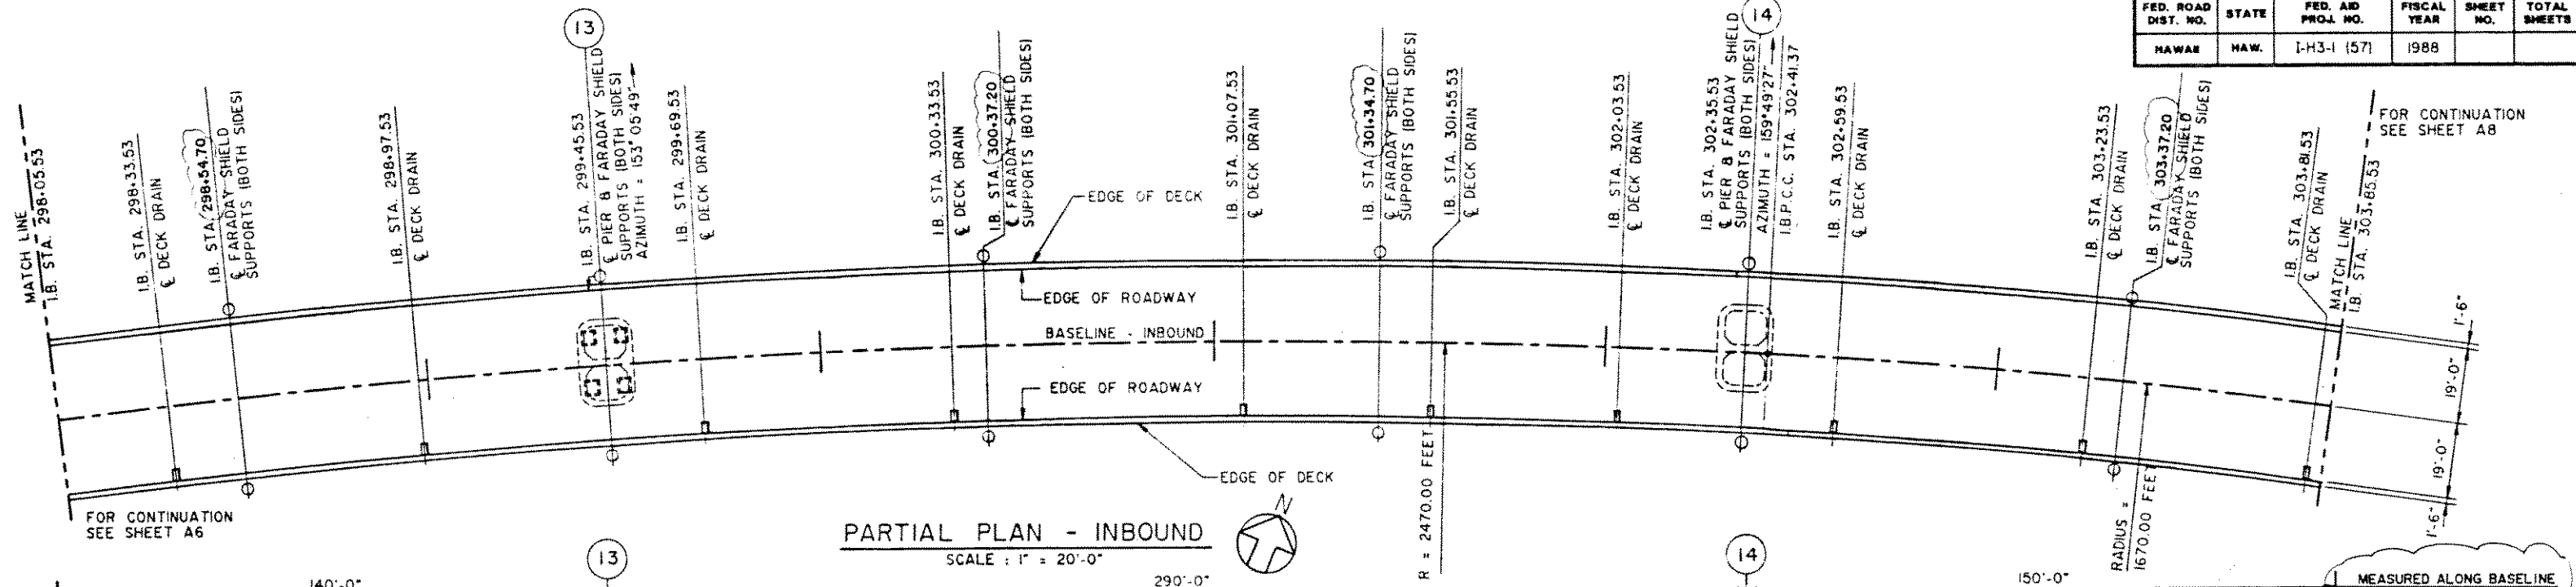

PARTIAL PLAN - INBOUND
SCALE : 1" = 20'-0"

NOTE:
LOCATE ALL DECK DRAINS AT CENTERLINE
OF NEAREST SEGMENT.

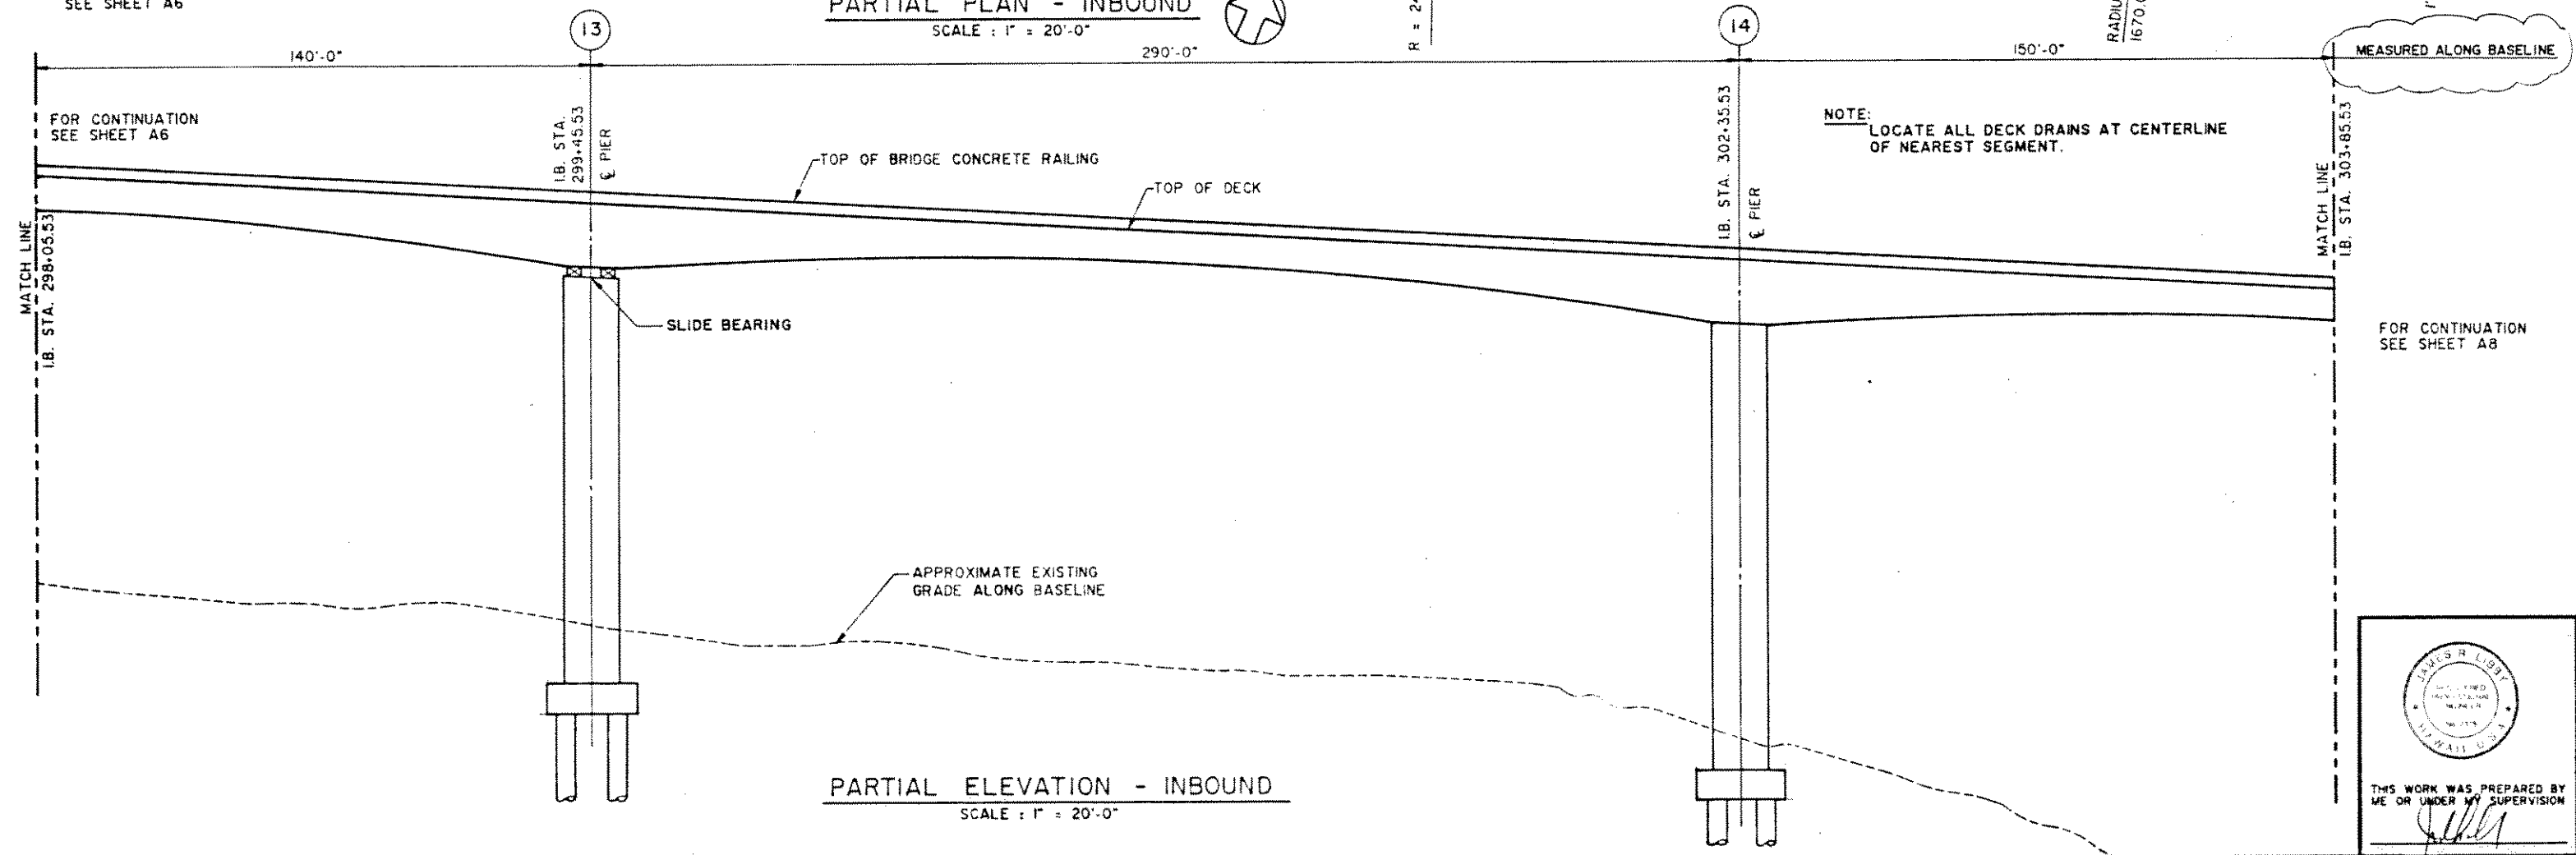

PARTIAL ELEVATION - INBOUND
SCALE : 1" = 20'-0"


LEGEND:

1. ——— INDICATES GROUND BUSS EXTENDING
DOWN PIER TO GROUND ROD.

SURVEY PLANNED BY	DATE
DRAWN BY	
DESIGNED BY	
CHECKED BY	
APPROVED BY	

08/23/91	UPDATED FARADAY SHIELD SUPPORT STA. AND REMOVED SIGN SUPPORT IP-14.
DATE	REVISION
J. MULLER INTERNATIONAL	Libby Engineers

STATE OF HAWAII DEPARTMENT OF TRANSPORTATION HIGHWAYS DIVISION
PART. DECK LAYOUT & ELEVATION STA. 298+05.53 TO STA. 303+85.53 INBOUND STRUCTURE INTERSTATE ROUTE H-3 F.A.I. PROJECT NO. I-H3-1 (57) F.A.I. PROJECT NO. I-H3-1 (58) SCALE: AS NOTED DATE: JUNE 1990 SHEET No. A7 OF 24 SHEETS

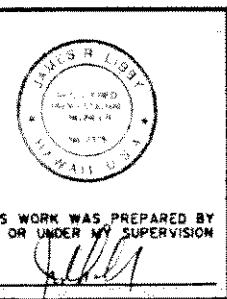

THIS WORK WAS PREPARED BY
ME OR UNDER MY SUPERVISION