


FED. ROAD DIST. NO.	STATE	FED. AID PROJ. NO.	FISCAL YEAR	SHEET NO.	TOTAL SHEETS
HAWAII	HAW.	I-H3-1 (57)	1988		

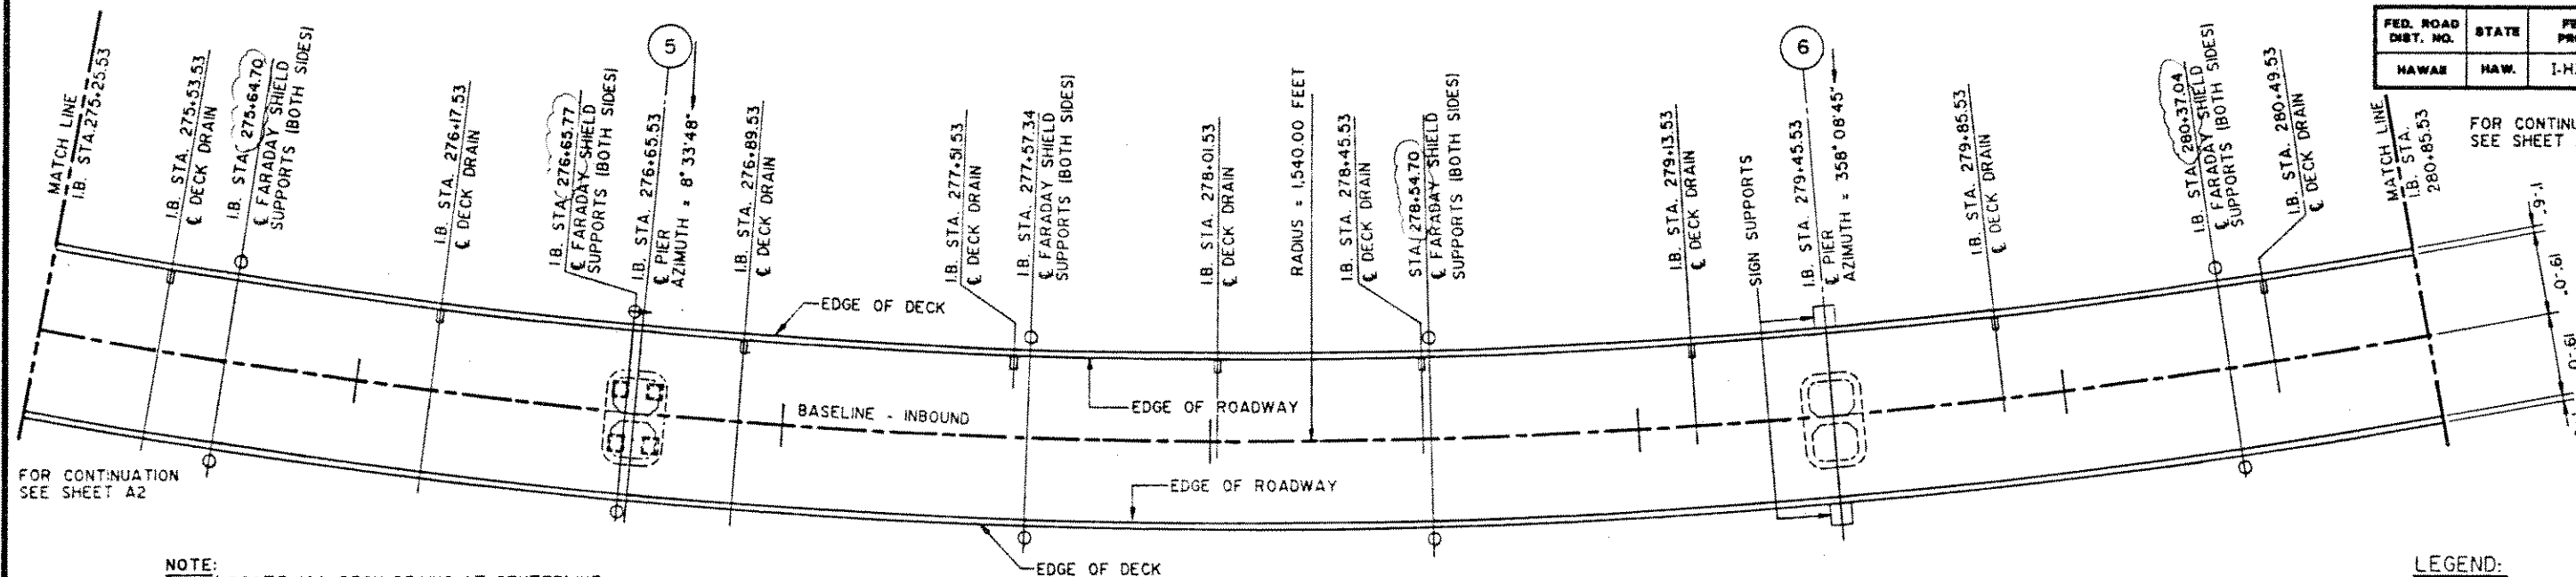


FOR CONTINUATION
SEE SHEET A4

NOTE:
LOCATE ALL DECK DRAINS AT CENTERLINE
OF NEAREST SEGMENT.

LEGEND:

1. ——— INDICATES GROUND BUSS EXTENDING
DOWN PIER TO GROUND ROD.

PARTIAL PLAN - INBOUND
SCALE: 1" = 20'-0"

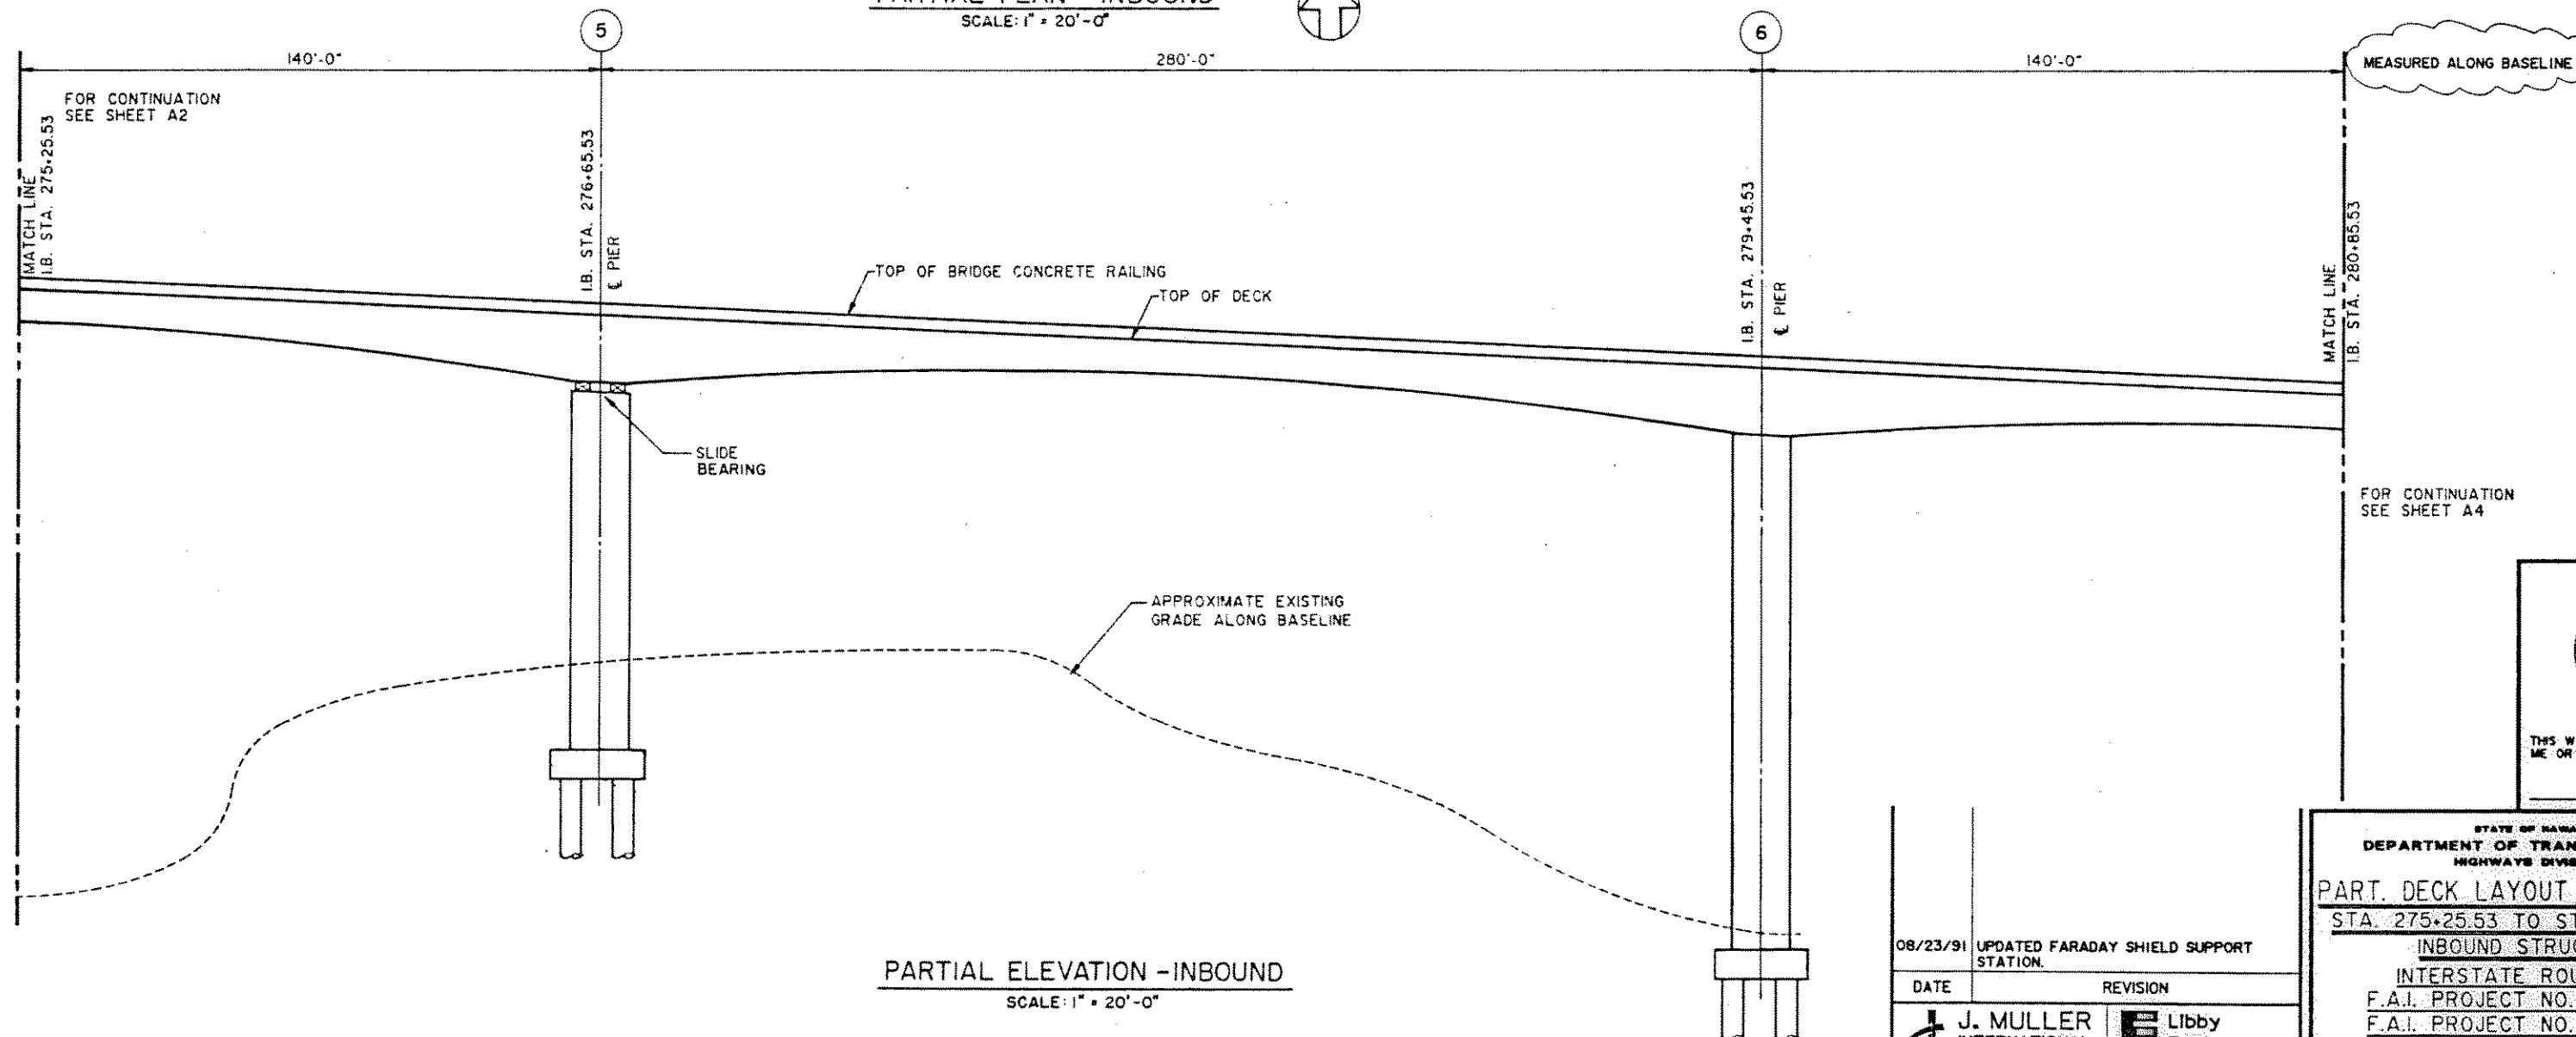

PARTIAL ELEVATION - INBOUND
SCALE: 1" = 20'-0"



THIS WORK WAS PREPARED BY
ME OR UNDER MY SUPERVISION

08/23/91	UPDATED FARADAY SHIELD SUPPORT STATION.
DATE	REVISION
J. MULLER INTERNATIONAL	Libby Engineers

STATE OF HAWAII
DEPARTMENT OF TRANSPORTATION
HIGHWAYS DIVISION

PART. DECK LAYOUT & ELEVATION
STA. 275.25.53 TO STA. 280.85.53
INBOUND STRUCTURE
INTERSTATE ROUTE H-3
F.A.I. PROJECT NO. I-H3-1 (57)
F.A.I. PROJECT NO. I-H3-1 (58)
SCALE: AS NOTED DATE: JUNE 1990

SHEET No. A3 OF 24 SHEETS