



FED. ROAD DIST. NO.	STATE	FED. AID PROJ. NO.	FISCAL YEAR	SHEET NO.	TOTAL SHEETS
HAWAII	HAW.	I-H3-1 (57)	1988		

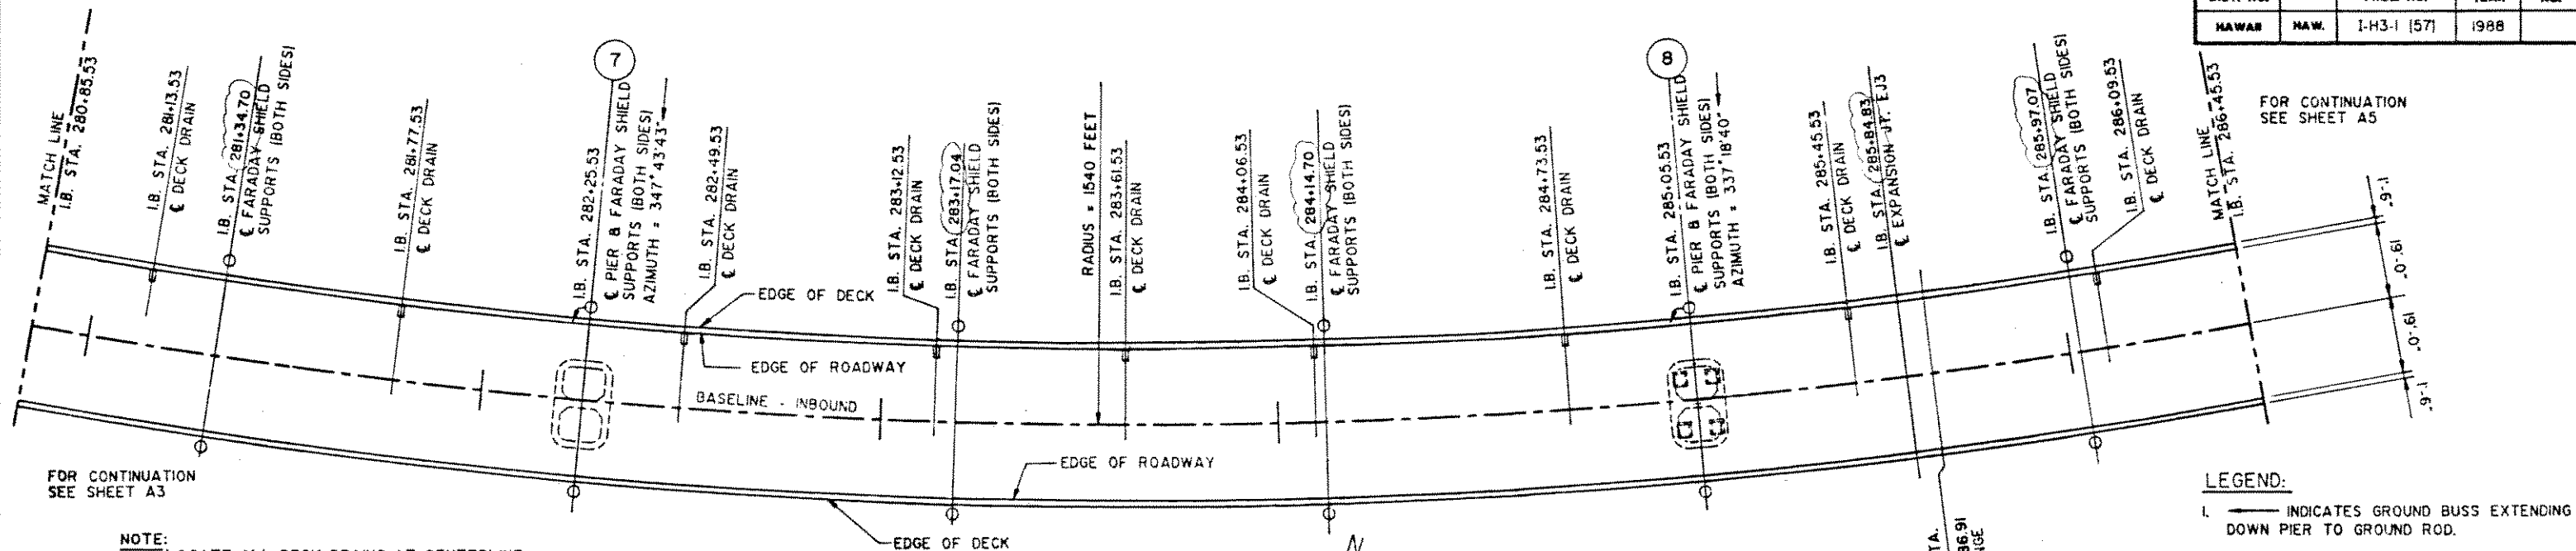

PARTIAL PLAN - INBOUND

SCALE : 1" = 20'-0"

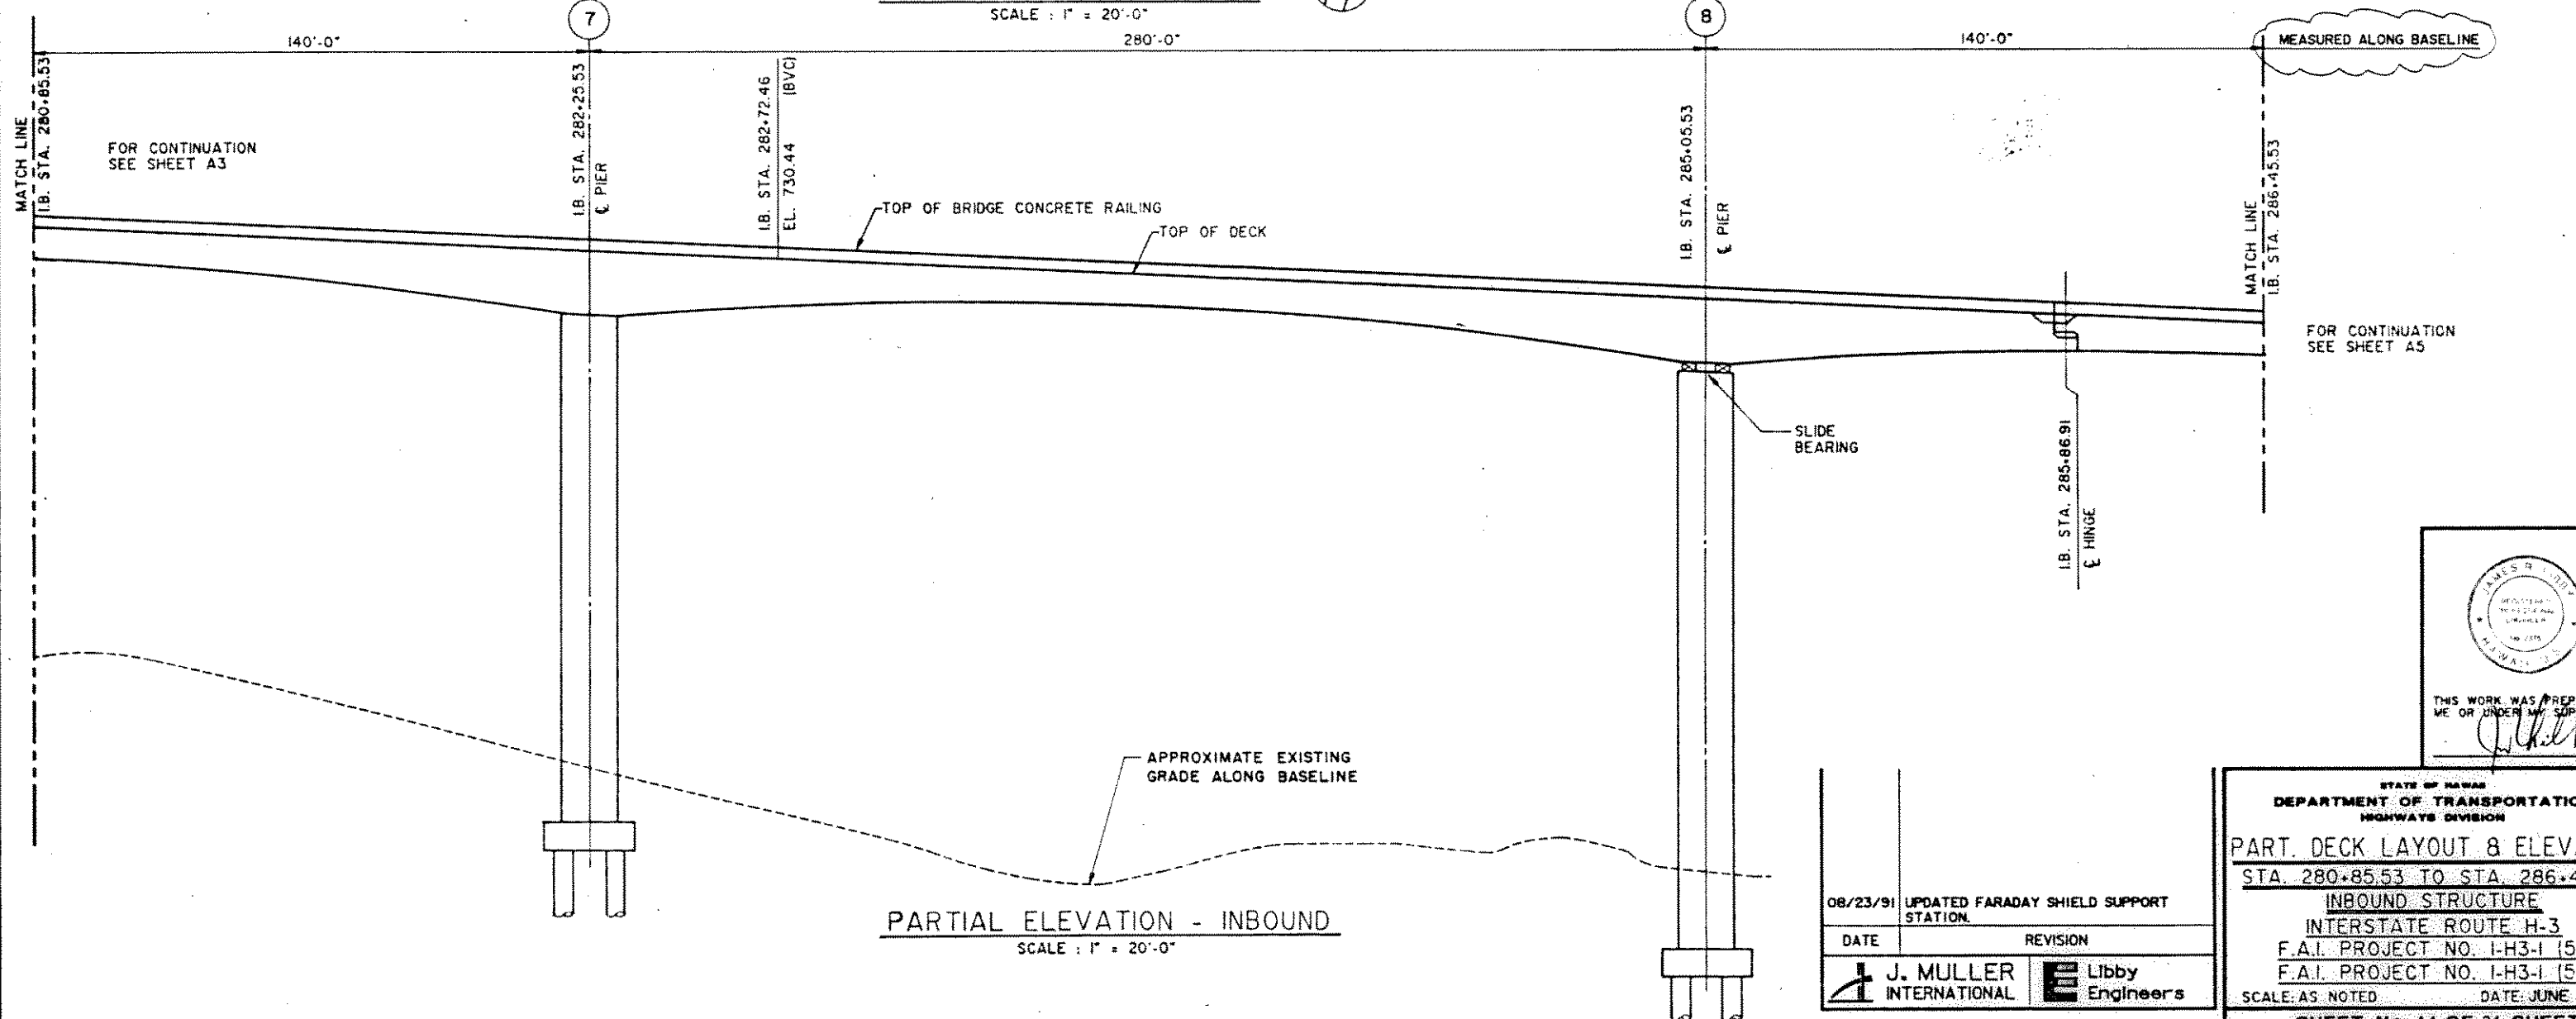

PARTIAL ELEVATION - INBOUND

SCALE : 1" = 20'-0"

08/23/91	UPDATED FARADAY SHIELD SUPPORT STATION.	
DATE	REVISION	
 J. MULLER INTERNATIONAL	 Libby Engineering	

STATE OF MICHIGAN
DEPARTMENT OF TRANSPORTATION
HIGHWAYS DIVISION

PART. DECK LAYOUT & ELEVATION

STA. 280+85.53 TO STA. 286+45.53

INBOUND STRUCTURE

INTERSTATE ROUTE H-3

F.A.I. PROJECT NO. I-H3-1 [57]

F.A.I. PROJECT NO. I-H3-1 [58]

SCALE: AS NOTED DATE: JUNE 1990

SHEET No. A4 OF 24 SHEETS