



FED. ROAD DIST. NO.	STATE	FED. AID PROJ. NO.	FISCAL YEAR	SHEET NO.	TOTAL SHEETS
HAWAII	HAW.	I-H3-1 (57)	1988		


FOR CONTINUATION
SEE SHEET A6

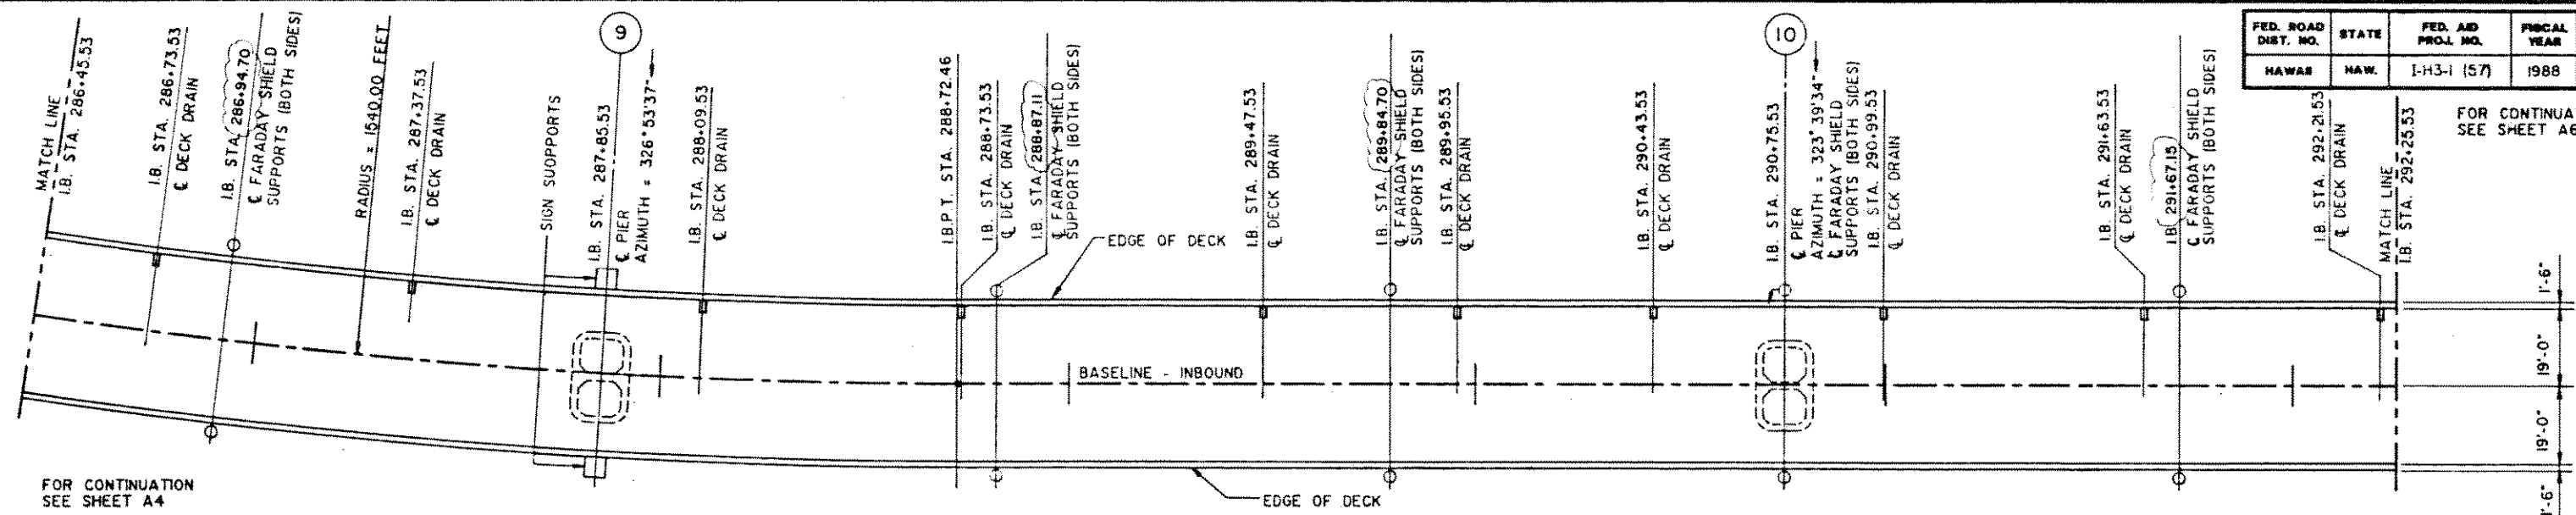

PARTIAL PLAN - INBOUND
SCALE : 1" = 20'-0"

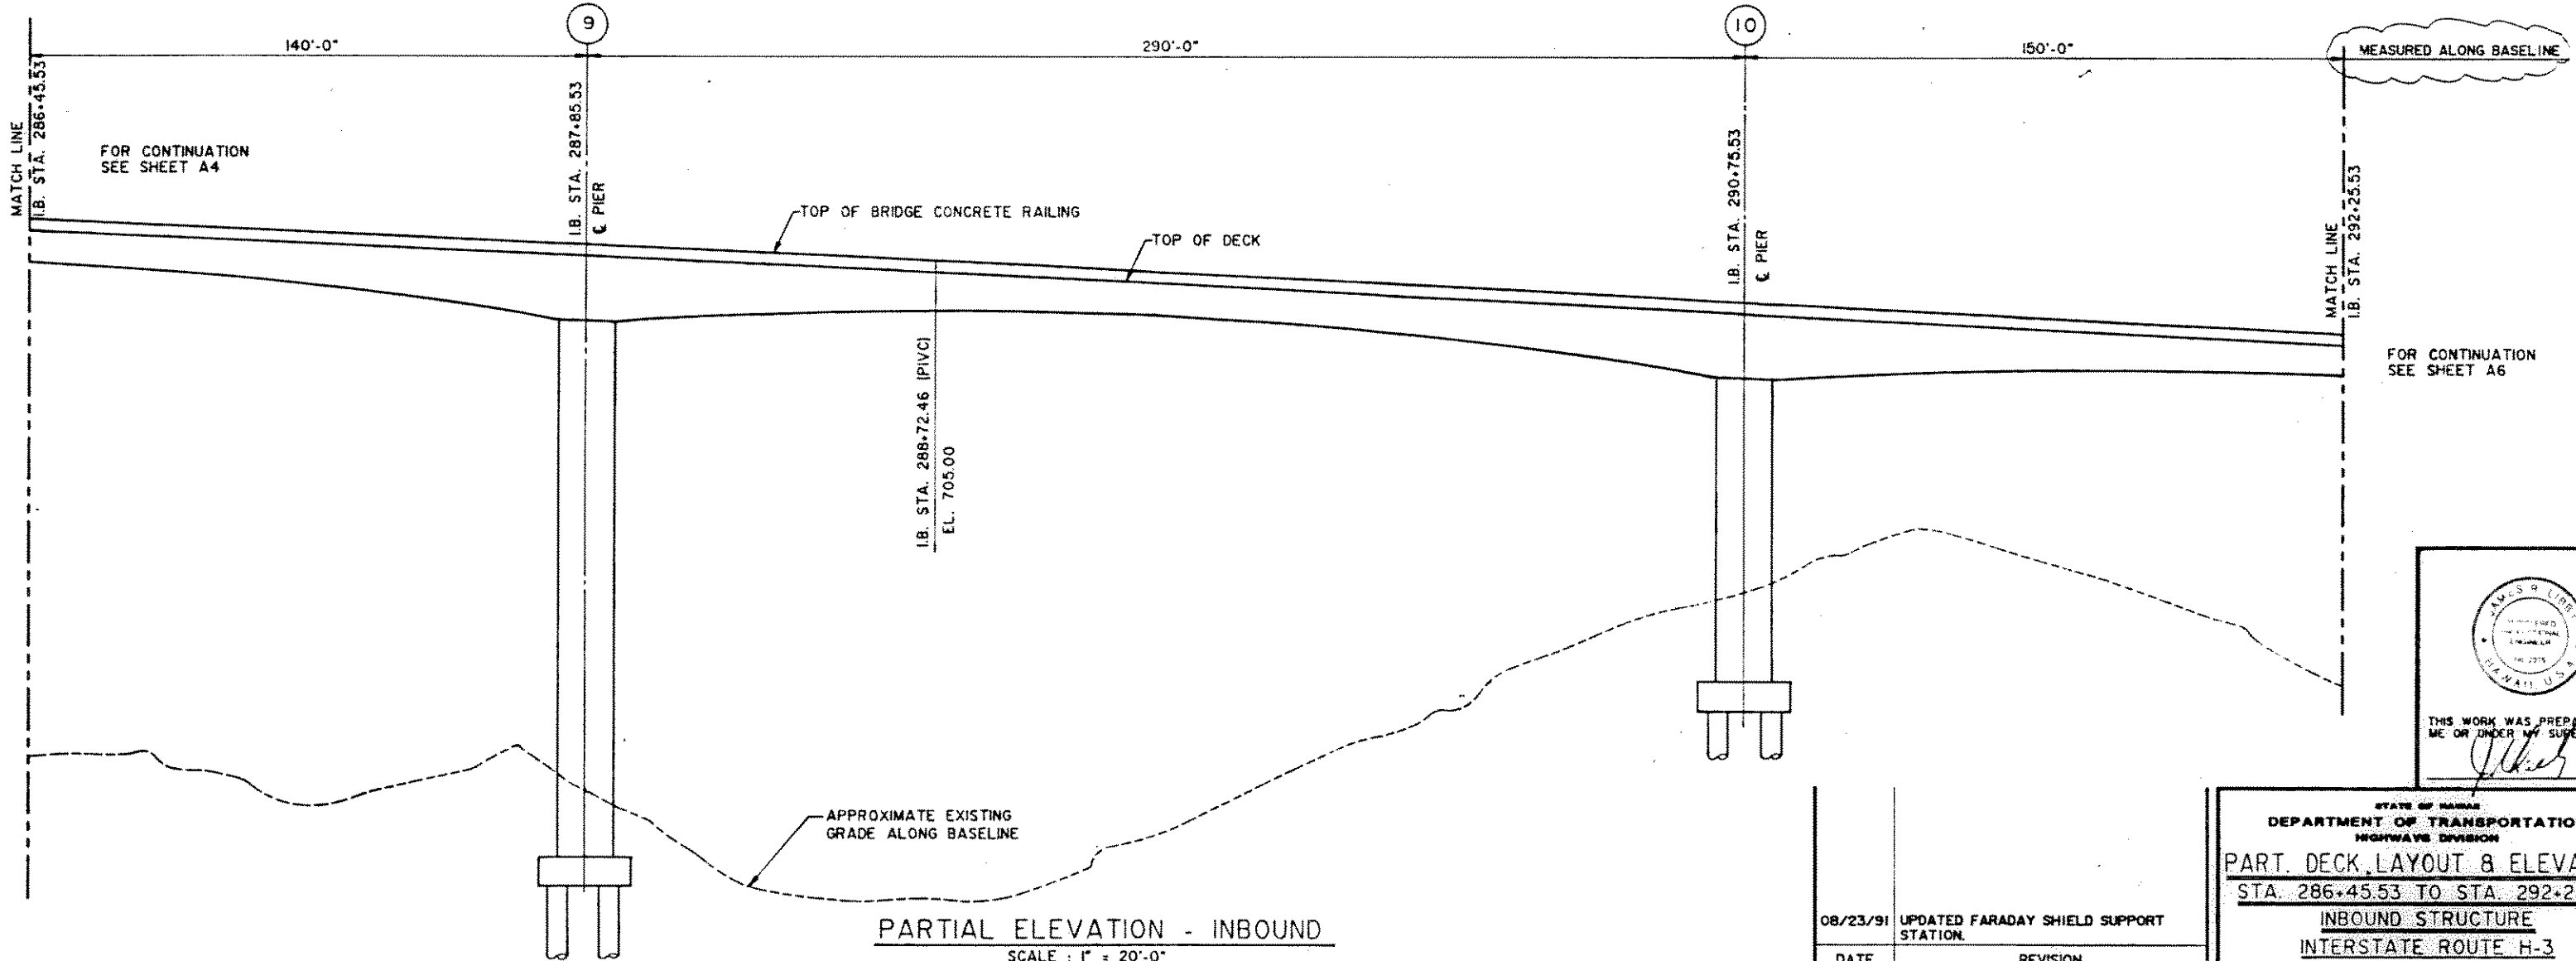

PARTIAL ELEVATION - INBOUND
SCALE : 1" = 20'-0"

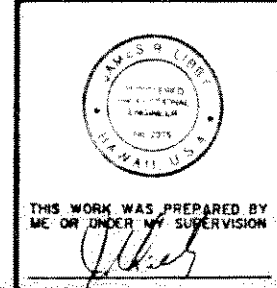

08/23/91	UPDATED FARADAY SHIELD SUPPORT STATION.
DATE	REVISION
J. MULLER INTERNATIONAL	Libby Engineers

STATE OF HAWAII
DEPARTMENT OF TRANSPORTATION
HIGHWAY DIVISION
PART. DECK LAYOUT & ELEVATION
STA. 286+45.53 TO STA. 292+25.53
INBOUND STRUCTURE
INTERSTATE ROUTE H-3
F.A.I. PROJECT NO. I-H3-1 (57)
F.A.I. PROJECT NO. I-H3-1 (58)
SCALE: AS NOTED DATE: JUNE 1990
SHEET No. A5 OF 24 SHEETS

DESIGNED BY	DATE
DRAWN BY	
CHECKED BY	
NOTED BY	
QUANTITY BY	
ORDERED BY	