
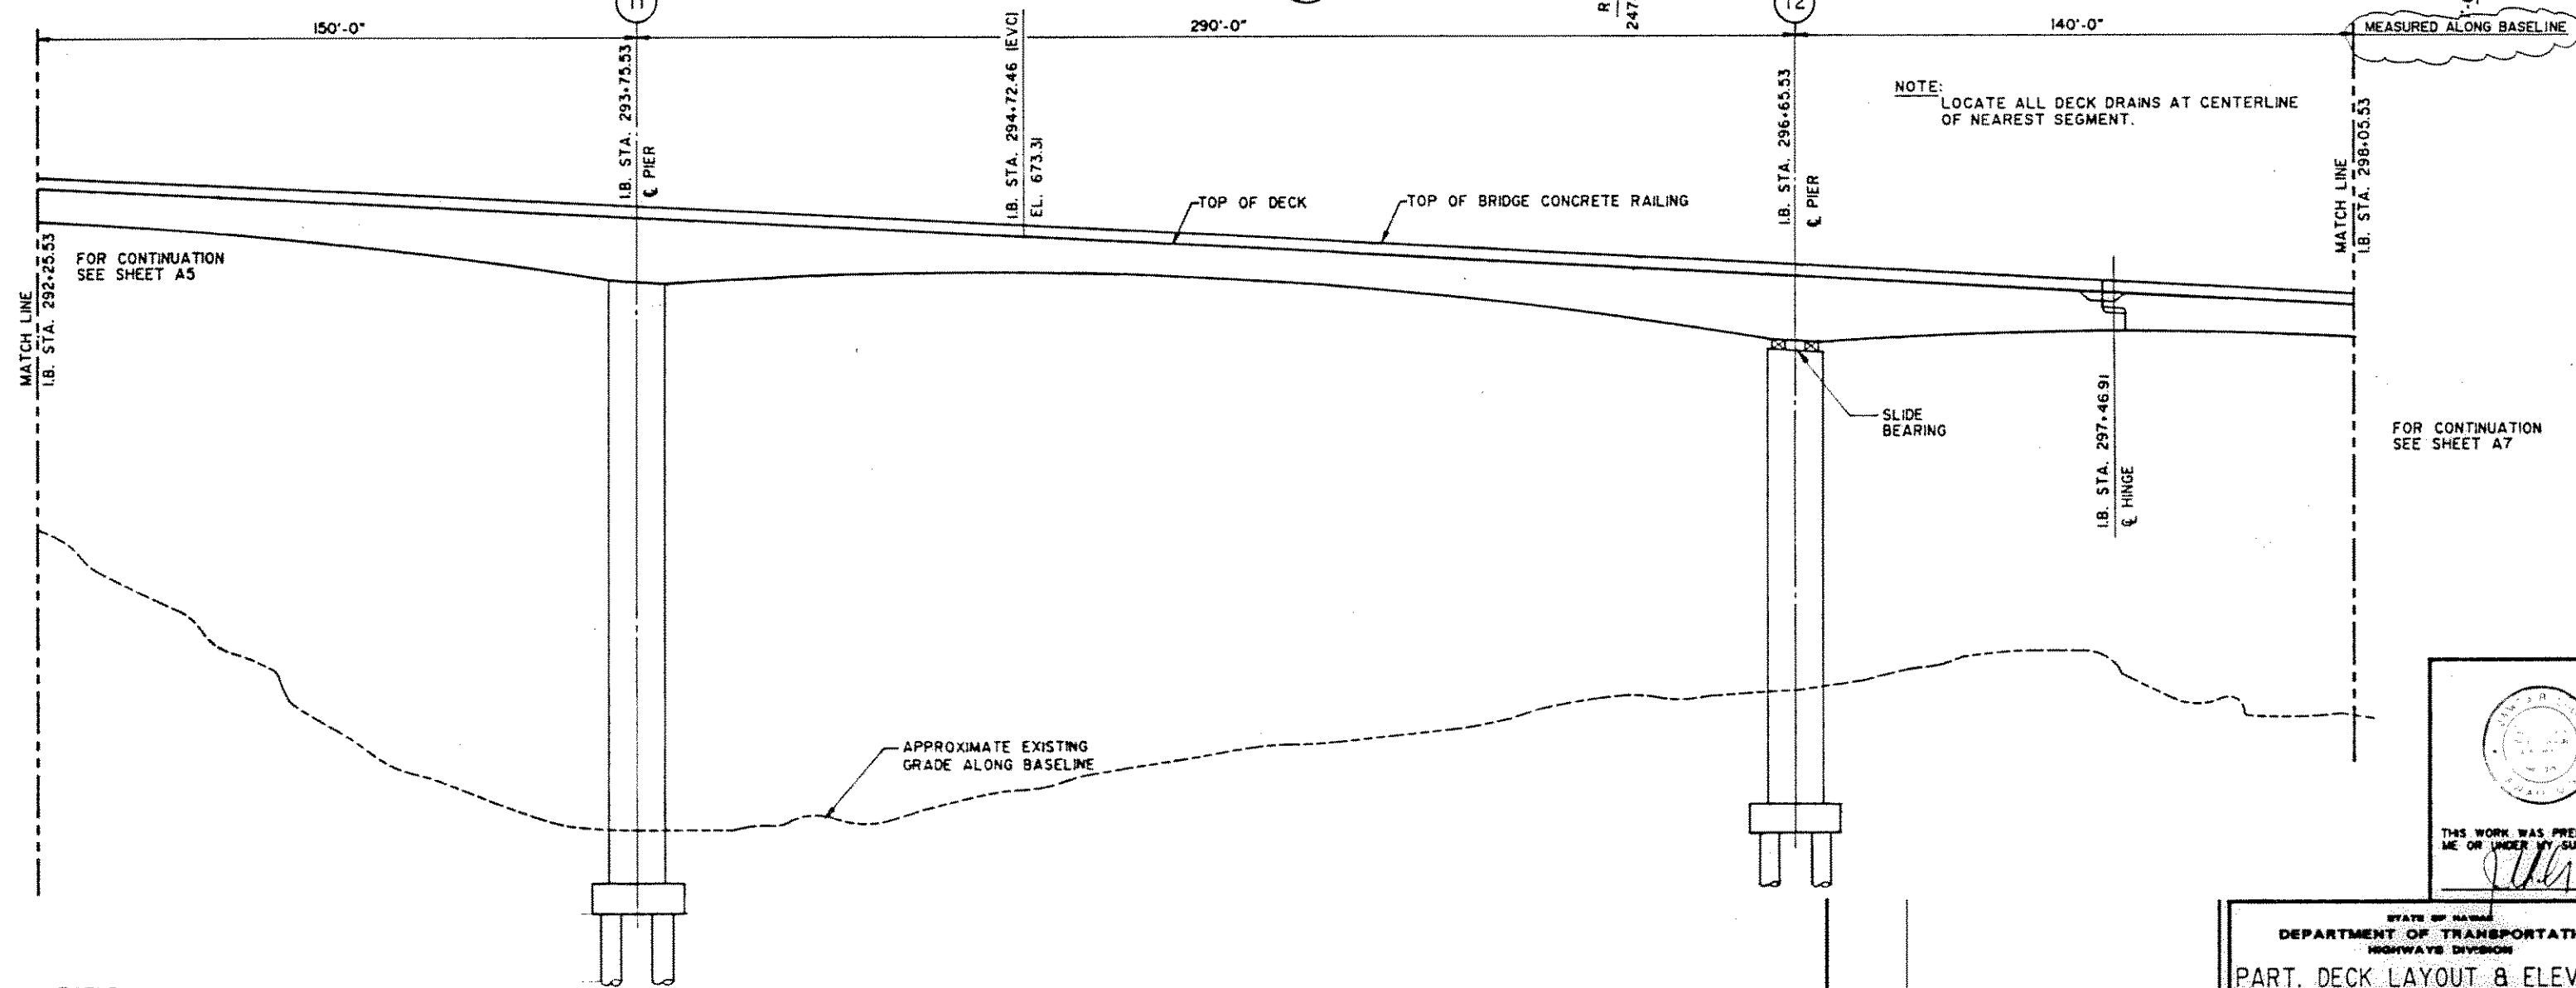


FED. ROAD DIST. NO.	STATE	FED. AID PROJ. NO.	FISCAL YEAR	SHEET NO.	TOTAL SHEETS
HAWAII	HAW.	I-H3-1 (57)	1988		

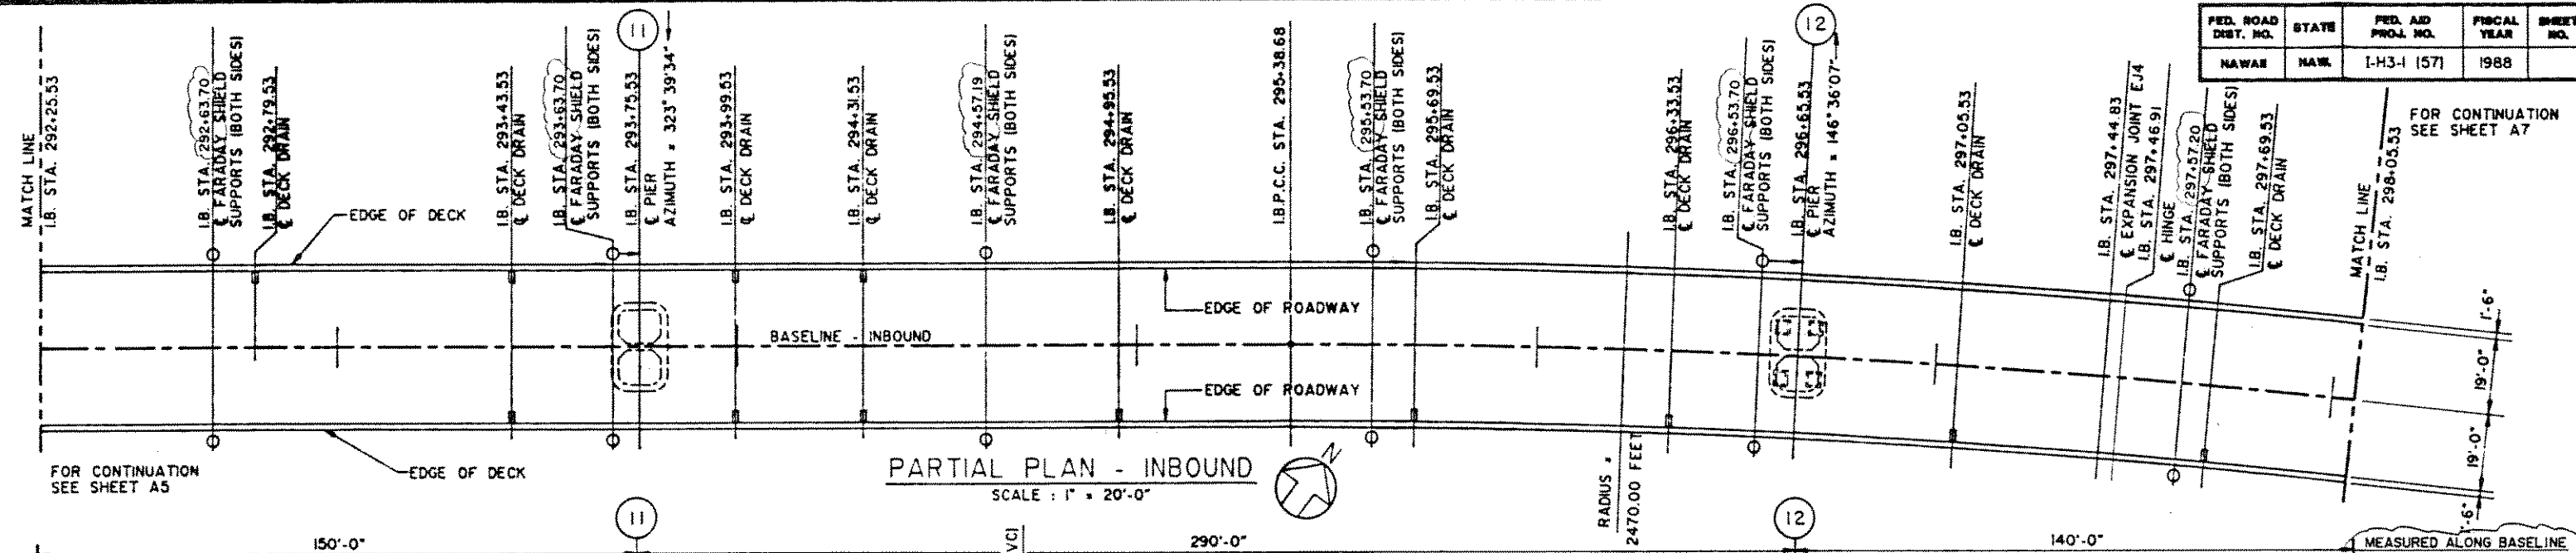

LEGEND:
 L — INDICATES GROUND BUSS EXTENDING DOWN PIER TO GROUND ROD.

08/23/91	UPDATED FARADAY SHIELD SUPPORT STATION.
DATE	REVISION
J. MULLER INTERNATIONAL	Libby Engineers

STATE OF HAWAII
 DEPARTMENT OF TRANSPORTATION
 HIGHWAYS DIVISION

PART. DECK LAYOUT & ELEVATION
 INBOUND STRUCTURE
 STA. 292+25.53 TO STA. 298+05.53
 INTERSTATE ROUTE H-3
 F.A.I. PROJECT NO. I-H3-1 (57)
 F.A.I. PROJECT NO. I-H3-1 (58)
 SCALE: AS NOTED DATE: JUNE 1990

SHEET No. A6 OF 24 SHEETS



THIS WORK WAS PREPARED BY ME OR UNDER MY SUPERVISION