
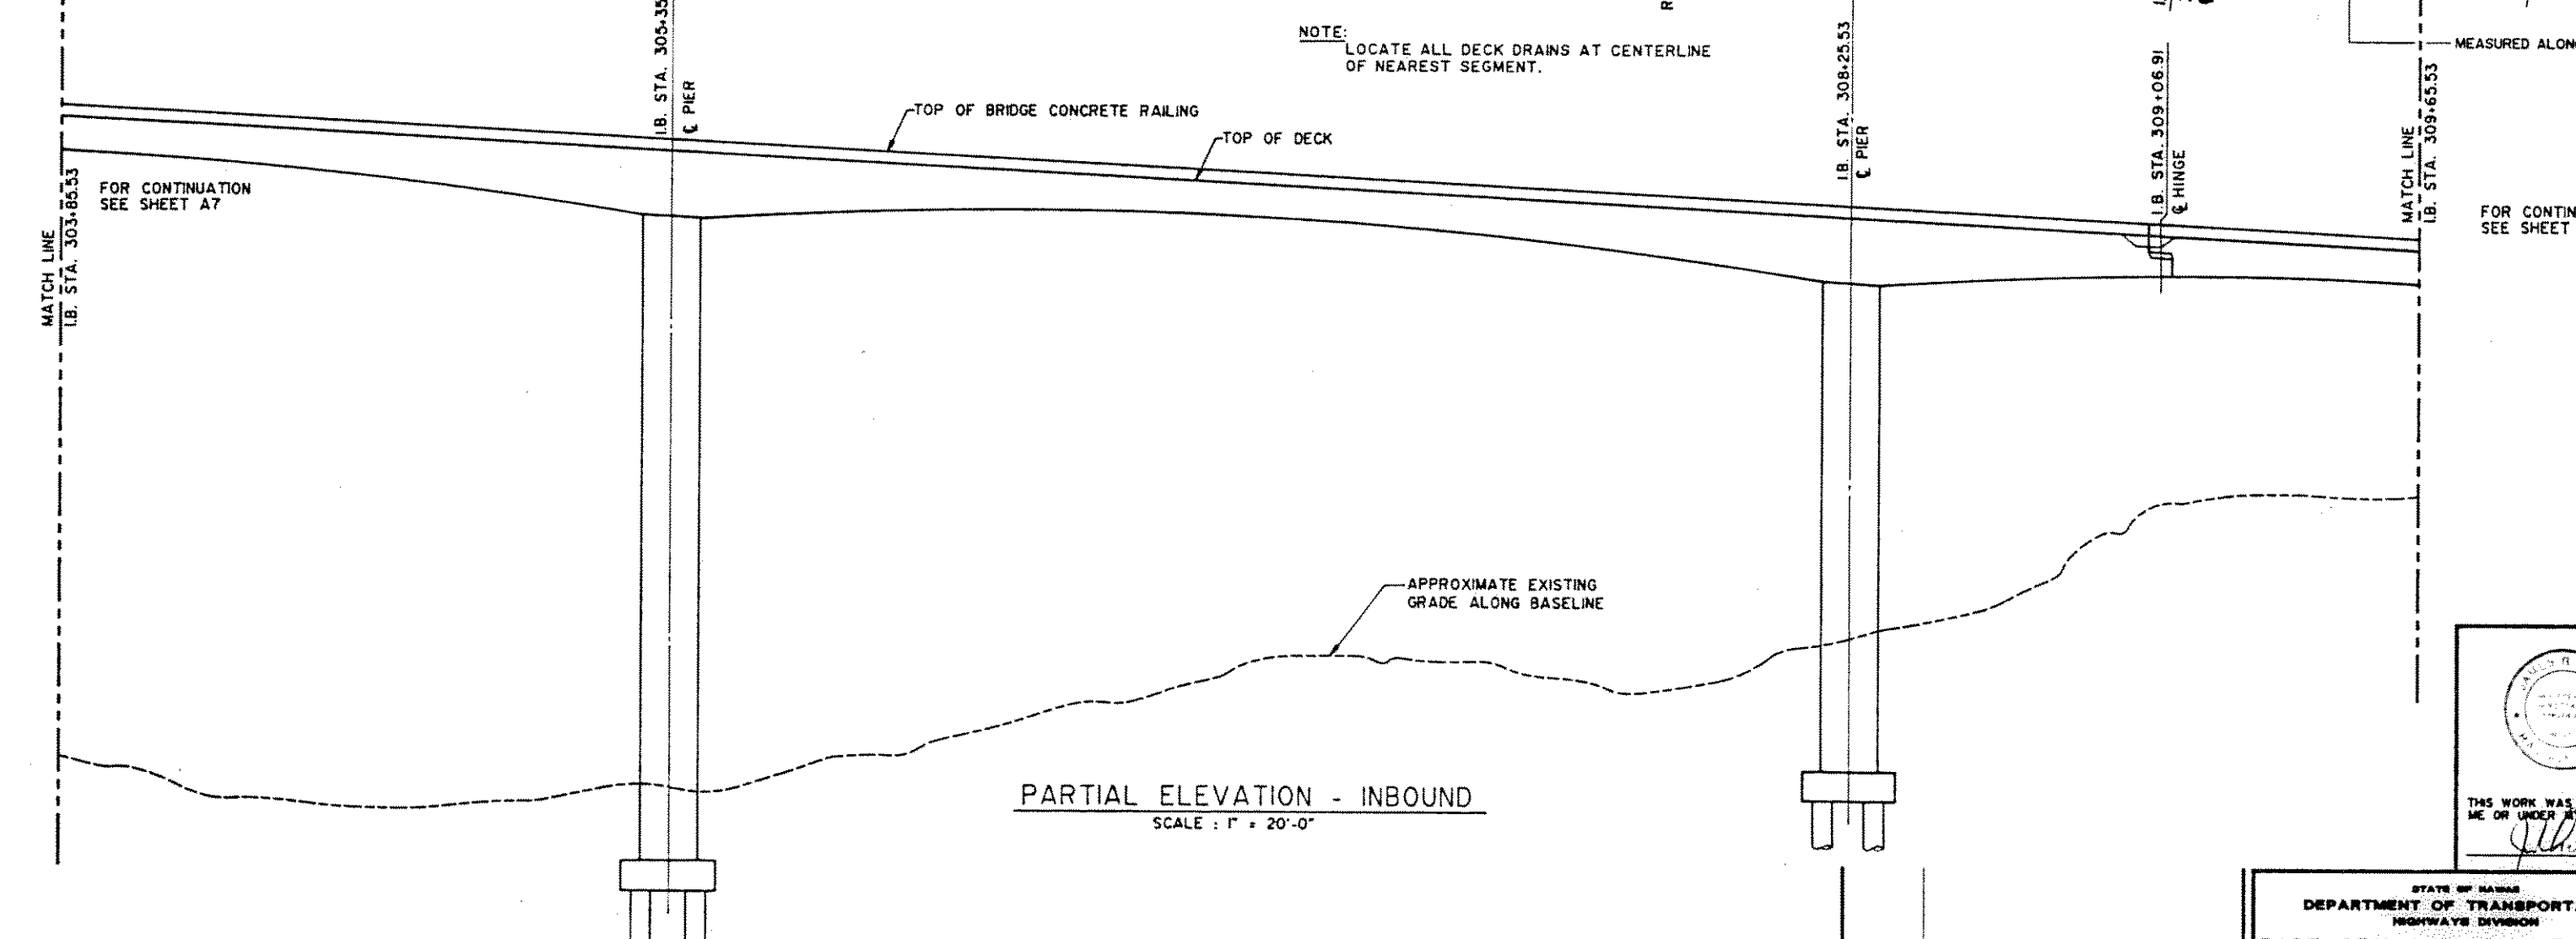


| FED. ROAD DIST. NO. | STATE  | FED. AID PROJ. NO. | FISCAL YEAR | SHEET NO. | TOTAL SHEETS |
|---------------------|--------|--------------------|-------------|-----------|--------------|
| HAWAII              | HAWAII | I-H3-1 (57)        | 1988        |           |              |

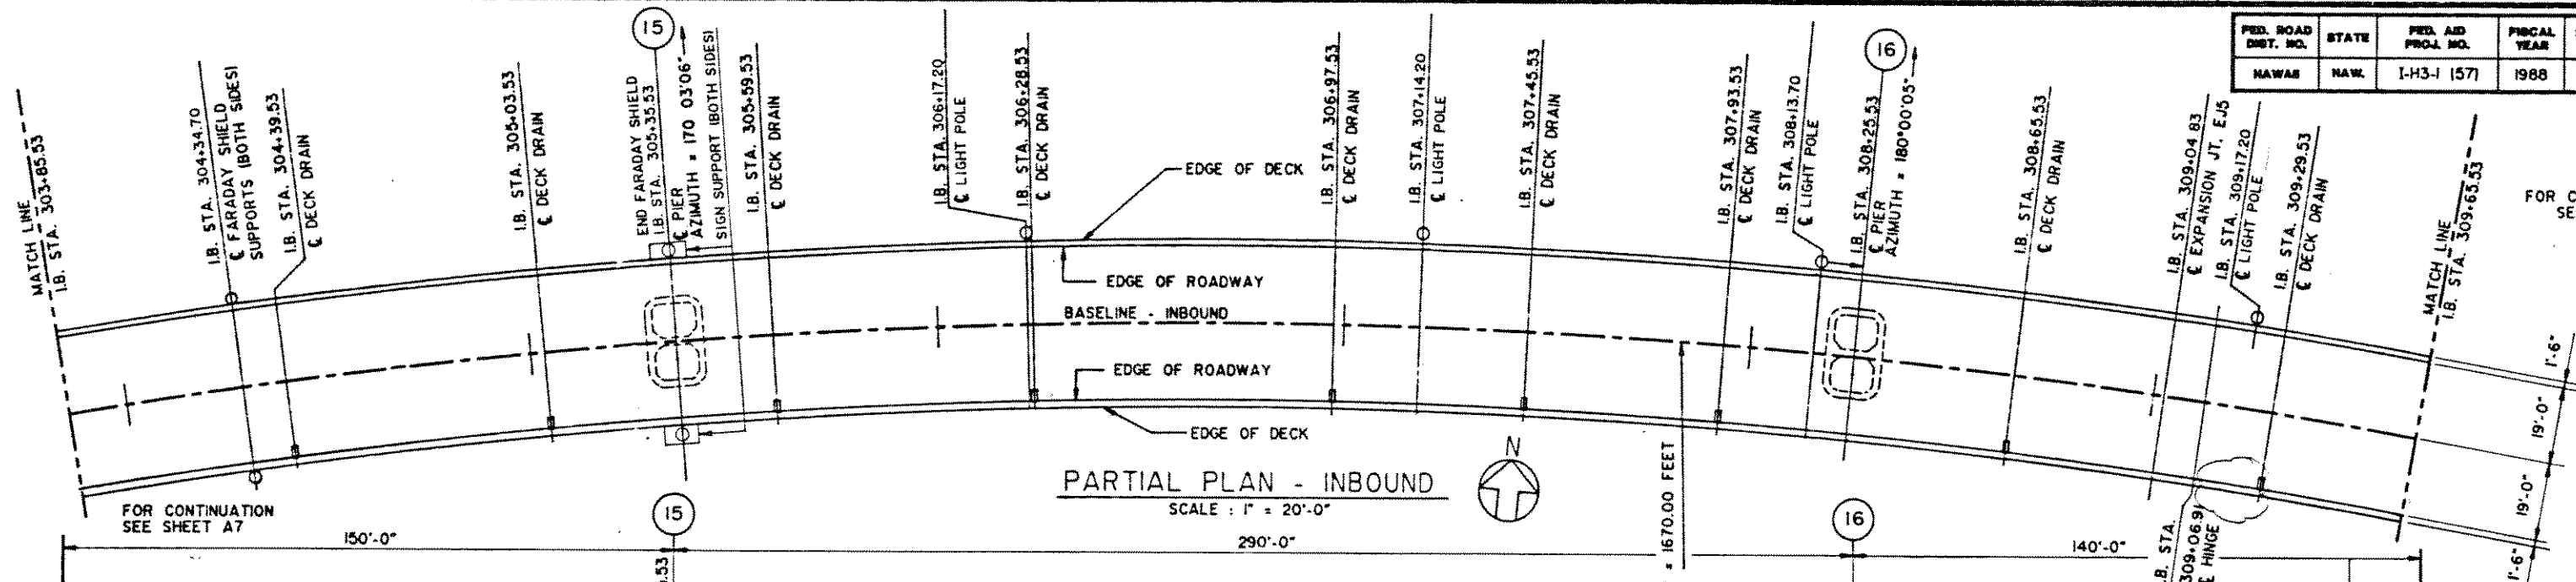

LEGEND:  
 I — INDICATES GROUND BUSS EXTENDING DOWN PIER TO GROUND ROD.

09/30/91 UPDATED LIGHT POLE STATION.  
 08/23/91 UPDATED FARADAY SHIELD SUPPORT STA. AND ADDED SIGN SUPPORT IP-15.

DATE REVISION  
 J. MULLER INTERNATIONAL Libby Engineers

STATE OF HAWAII  
 DEPARTMENT OF TRANSPORTATION  
 HIGHWAYS DIVISION

**PART. DECK LAYOUT & ELEVATION**  
**INBOUND STRUCTURE**  
 STA. 303+85.53 TO STA. 309+65.53  
 INTERSTATE ROUTE H-3  
 F.A.I. PROJECT NO. I-H3-1 (57)  
 F.A.I. PROJECT NO. I-H3-1 (58)  
 SCALE: AS NOTED DATE: JUNE 1990  
 SHEET No. A8 OF 24 SHEETS

THIS WORK WAS PREPARED BY ME OR UNDER MY SUPERVISION