
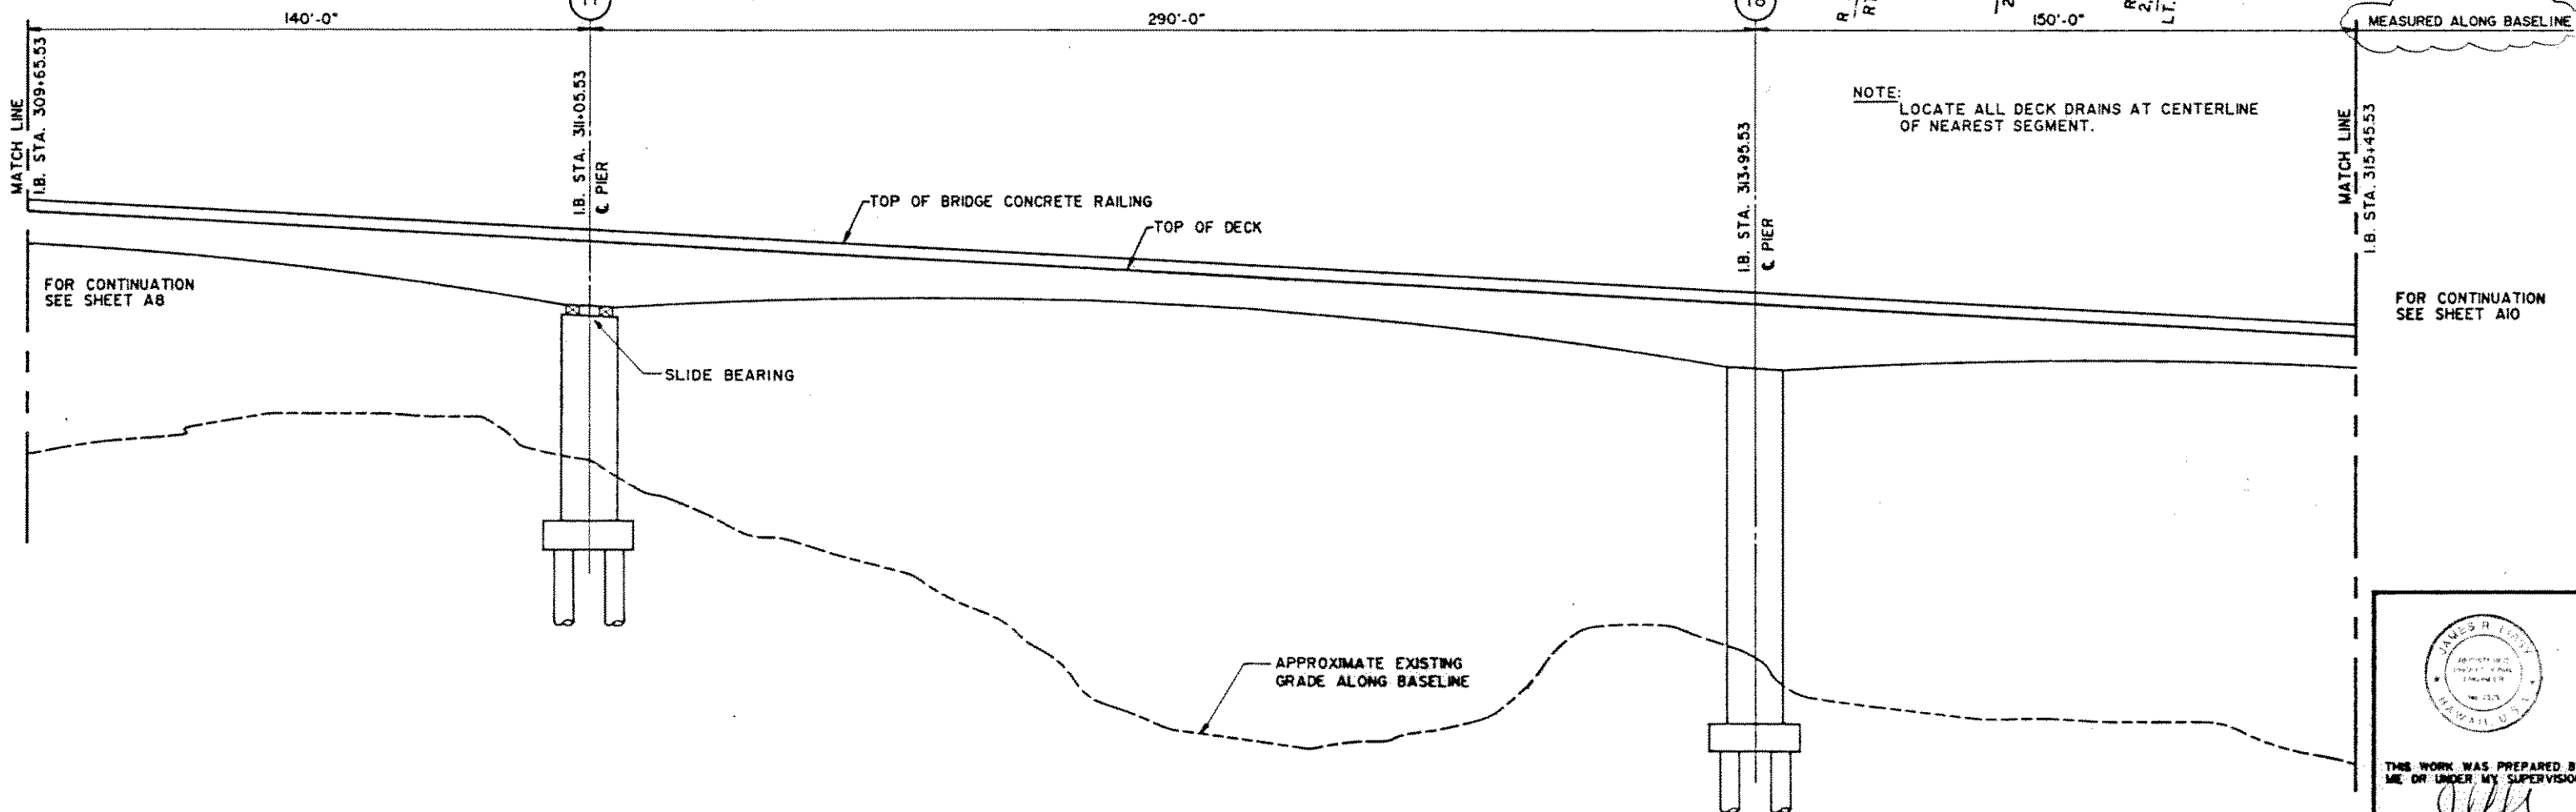


FED. ROAD DIST. NO.	STATE	FED. AID PROJ. NO.	FISCAL YEAR	SHEET NO.	TOTAL SHEETS
HAWAII	HAW.	I-H3-1 (57)	1988		

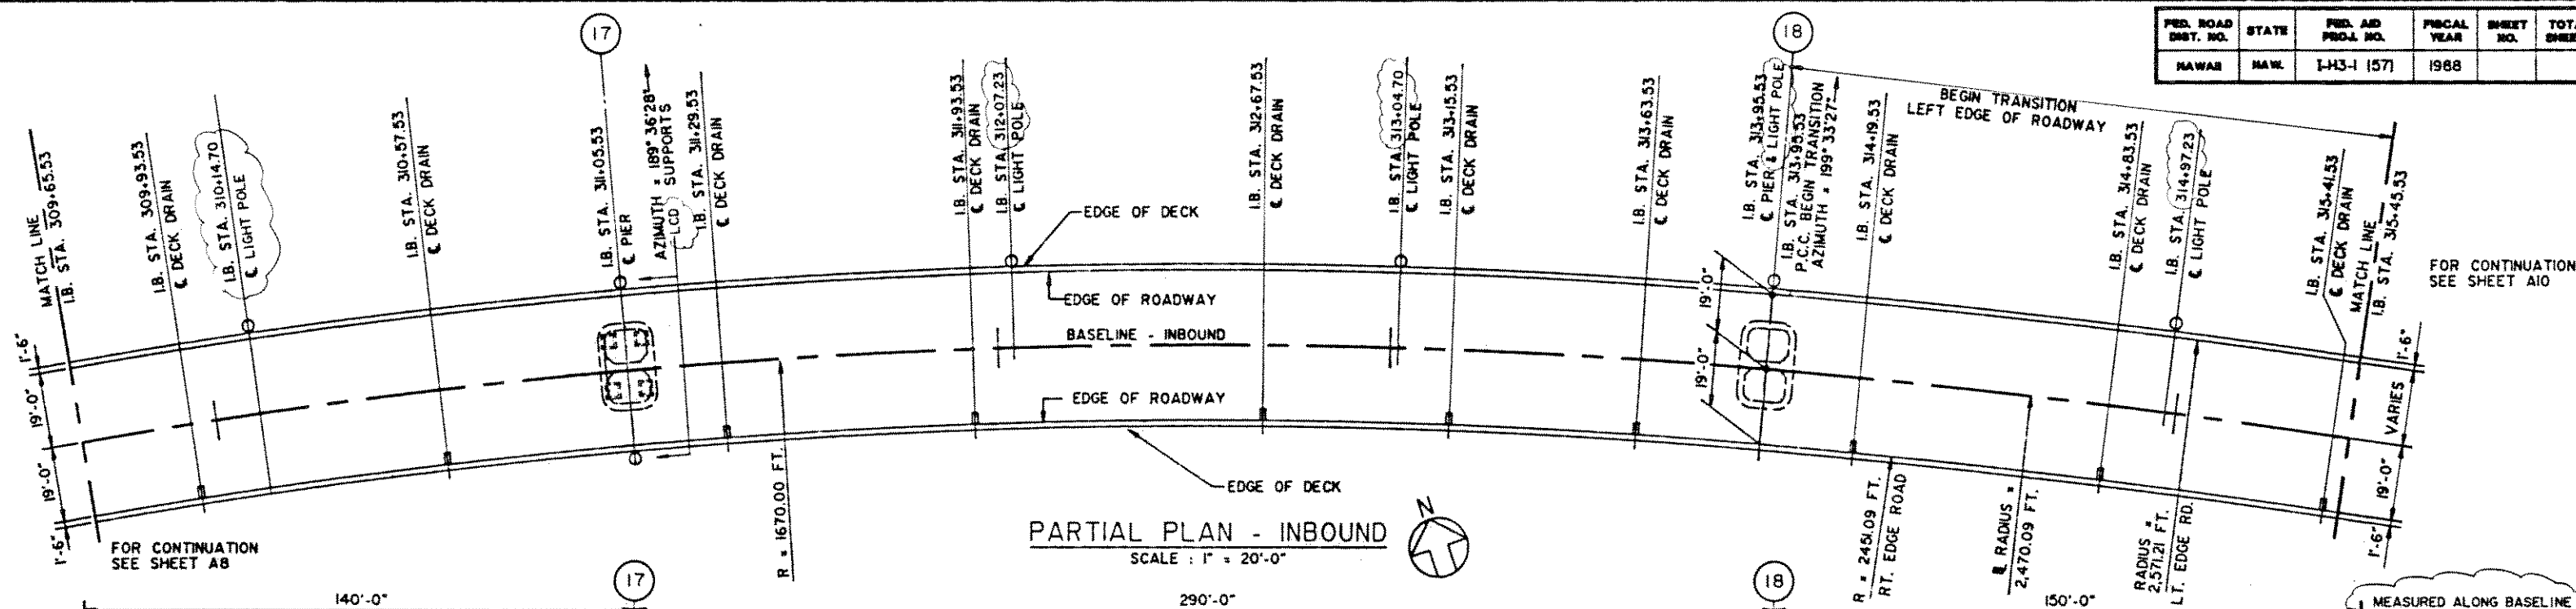


NOTE: LOCATE ALL DECK DRAINS AT CENTERLINE OF NEAREST SEGMENT.

DESIGNED BY	DATE
DRAWN BY	
CHECKED BY	
APPROVED BY	
IN CHARGE	

08/23/91 UPDATED LIGHT POLE STATIONS
DATE REVISION
J. MULLER INTERNATIONAL Libby Engineers

STATE OF HAWAII
DEPARTMENT OF TRANSPORTATION
HIGHWAYS DIVISION
PART. DECK LAYOUT & ELEVATION
STA. 309+65.53 TO STA. 315+45.53
INBOUND STRUCTURE
INTERSTATE ROUTE H-3
F.A.I. PROJECT NO. I-H3-1 (57)
F.A.I. PROJECT NO. I-H3-1 (58)
SCALE: AS NOTED DATE: JUNE 1990
SHEET No. A9 OF 24 SHEETS

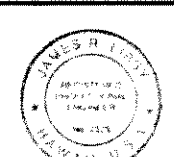

THIS WORK WAS PREPARED BY ME OR UNDER MY SUPERVISION
James R. Libby