
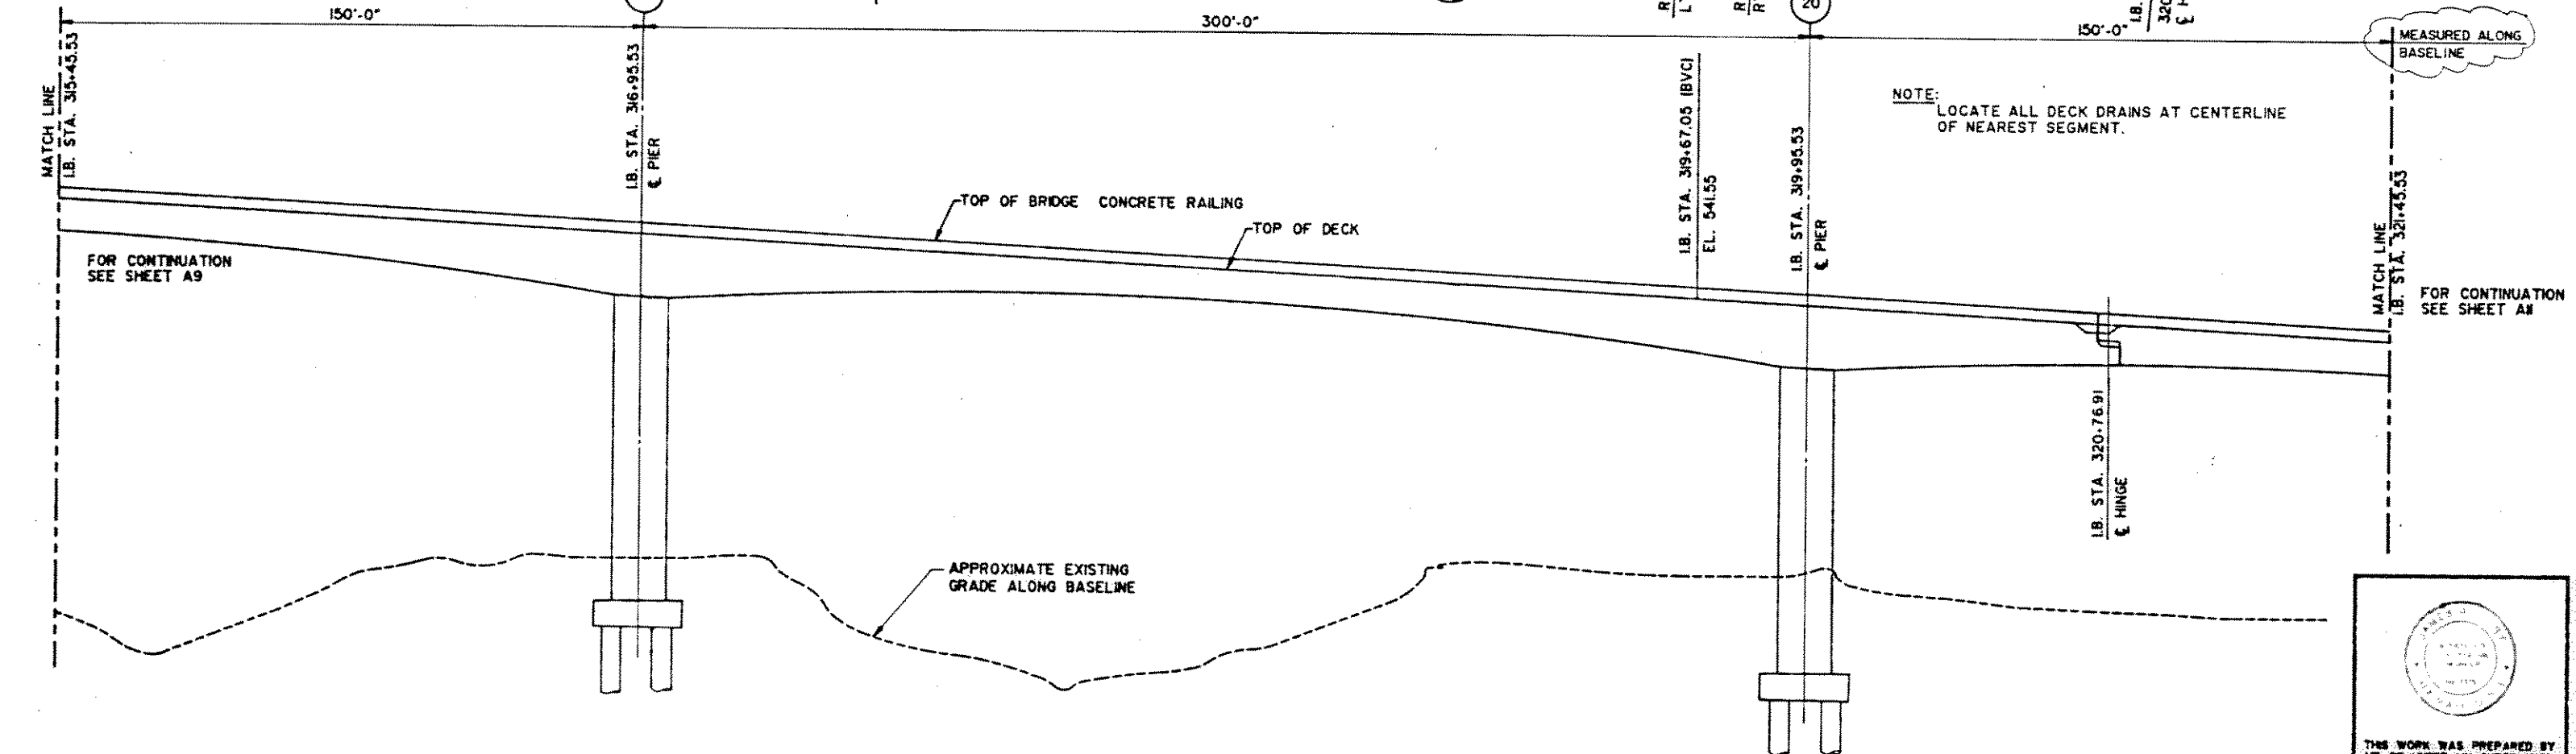


FED. ROAD DIST. NO.	STATE	FED. AID PROJ. NO.	FISCAL YEAR	SHEET NO.	TOTAL SHEETS
HAWAII	HAW.	I-43-1 (57)	1988		

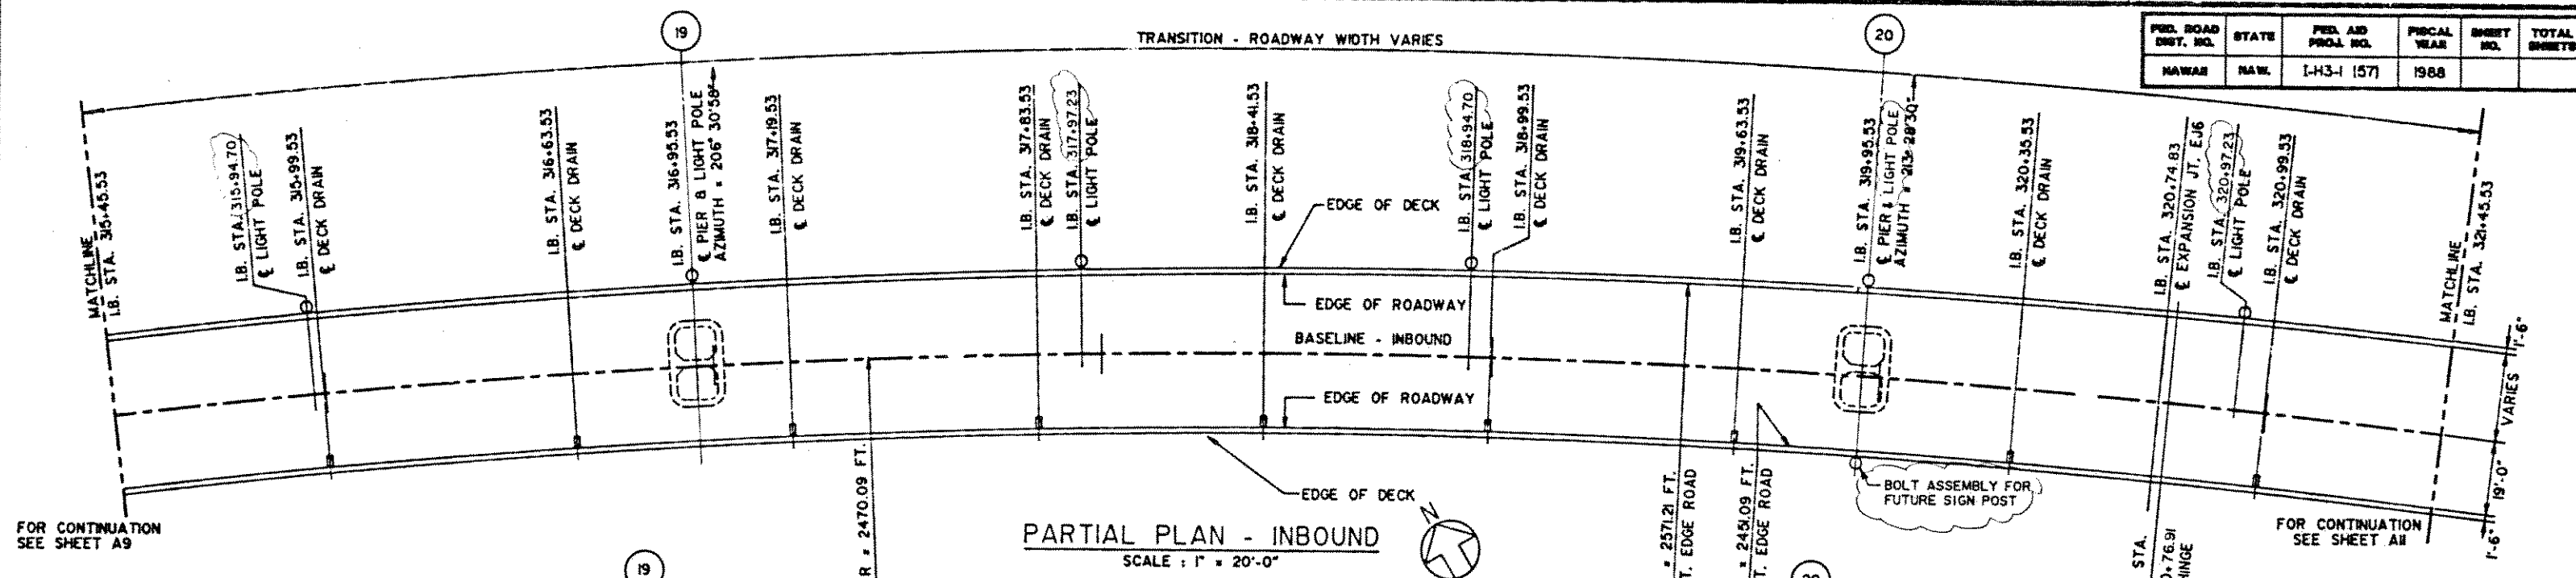

NOTE: LOCATE ALL DECK DRAINS AT CENTERLINE OF NEAREST SEGMENT.

LEGEND:

1. — INDICATES GROUND BUSS EXTENDING DOWN PIER TO GROUND ROD.
2. O/R INDICATES OFFSET RIGHT OF BASELINE.
3. O/L INDICATES OFFSET LEFT OF BASELINE.

PARTIAL ELEVATION - INBOUND
SCALE: 1" = 20'-0"


08/23/91 UPDATED LIGHT POLE STATIONS & FUTURE SIGN POST.

DATE

REVISION

J. MULLER
INTERNATIONAL

Libby
Engineers

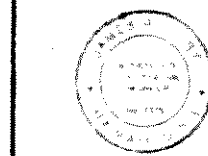

THIS WORK WAS PREPARED BY ME OR UNDER MY SUPERVISION

STATE OF HAWAII
DEPARTMENT OF TRANSPORTATION
HIGHWAYS DIVISION
PART. DECK LAYOUT & ELEVATION
STA. 315+45.53 TO STA. 321+45.53
INBOUND STRUCTURE
INTERSTATE ROUTE H-3
F.A.I. PROJECT NO. I-43-1 (57)
F.A.I. PROJECT NO. I-43-1 (58)
SCALE: AS NOTED DATE: JUNE 1990
SHEET No. 110 OF 24 SHEETS