



FED. ROAD DIST. NO.	STATE	FED. AID PROJ. NO.	FISCAL YEAR	SHEET NO.	TOTAL SHEETS
HAWAII	HAW.	I-H3-1 (57)	1988		

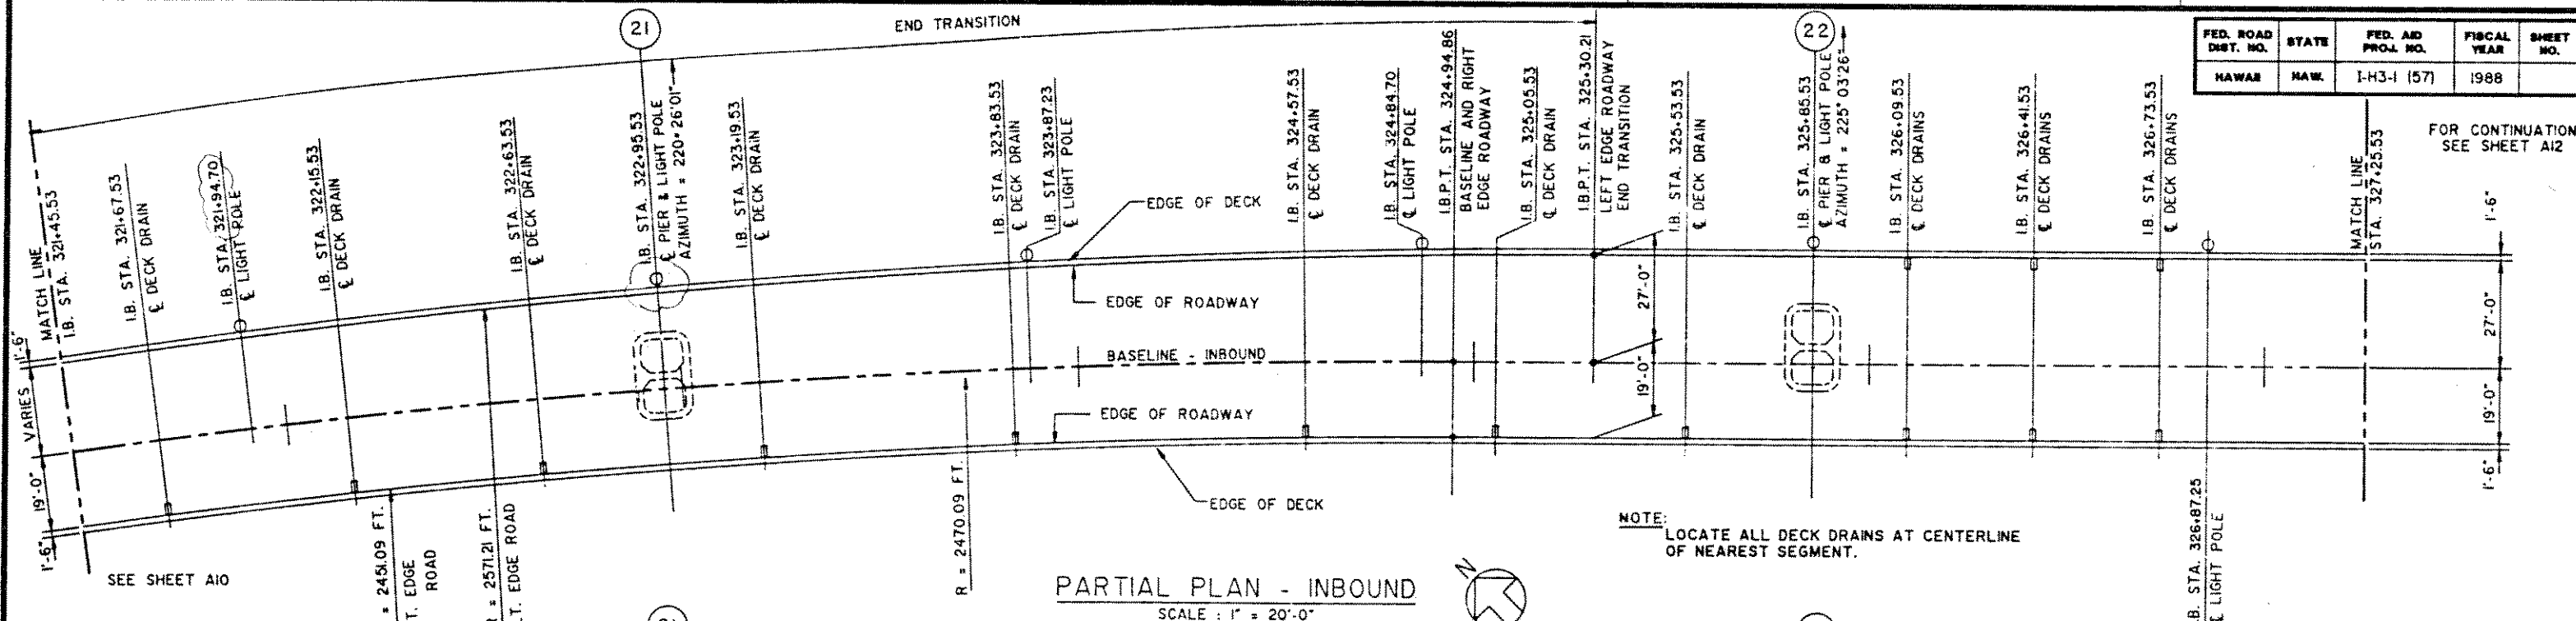

PARTIAL PLAN - INBOUND
SCALE : 1" = 20'-0"

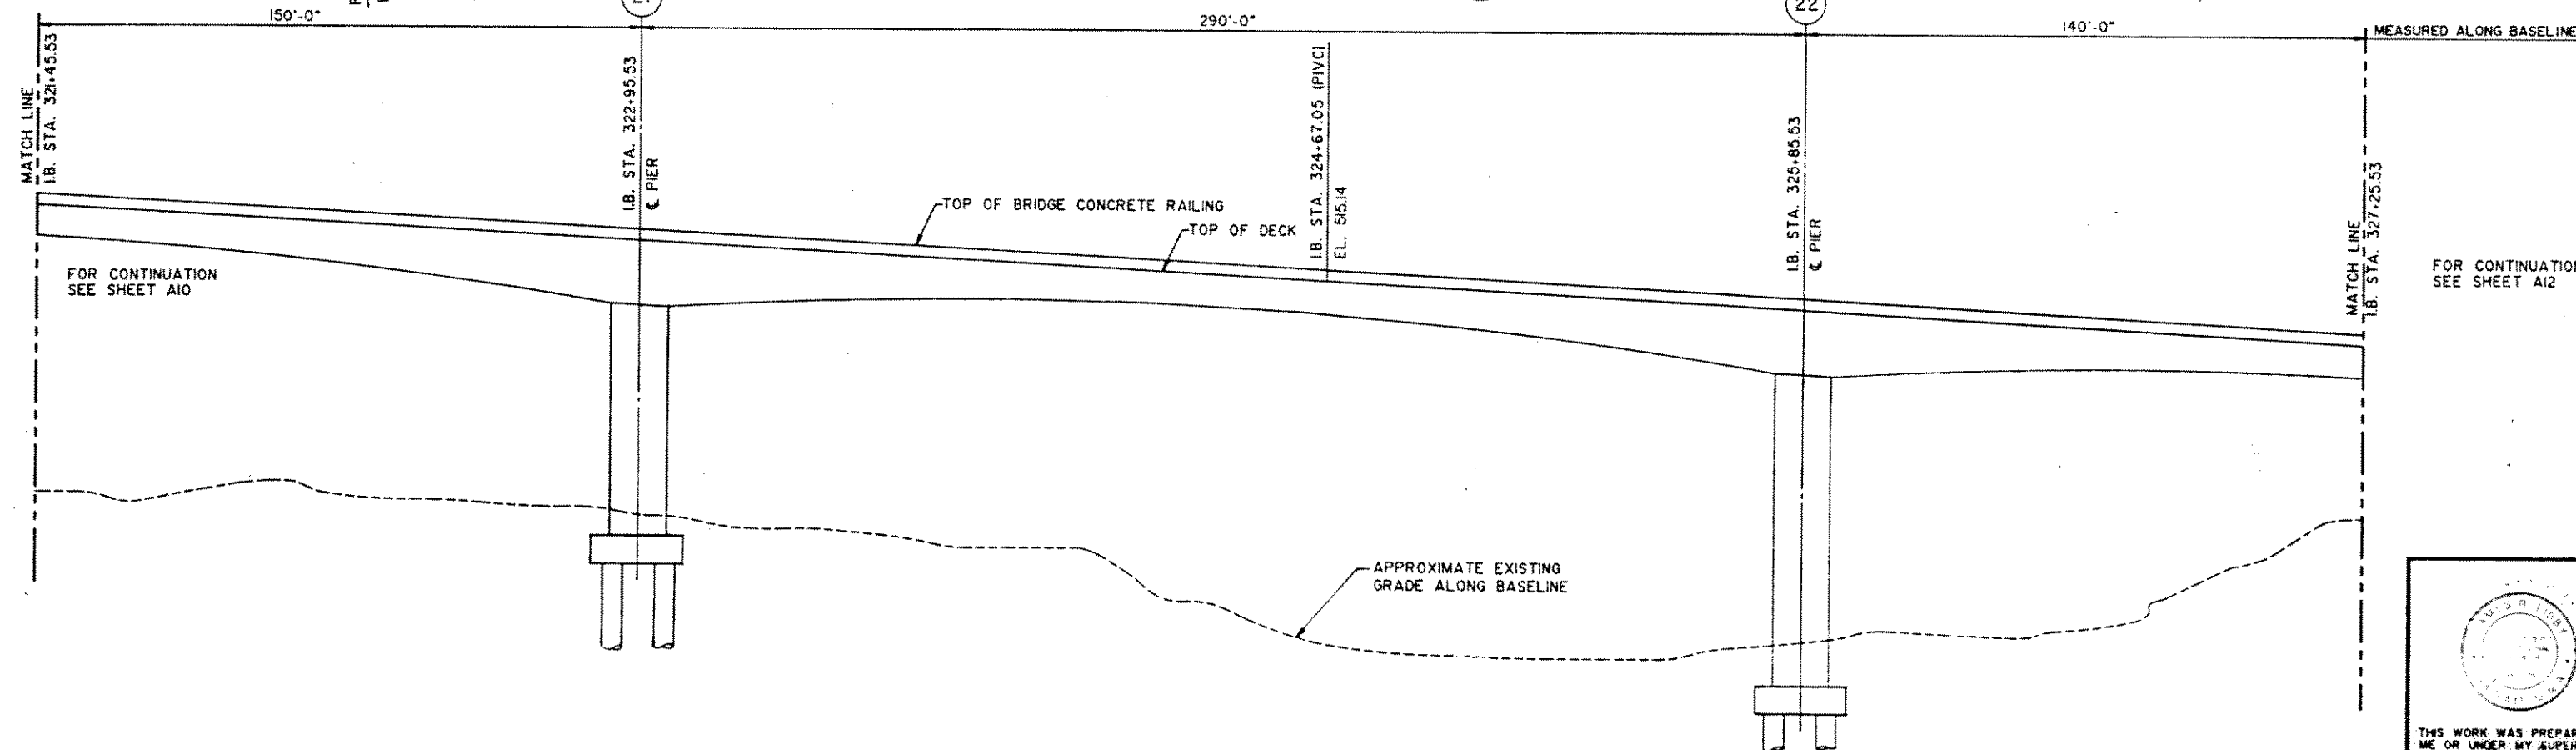


PARTIAL ELEVATION - INBOUND
SCALE : 1" = 20'-0"

LEGEND:
I ——— INDICATES GROUND BUSS EXTENDING DOWN PIER TO GROUND ROD.

09/30/91 UPDATED LIGHT POLE STATION.
08/23/91 UPDATED LIGHT POLE STATIONS.

DATE REVISION
J. MULLER INTERNATIONAL Libby Engineers

STATE OF HAWAII
DEPARTMENT OF TRANSPORTATION
HIGHWAYS DIVISION
PART. DECK LAYOUT & ELEVATION
STA. 321+45.53 TO STA. 327+25.53
INBOUND STRUCTURE
INTERSTATE ROUTE H-3
F.A.I. PROJECT NO. I-H3-1 (57)
F.A.I. PROJECT NO. I-H3-1 (58)
SCALE: AS NOTED DATE: JUNE, 1990
SHEET No. 11 OF 24 SHEETS

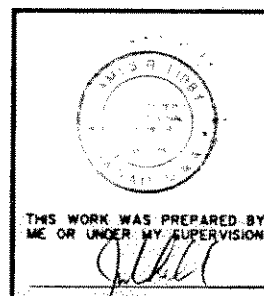

THIS WORK WAS PREPARED BY ME OR UNDER MY SUPERVISION