


FED. ROAD DIST. NO.	STATE	FED. AID PROJ. NO.	FISCAL YEAR	SHEET NO.	TOTAL SHEETS
HAWAII	HAW.	I-H3-1 (57)	1988		

FOR CONTINUATION
SEE SHEET AH

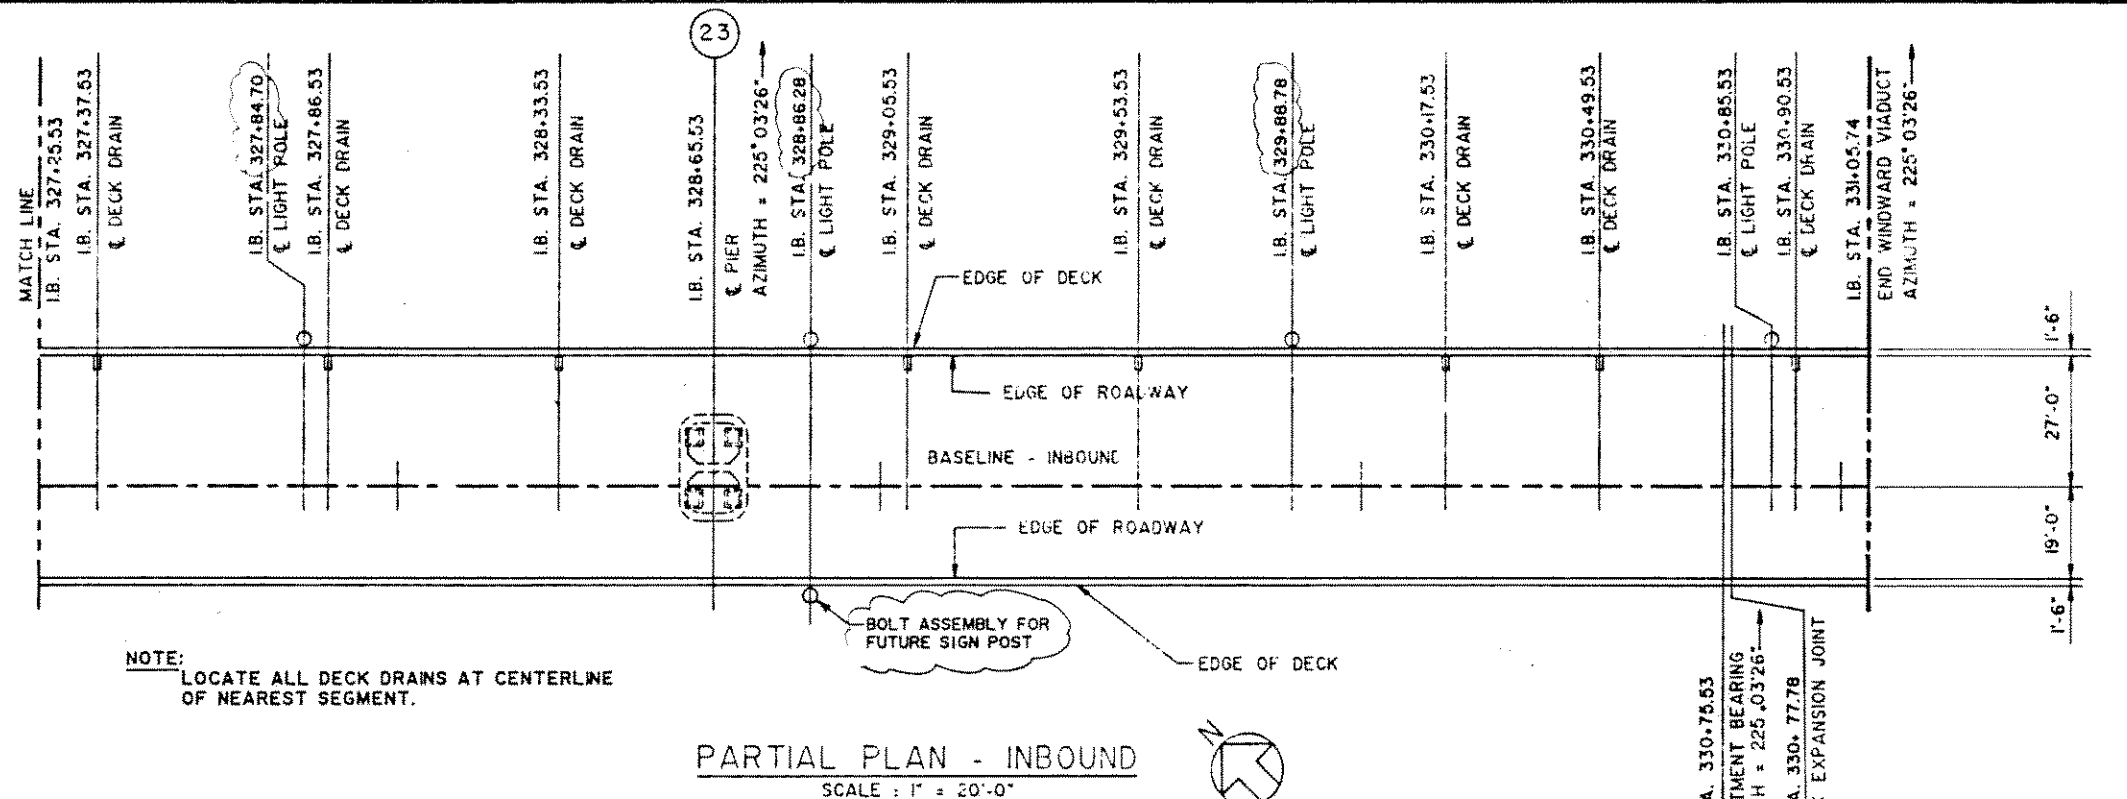


NOTE:
LOCATE ALL DECK DRAINS AT CENTERLINE
OF NEAREST SEGMENT.

PARTIAL PLAN - INBOUND

SCALE : 1" = 20'-0"



FOR CONTINUATION
SEE SHEET AH

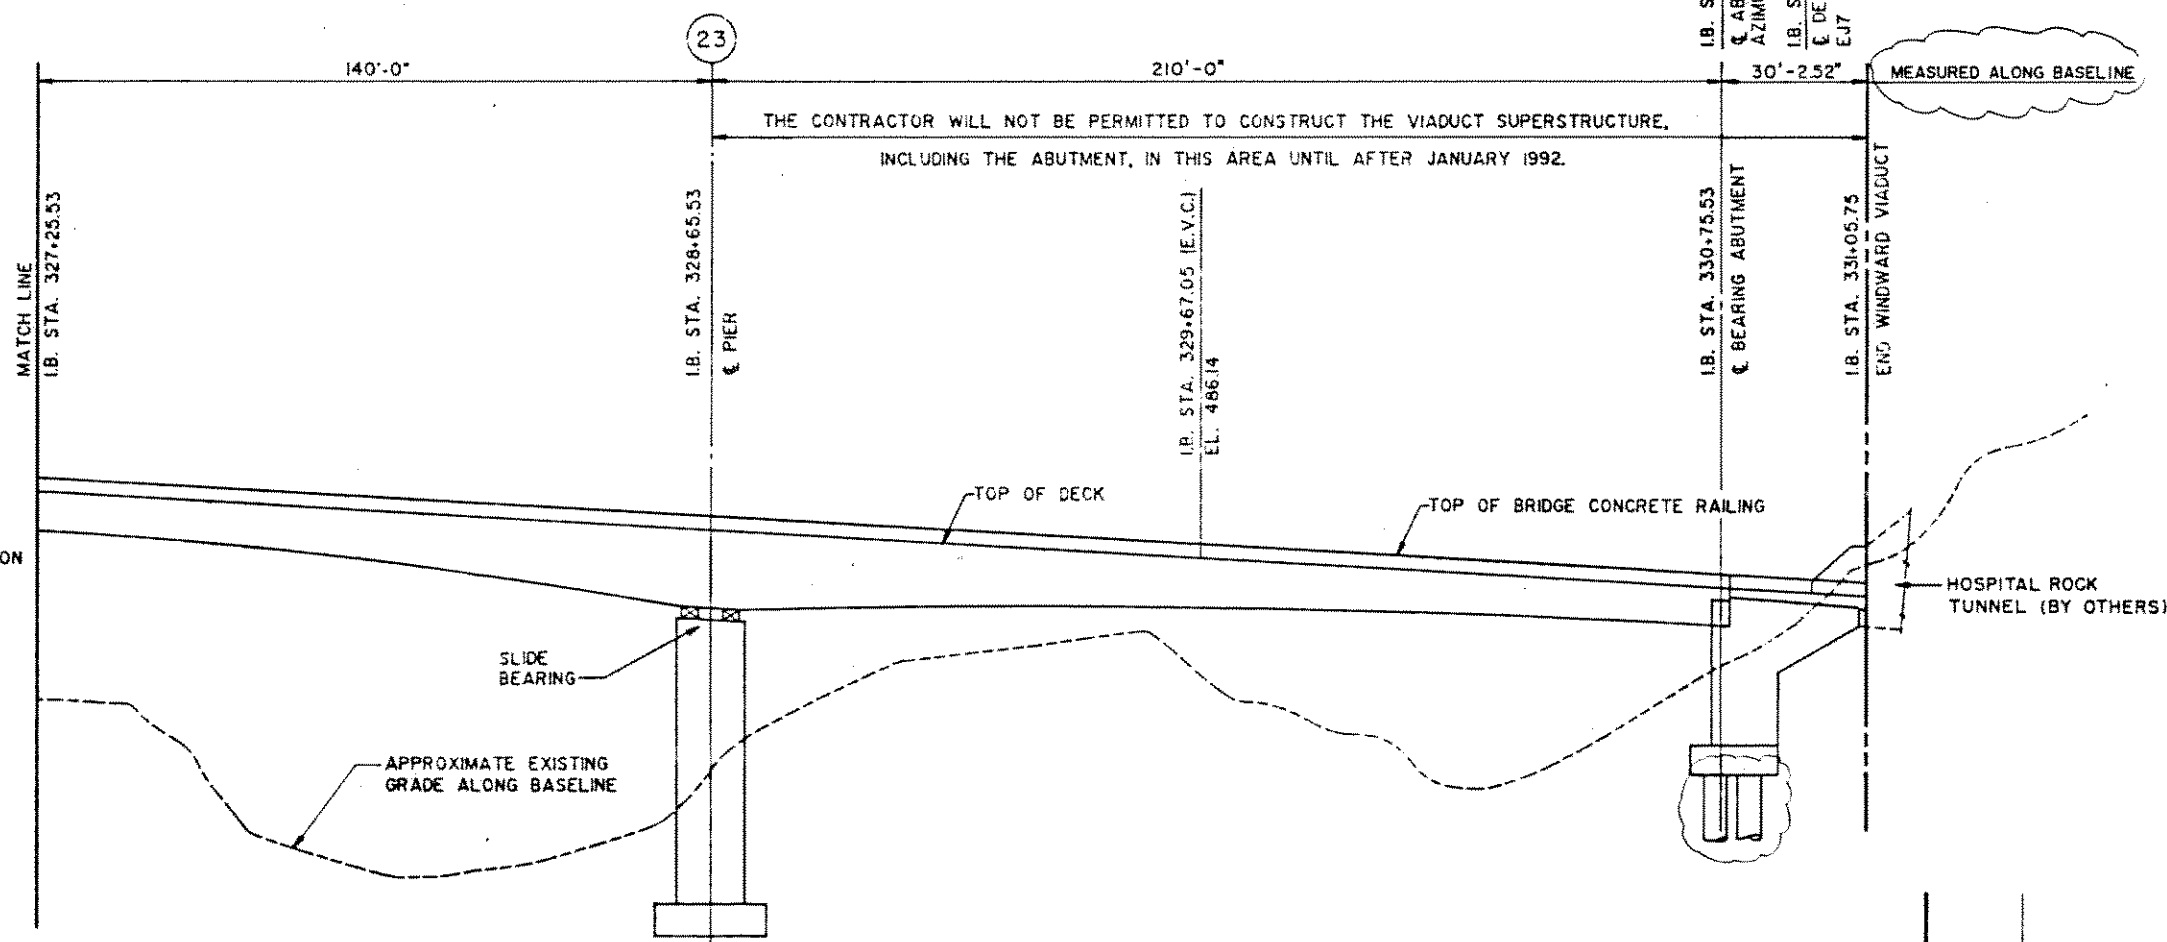


PARTIAL ELEVATION - INBOUND

SCALE : 1" = 20'-0"

08/23/91 UPDATED LIGHT POLE STATIONS AND
07/02/91 FUTURE SIGN POST.
DATE UPDATED DRAWING.

DATE REVISION
J. MULLER
INTERNATIONAL Libby
Engineers

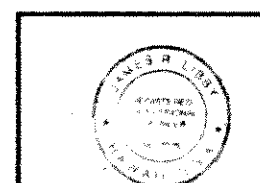

THIS WORK WAS PREPARED BY
ME OR UNDER MY SUPERVISION

J. Libby

STATE OF HAWAII
DEPARTMENT OF TRANSPORTATION
HIGHWAYS DIVISION
PART. DECK LAYOUT & ELEVATION
STA. 327+25.53 TO STA. 331+05.75
INBOUND STRUCTURE
INTERSTATE ROUTE H-3
F.A.I. PROJECT NO. I-H3-1 (57)
F.A.I. PROJECT NO. I-H3-1 (58)
SCALE: AS NOTED DATE: JUNE 1990
SHEET No. A12 OF 24 SHEETS