


FED. ROAD DIST. NO.	STATE	FED. AID PROJ. NO.	FISCAL YEAR	SHEET NO.	TOTAL SHEETS
HAWAII	HAW.	I-H3-1 (57)	1988		

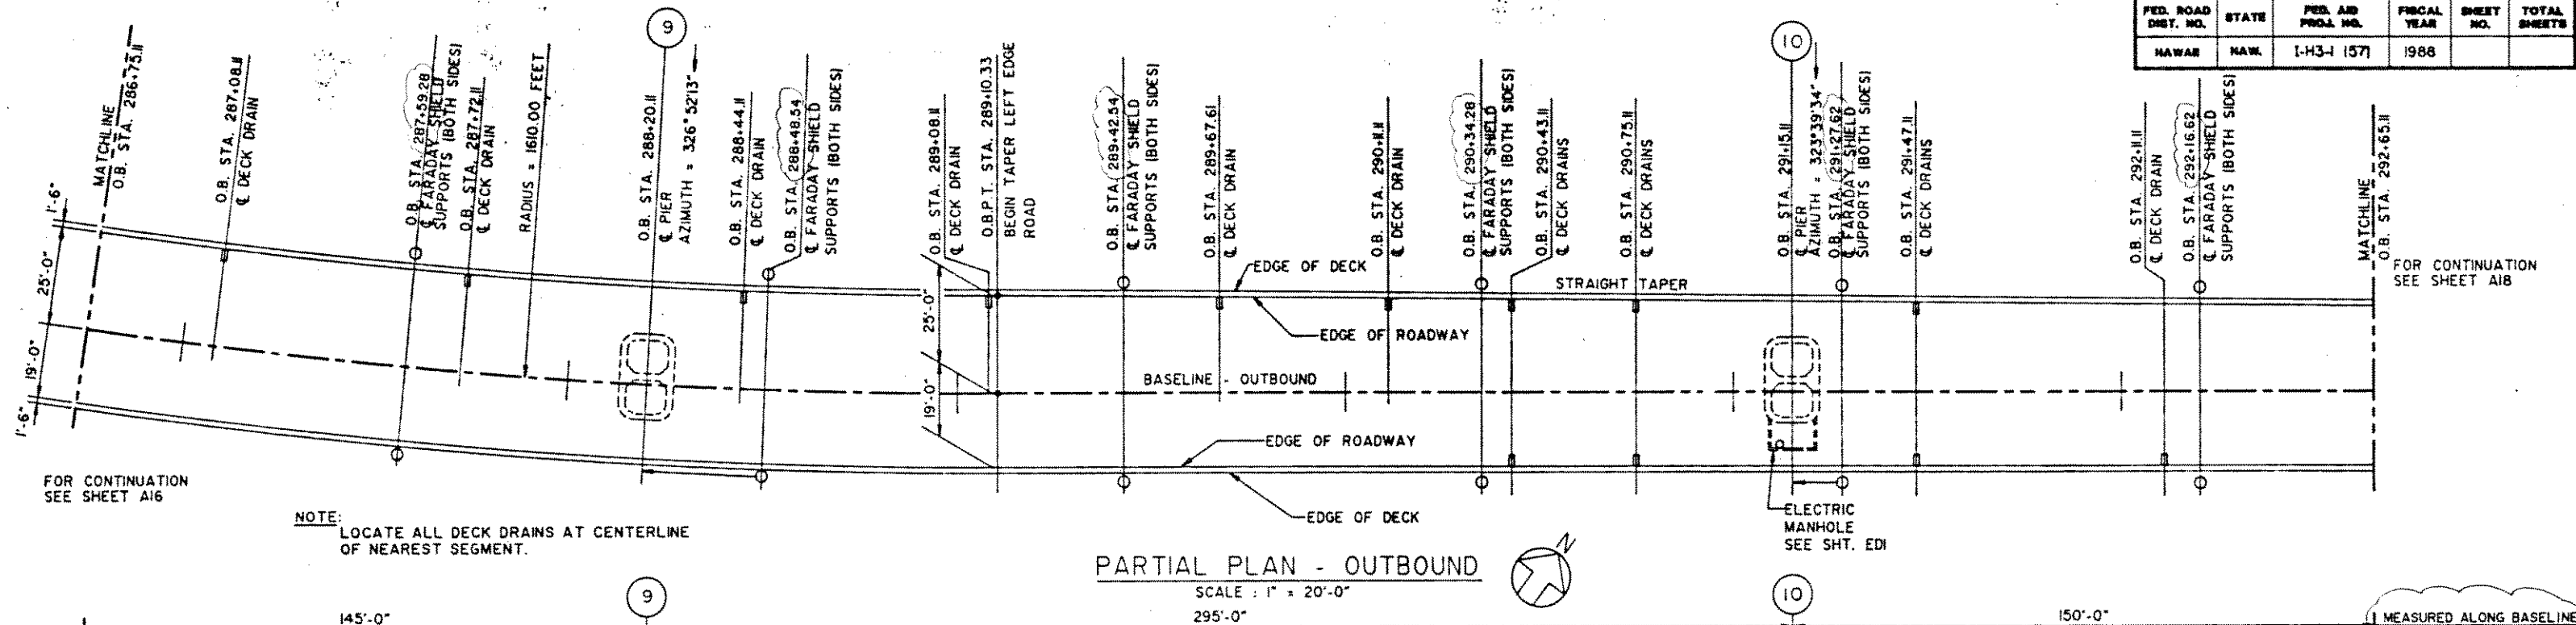


FOR CONTINUATION
SEE SHEET A16

NOTE:
LOCATE ALL DECK DRAINS AT CENTERLINE
OF NEAREST SEGMENT.

PARTIAL PLAN - OUTBOUND

SCALE: 1" = 20'-0"

FOR CONTINUATION
SEE SHEET A18

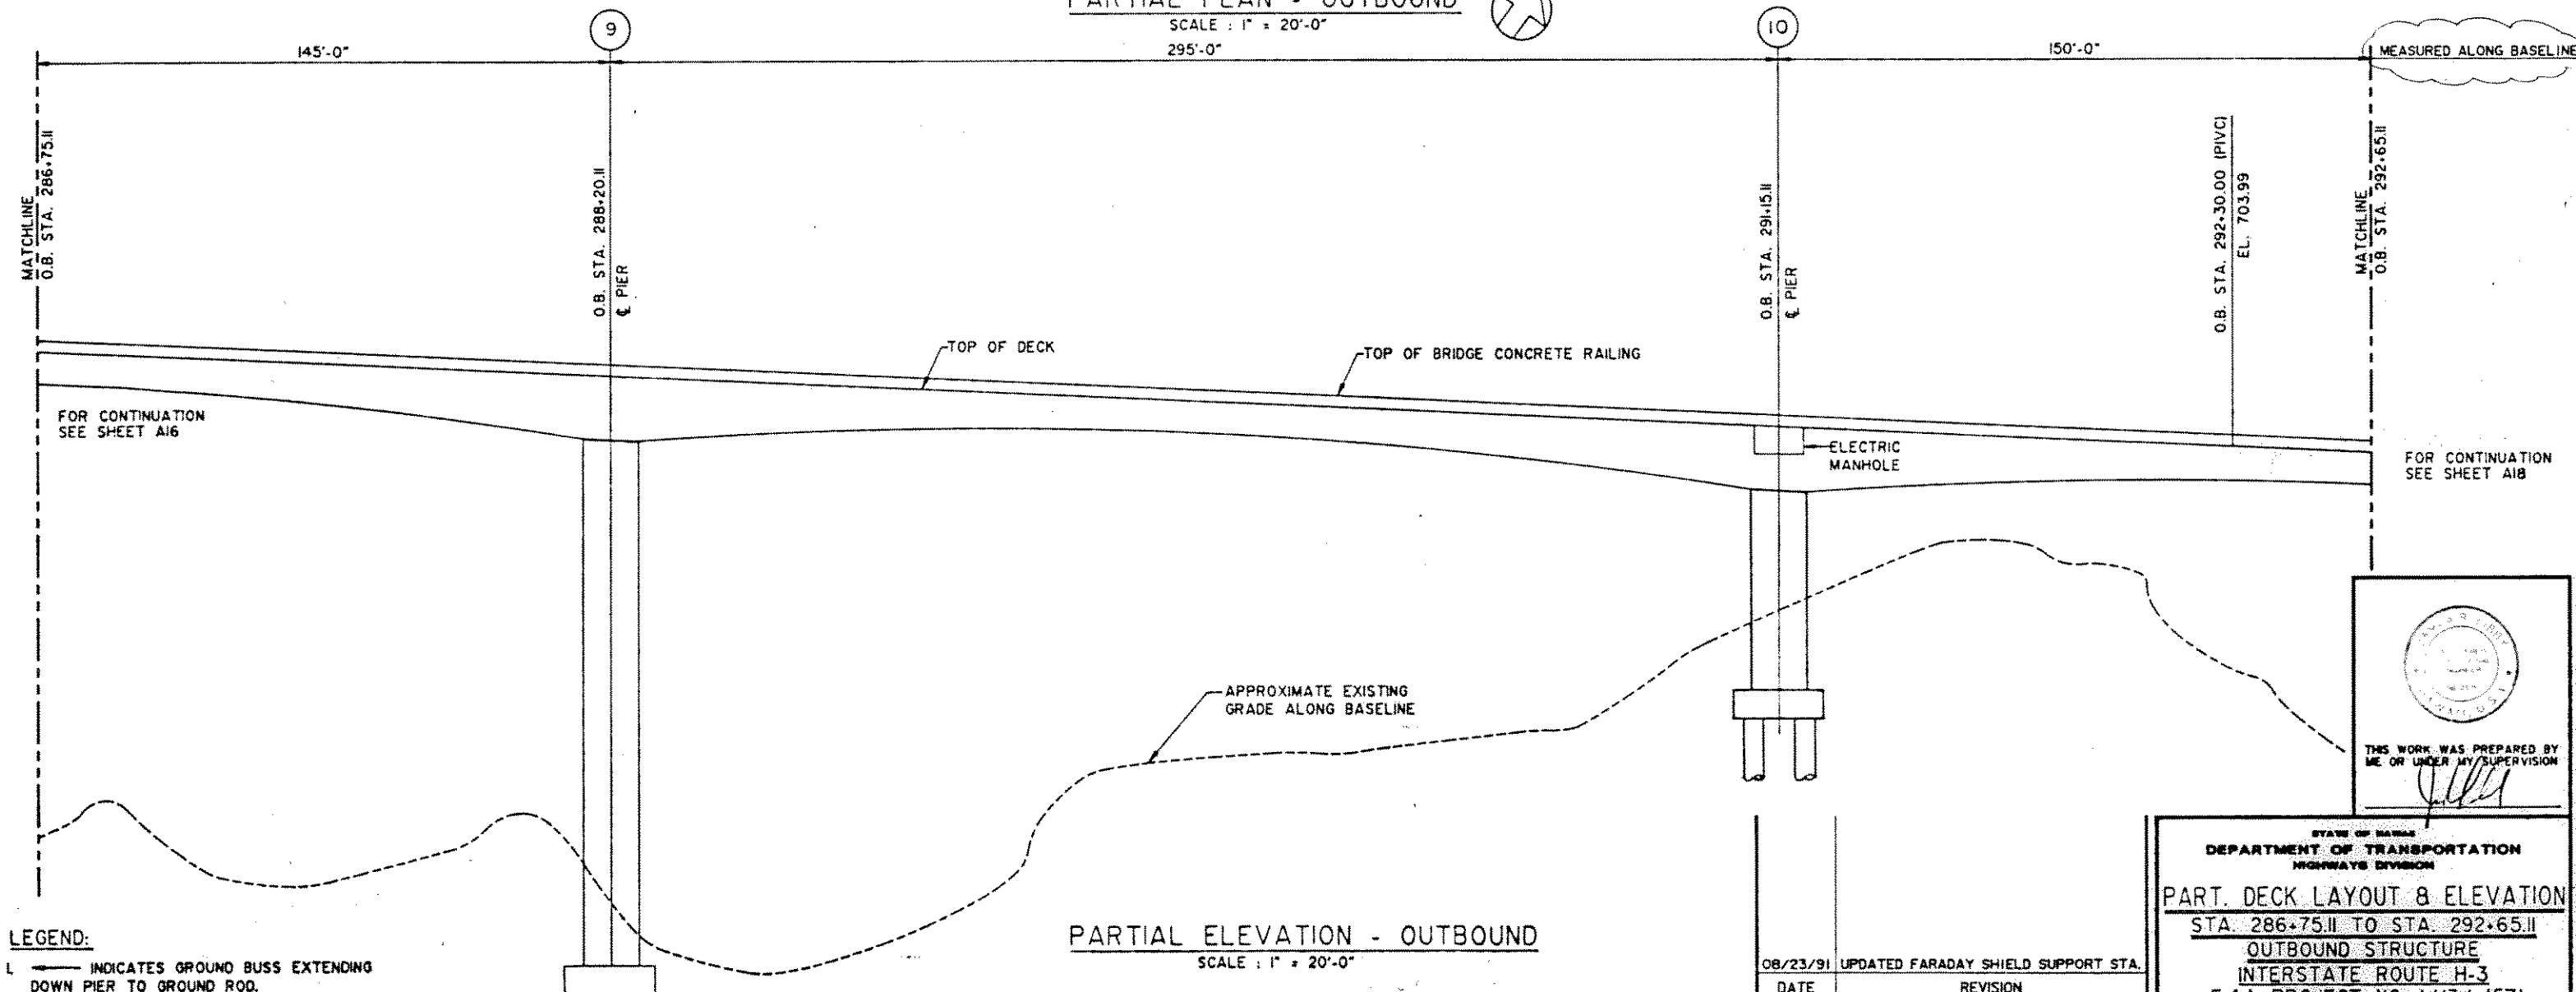

FOR CONTINUATION
SEE SHEET A16


FOR CONTINUATION
SEE SHEET A18

LEGEND:

— INDICATES GROUND BUSS EXTENDING
DOWN PIER TO GROUND ROD.

PARTIAL ELEVATION - OUTBOUND

SCALE: 1" = 20'-0"

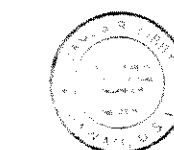

THIS WORK WAS PREPARED BY
ME OR UNDER MY SUPERVISION

08/23/91 UPDATED FARADAY SHIELD SUPPORT STA.
DATE REVISION
J. MULLER INTERNATIONAL Libby Engineers

STATE OF HAWAII
DEPARTMENT OF TRANSPORTATION
HIGHWAYS DIVISION
PART. DECK LAYOUT & ELEVATION
STA. 286+75.11 TO STA. 292+65.11
OUTBOUND STRUCTURE
INTERSTATE ROUTE H-3
F.A.I. PROJECT NO. I-H3-1 (57)
F.A.I. PROJECT NO. I-H3-1 (58)
SCALE: AS NOTED DATE: JUNE 1990
SHEET NO. A17 OF 24 SHEETS