


FED. ROAD DIST. NO.	STATE	FED. AID PROJ. NO.	FISCAL YEAR	SHEET NO.	TOTAL SHEETS
HAWAII	HAW.	I-H3-1 (57)	1988		

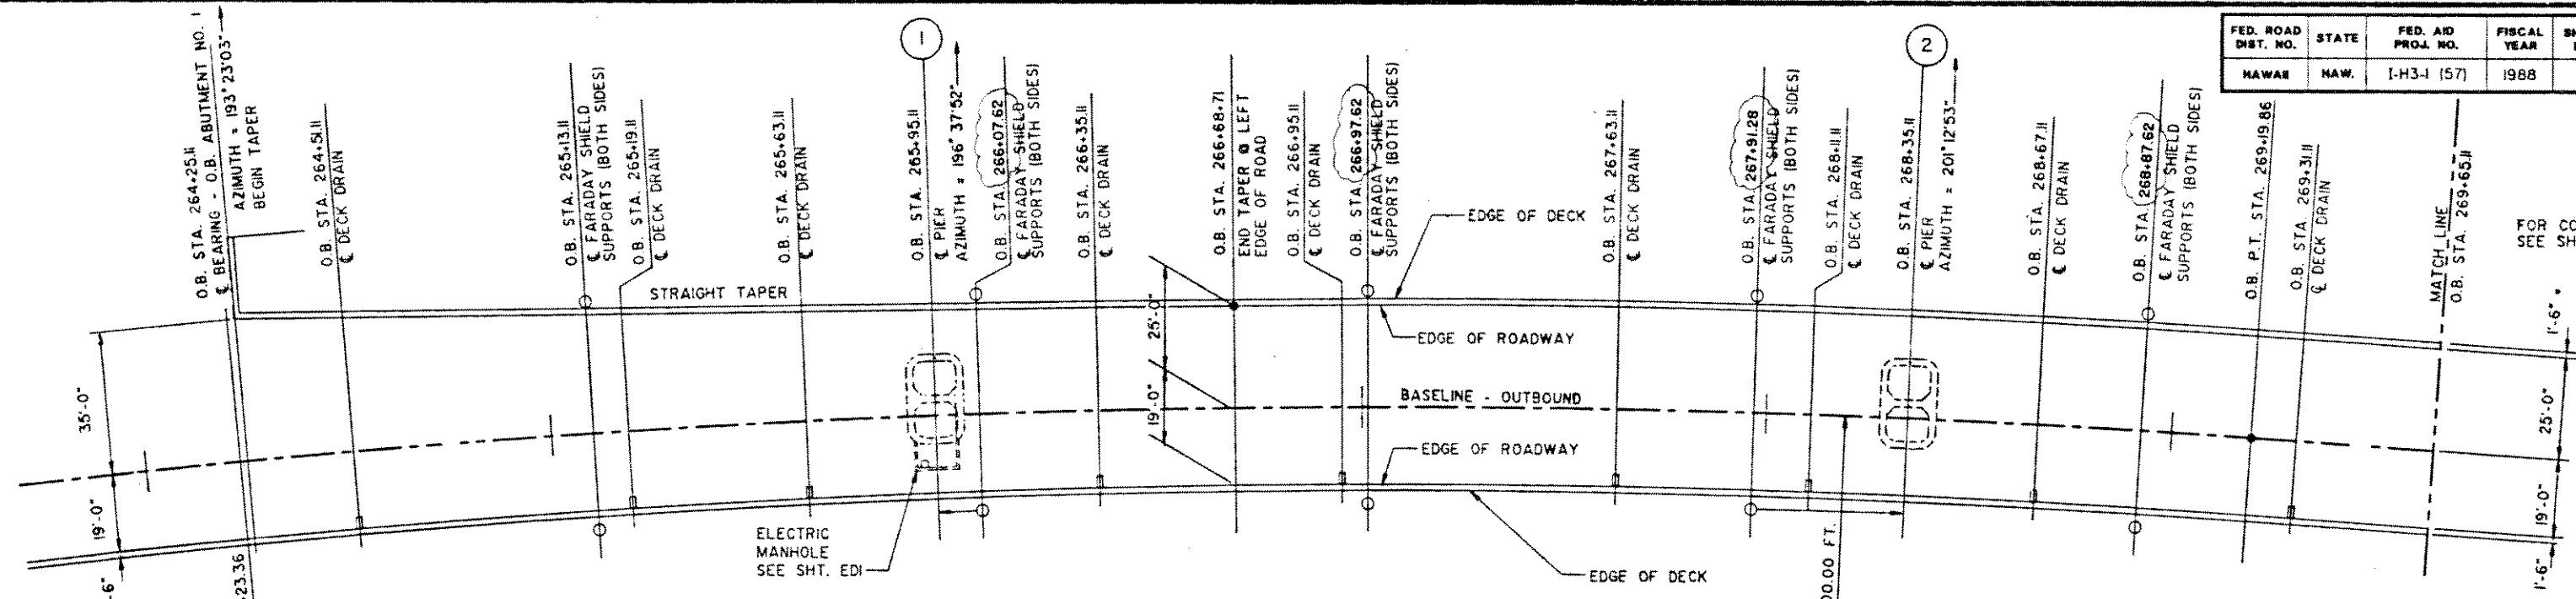


NOTE: LOCATE ALL DECK DRAINS AT CENTERLINE OF NEAREST SEGMENT.

PARTIAL PLAN - OUTBOUND
SCALE: 1" = 20'-0"

NOTE: FARADAY SHIELD SUPPORTS SHALL BE LOCATED RADIALLY TO THE BASELINE.

FOR CONTINUATION SEE SHEET A14

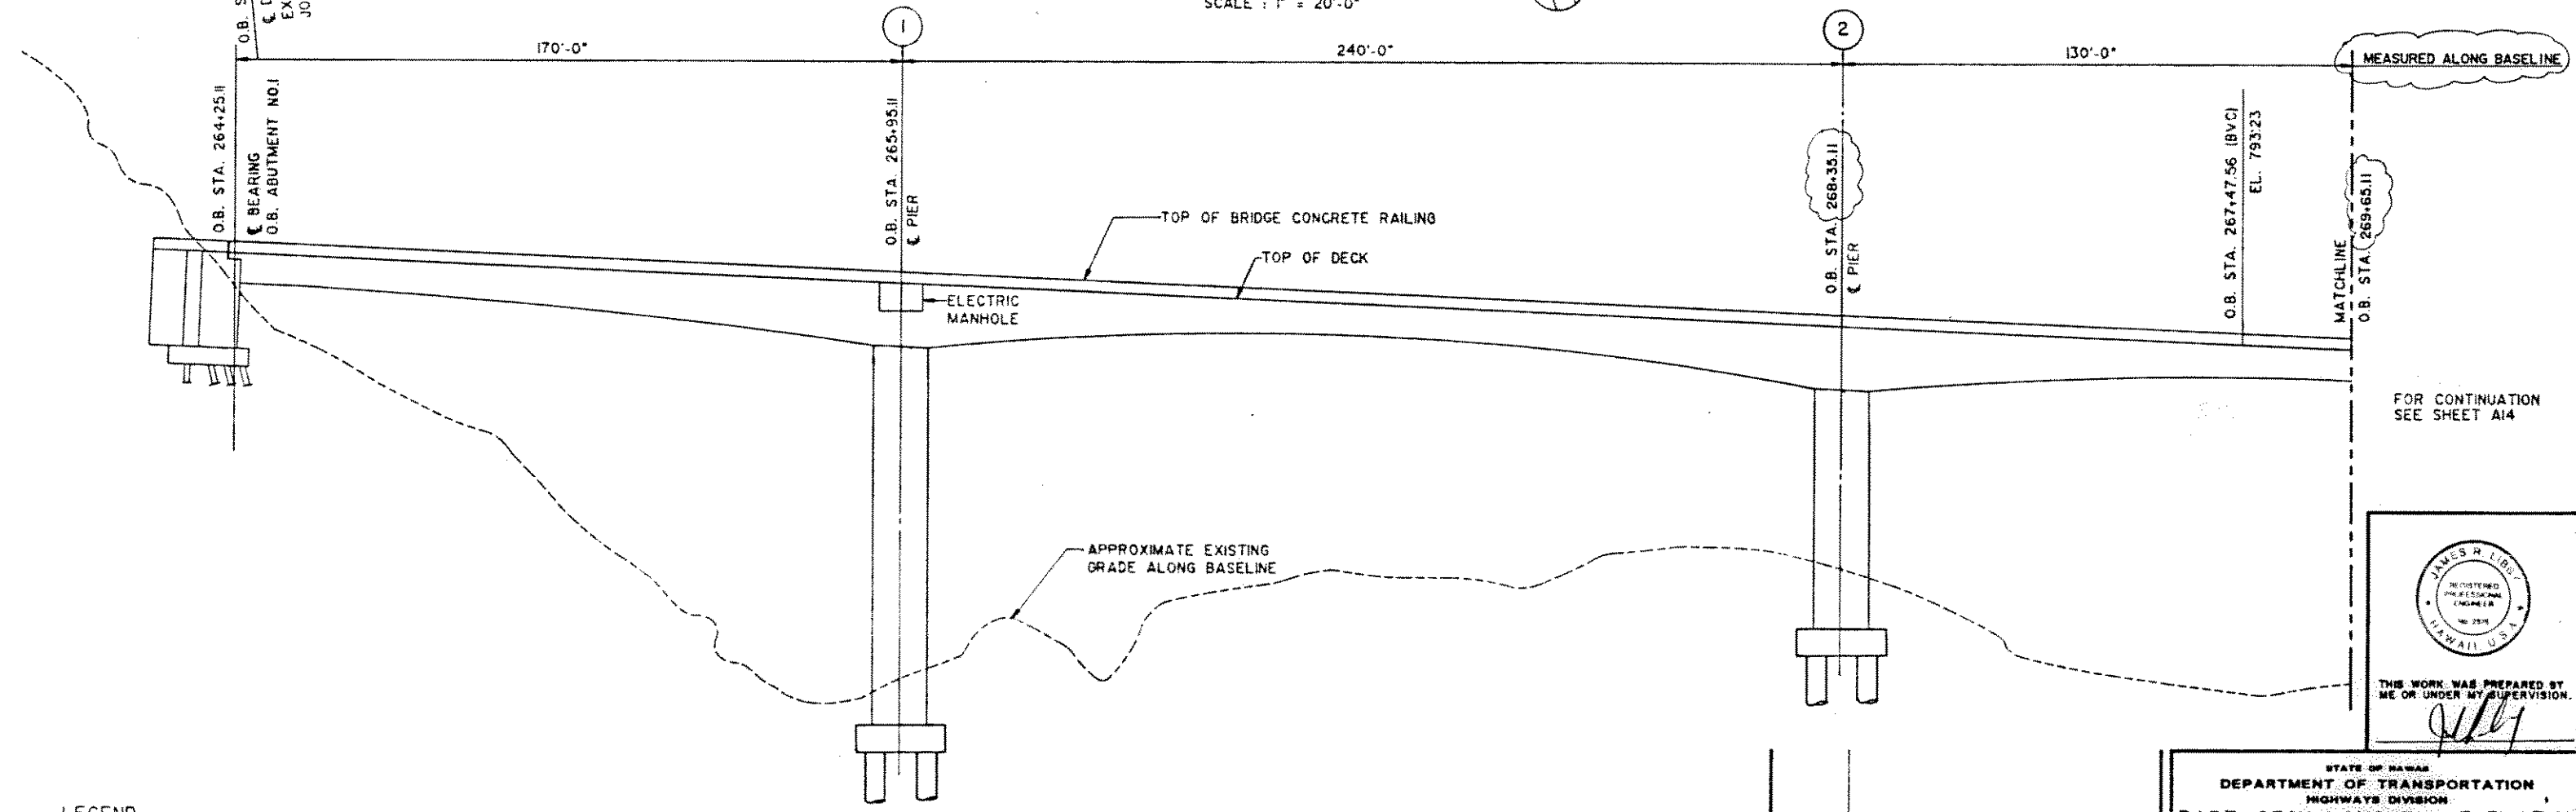

PARTIAL ELEVATION - OUTBOUND
SCALE: 1" = 20'-0"

FOR CONTINUATION SEE SHEET A14

LEGEND:
I. ——— INDICATES GROUND BUSS EXTENDING DOWN PIER TO GROUND ROD.

SURVEY PLOTTED BY	DATE
DRAWN BY	
TRACED BY	
DESIGNED BY	
CHECKED BY	

08/23/91	UPDATED FARADAY SHIELD SUPPORT STA.
DATE	REVISION
J. MULLER	Libby
INTERNATIONAL	Engineers

STATE OF HAWAII
DEPARTMENT OF TRANSPORTATION
HIGHWAYS DIVISION
PART. DECK LAYOUT & ELEVATION
STA. 264.25 II TO STA. 269.65 II
OUTBOUND STRUCTURE
INTERSTATE ROUTE H-3
F.A.I. PROJECT NO. I-H3-1 (57)
F.A.I. PROJECT NO. I-H3-1 (58)
SCALE: AS NOTED DATE: JUNE 1990
SHEET No. A13 OF 24 SHEETS

THIS WORK WAS PREPARED BY ME OR UNDER MY SUPERVISION.

[Signature]