



FED. ROAD DIST. NO.	STATE	FED. AID PROJ. NO.	FISCAL YEAR	SHEET NO.	TOTAL SHEETS
HAWAII	HAW.	I-H3-1 (57)	1988		

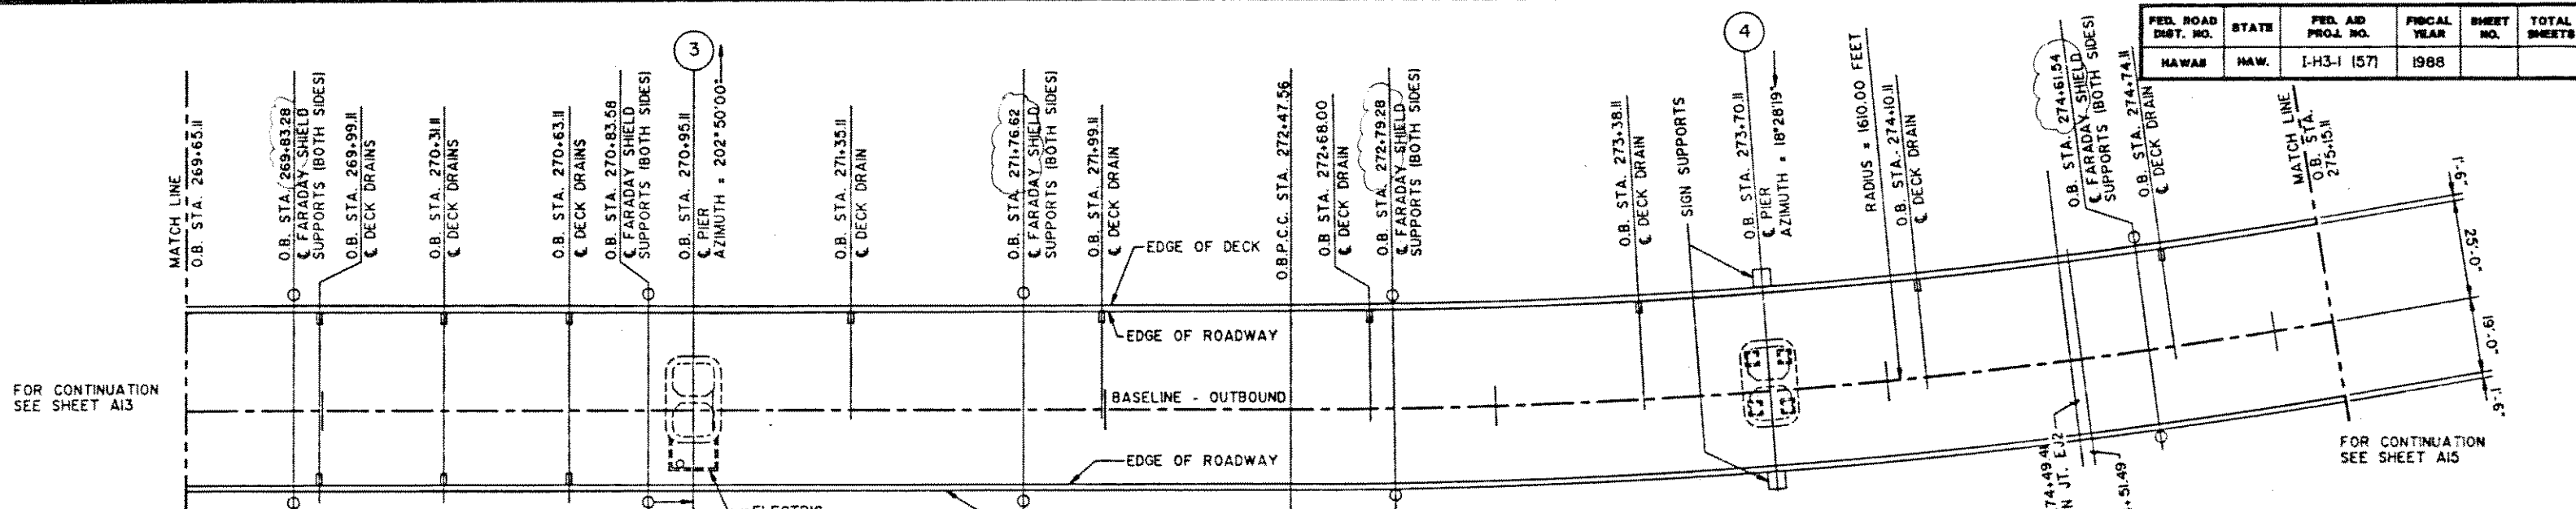

PARTIAL PLAN - OUTBOUND

SCALE : 1" = 20'-0"

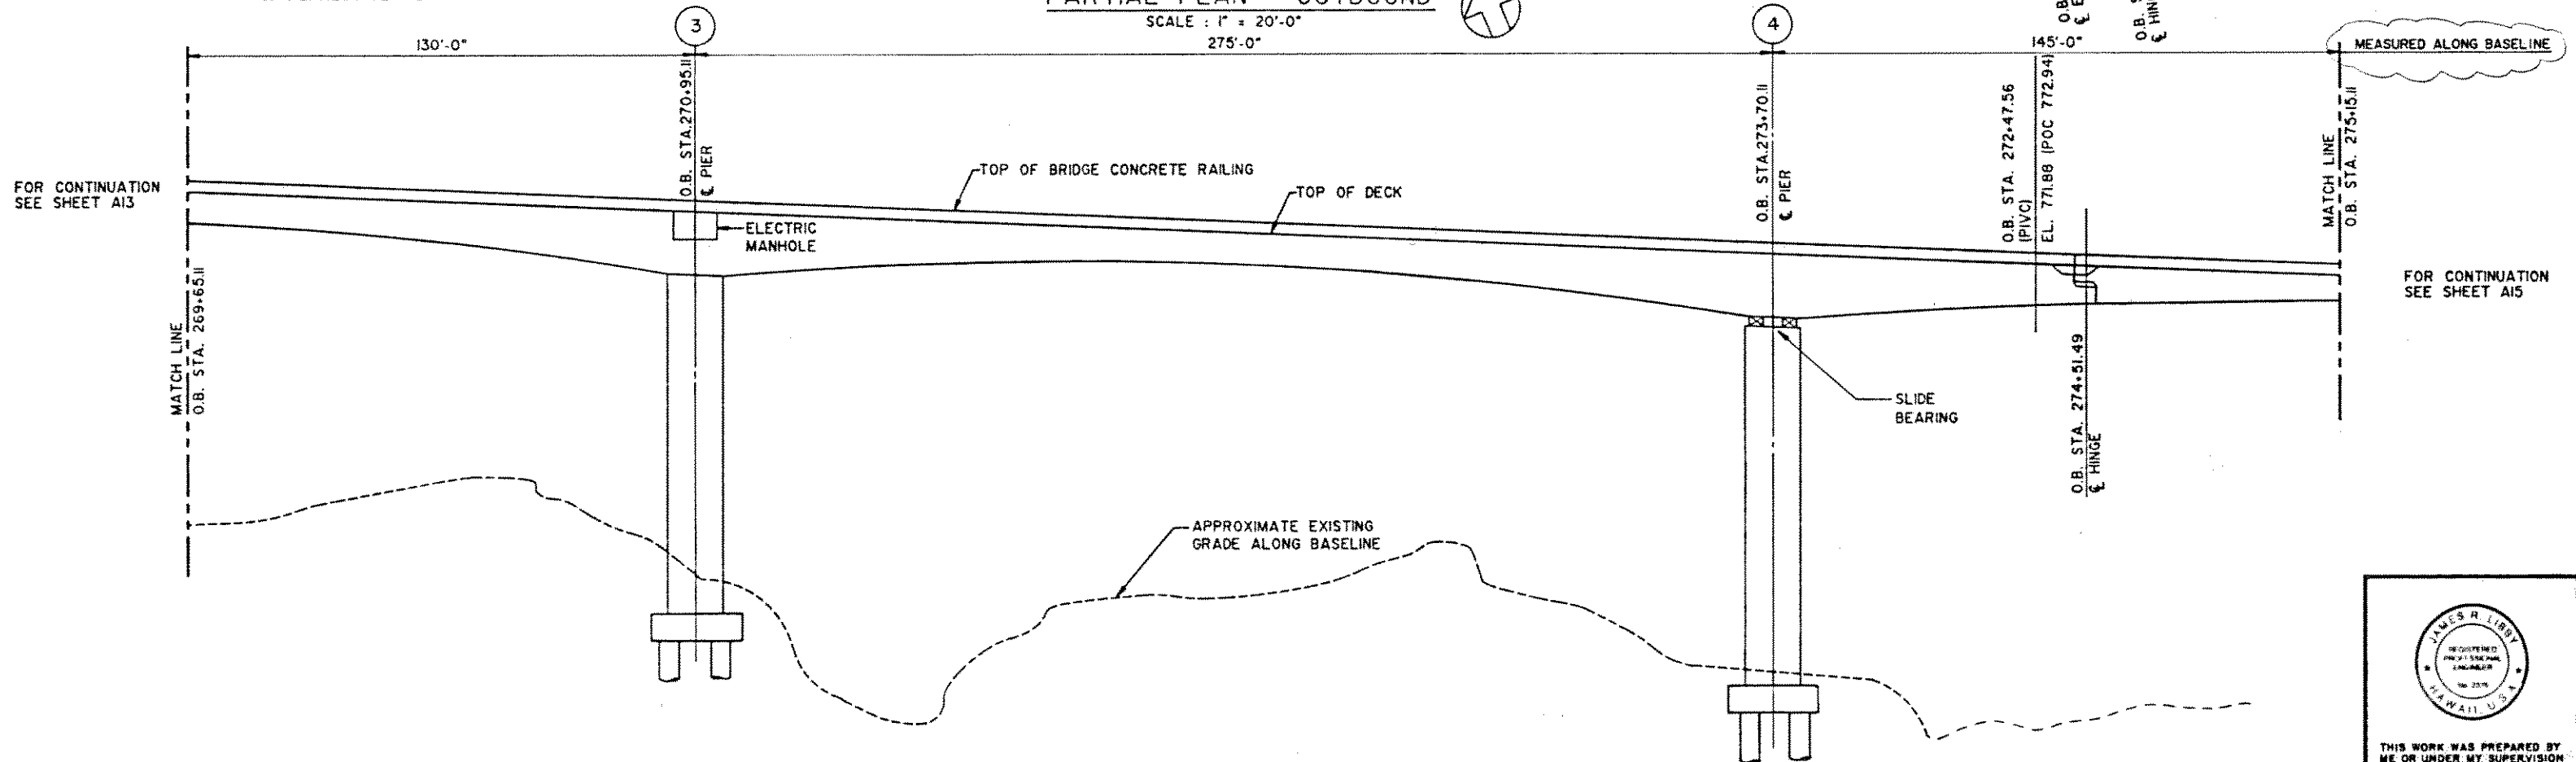

PARTIAL ELEVATION - OUTBOUND

SCALE : 1" = 20'-0"

LEGEND:

- INDICATES GROUND BUSS EXTENDING DOWN PIER TO GROUND ROD.
- O/R INDICATES OFFSET RIGHT OF BASELINE.
- O/L INDICATES OFFSET LEFT OF BASELINE.

DESIGNED BY	DATE
DRAWN BY	
CHECKED BY	
INTEGRITY	
NO.	

08/23/91 UPDATED FARADAY SHIELD SUPPORT STA.

DATE REVISION

J. MULLER INTERNATIONAL Libby Engineers

STATE OF HAWAII
DEPARTMENT OF TRANSPORTATION
HIGHWAYS DIVISION

PART. DECK LAYOUT & ELEVATION

STA. 269+65.11 TO STA. 275+15.11

OUTBOUND STRUCTURE

INTERSTATE ROUTE H-3

F.A.I. PROJECT NO. I-H3-1 (57)

F.A.I. PROJECT NO. I-H3-1 (58)

SCALE: AS NOTED DATE: JUNE 1990

SHEET No. A14 OF 24 SHEETS

JAMES R. LIBBY
REGISTERED PROFESSIONAL ENGINEER
NO. 2276
HAWAII, U.S.A.

THIS WORK WAS PREPARED BY ME OR UNDER MY SUPERVISION