
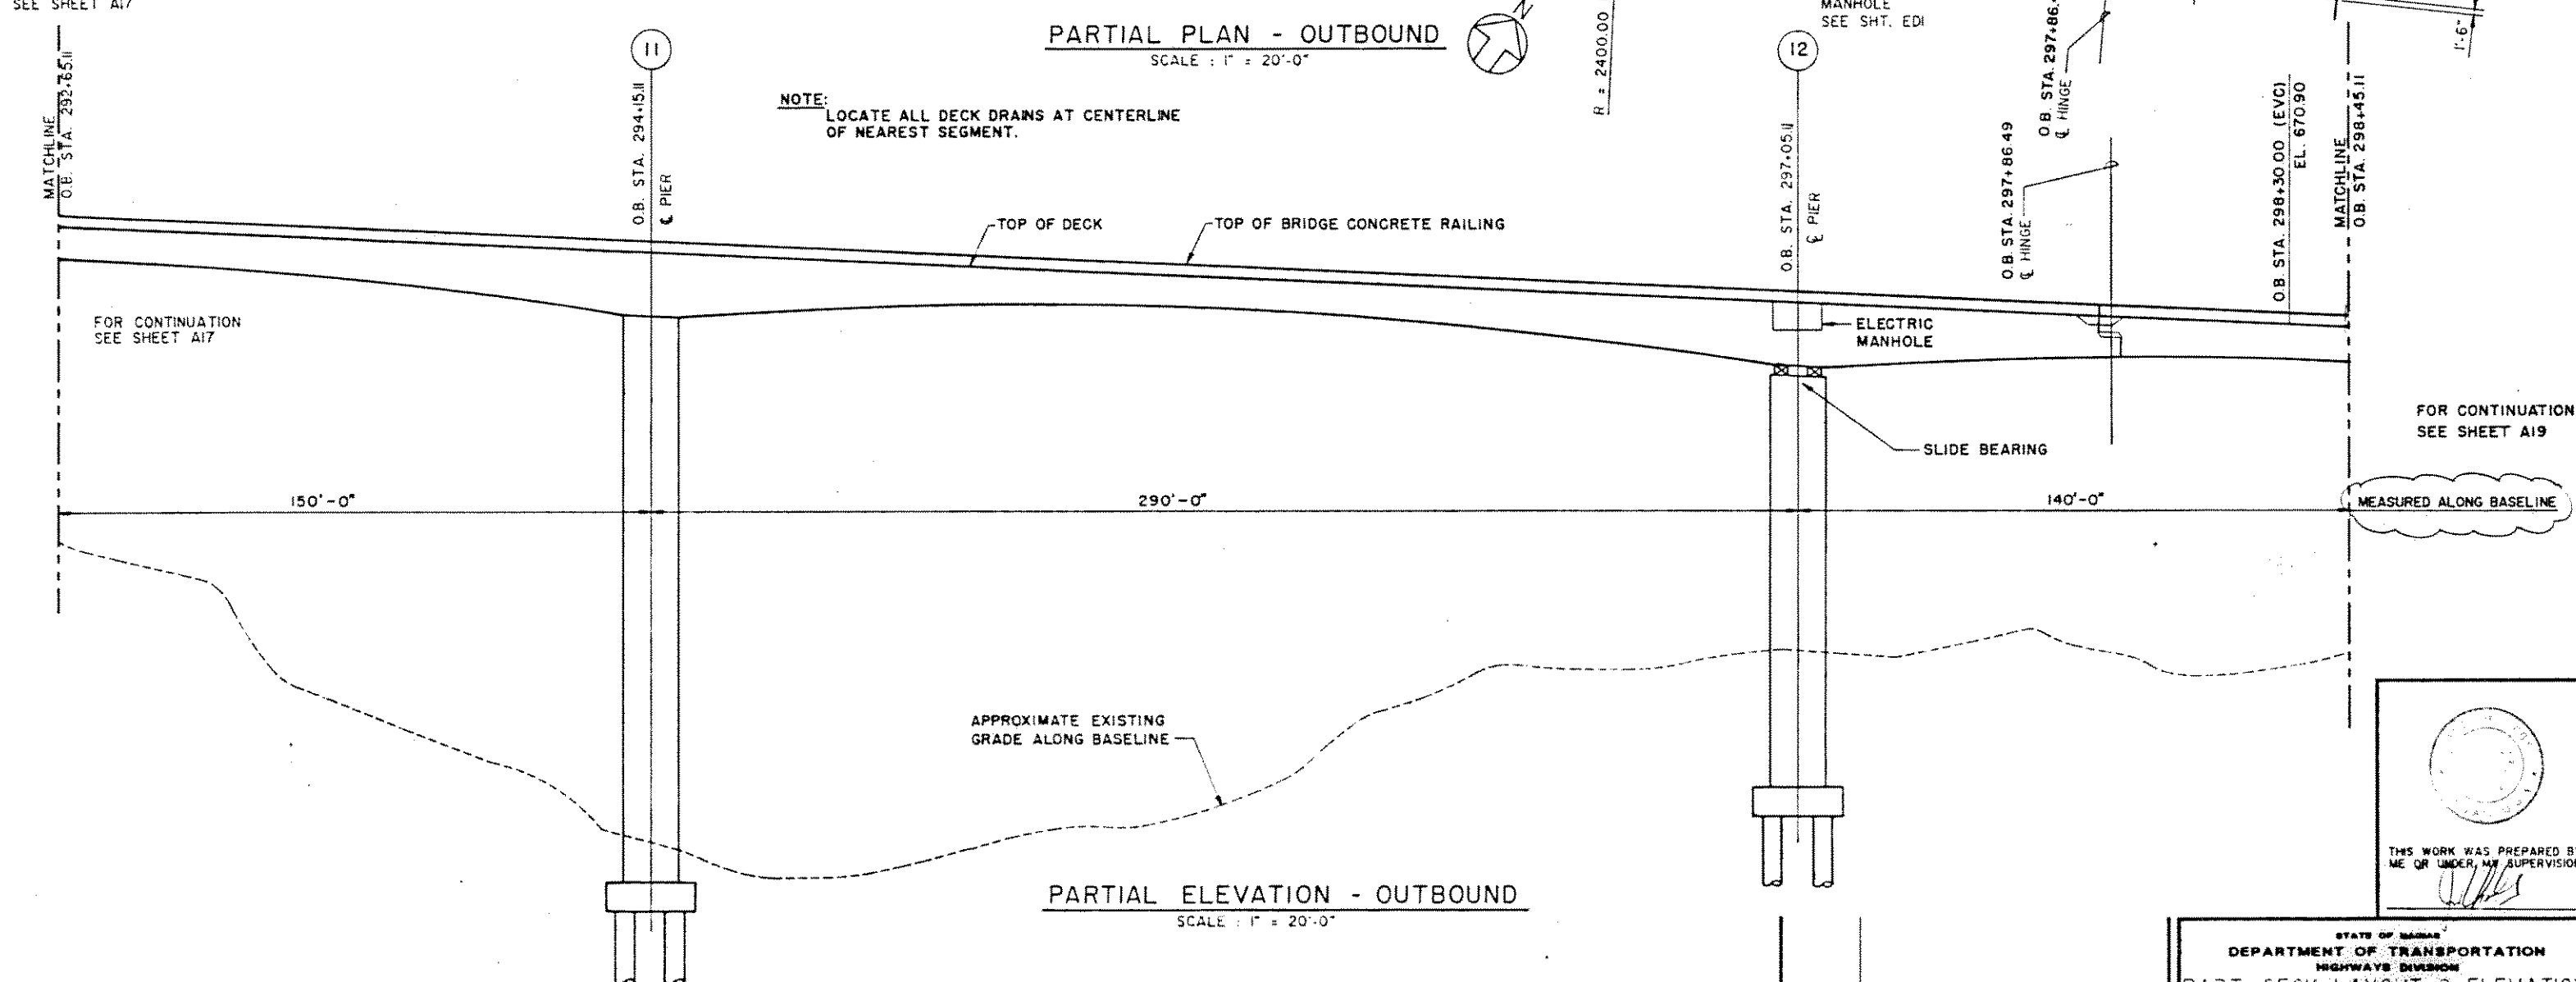


FED. ROAD DIST. NO.	STATE	FED. AID PROJ. NO.	FISCAL YEAR	SHEET NO.	TOTAL SHEETS
HAWAII	HAW.	I-H3-1 (57)	1988		

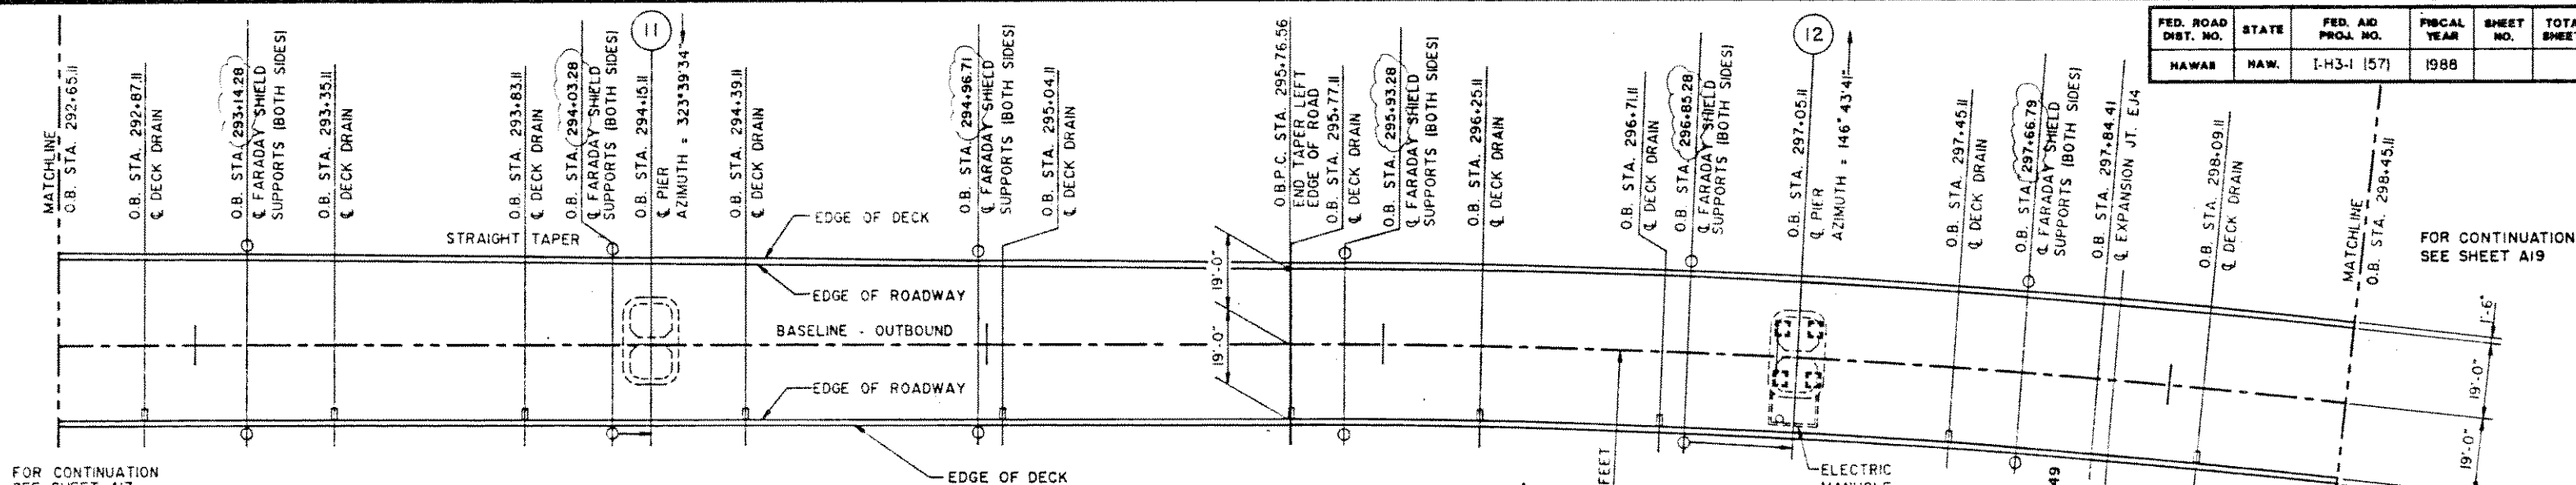

LEGEND:
 I — INDICATES GROUND BUSS EXTENDING DOWN PIER TO GROUND ROD.

08/23/91 UPDATED FARADAY SHIELD SUPPORT STA.
 DATE REVISION
 J. MULLER INTERNATIONAL E Libby Engineers

STATE OF HAWAII
 DEPARTMENT OF TRANSPORTATION
 HIGHWAYS DIVISION
 PART DECK LAYOUT & ELEVATION
 STA. 292+65.11 TO STA. 298+45.11
 OUTBOUND STRUCTURE
 INTERSTATE ROUTE H-3
 F.A.I. PROJECT NO. I-H3-1 (57)
 F.A.I. PROJECT NO. I-H3-1 (58)
 SCALE: AS NOTED DATE: JUNE 1990
 SHEET NO. A18 OF 24 SHEETS