



FED. ROAD DIST. NO.	STATE	FED. AID PROJ. NO.	FISCAL YEAR	SHEET NO.	TOTAL SHEETS
HAWAII	HAW.	I-H3-1 (57)	1988	65	274

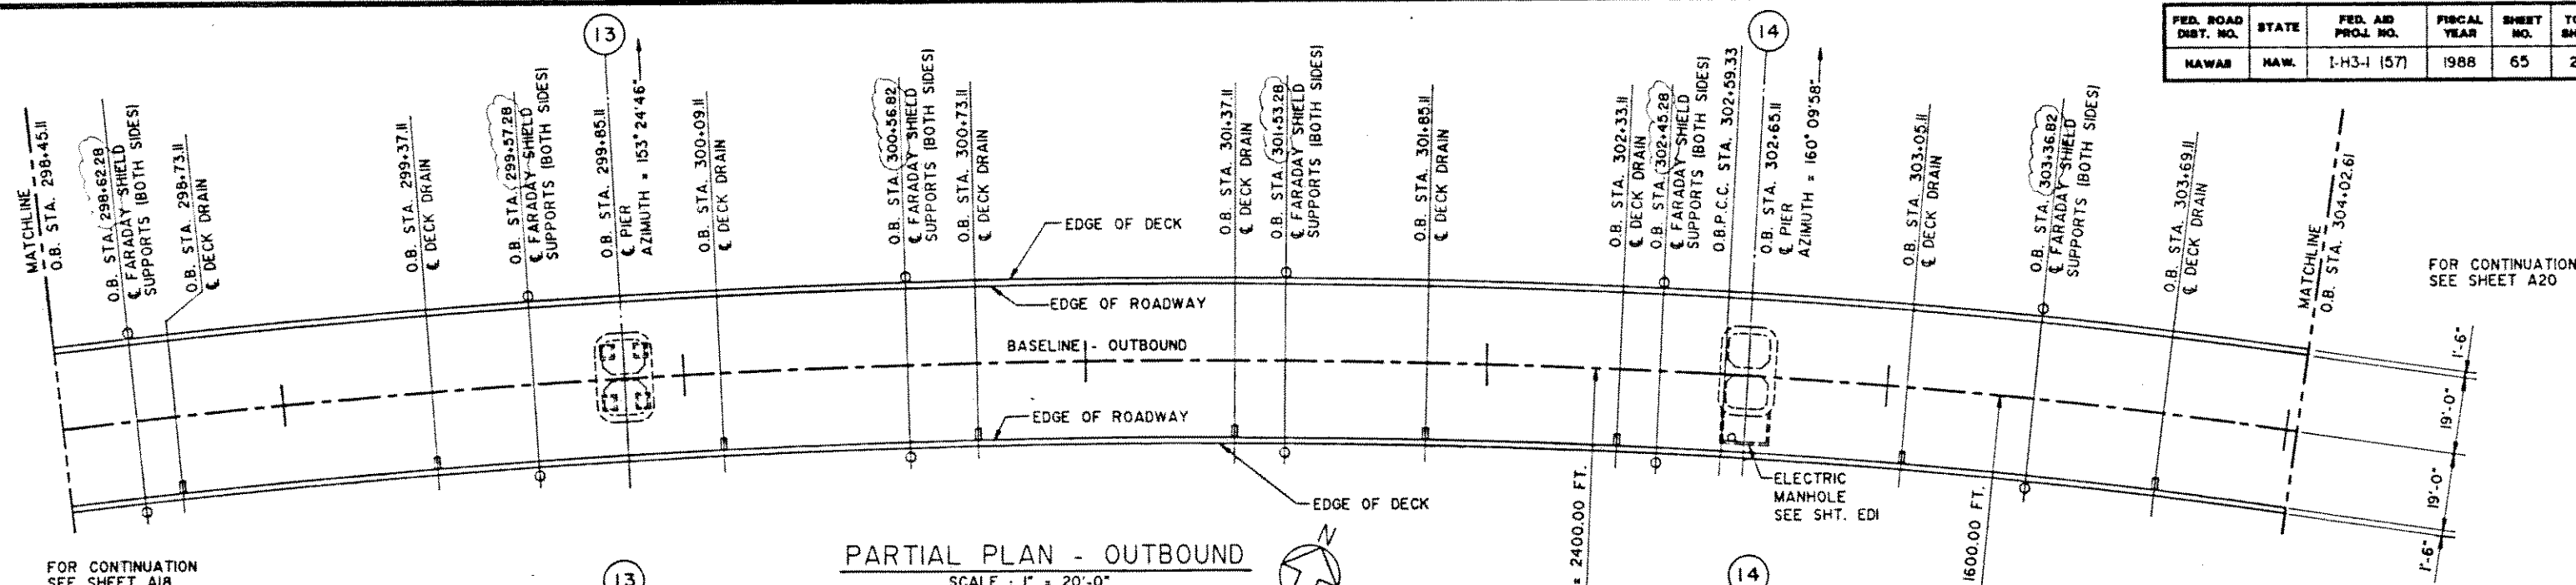

FOR CONTINUATION
SEE SHEET A18

FOR CONTINUATION
SEE SHEET A18

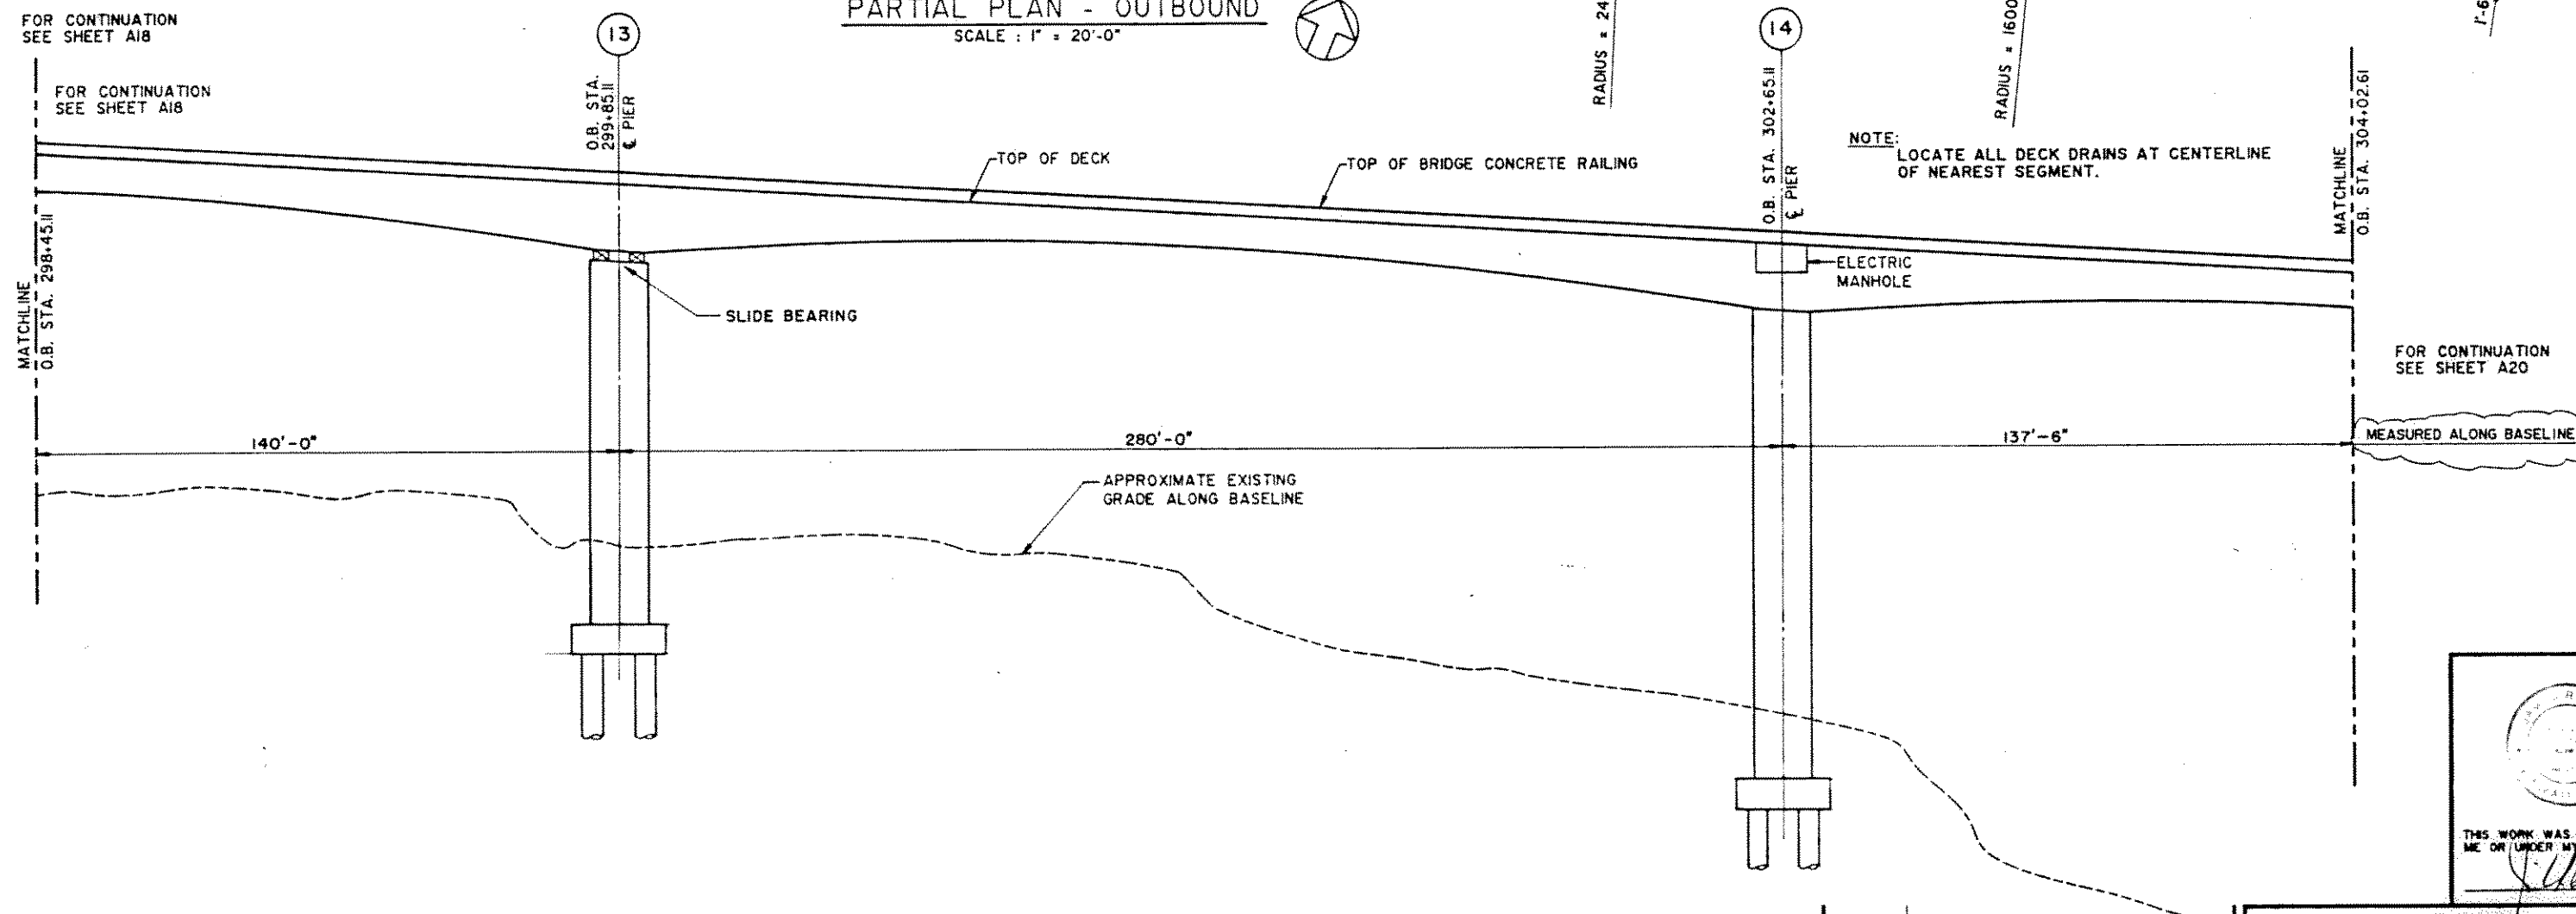

LEGEND:

- 1. ——— INDICATES GROUND BUSS EXTENDING DOWN PIER TO GROUND ROD.

PARTIAL ELEVATION - OUTBOUND
SCALE: 1" = 20'-0"

08/23/91	UPDATED FARADAY SHIELD SUPPORT STA.
DATE	REVISION
J. MULLER INTERNATIONAL	Libby Engineers

STATE OF HAWAII
DEPARTMENT OF TRANSPORTATION
HIGHWAYS DIVISION

PART. DECK LAYOUT & ELEVATION
STA. 298.45.11 TO STA. 304.02.61
OUTBOUND STRUCTURE
INTERSTATE ROUTE H-3
F.A.I. PROJECT NO. I-H3-1 (57)
F.A.I. PROJECT NO. I-H3-1 (58)
SCALE: AS NOTED DATE: JUNE 1990
SHEET No. A19 OF 24 SHEETS