



FED. ROAD DIST. NO.	STATE	FED. AID PROJ. NO.	FISCAL YEAR	SHEET NO.	TOTAL SHEETS
HAWAII	HAWAII	I-H3-1 (57)	1988		

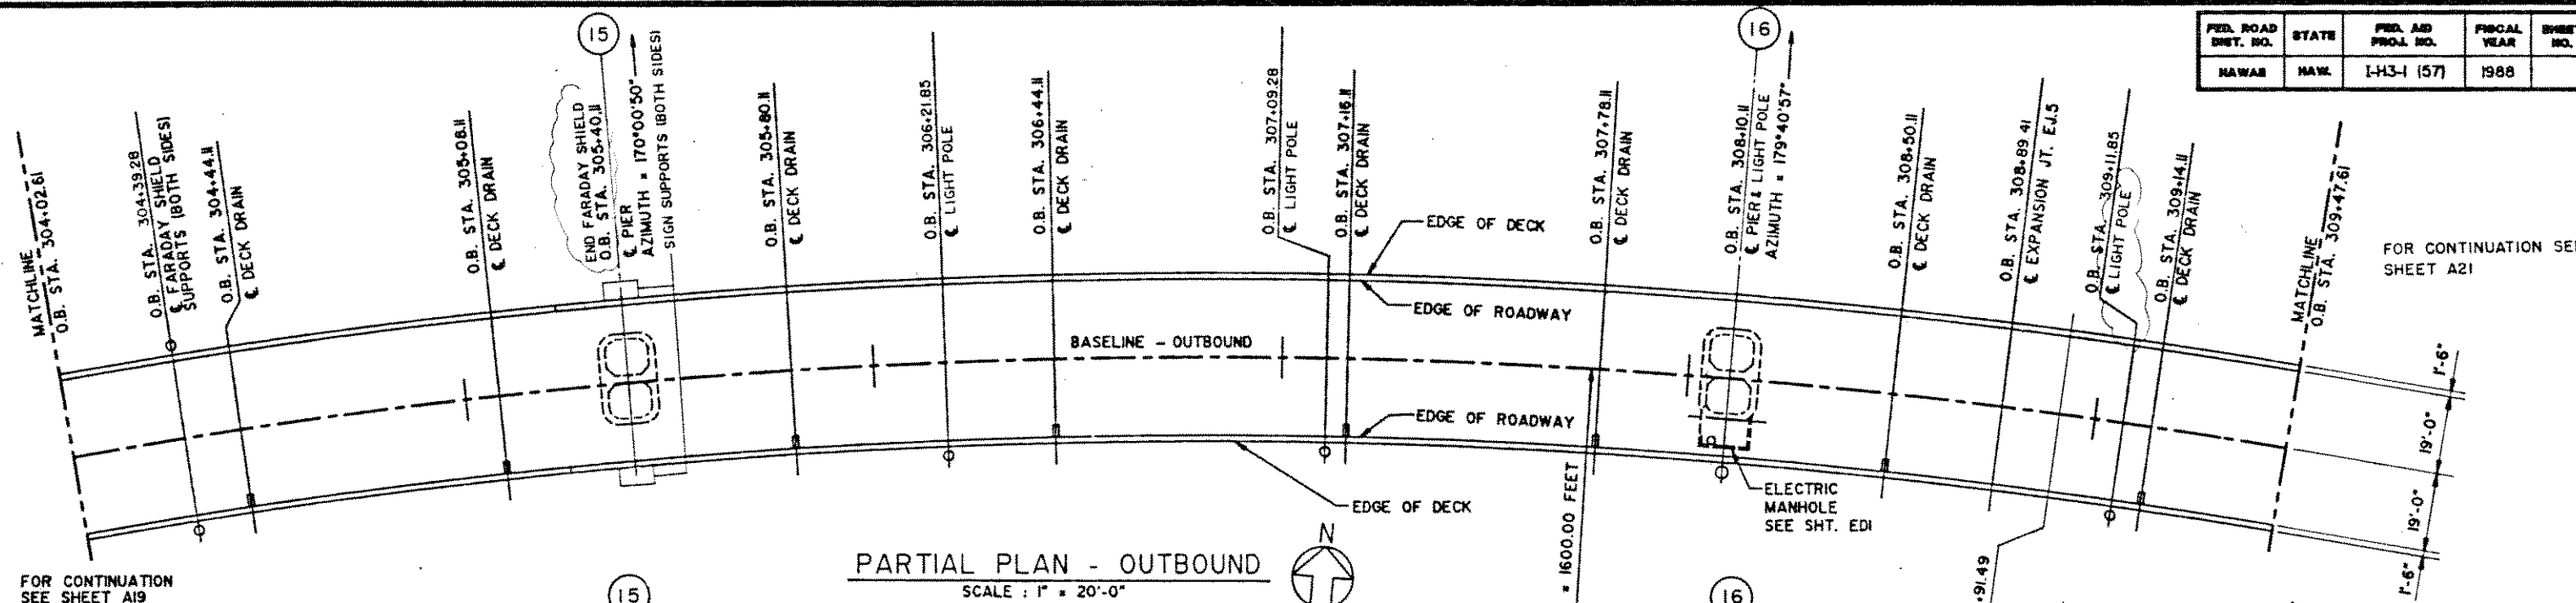

FOR CONTINUATION
SEE SHEET A19

FOR CONTINUATION SEE
SHEET A21

PARTIAL PLAN - OUTBOUND
SCALE : 1" = 20'-0"

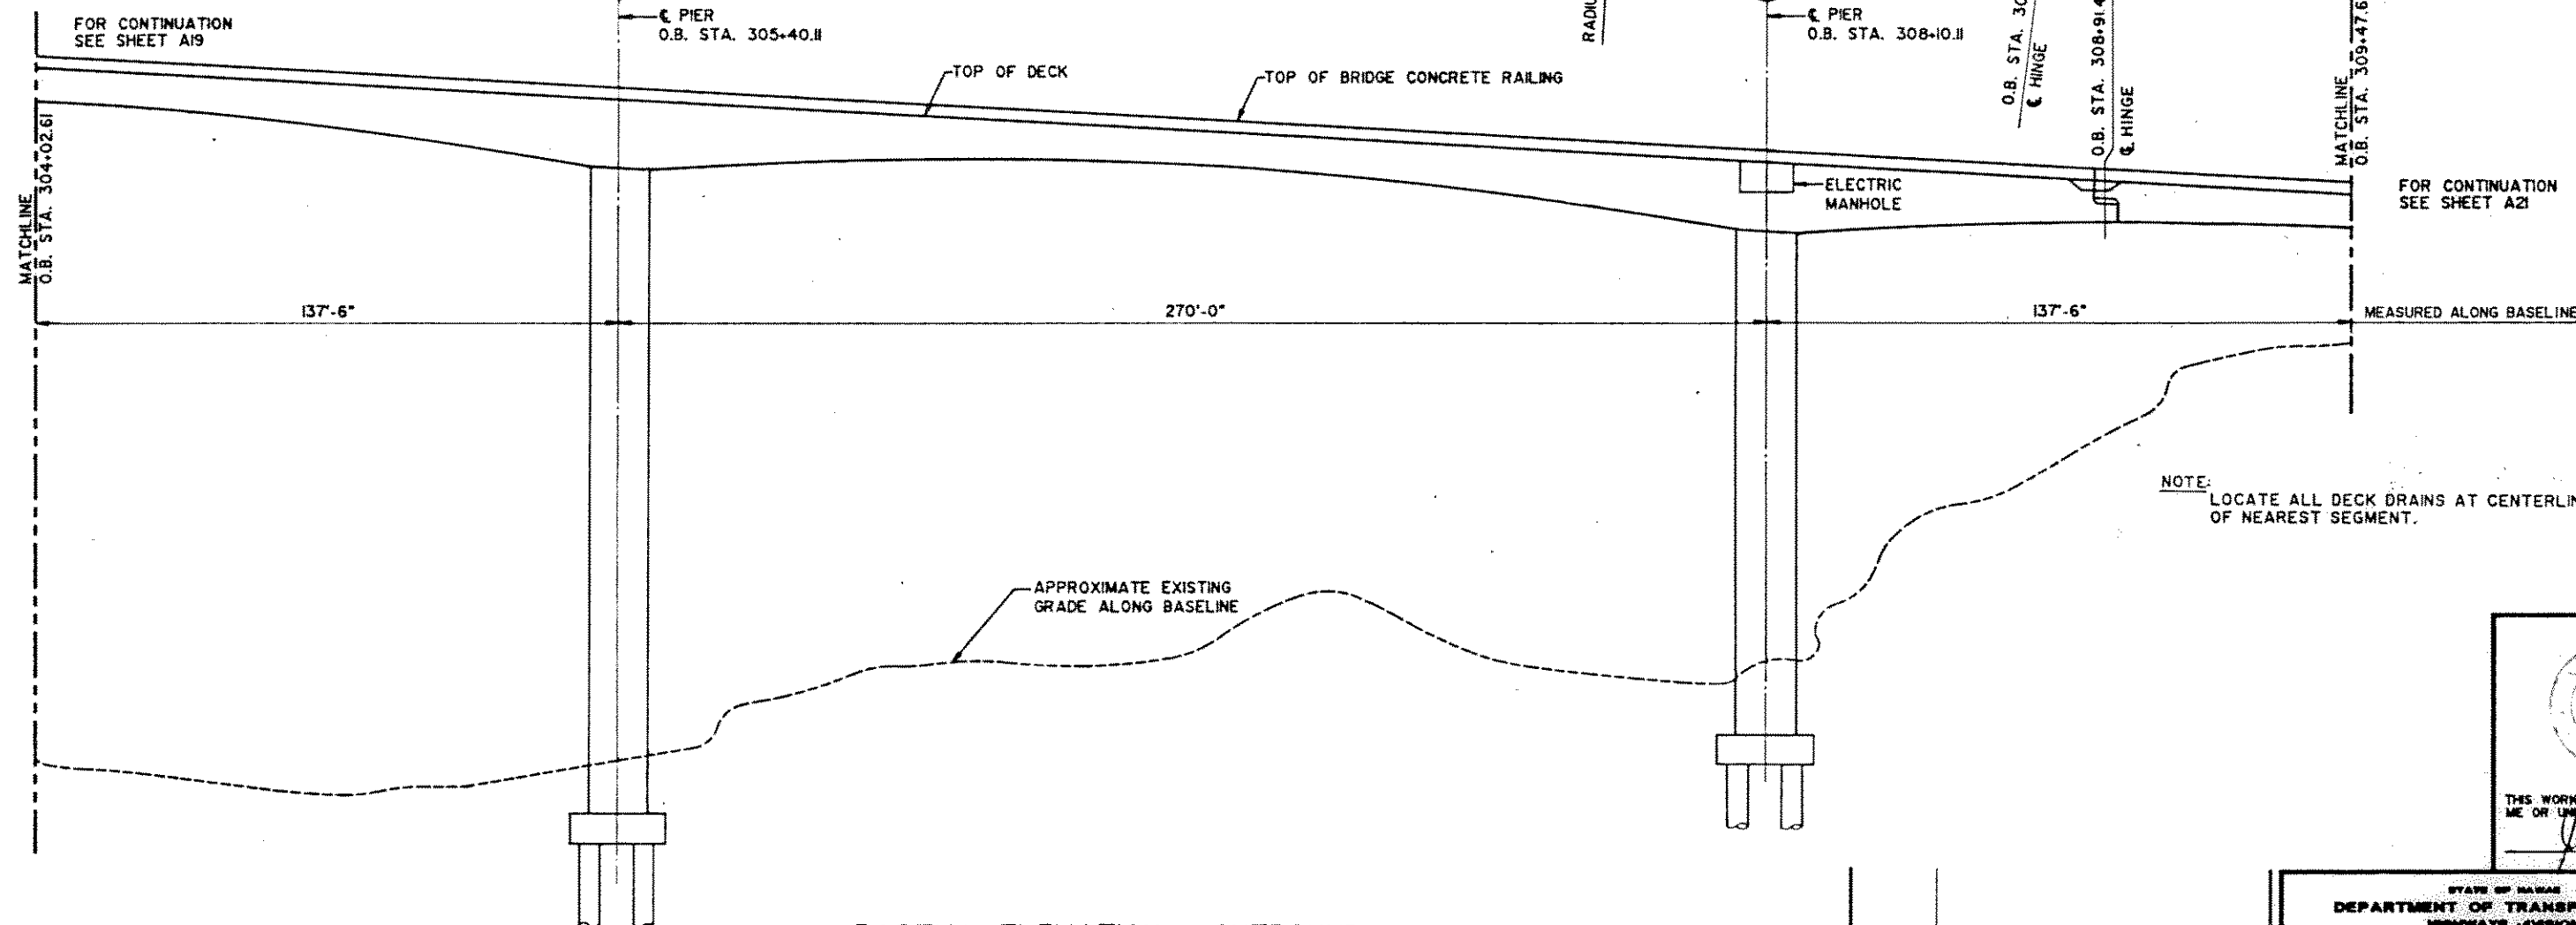

FOR CONTINUATION
SEE SHEET A19

FOR CONTINUATION
SEE SHEET A21

PARTIAL ELEVATION - OUTBOUND
SCALE : 1" = 20'-0"

NOTE:
LOCATE ALL DECK DRAINS AT CENTERLINE
OF NEAREST SEGMENT.

LEGEND:

1. — INDICATES GROUND BUSS EXTENDING DOWN PIER TO GROUND ROD.
2. O/R INDICATES OFFSET RIGHT OF BASELINE.
3. O/L INDICATES OFFSET LEFT OF BASELINE.

09/30/91	UPDATED DRAWING.
08/23/91	UPDATED FARADAY SHIELD SUPPORT STA. AND SIGN SUPPORT.
DATE	REVISION
J. MULLER INTERNATIONAL	Libby Engineers

STATE OF HAWAII
DEPARTMENT OF TRANSPORTATION
HIGHWAYS DIVISION

PART. DECK LAYOUT & ELEVATION
STA. 304+02.61 TO STA. 309+47.61
OUTBOUND STRUCTURE
INTERSTATE ROUTE H-3
F.A.I. PROJECT NO. I-H3-1 (57)
F.A.I. PROJECT NO. I-H3-1 (58)
SCALE: AS NOTED DATE: JUNE 1990
SHEET No. A20 OF 24 SHEETS



THIS WORK WAS PREPARED BY
ME OR UNDER MY SUPERVISION