
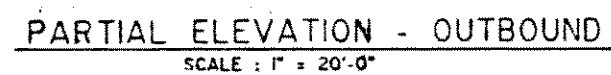


9	DATE
8	MONTH PLANTED BY
7	PLANT
6	PLANT
5	PLANT
4	PLANT
3	PLANT
2	PLANT
1	PLANT

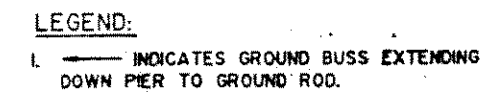

 J. MULLER
INTERNATIONAL  Libby
Engineers

67